




120 ELEVATION  
SCALE 1:50

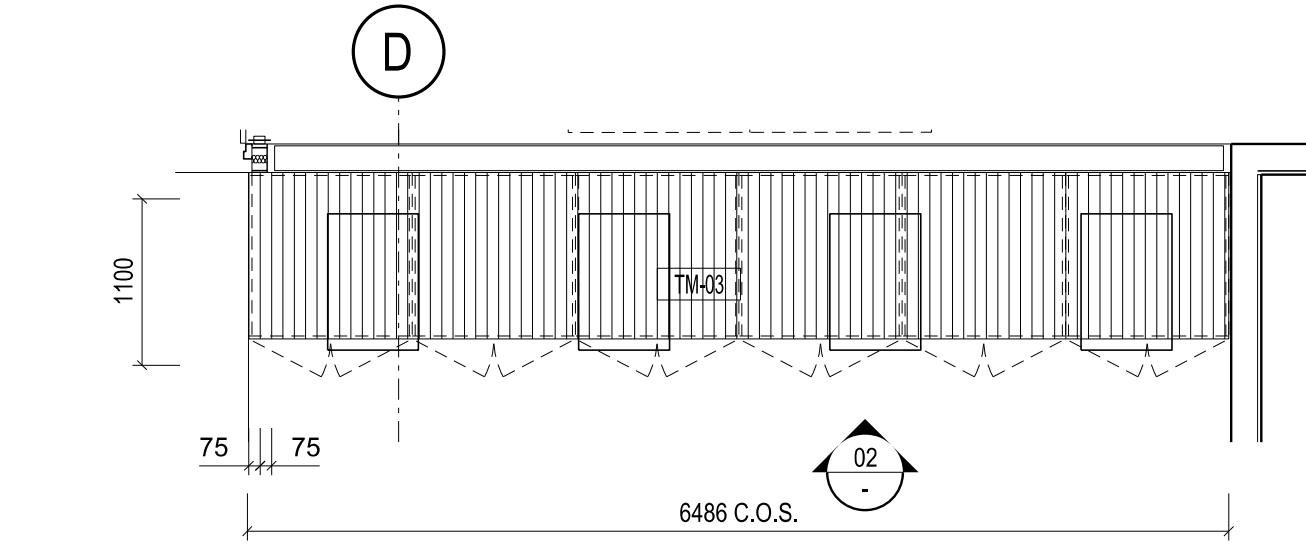


120 PLAN - J0G-27 - FOAM CUTTING BENCH  
SCALE 1:50

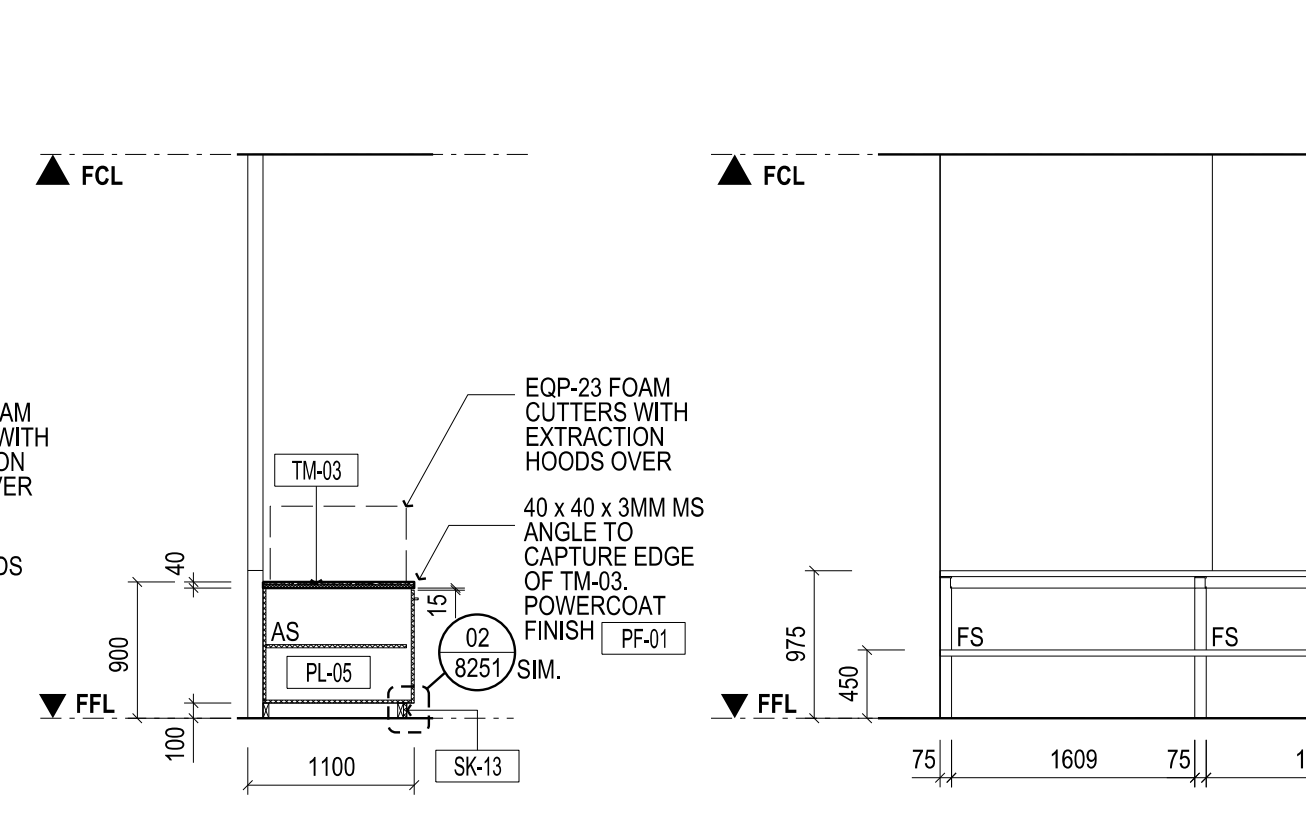


130 SECTION  
SCALE 1:50

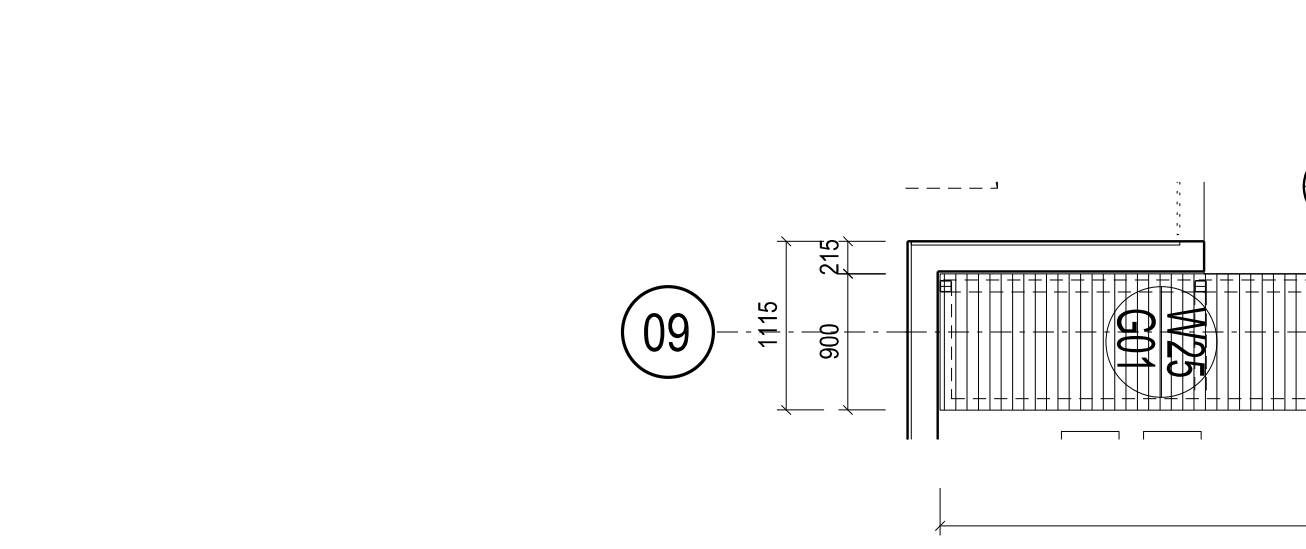


130 PLAN - J0G-28 - WORKBENCH  
SCALE 1:50

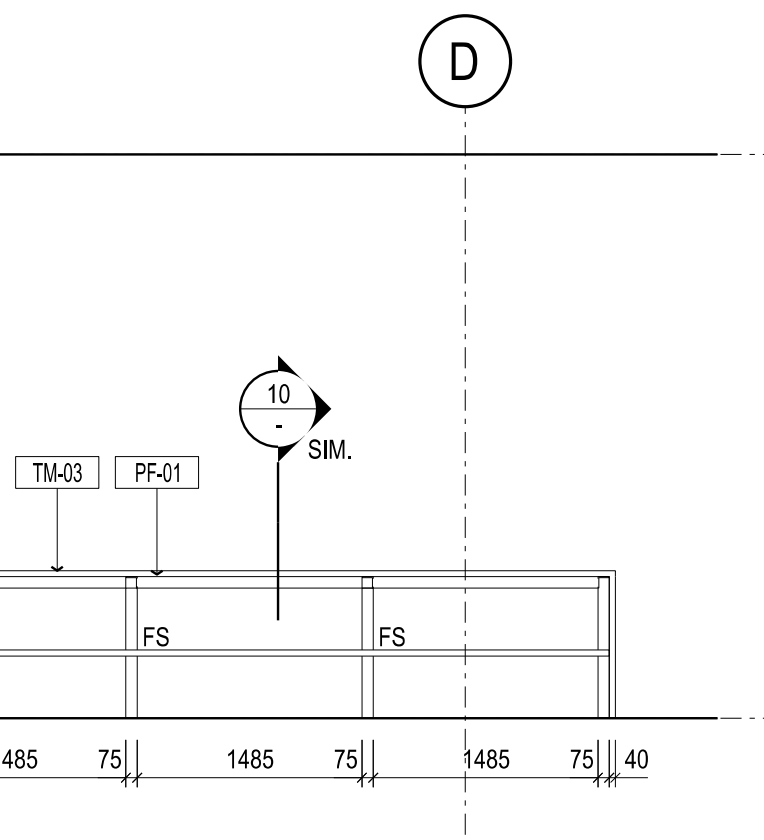

150 ELEVATION  
SCALE 1:50

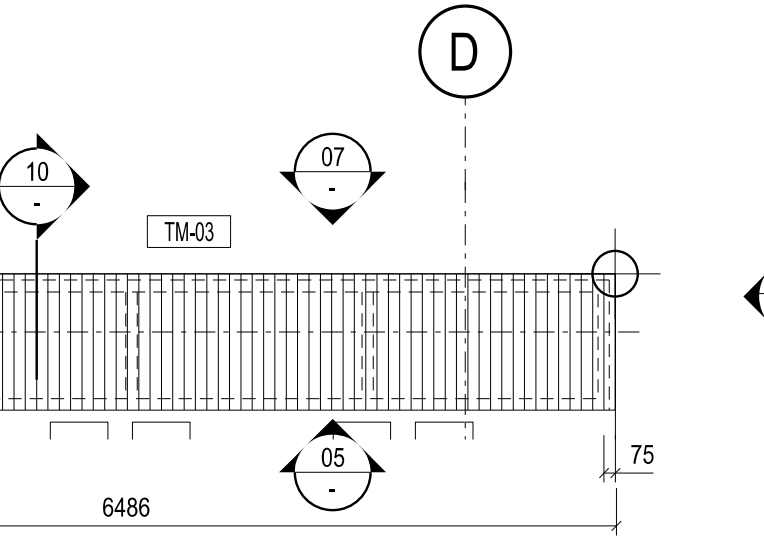


150 PLAN - J0G-29 - WORKBENCH  
SCALE 1:50

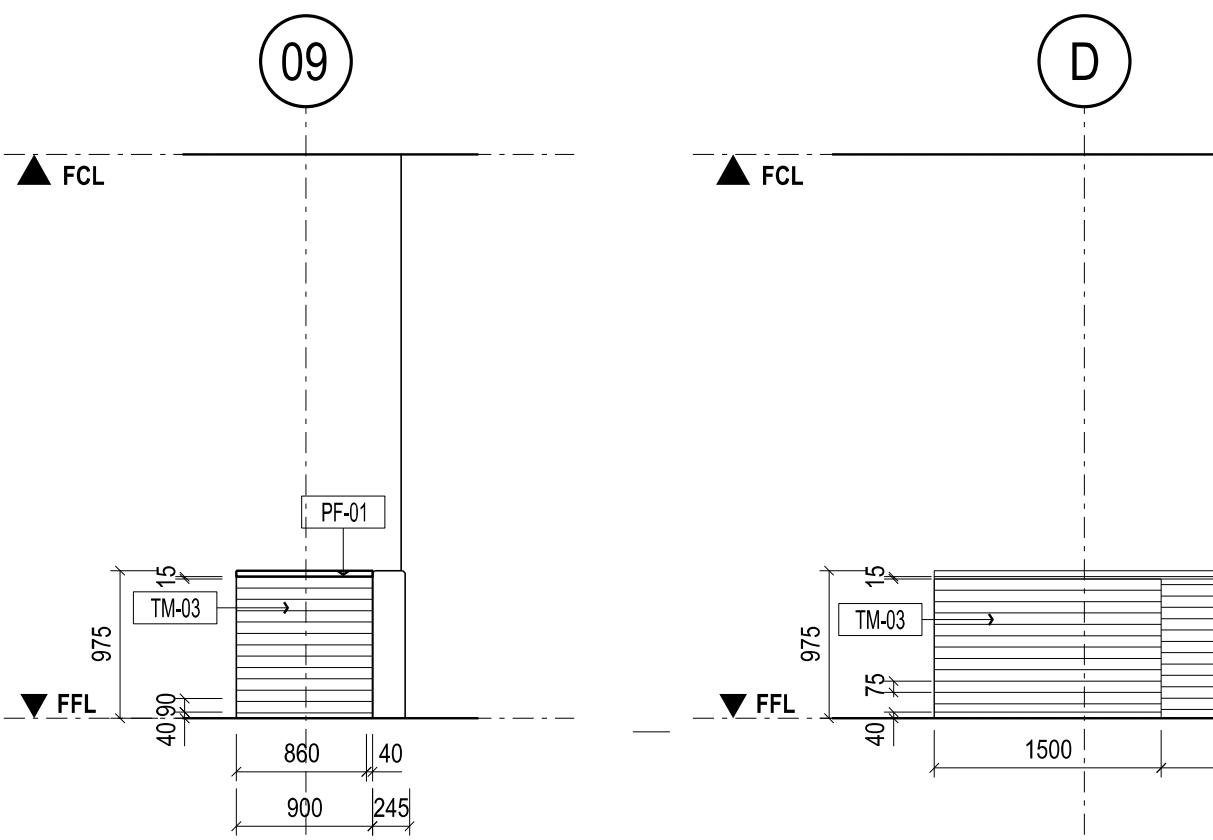


160 ELEVATION  
SCALE 1:50




170 ELEVATION  
SCALE 1:50

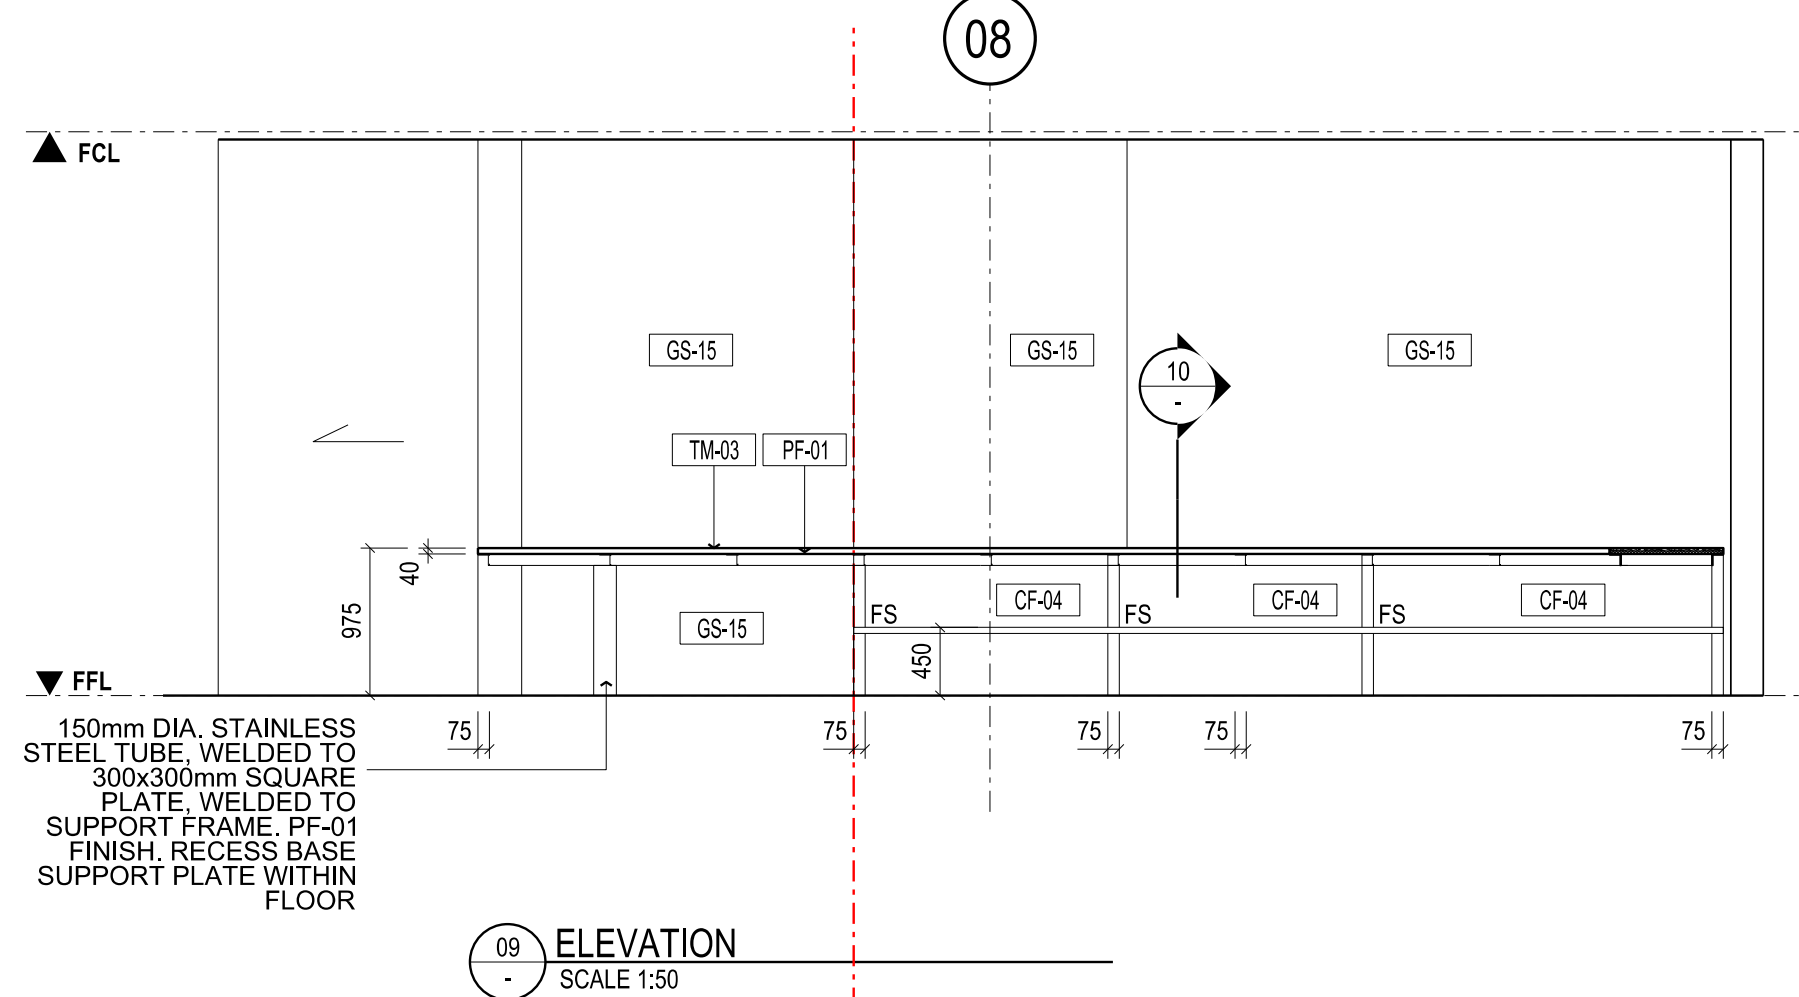


180 ELEVATION  
SCALE 1:50

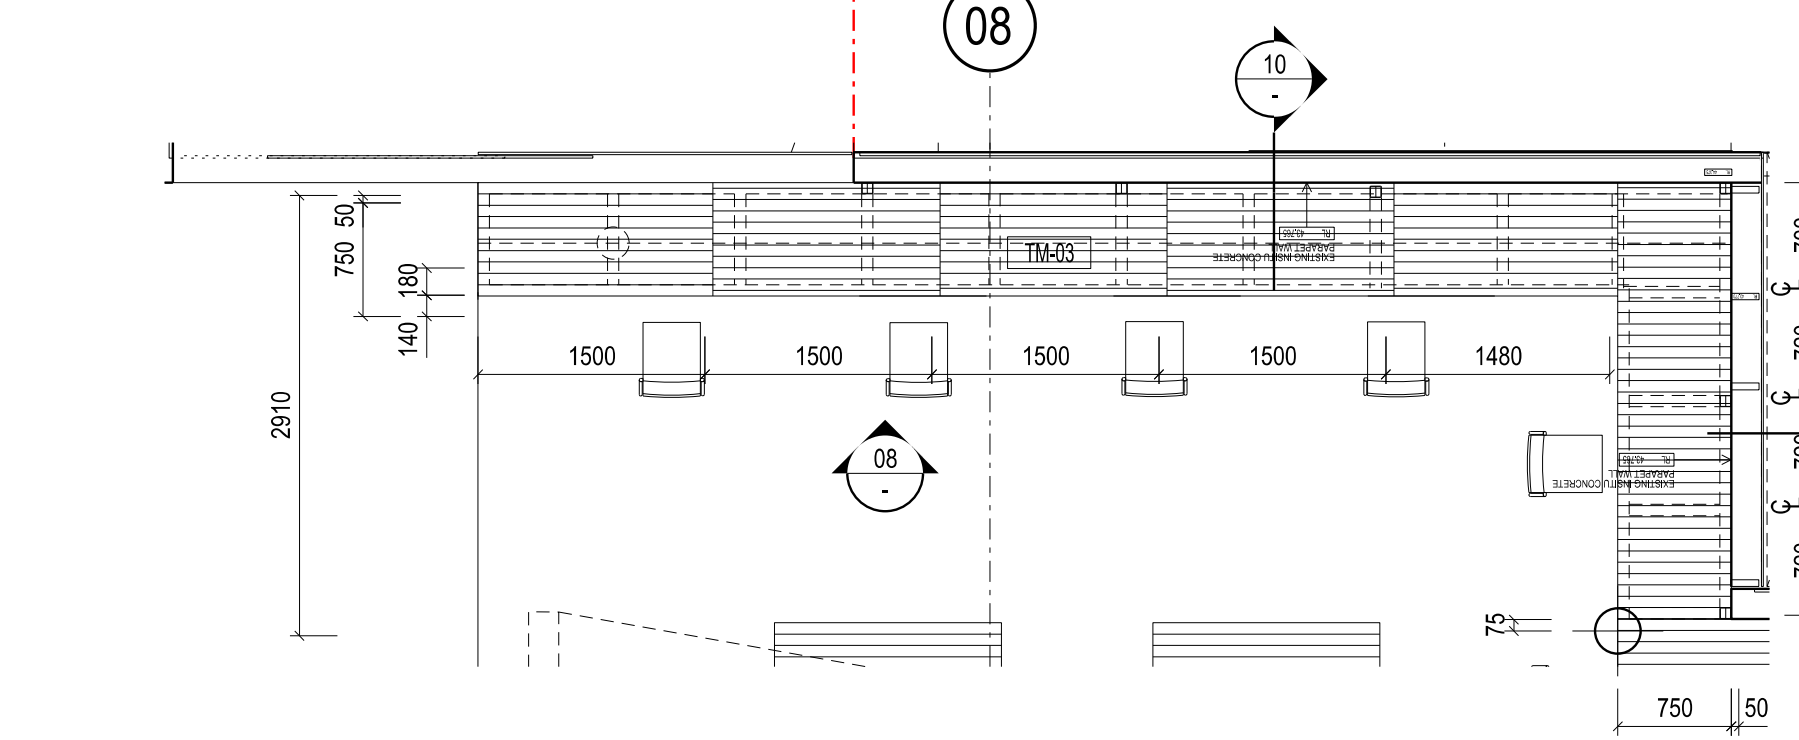


180 PLAN - J0G-31A - E - WORKBENCH  
SCALE 1:50

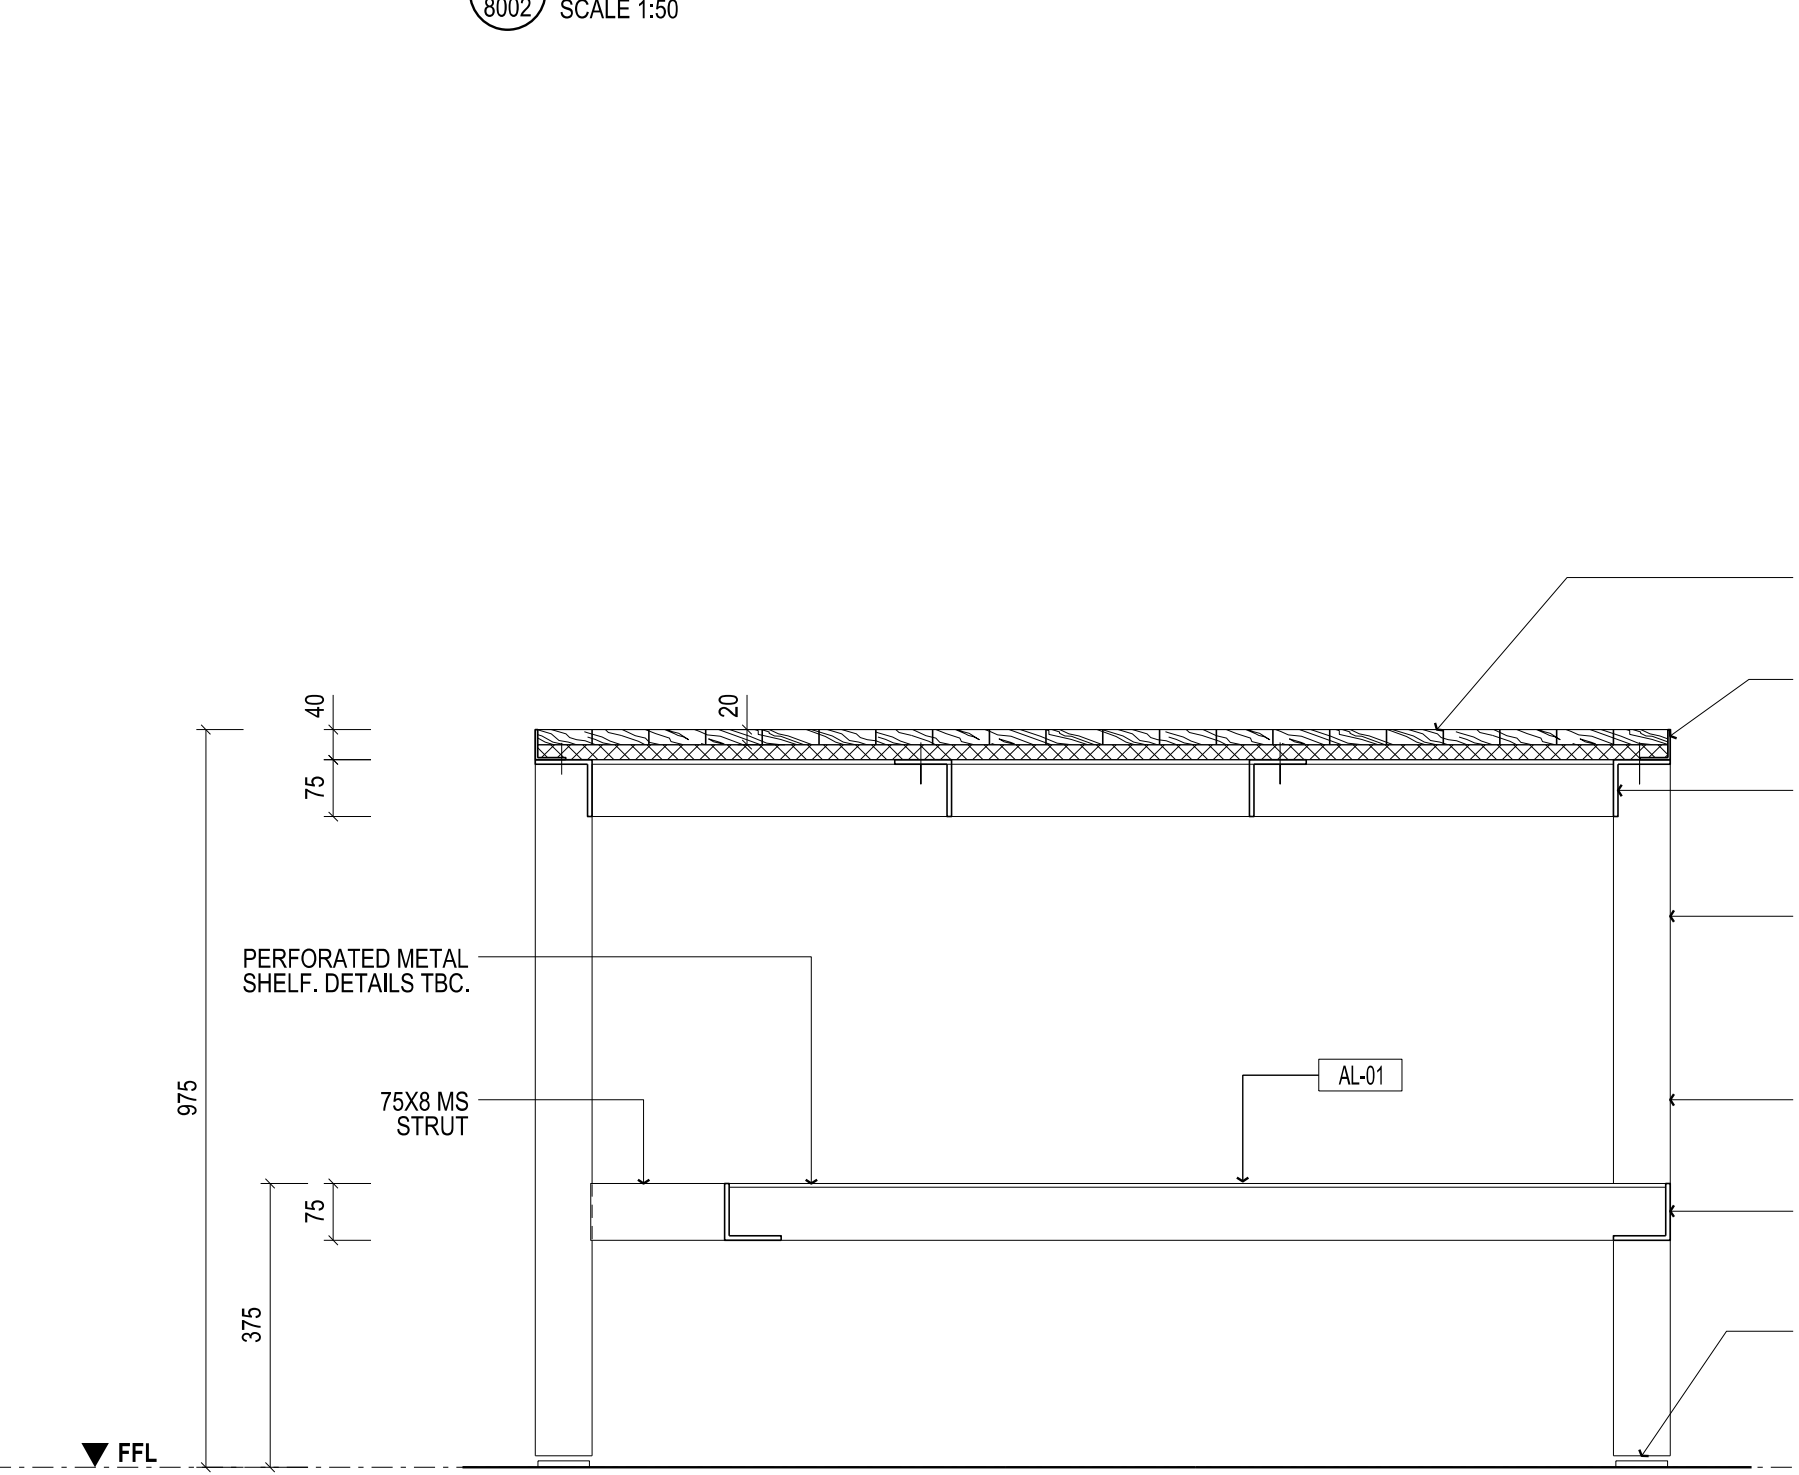


160 SECTION - J0G-31A - E - WORKBENCH  
SCALE 1:10

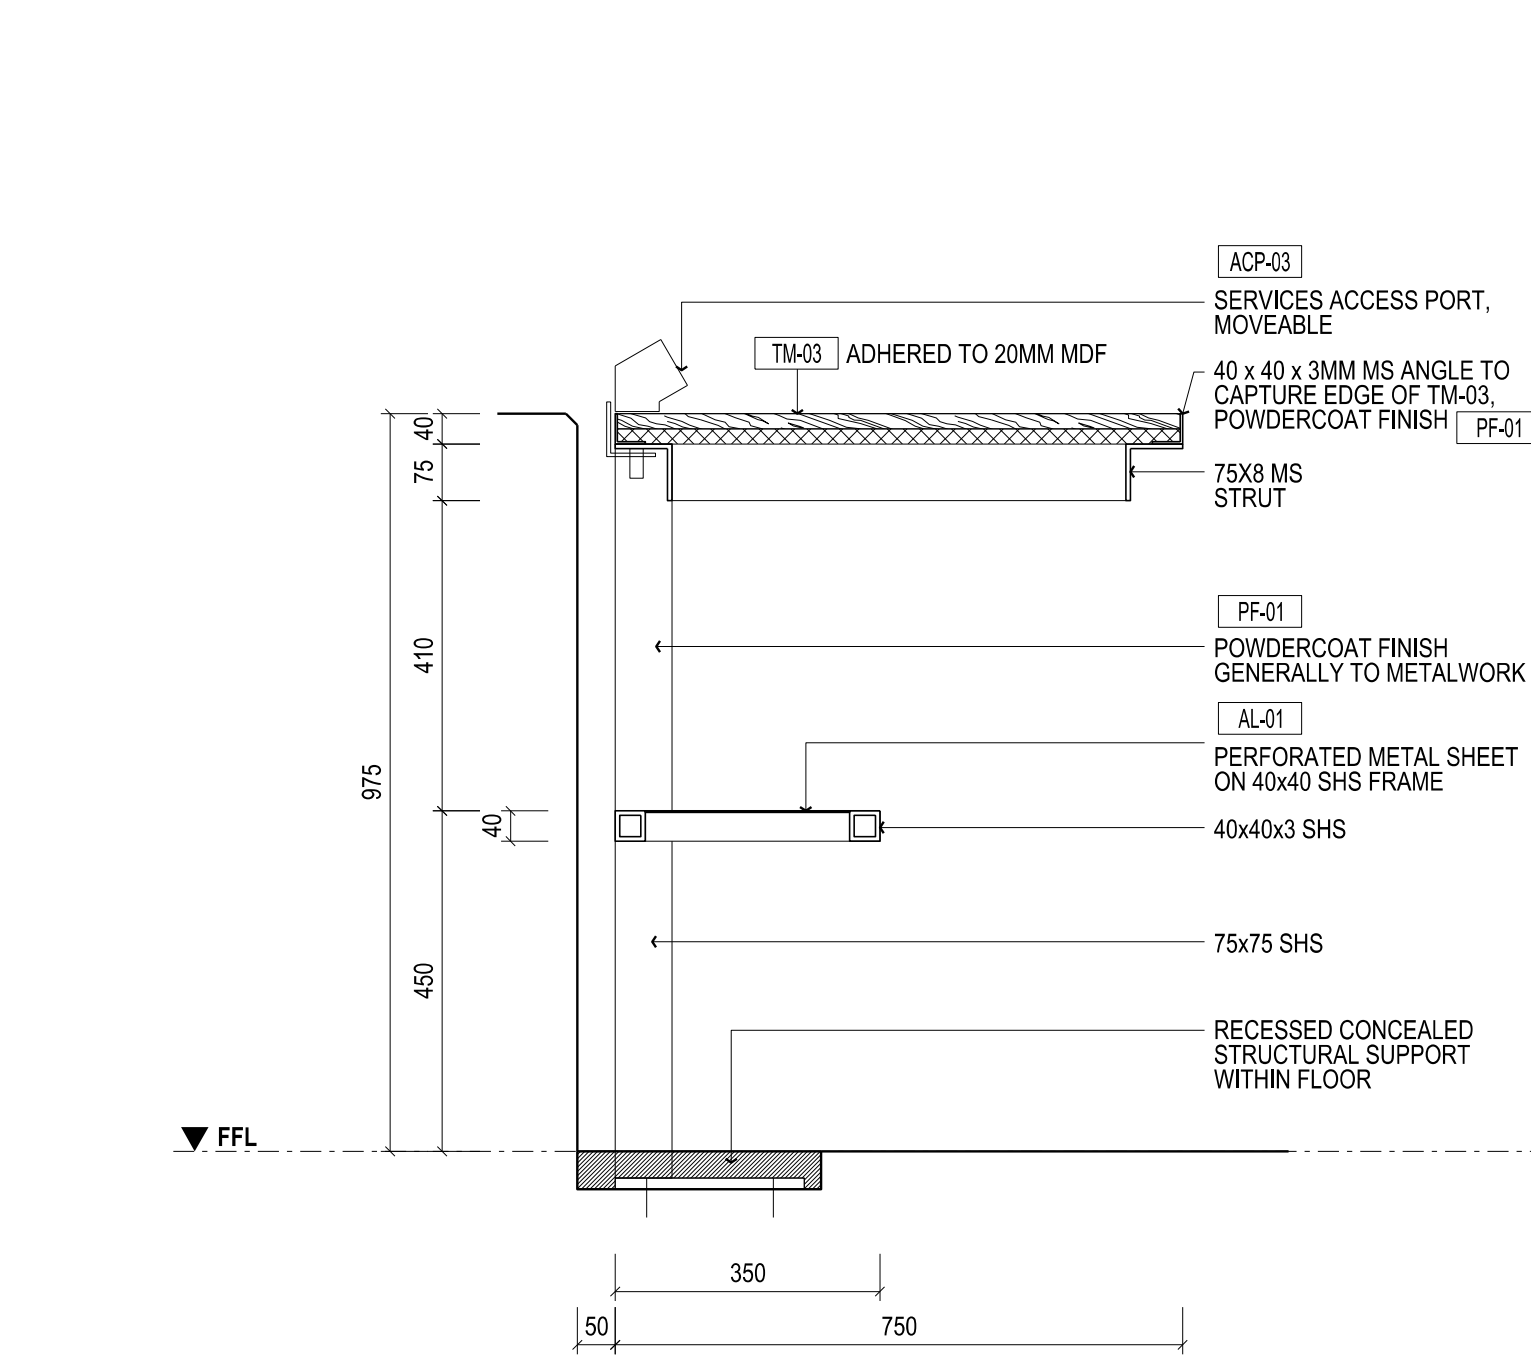


10 SECTION  
SCALE 1:10

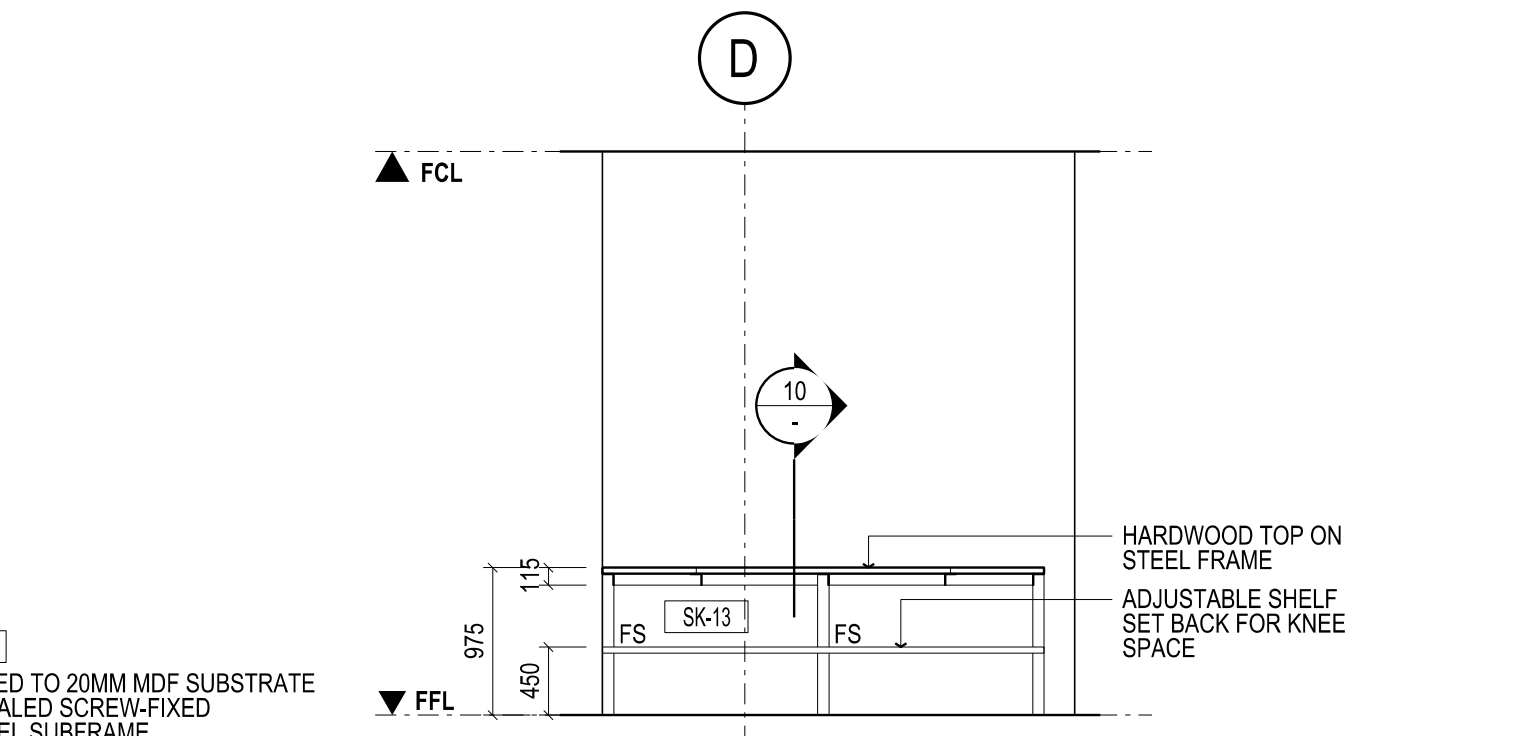


18 ELEVATION  
SCALE 1:50

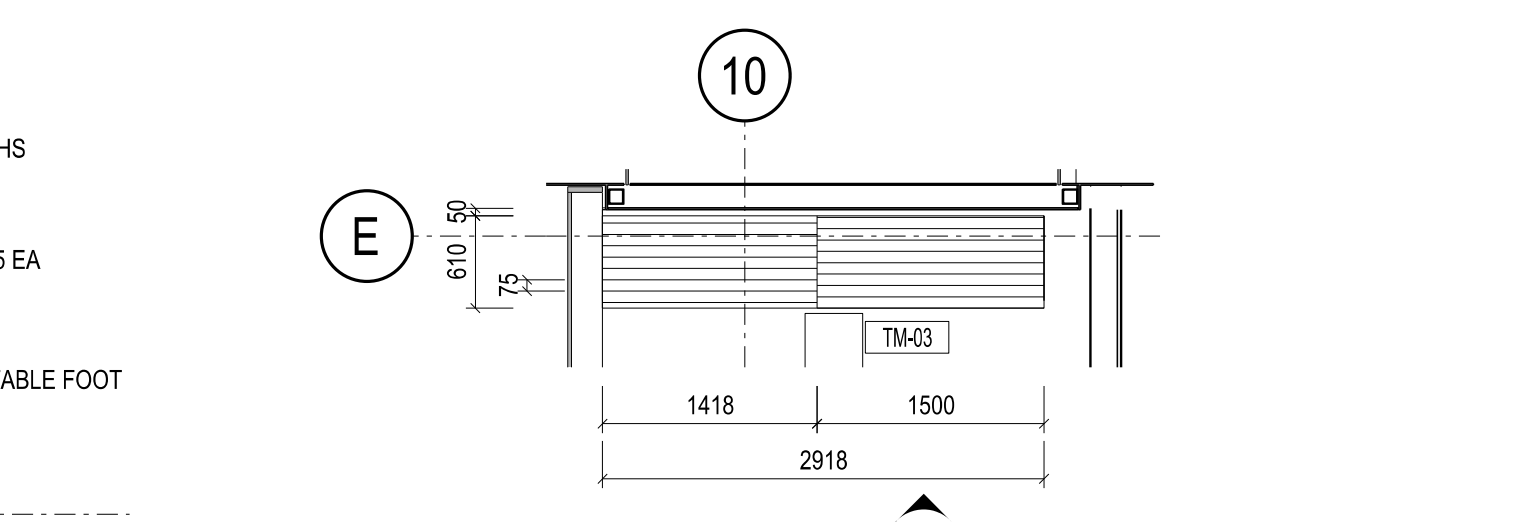


17 PLAN - J0G-32 - WORKBENCH  
SCALE 1:50

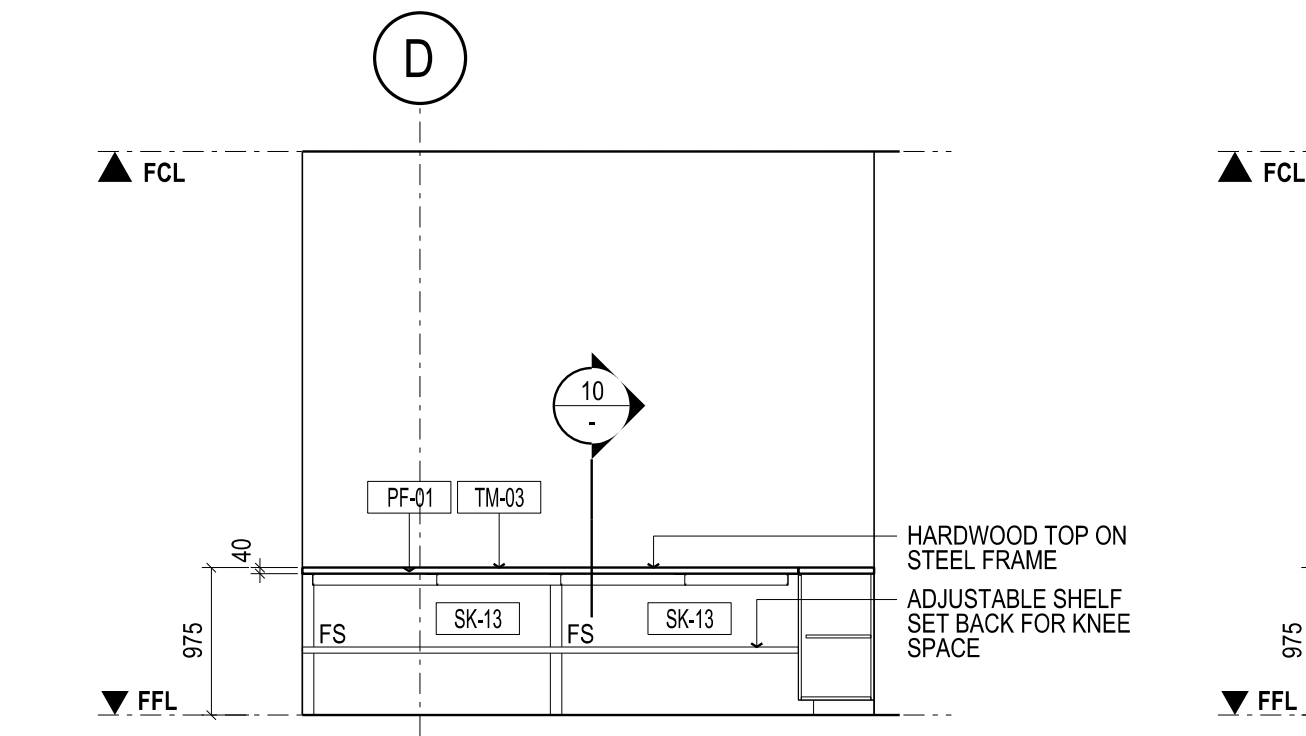

12 ELEVATION  
SCALE 1:50

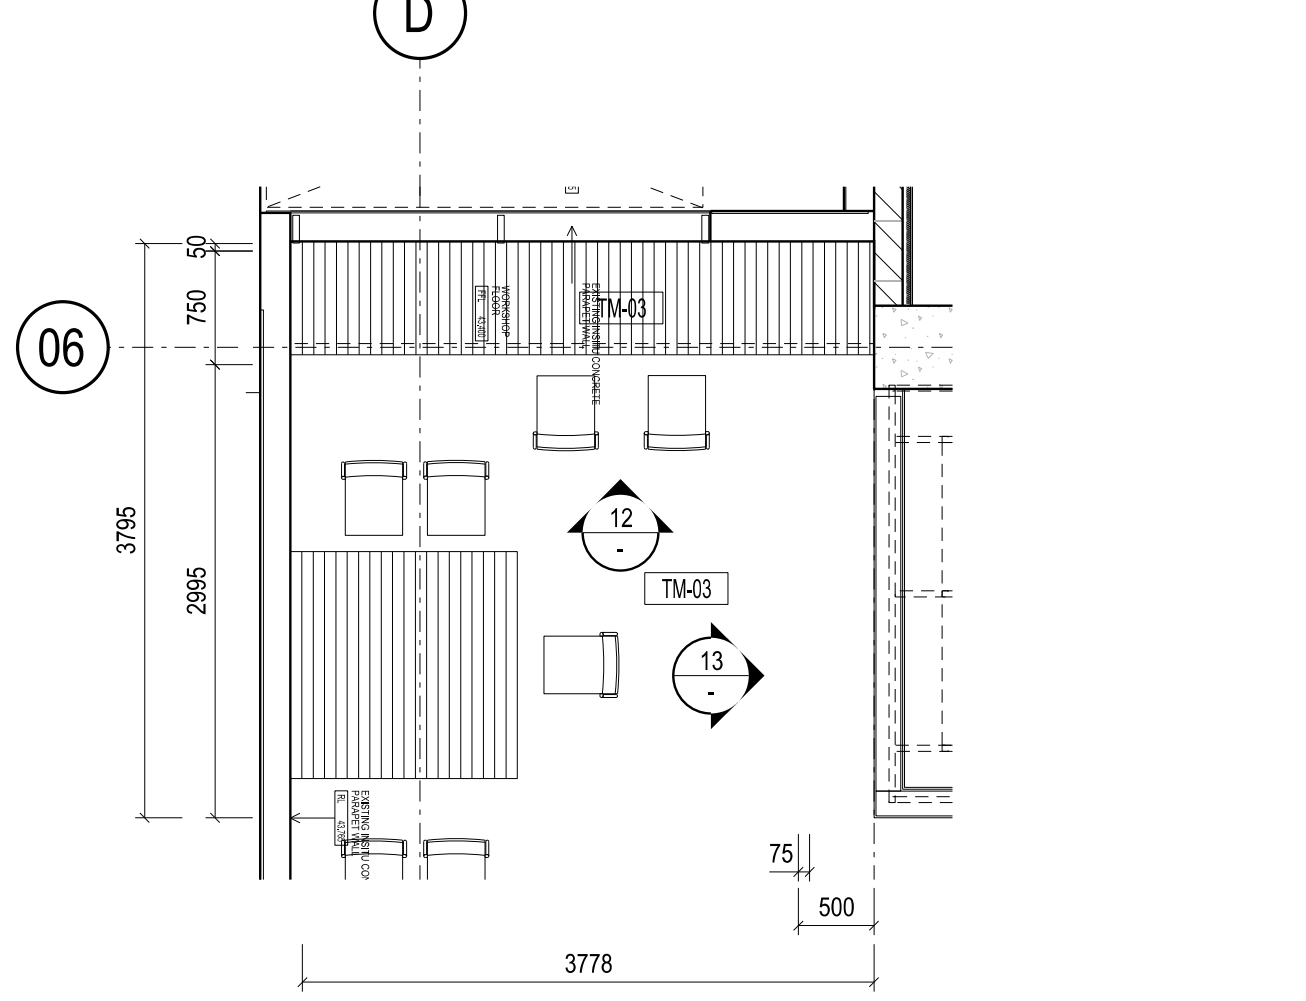

11 PLAN - J0G-30 - WORKBENCH / STORAGE  
SCALE 1:50

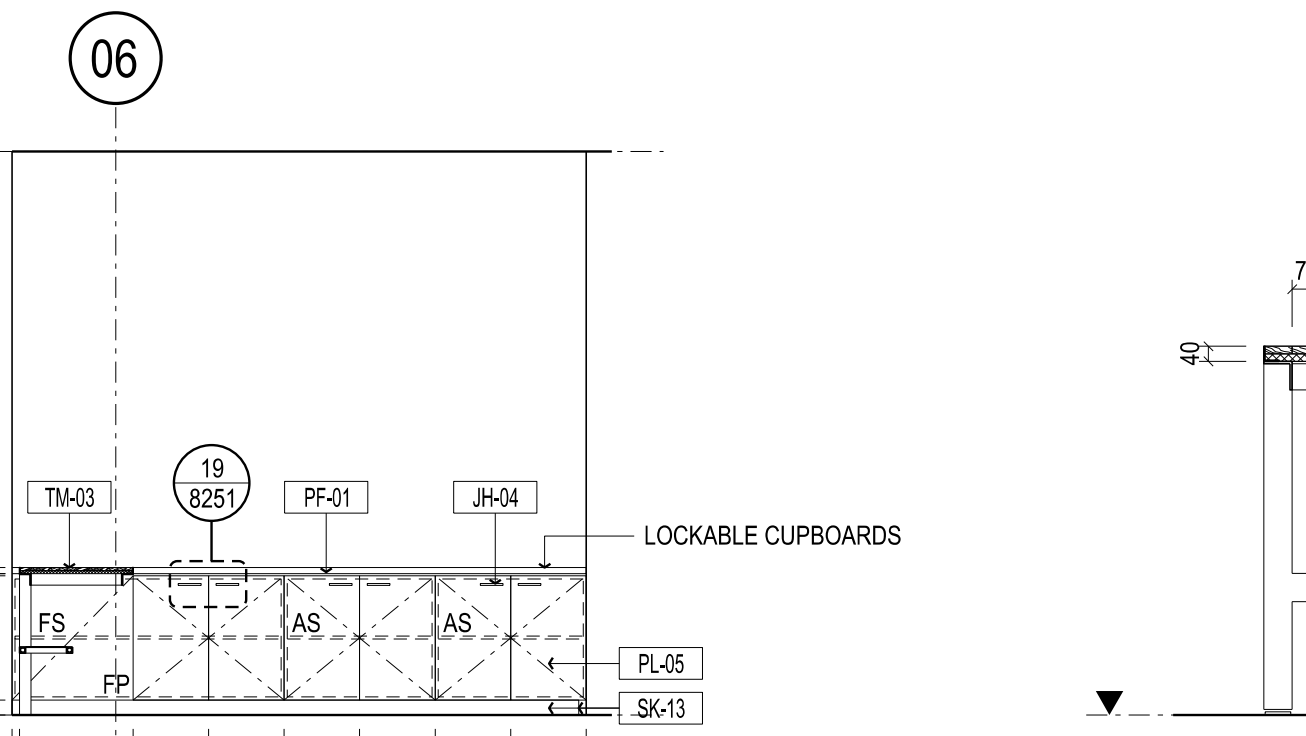

13 ELEVATION  
SCALE 1:50



15 ELEVATION  
SCALE 1:20



14 PLAN - J0G-31A - E - WORKBENCH  
SCALE 1:20

THIS DRAWING IS AN UNCONTROLLED COPY UNLESS STAMPED OTHERWISE

CONTRACTORS SHALL VERIFY JOB DIMENSIONS BEFORE ANY JOB COMMENCES. ALL SHOP DRAWINGS SHALL BE SUBMITTED TO THE SUPERINTENDENT AND MANUFACTURE SHALL NOT COMMENCE PRIOR TO THE RETURN OF DIMENSIONS. SHOP DRAWINGS ISSUED BY THE CONSULTANT REQUIRED DIMENSIONS SHALL TAKE PRECEDENCE OVER SCALED. THIS DRAWING SHOULD BE READ IN CONJUNCTION WITH ALL RELEVANT CONTRACT SPECIFICATIONS AND DRAWING COPYRIGHT OF THIS DRAWING IS VESTED IN WARDLE.

General Notes

18mm E1 MDF CARCASS THROUGHOUT UNLESS OTHERWISE NOTED.

ALL NON EXPOSED CARCASS TO BE MATCHING LAMINATE UNLESS OTHERWISE NOTED.

ALL NON EXPOSED CARCASS TO BE BLACK LAMINATE TO JOINERY RECEIVING TIMBER VENEER FINISH. REFER MATERIALS SCHEDULE [ PL-05 ]

ALL NON EXPOSED CARCASS TO BE WHITE LAMINATE TO JOINERY RECEIVING STAINLESS STEEL CLADDING. REFER MATERIALS SCHEDULE [ PL-07 ]

ALL EXPOSED EDGES TO TIMBER VENEER PANELS TV-01 TO RECEIVE 3mm THK MATCHING SOLID EDGES. UNLESS OTHERWISE NOTED.

SPLIT BATTENS TO BE 12mm UNLESS OTHERWISE NOTED.

APPLY MATCHING LAMINATE ABS EDGING TO LAMINATED BENCHTOPS. UNLESS OTHERWISE NOTED

REFER TO '1300 - MATERIALS SCHEDULE' FOR A DESCRIPTION OF THE MATERIAL CODES AS SHOWN ON THIS DRAWING. [ TV-02 ]

REFER TO '1400 - FIXTURES, FITTINGS & EQUIPMENT SCHEDULE' FOR A DESCRIPTION OF THE FF&E CODES AS SHOWN ON THIS DRAWING. [ JH-02 ]

ALL JOINERY LOCKS TO BE [ JH-02 ] UNLESS OTHERWISE NOTED.

REFER TO DRAWING AR7300 FOR MOUNTING HEIGHTS FOR ALL SERVICES. FIXTURES. UNLESS OTHERWISE DIMENSIONED ON THE JOINERY ELEVATIONS.

ALL CORNER JUNCTIONS TO BE MITRED UNLESS OTHERWISE NOTED.

ALL UPHOLSTERY STITCHING TOO MATCH FABRIC COLOUR UNLESS OTHERWISE NOTED

DRAWINGS TO BE READ IN CONJUNCTION WITH AR1200 SERIES INTERNAL ARRANGEMENT PLANS TO COORDINATE FININGS INTO PARTITIONS WHERE NECESSARY

FS = FIXED SHELF

AS = ADJUSTABLE SHELF

FP = FIXED PANEL

PJ = PANEL JOIN. MAXIMUM WIDTH 2mm

C.O.S = CHECK ON SITE - DIMENSIONS MUST BE VERIFIED ON SITE BY CONTRACTOR PRIOR TO COMMENCEMENT OF CONSTRUCTION.

NCM = NOMINAL

TYP. = TYPICAL

SIM. = SIMILAR

MIRR. = MIRROR

FCL = FINISHED CEILING LEVEL

FFL = FINISHED FLOOR LEVEL

SSL = STRUCTURAL SLAB LEVEL

C = CENTRELINE

Direction of Grain / Finish