




01 ELEVATION SCALE 1:50

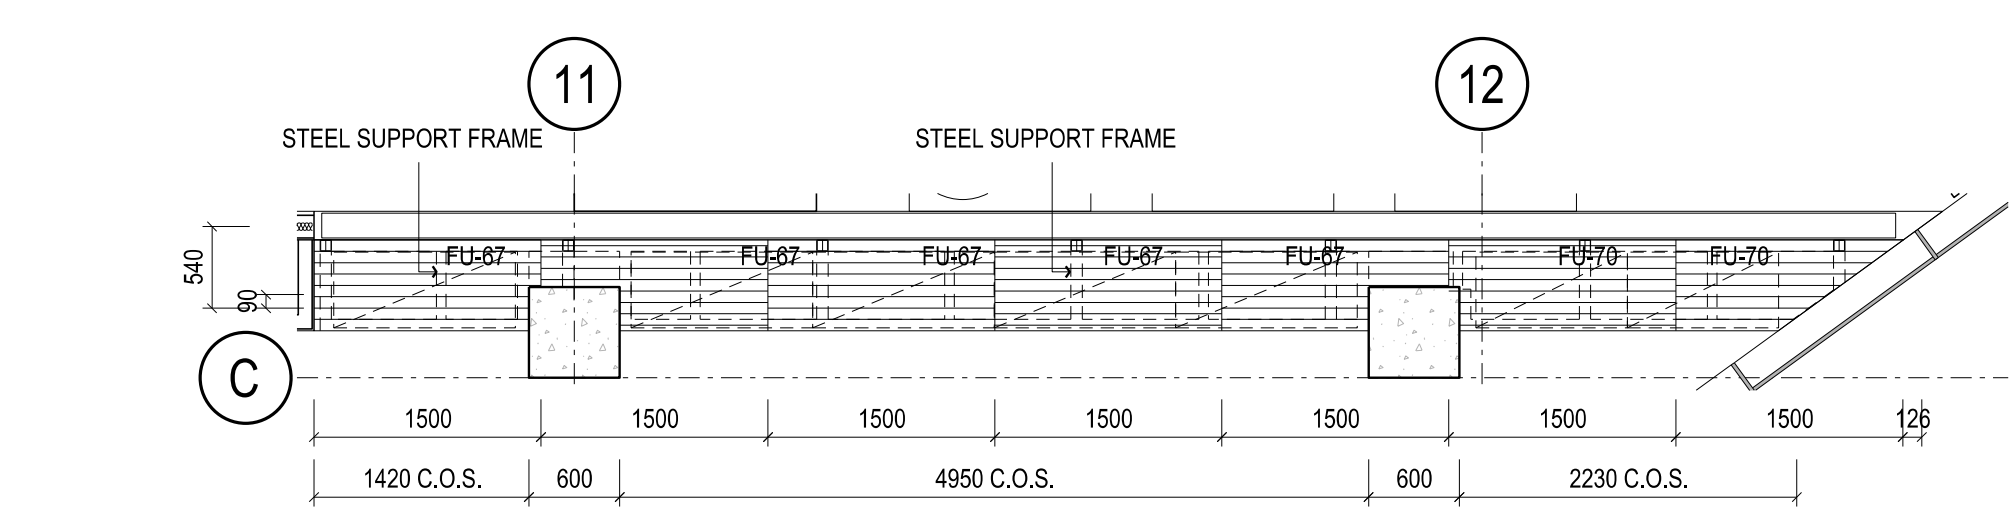


01 PLAN - J0G-33 - STORAGE - ROOM G23 SCALE 1:50

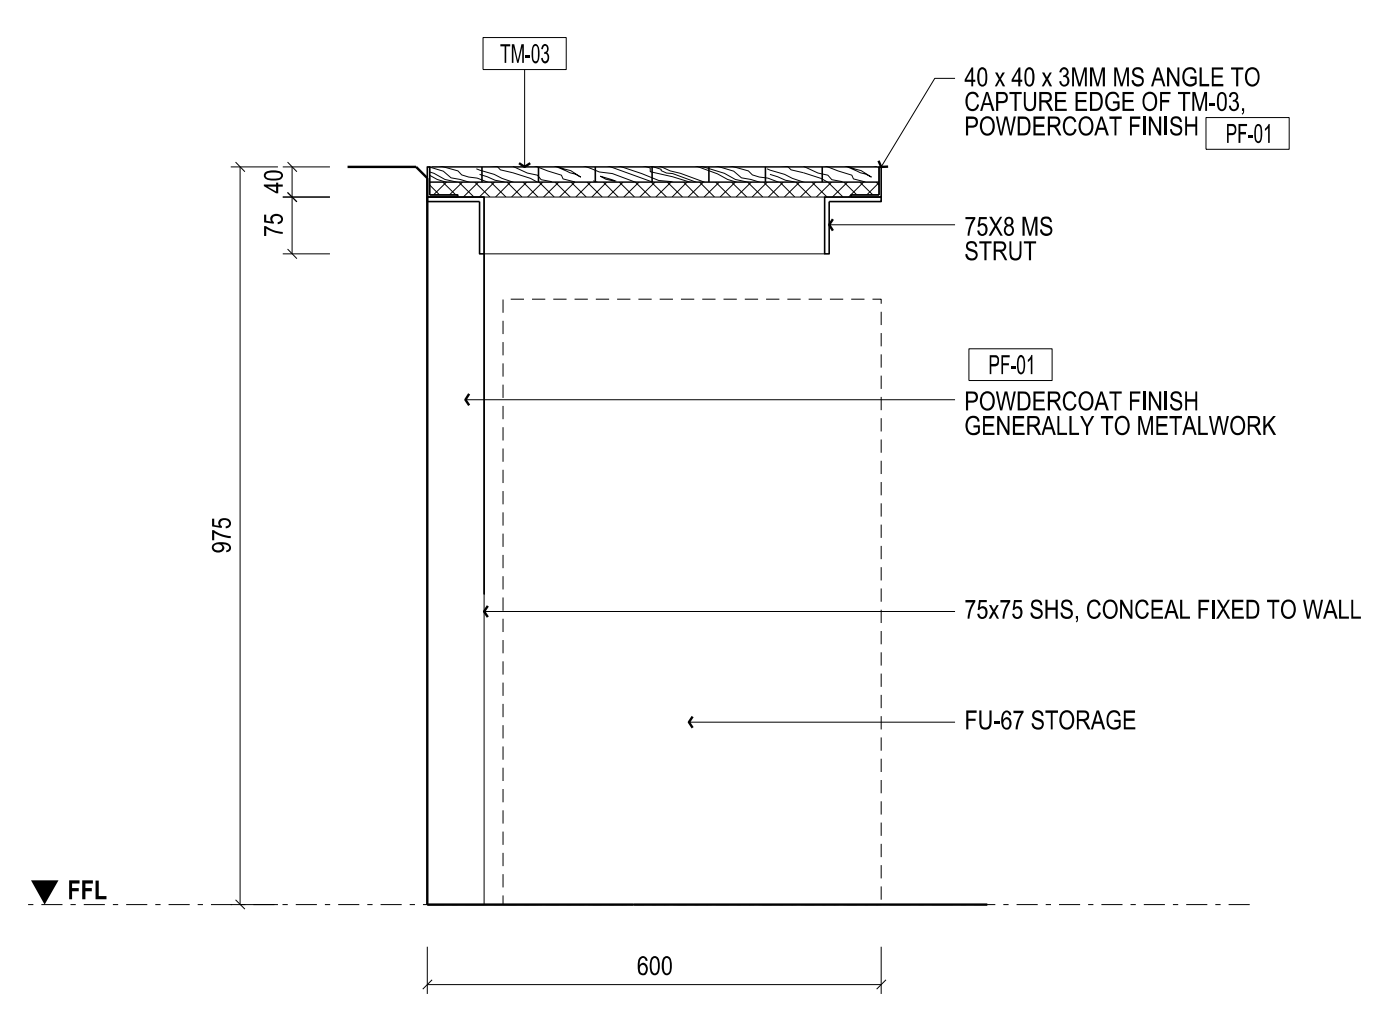


03 SECTION SCALE 1:10

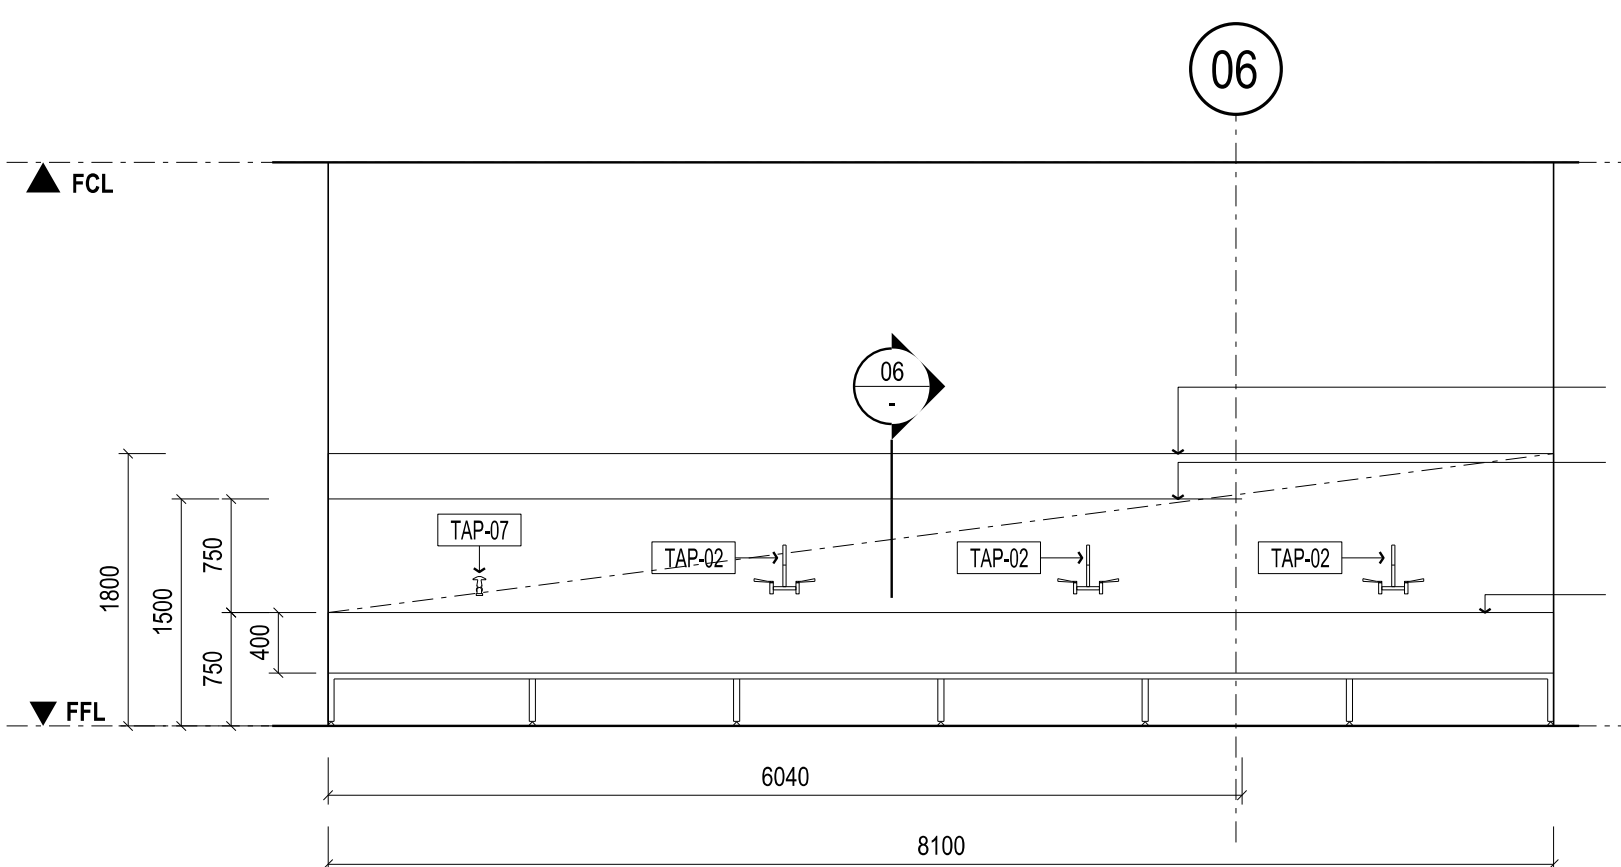


06 ELEVATION SCALE 1:50

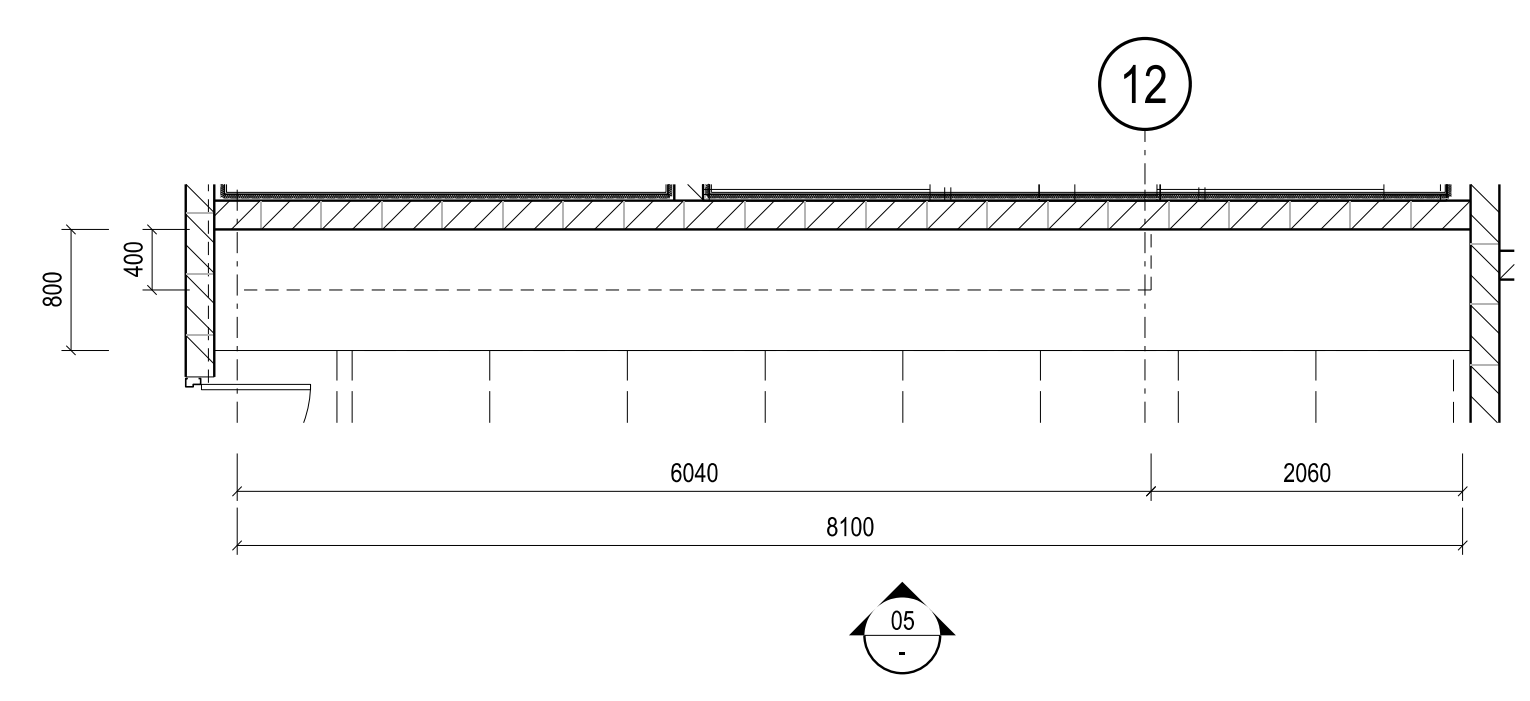


04 PLAN - J0G-34 - WASH BENCH SCALE 1:50

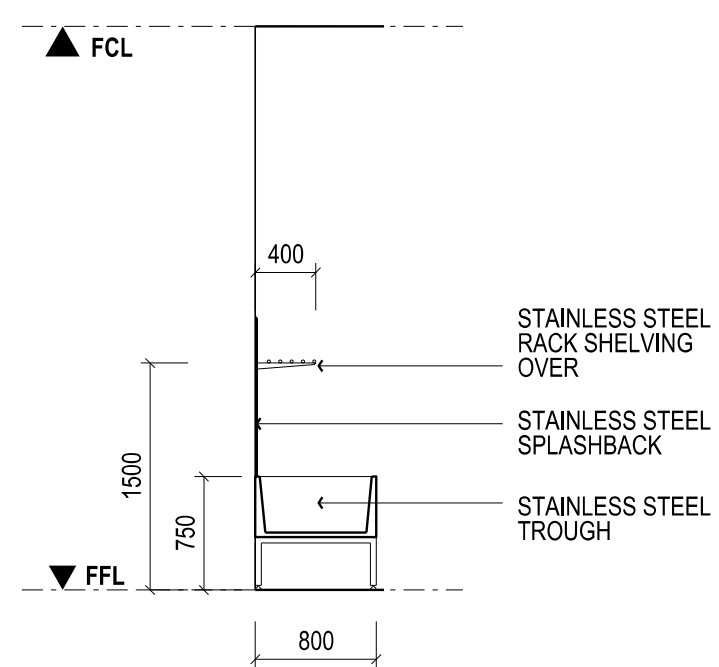


06 ELEVATION SCALE 1:50

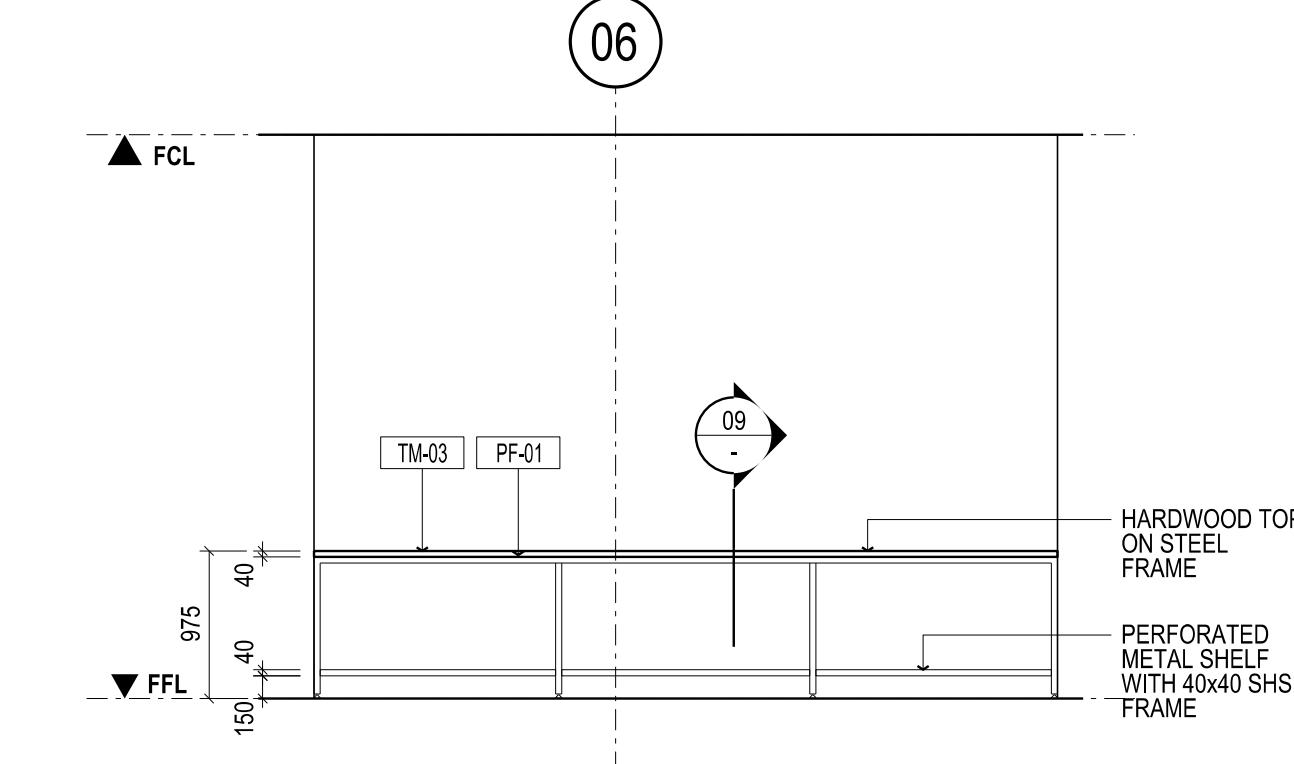

08 ELEVATION SCALE 1:50

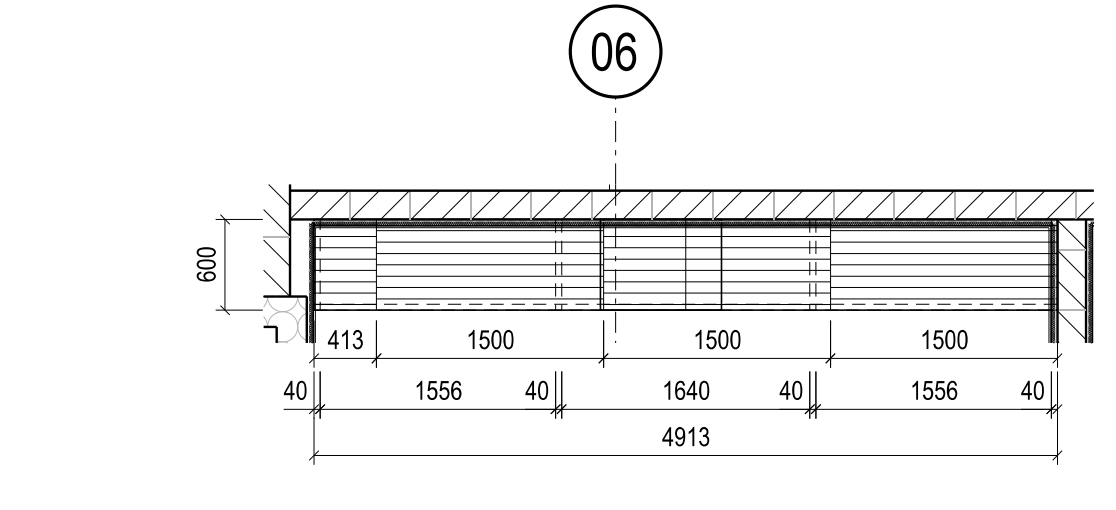

07 PLAN - J0G-35 - DRILL BENCH SCALE 1:50

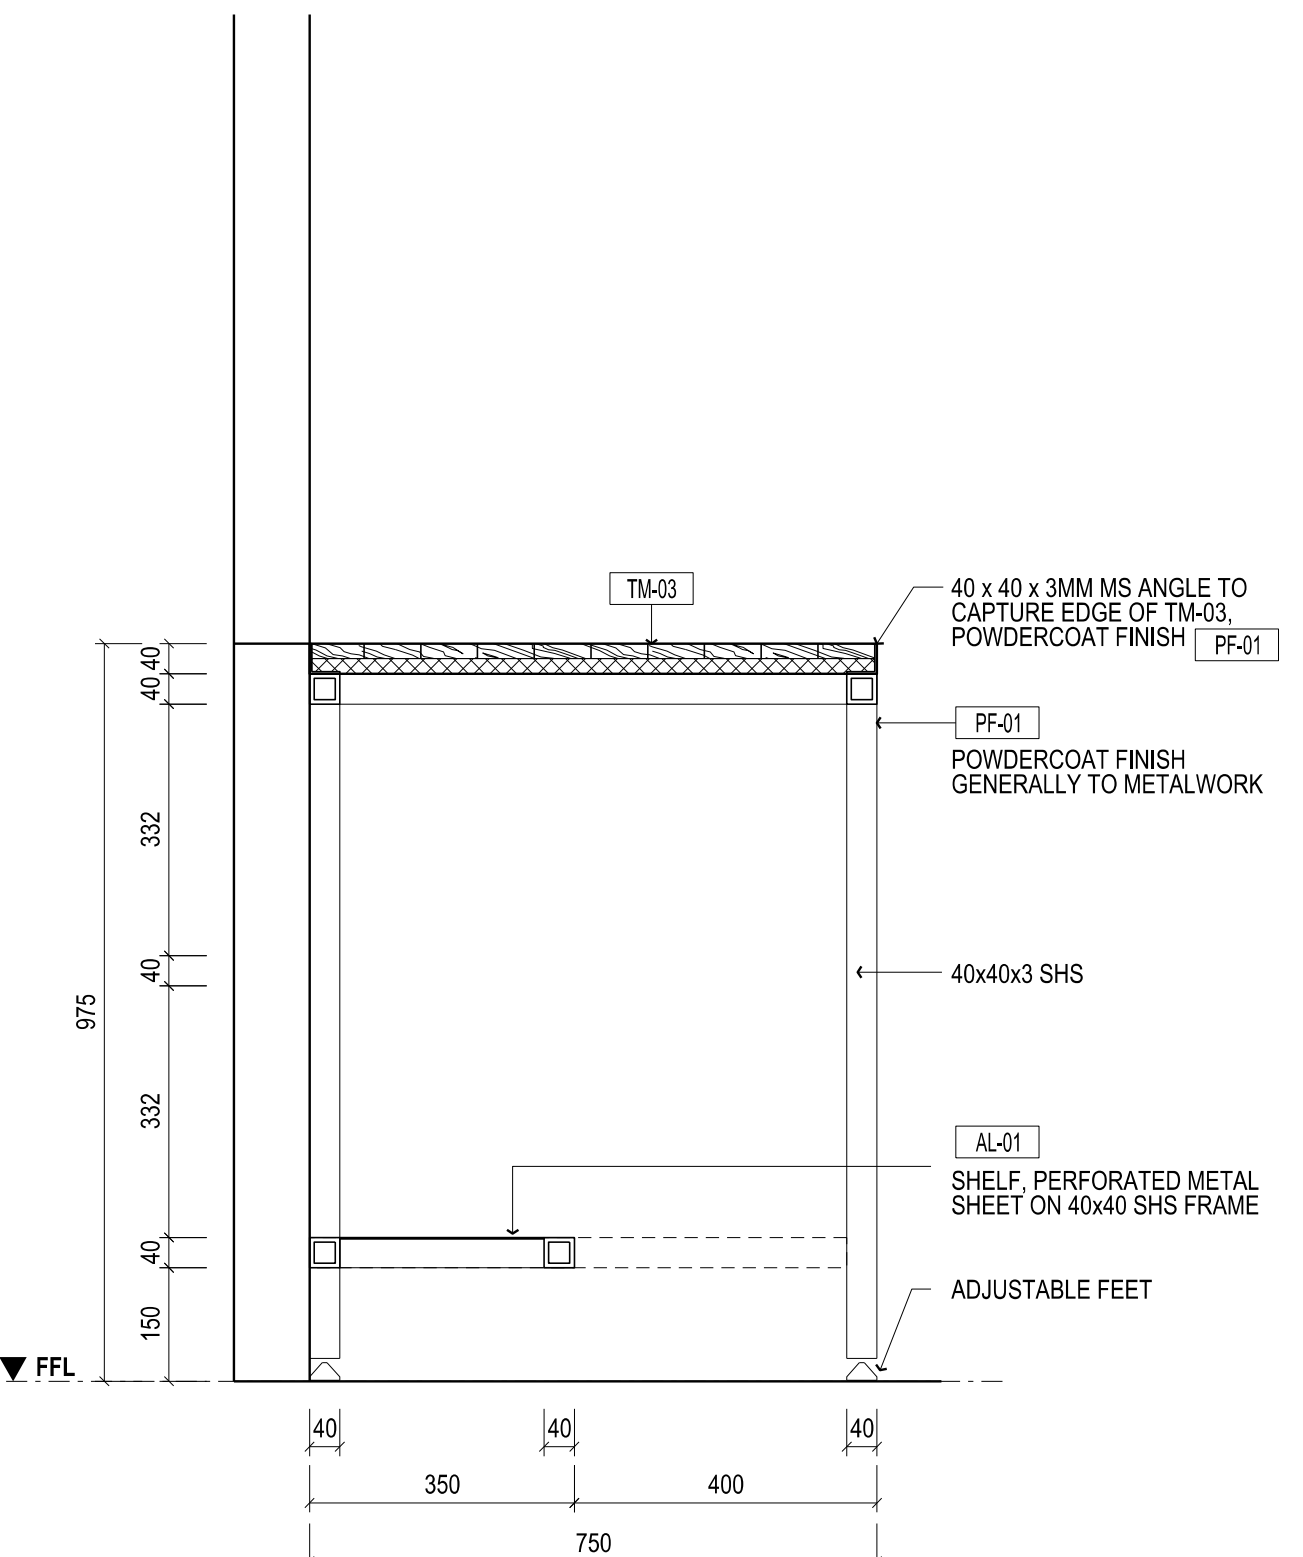

09 SECTION SCALE 1:10

THIS DRAWING IS AN UNCONTROLLED COPY UNLESS STAMPED OTHERWISE

CONTRACTORS SHALL VERIFY JOB DIMENSIONS BEFORE ANY JOB COMMENCES. ALL SHOP DRAWINGS SHALL BE SUBMITTED TO THE SUPERINTENDENT AND MANUFACTURER SHALL NOT COMMENCE PRIOR TO THE RETURN OF DRAWINGS MARKED BY THE CONSULTANT. DIMENSIONS SHALL TAKE PRECEDENCE OVER SCALES. THIS DRAWING SHALL BE READ IN CONJUNCTION WITH ALL RELEVANT CONTRACT SPECIFICATIONS AND DRAWINGS COPYRIGHT OF THIS DRAWING IS VESTED IN NADAAA.

General Notes

18mm E1 MDF CARCASS THROUGHOUT UNLESS OTHERWISE NOTED.

ALL NON EXPOSED CARCASS TO BE MATCHING LAMINATE UNLESS OTHERWISE NOTED.

ALL NON EXPOSED CARCASS TO BE BLACK LAMINATE TO JOINERY RECEIVING TIMBER VENEER FINISH. REFER MATERIALS SCHEDULE [PL45]

ALL NON EXPOSED CARCASS TO BE WHITE LAMINATE TO JOINERY RECEIVING STAINLESS STEEL CLADDING. REFER MATERIALS SCHEDULE [PL47]

ALL EXPOSED EDGES TO TIMBER VENEER PANELS TV-01 TO RECEIVE 3mm THK MATCHING SOLID EDGES UNLESS OTHERWISE NOTED.

SPLIT BATTENS TO BE 12mm UNLESS OTHERWISE NOTED.

APPLY MATCHING LAMINATE ABS EDGING TO LAMINATED BENCHTOPS, UNLESS OTHERWISE NOTED.

REFER TO '1300 - MATERIALS SCHEDULE' FOR A DESCRIPTION OF THE MATERIAL CODES AS SHOWN ON THIS DRAWING. [TV40]

REFER TO '1400 - FIXTURES, FITTINGS & EQUIPMENT SCHEDULE' FOR A DESCRIPTION OF THE FFAE CODES AS SHOWN ON THIS DRAWING. [J2400]

ALL JOINERY LOCKS TO BE [J42] UNLESS OTHERWISE NOTED.

REFER TO DRAWING AR7300 FOR MOUNTING HEIGHTS FOR ALL SERVICES. FIXTURES, UNLESS OTHERWISE DIMENSIONED ON THE JOINERY ELEVATIONS.

ALL CORNER JUNCTIONS TO BE MITRED UNLESS OTHERWISE NOTED.

ALL UPHOLSTERY STITCHING TOO MATCH FABRIC COLOUR UNLESS OTHERWISE NOTED.

DRAWINGS TO BE READ IN CONJUNCTION WITH AR1200 SERIES INTERNAL ARRANGEMENT PLANS TO COORDINATE FIXINGS INTO PARTITIONS WHERE NECESSARY.

FS = FIXED SHELF
 AS = ADJUSTABLE SHELF
 FP = FIXED PANEL
 PJ = PANEL JOIN. MAXIMUM WIDTH 2mm

C.O.S. = CHECK ON SITE - DIMENSIONS MUST BE VERIFIED ON SITE BY CONTRACTOR PRIOR TO COMMENCEMENT OF CONSTRUCTION.

NCM = NOMINAL
 TYP. = TYPICAL
 SM. = SIMILAR
 MIRR. = MIRROR
 FCL = FINISHED CEILING LEVEL
 FFL = FINISHED FLOOR LEVEL
 SSL = STRUCTURAL SLAB LEVEL
 C = CENTRELINE
 ↻ = DIRECTION OF GRAIN / FINISH

Rev	Issue	Revision Description	And	Date
A	SC	ISSUE FOR CONSTRUCTION	-	19.11.13
05	SG	VALUE MANAGEMENT ISSUE	-	28.03.13
04	SG	100% CD - TENDER ISSUE	-	07.09.12
03	SG	90% CD ISSUE	-	10.08.12
02	SG	75% CD ISSUE	-	13.07.12
01	SG	55% CD ISSUE	-	01.06.12



NADAAA

NADAAA
 1520 Washington Street No.2
 Boston Massachusetts 02118 USA

Telephone +1 617 442 8232
 Facsimile +1 688 442 1417
 Email nadaaa@nadaaa.com

John Wardle Architects

25 Rokeby Street, Collingwood, Victoria 3066 Australia
 Tel : +61 3 8662 0400 www.johnwardlearchitects.com
 © 2012 John Wardle Architects ABN 83 006 814 268

Client **University of Melbourne Parkville Campus**

Project **Faculty of Architecture Building and Planning**

Title **JOINERY DETAILS**

	Project No.	0913	Scale	1:20 @ A0 1:40 @ A2			
	Drawing No.	AR8167	Revision	A			
Date	Dec 2011	Dwn	SC	Co-Ord	SG	Chk	JA

FILENAME - \$FILES

FOR CONSTRUCTION