

THIS DRAWING IS AN UNCONTROLLED COPY UNLESS STAMPED OTHERWISE

CONTRACTORS SHALL VERIFY JOB DIMENSIONS BEFORE ANY JOB COMMENCES. ALL SHOP DRAWINGS SHALL BE SUBMITTED TO THE SUPERINTENDENT AND MANUFACTURER SHALL NOT COMMENCE FROM THE RETURN OF DRAWINGS SHOWN. BY THE CONSULTANT. DIMENSIONS SHALL TAKE PRECEDENCE OVER SCALES. THIS DRAWING SHOULD BE READ IN CONJUNCTION WITH ALL RELEVANT CONTRACT SPECIFICATIONS AND DRAWINGS COPYRIGHT OF THIS DRAWING IS VESTED IN WARDLE

General Notes

- 18mm E1 MDF CARCASS THROUGHOUT UNLESS OTHERWISE NOTED.
- ALL NON EXPOSED CARCASS TO BE MATCHING LAMINATE UNLESS OTHERWISE NOTED.
- ALL NON EXPOSED CARCASS TO BE BLACK LAMINATE TO JOINERY RECEIVING TIMBER VENEER FINISH, REFER MATERIALS SCHEDULE [PL-05]
- ALL NON EXPOSED CARCASS TO BE WHITE LAMINATE TO JOINERY RECEIVING STAINLESS STEEL CLADDING, REFER MATERIALS SCHEDULE [PL-01]
- ALL EXPOSED EDGES TO TIMBER VENEER PANELS TV-01 TO RECEIVE 3mm THK MATCHING SOLID EDGES, UNLESS OTHERWISE NOTED.
- SPLIT BATTENS TO BE 12mm UNLESS OTHERWISE NOTED.
- APPLY MATCHING LAMINATE ABS EDGING TO LAMINATED BENCHTOPS, UNLESS OTHERWISE NOTED.
- REFER TO '1300 - MATERIALS SCHEDULE' FOR A DESCRIPTION OF THE MATERIAL CODES AS SHOWN ON THIS DRAWING. [TV-00]
- REFER TO '1400 - FIXTURES, FITTINGS & EQUIPMENT SCHEDULE' FOR A DESCRIPTION OF THE FFAE CODES AS SHOWN ON THIS DRAWING. [JH-00]
- ALL JOINERY LOCKS TO BE [JH-02] UNLESS OTHERWISE NOTED.
- REFER TO DRAWING AR7300 FOR MOUNTING HEIGHTS FOR ALL SERVICES, FIXTURES, UNLESS OTHERWISE DIMENSIONED ON THE JOINERY ELEVATIONS.
- ALL CORNER JUNCTIONS TO BE MITRED UNLESS OTHERWISE NOTED.
- ALL UPHOLSTERY STITCHING TO MATCH FABRIC COLOUR UNLESS OTHERWISE NOTED.


DRAWINGS TO BE READ IN CONJUNCTION WITH AR1000 SERIES INTERNAL ARRANGEMENT PLANS TO COORDINATE FIXINGS INTO PARTITIONS WHERE NECESSARY

- FS = FIXED SHELF
- AS = ADJUSTABLE SHELF
- FP = FIXED PANEL
- PJ = PANEL JOINT, MAXIMUM WIDTH 2mm


C.O.S = CHECK ON SITE - DIMENSIONS MUST BE VERIFIED ON SITE BY CONTRACTOR PRIOR TO COMMENCEMENT OF CONSTRUCTION.

- NOM. = NOMINAL
- TYP. = TYPICAL
- SM. = SIMILAR
- MIRR. = MIRROR
- FCL = FINISHED CEILING LEVEL
- FFL = FINISHED FLOOR LEVEL
- SSL = STRUCTURAL SLAB LEVEL
- C = CENTRELINE
- ↻ = DIRECTION OF GRAIN / FINISH


Rev	Issue	Revision Description	And	Date
B	SG	NOTES ADDED RE: AV CLIPBD FANSLIGHTING & VENTILATION	-	02.03.14
A	SG	ISSUE FOR CONSTRUCTION	-	19.12.13
05	SG	TENDER ADDENDUM NO. 05	-	17.10.12
04	SG	100% CD - TENDER ISSUE	-	07.09.12
03	SG	90% CD ISSUE	-	10.08.12
02	SG	75% CD ISSUE	-	13.07.12
01	SG	25% CD ISSUE	-	20.04.12

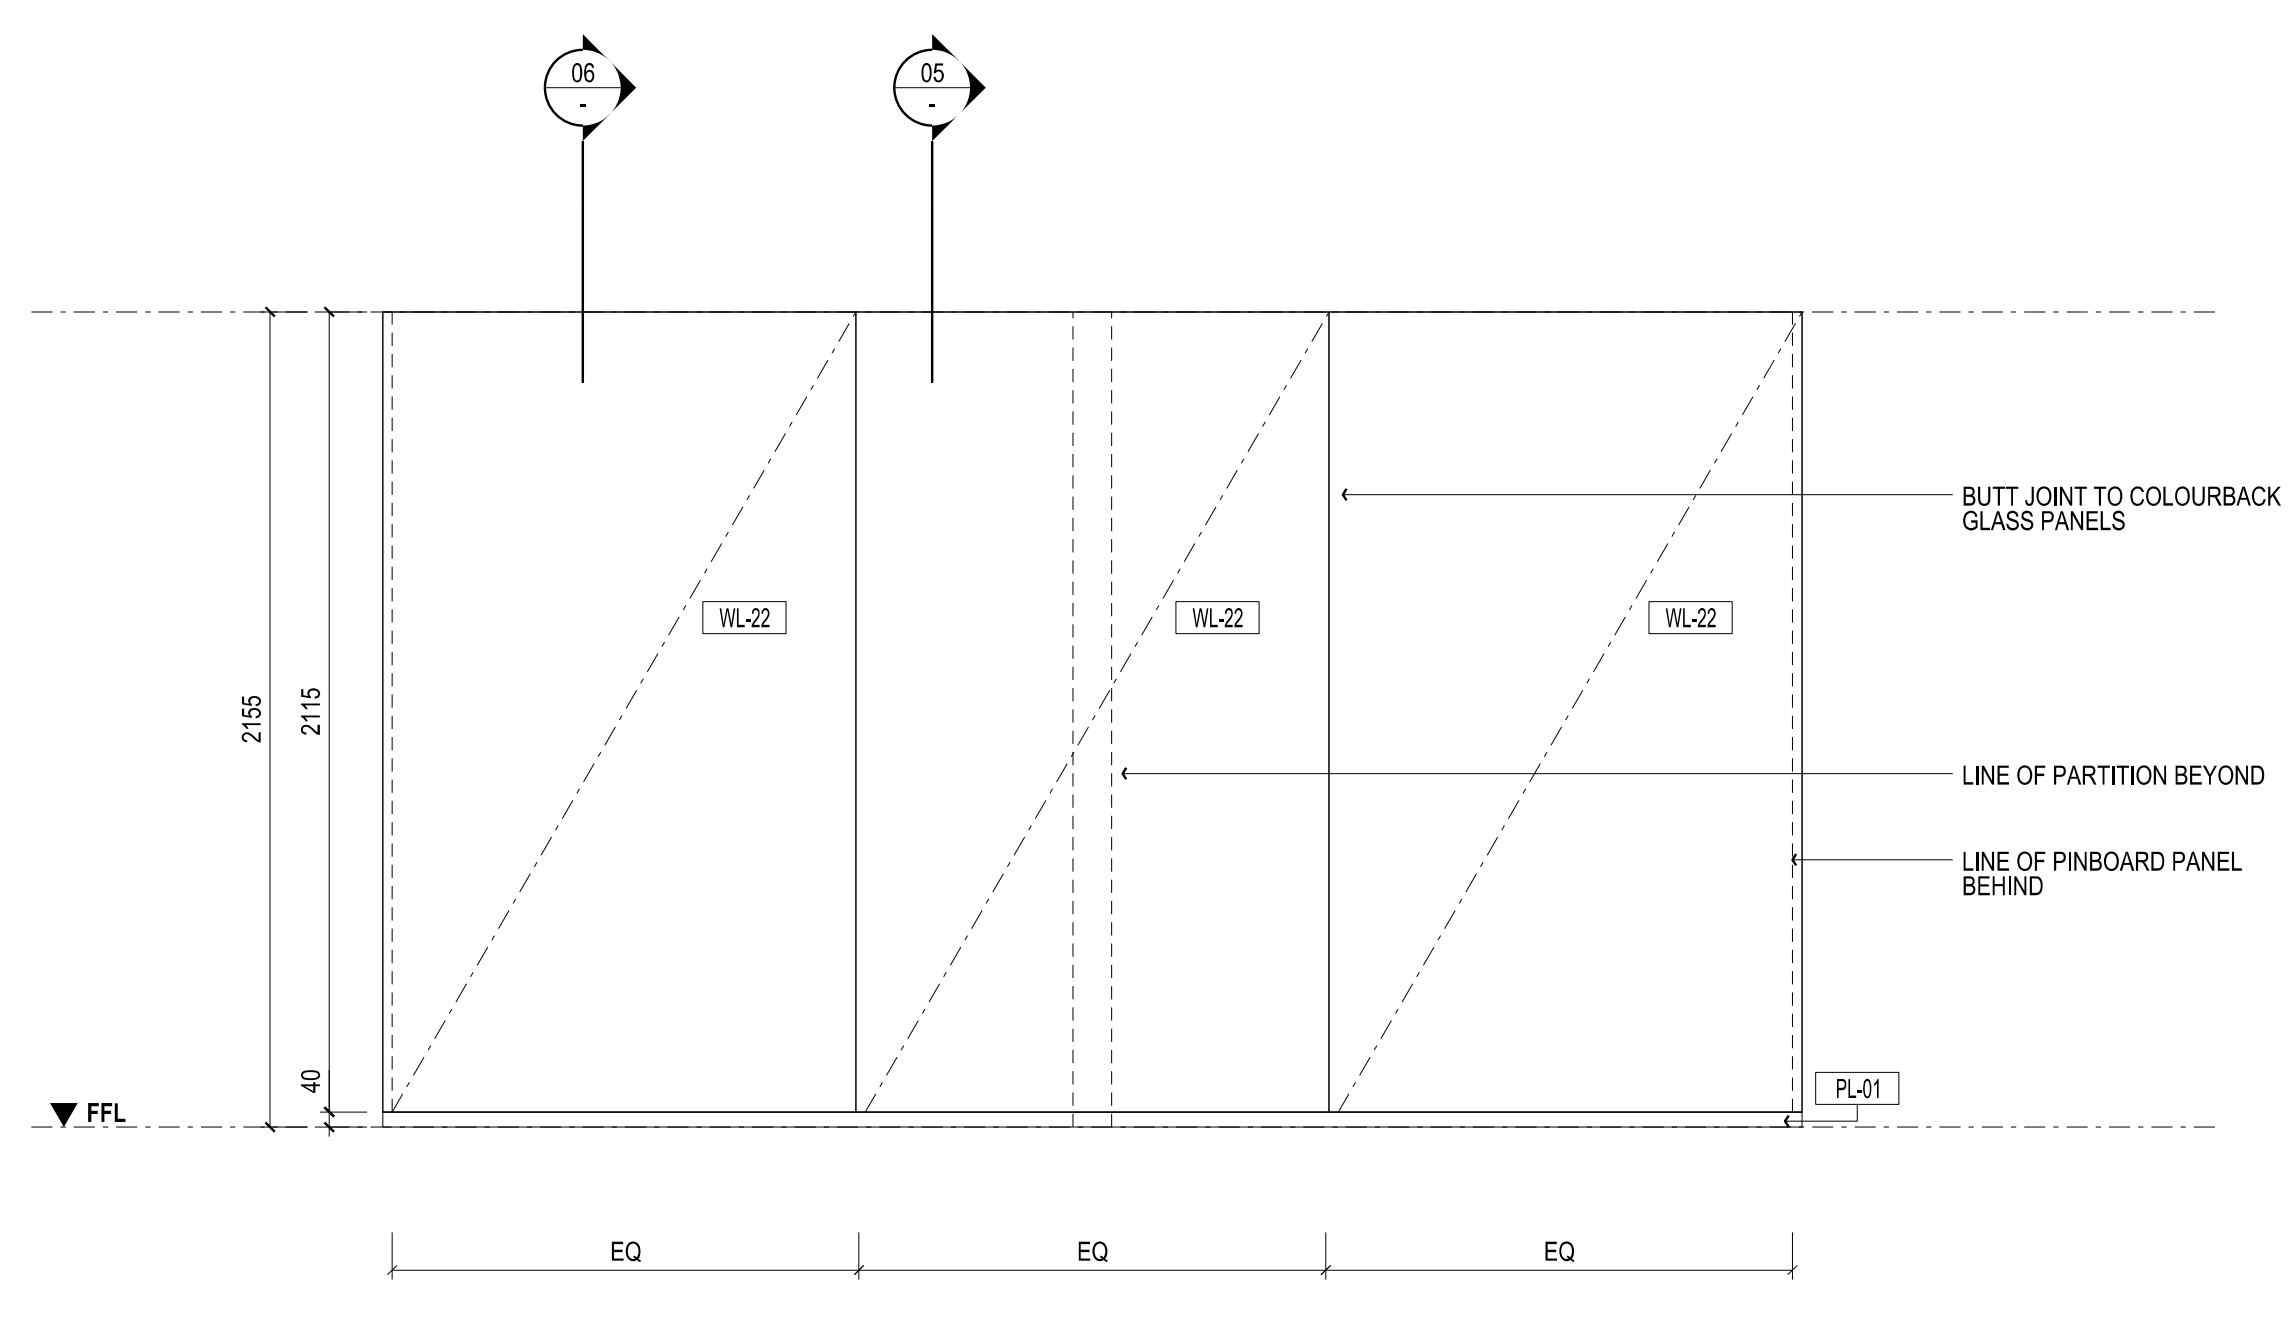


02 ELEVATION SCALE 1:20

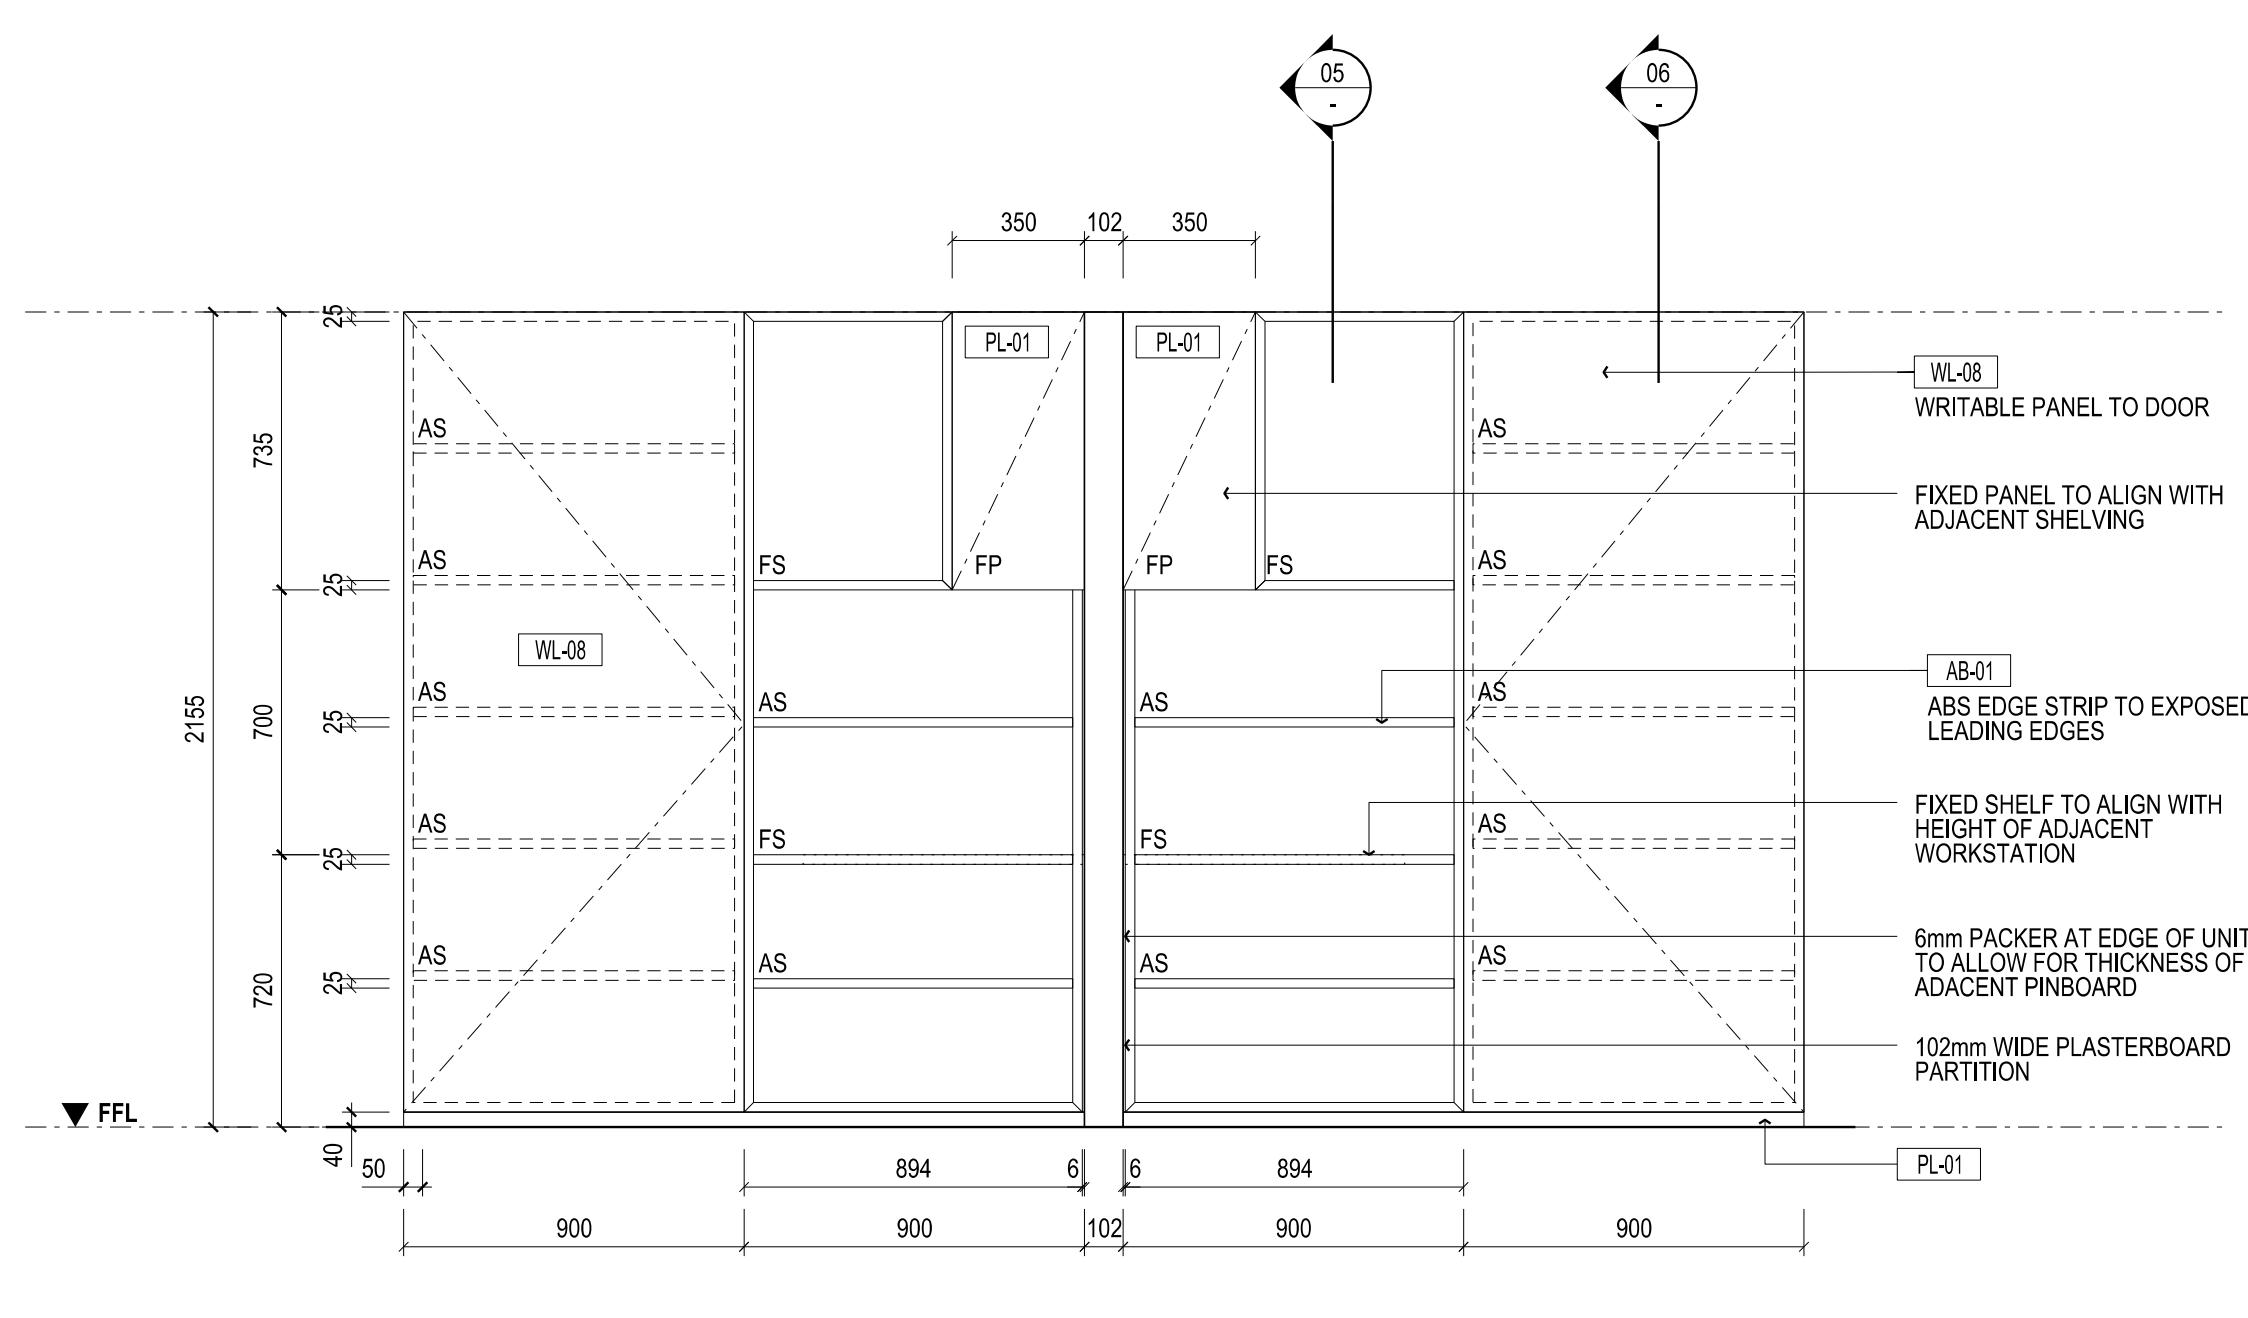


03 ELEVATION SCALE 1:20

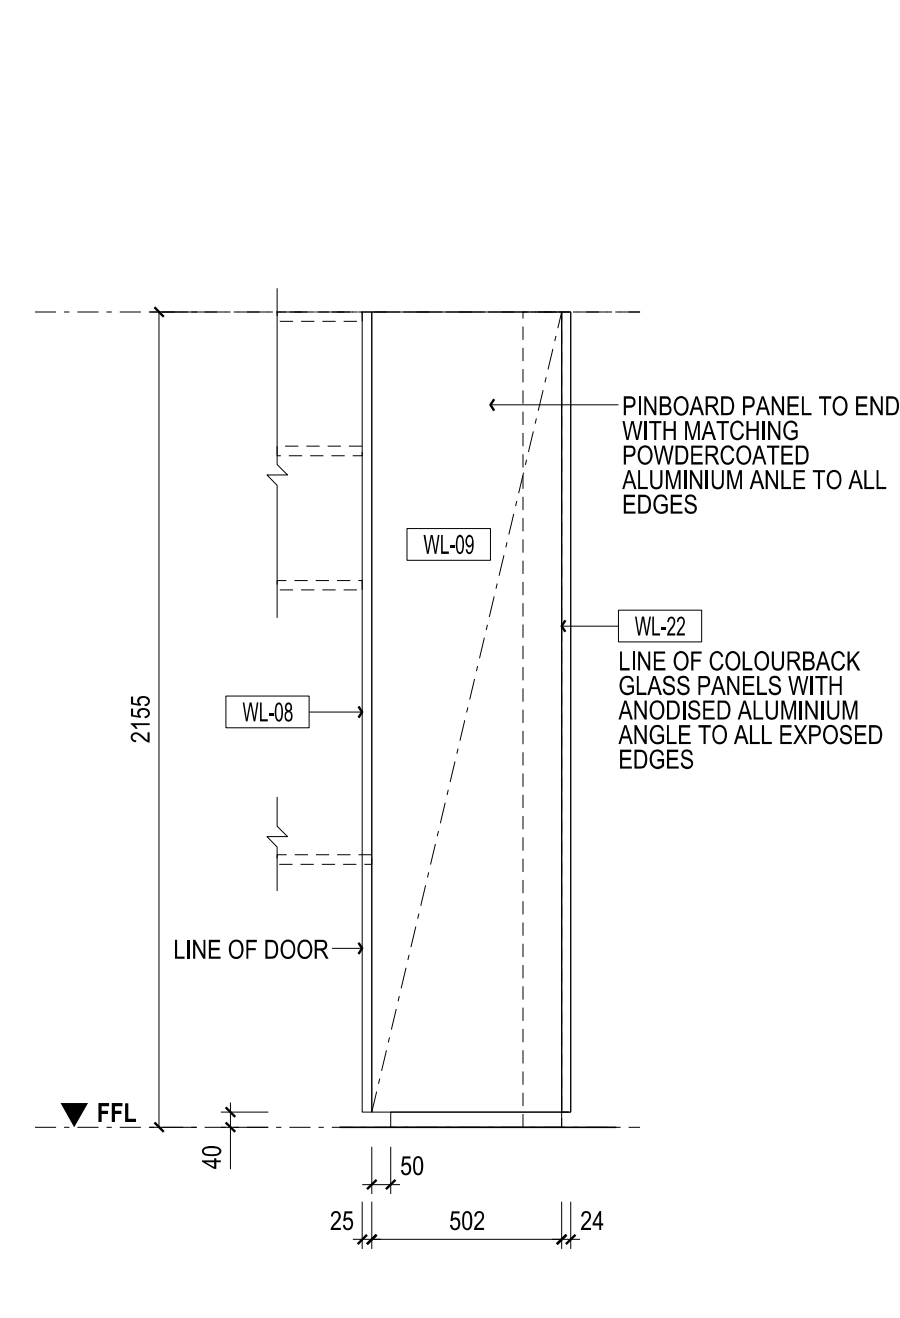


04 ELEVATION SCALE 1:20

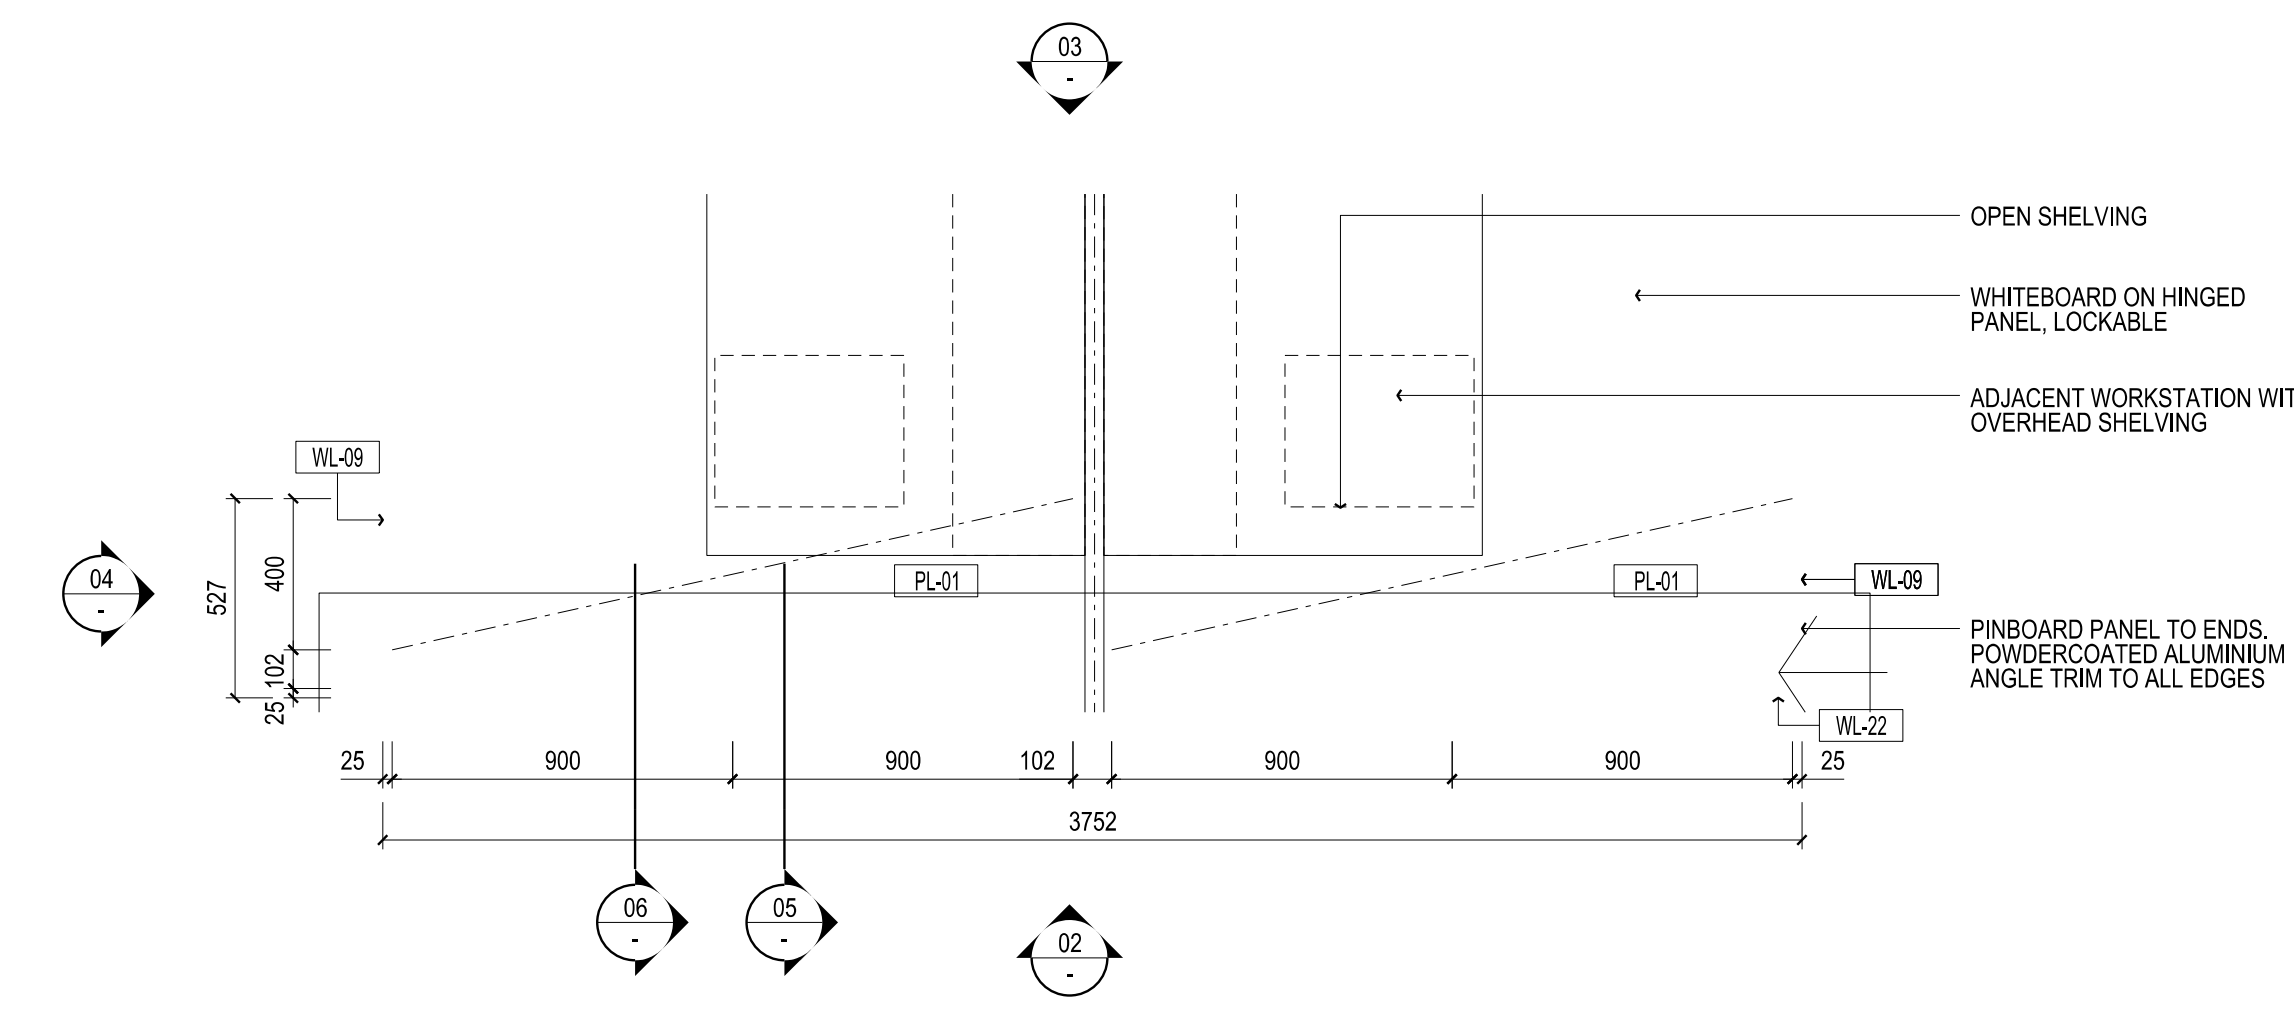


01 PLAN - J03-25A,B,C,D & J04-20A,B,C STORAGE UNIT SCALE 1:20

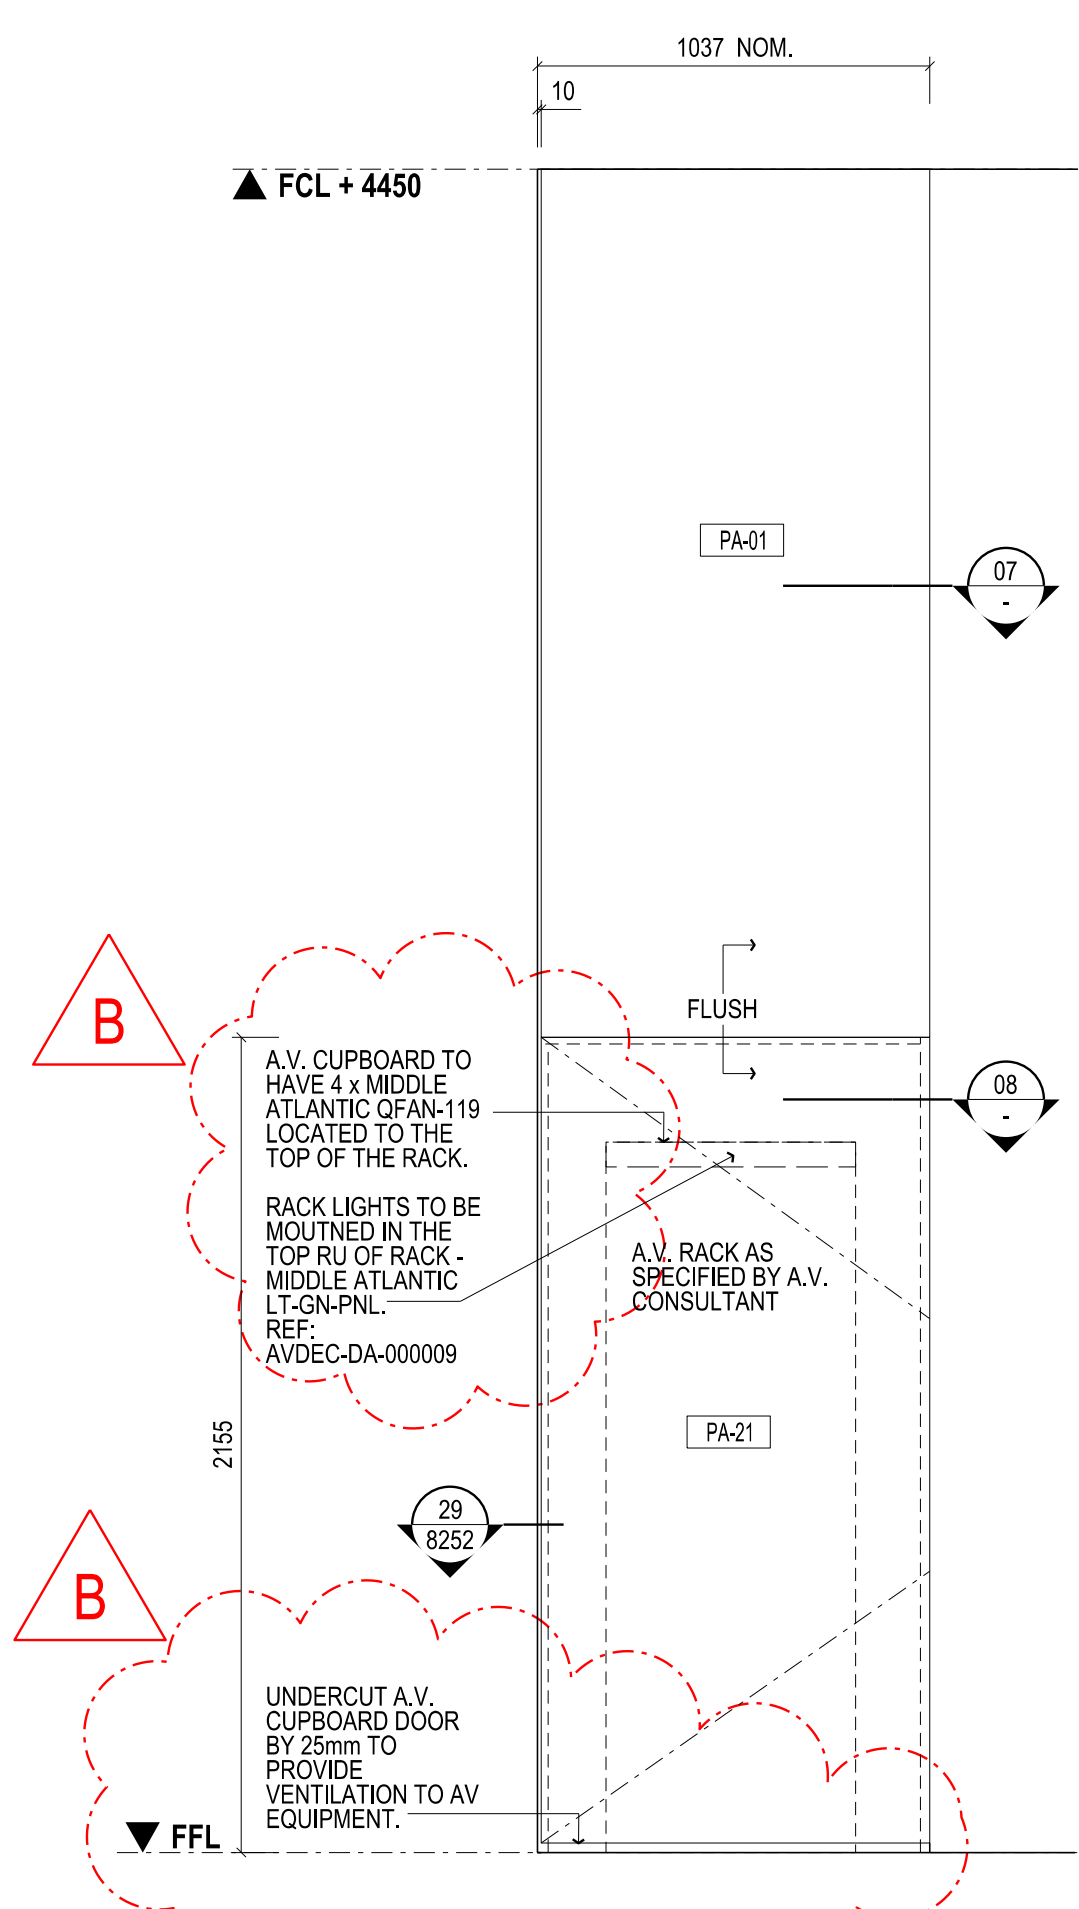


09 ELEVATION - JOG-50 A.V. RACK TO SMALL EXHIBITION SCALE 1:20

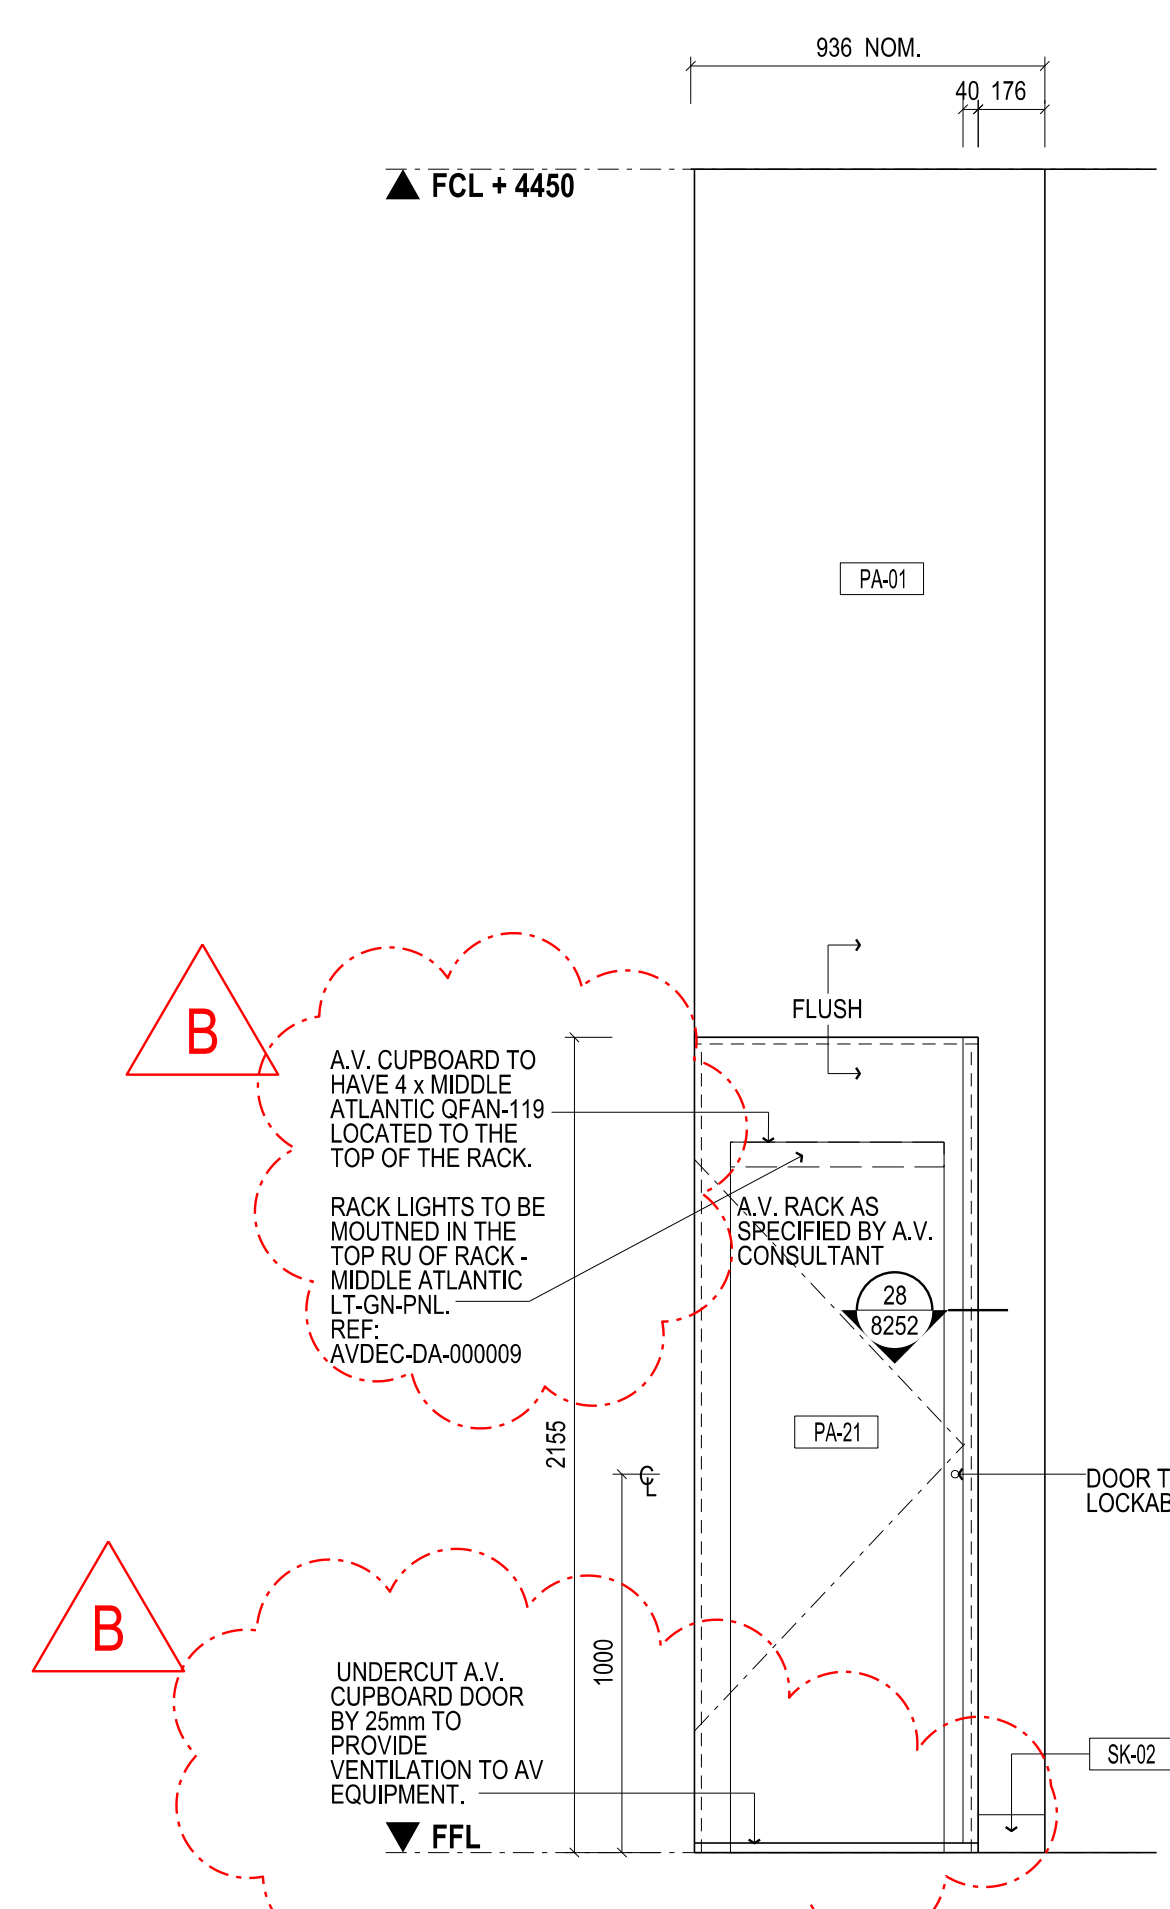


10 ELEVATION - JOG-50 A.V. RACK TO SMALL EXHIBITION SCALE 1:20

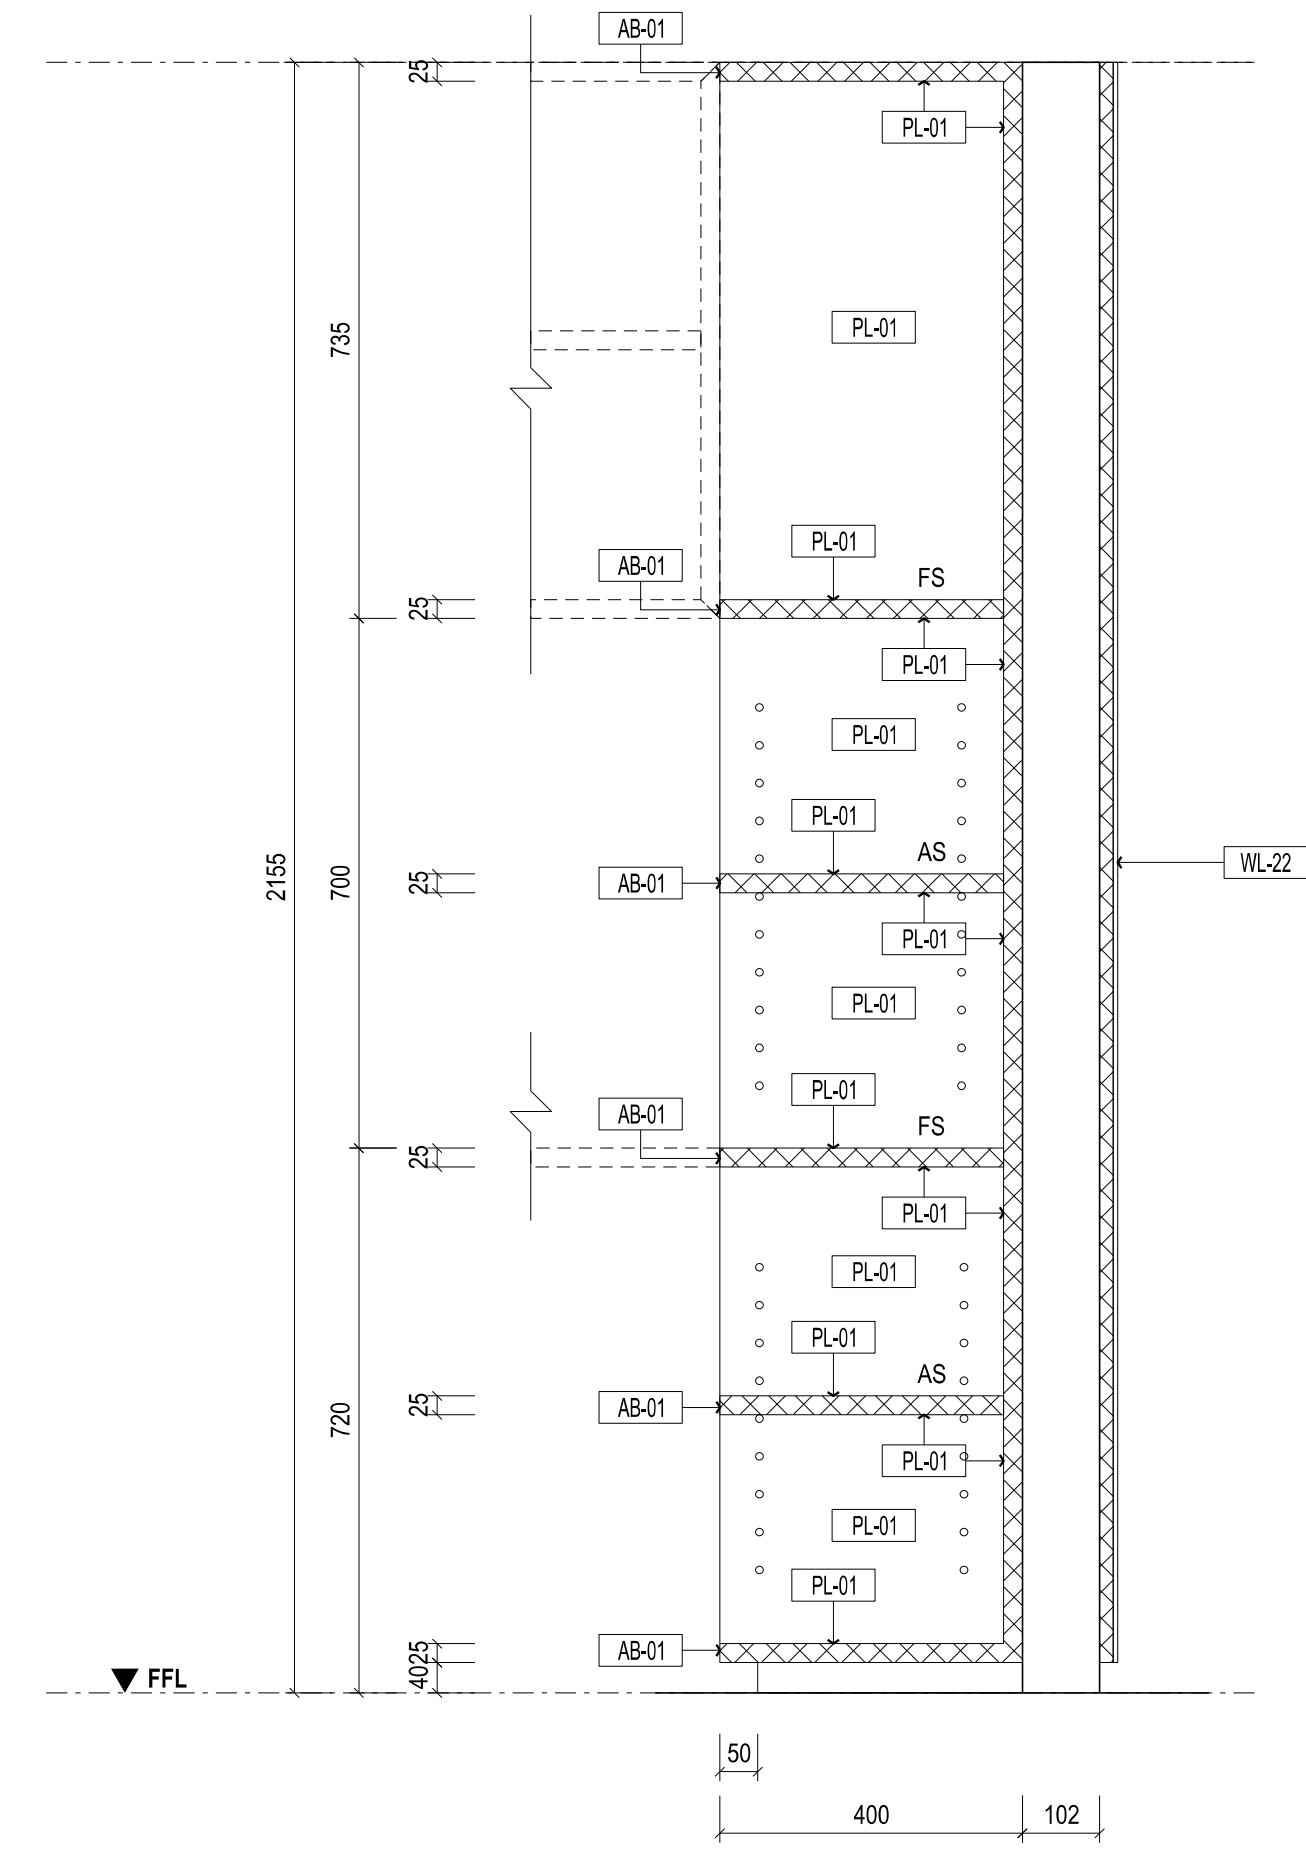


05 SECTION SCALE 1:10

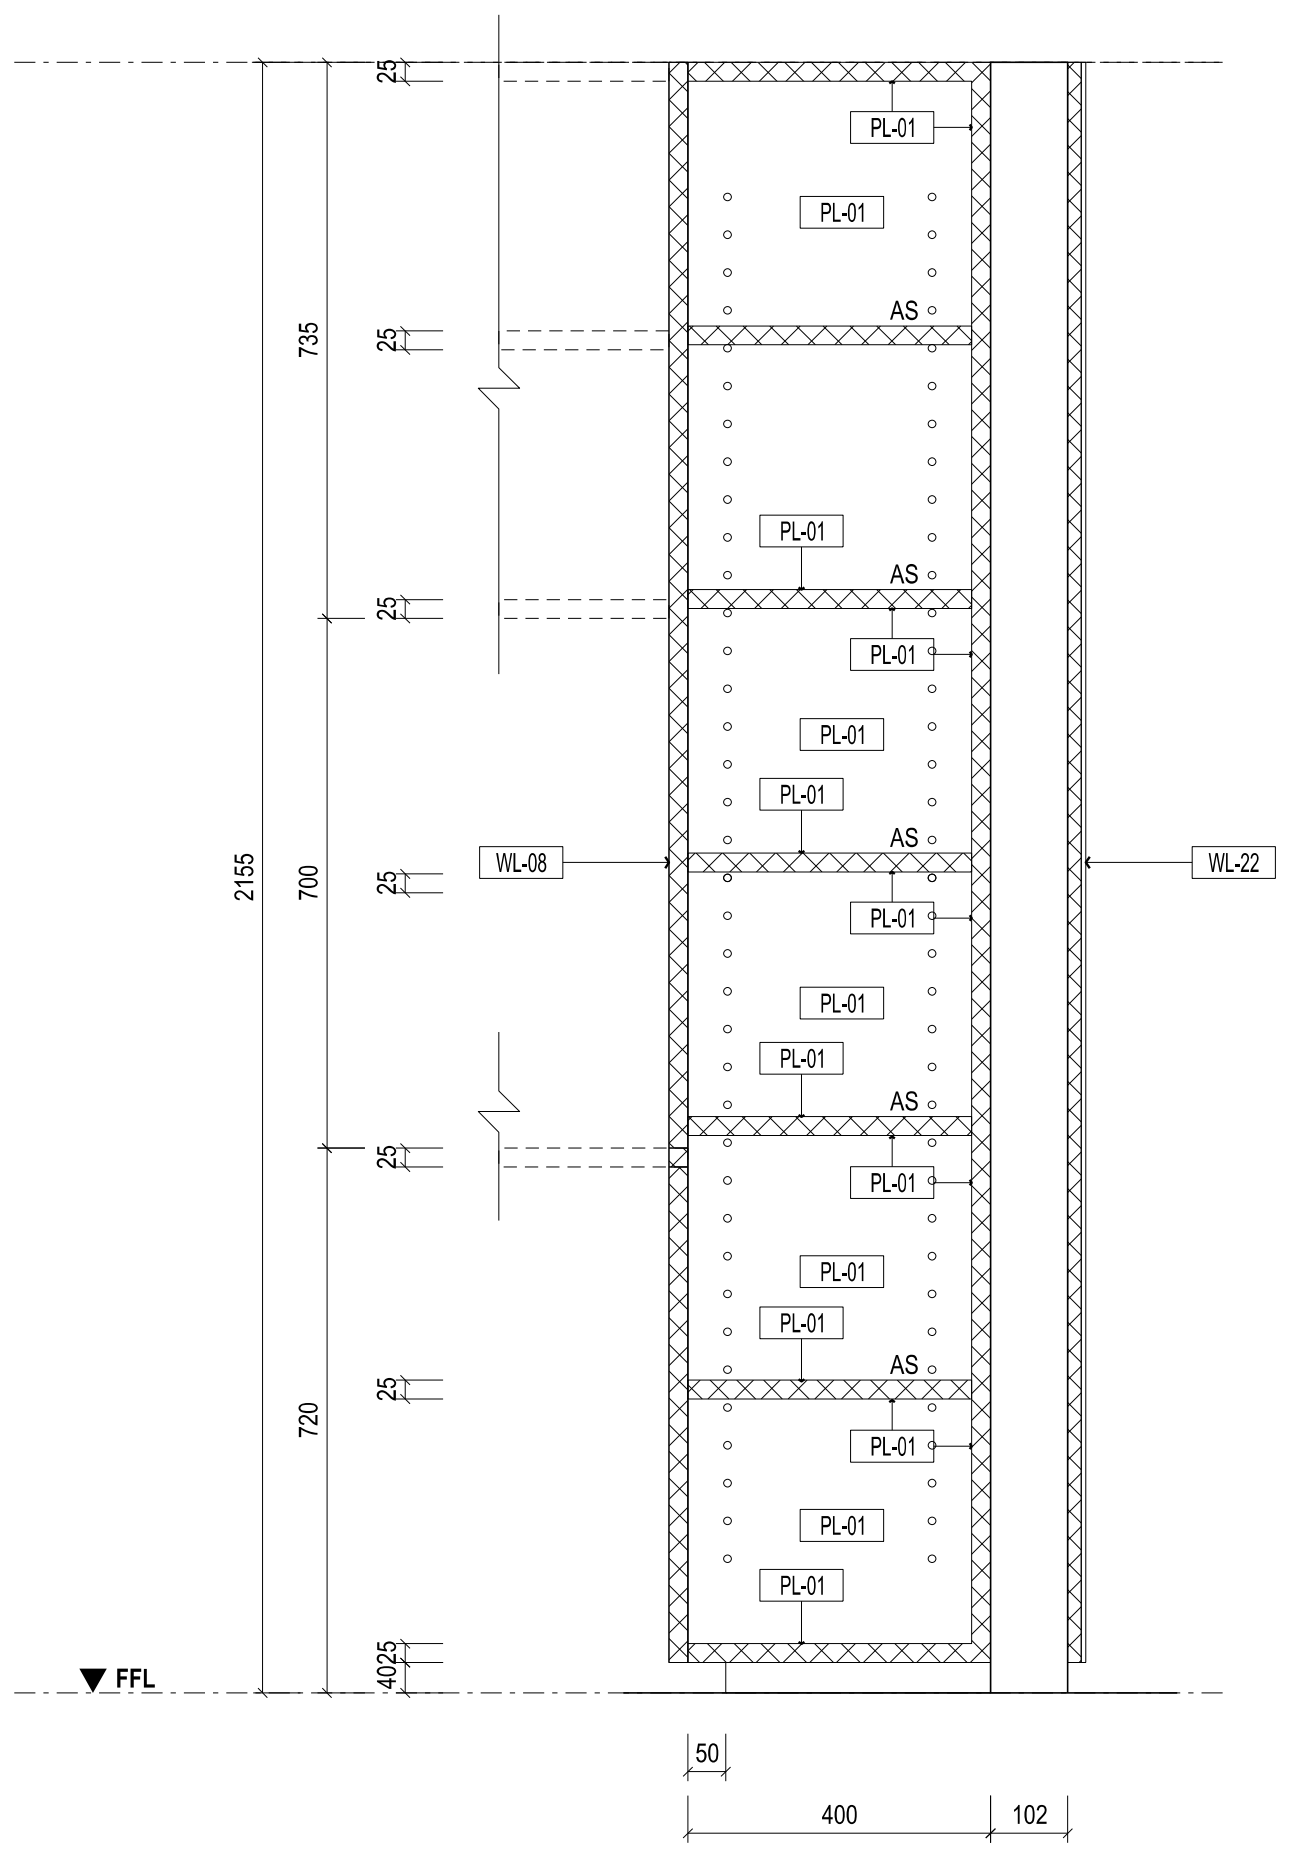

06 SECTION SCALE 1:10

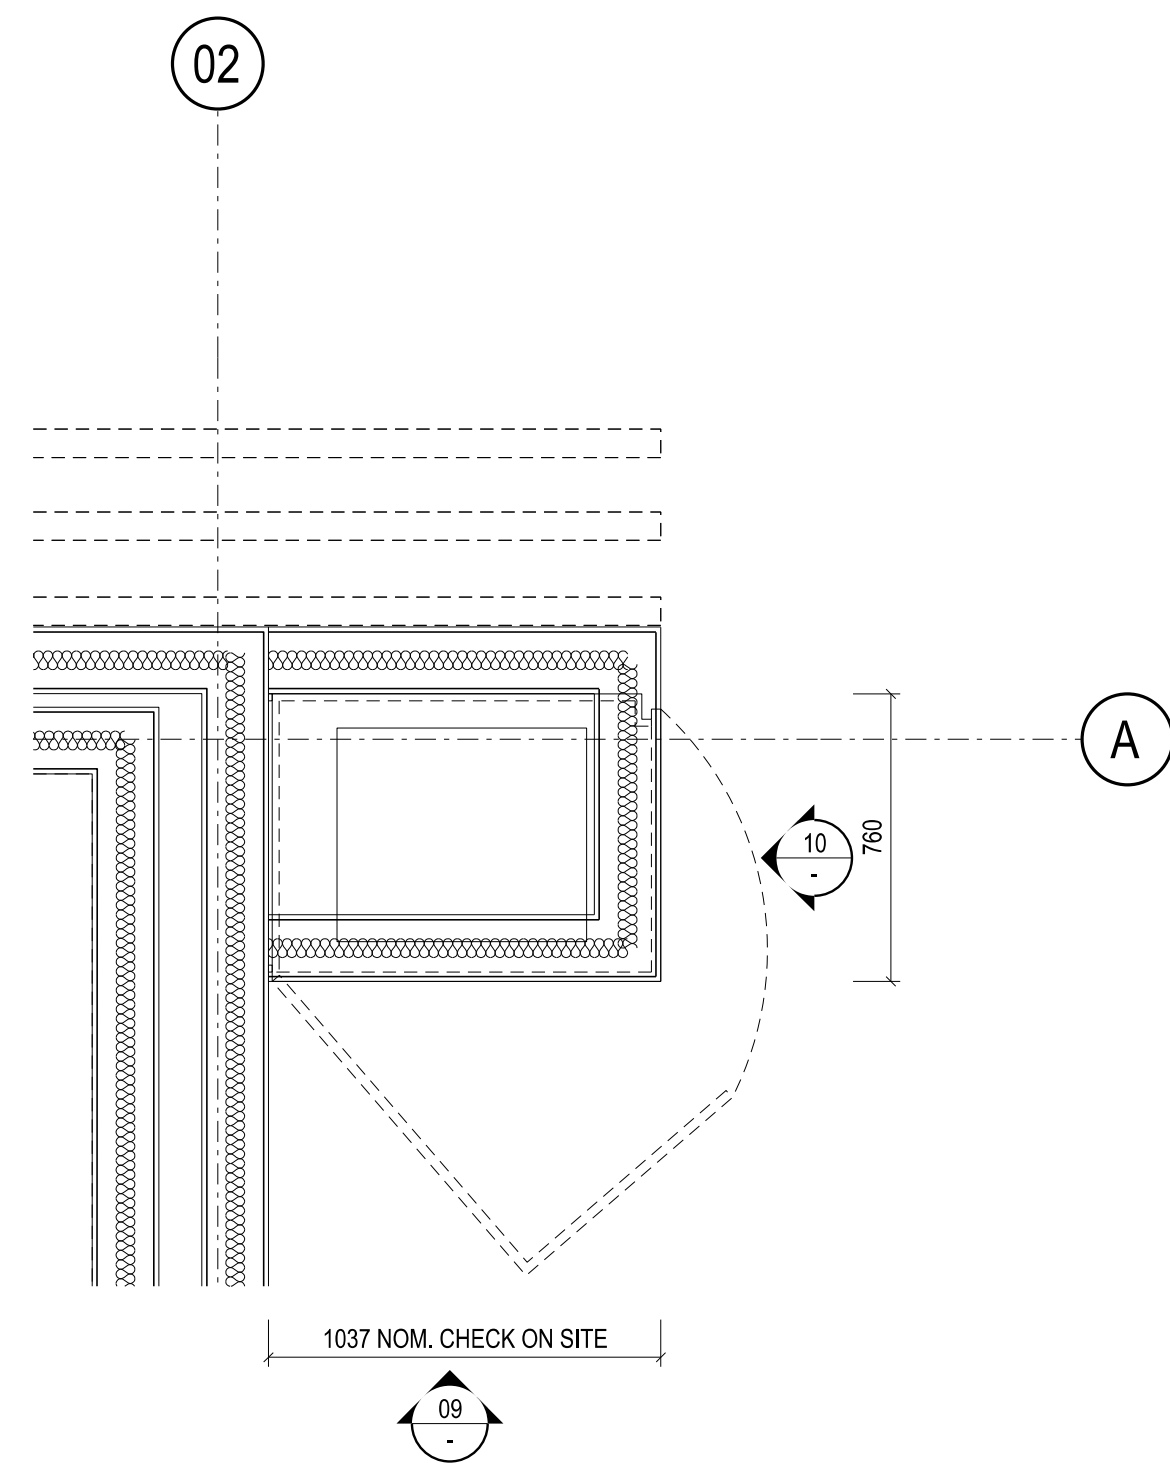

07 PLAN - JOG-50 A.V. RACK TO SMALL EXHIBITION SCALE 1:20

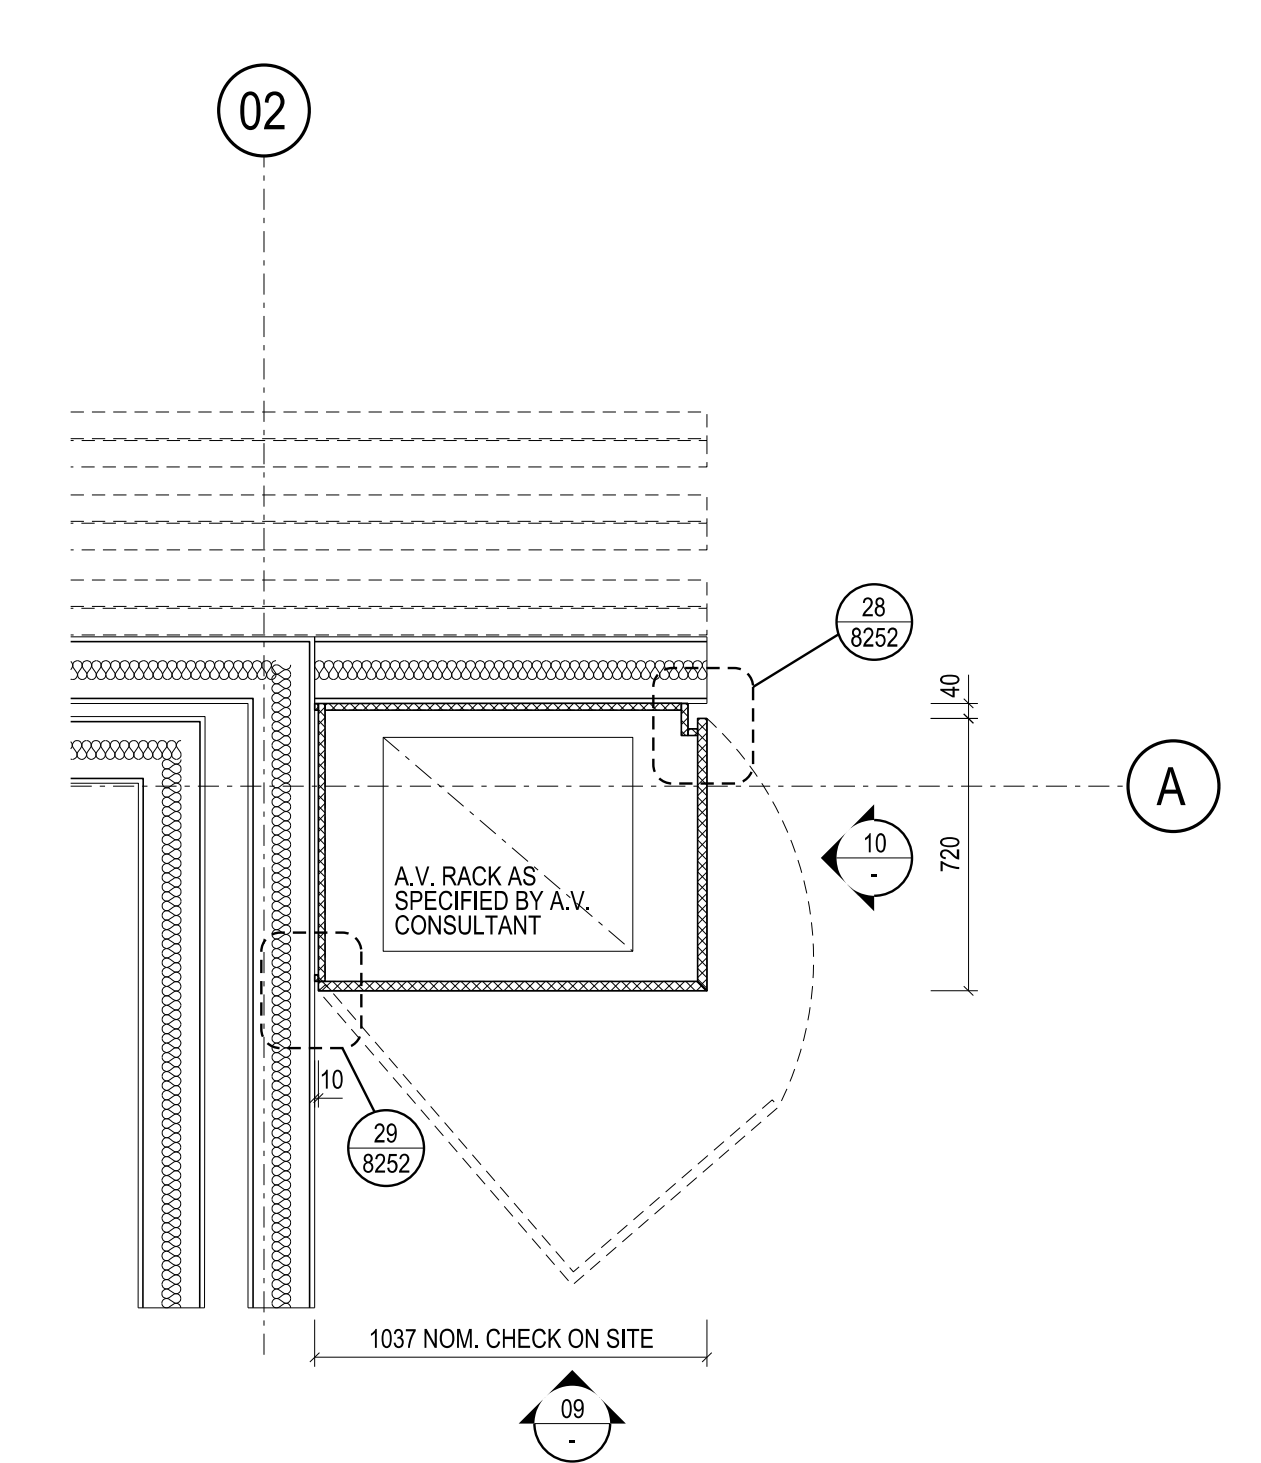

08 PLAN SECTION - JOG-50 A.V. RACK TO SMALL EXHIBITION SCALE 1:20



Client University of Melbourne Parkville Campus
 Project Faculty of Architecture Building and Planning
 Title JOINERY DETAILS

Project No.	0913	Scale	1:20 @ A0 1:40 @ A2
Drawing No.	AR8168	Revision	B
Date	Dec 2011	Drawn	JWI
		Co-Ord	SG
		Chk	SG

FOR CONSTRUCTION