



01 ELEVATION  
SCALE 1:20

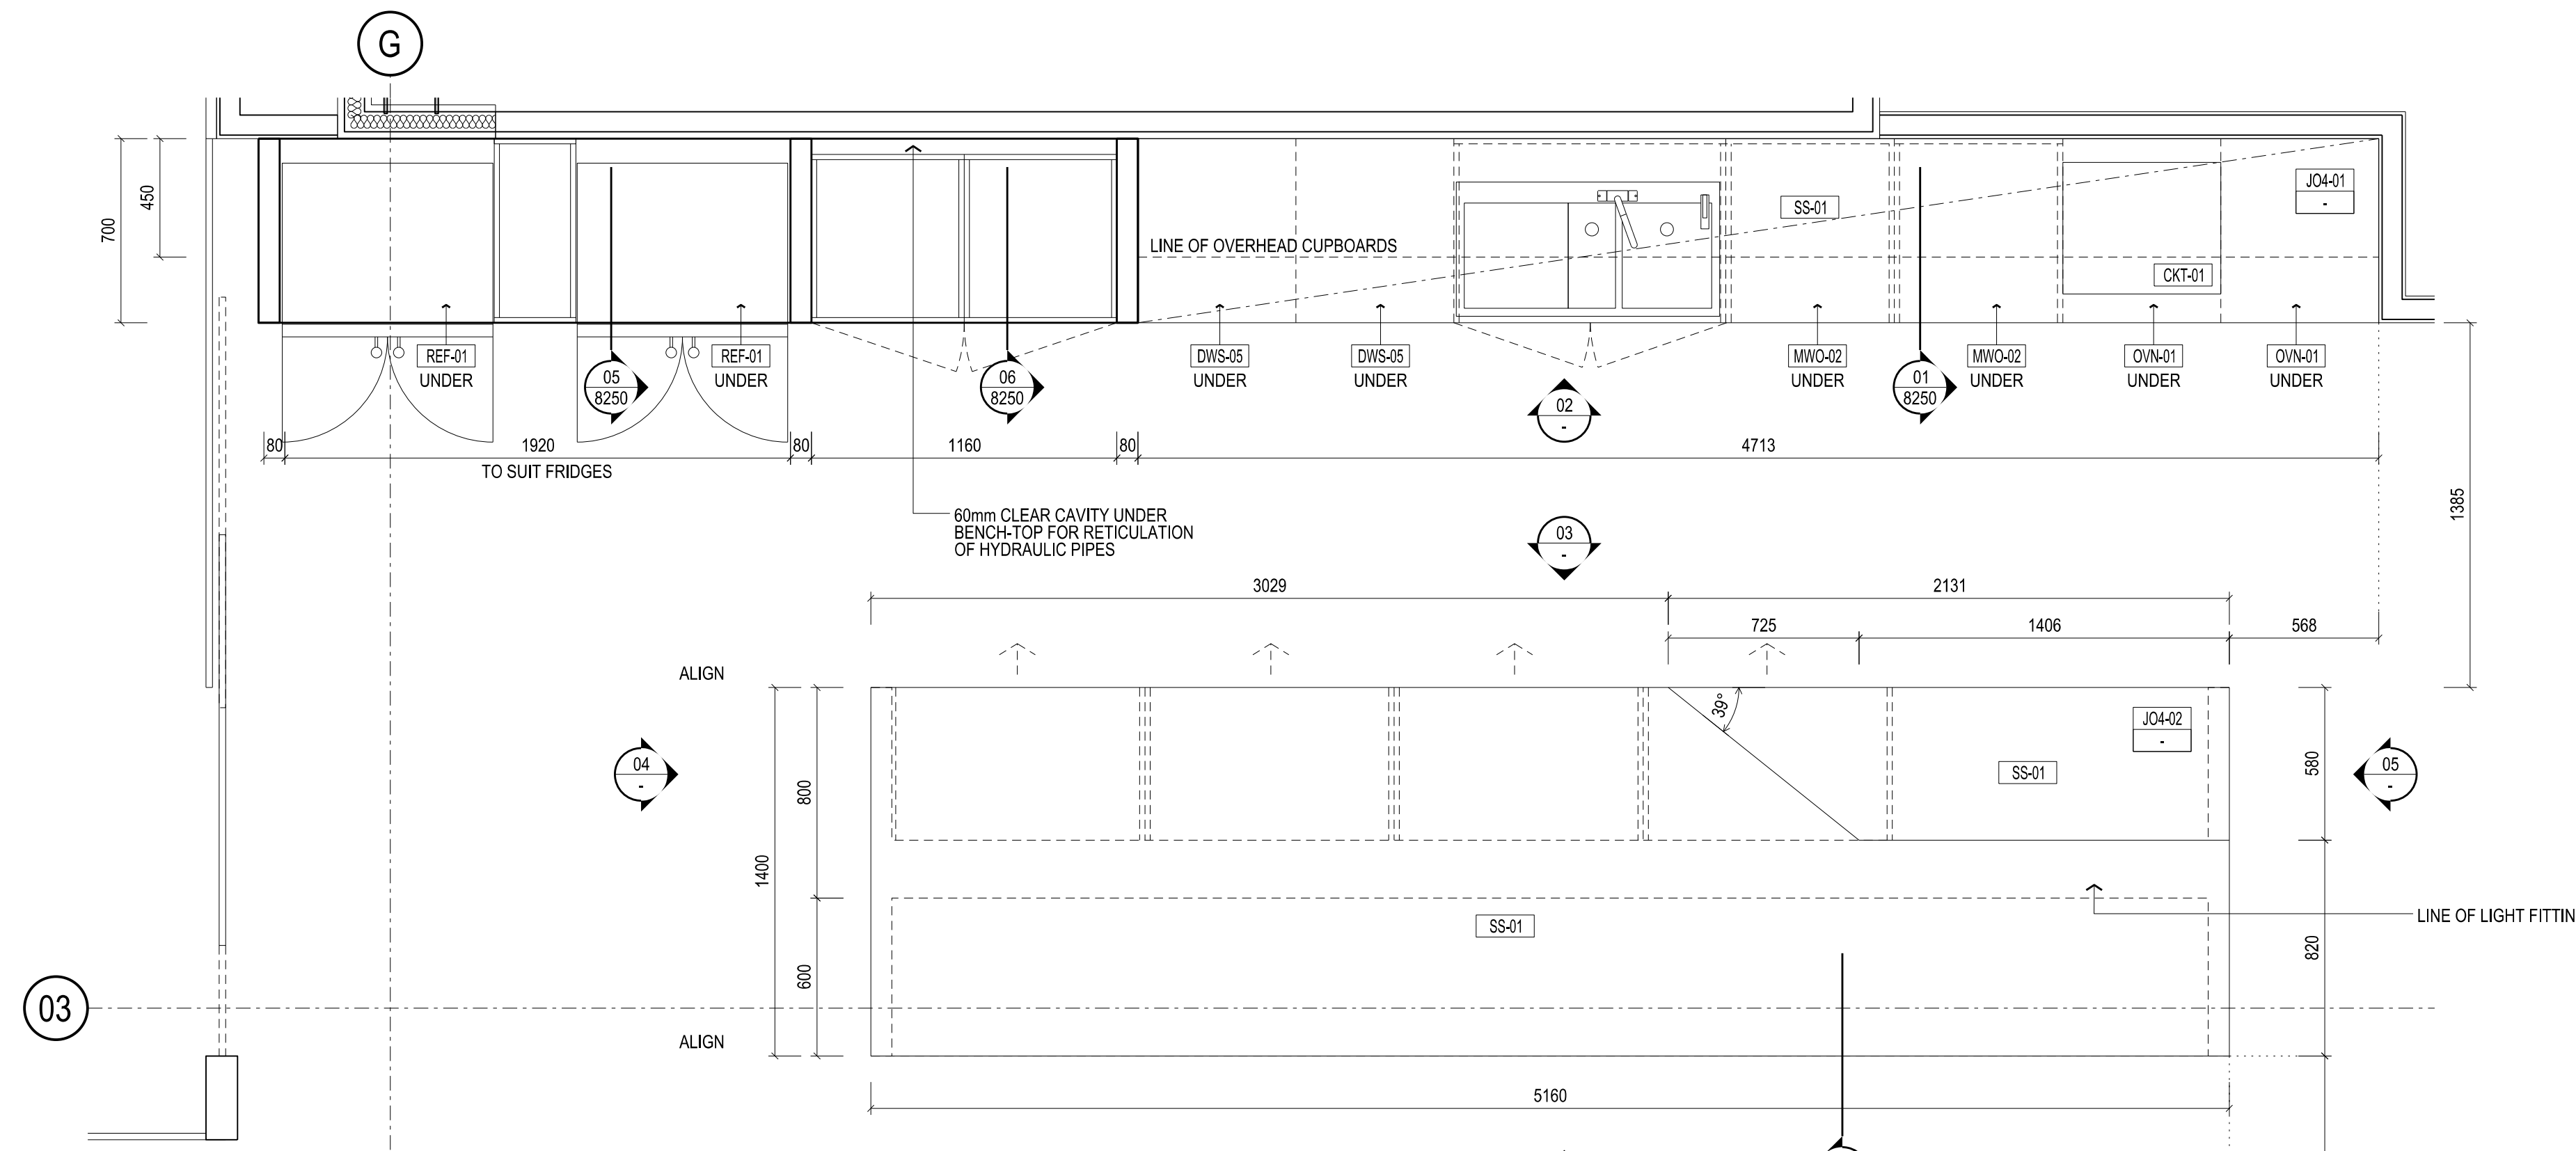


02 ELEVATION  
SCALE 1:20

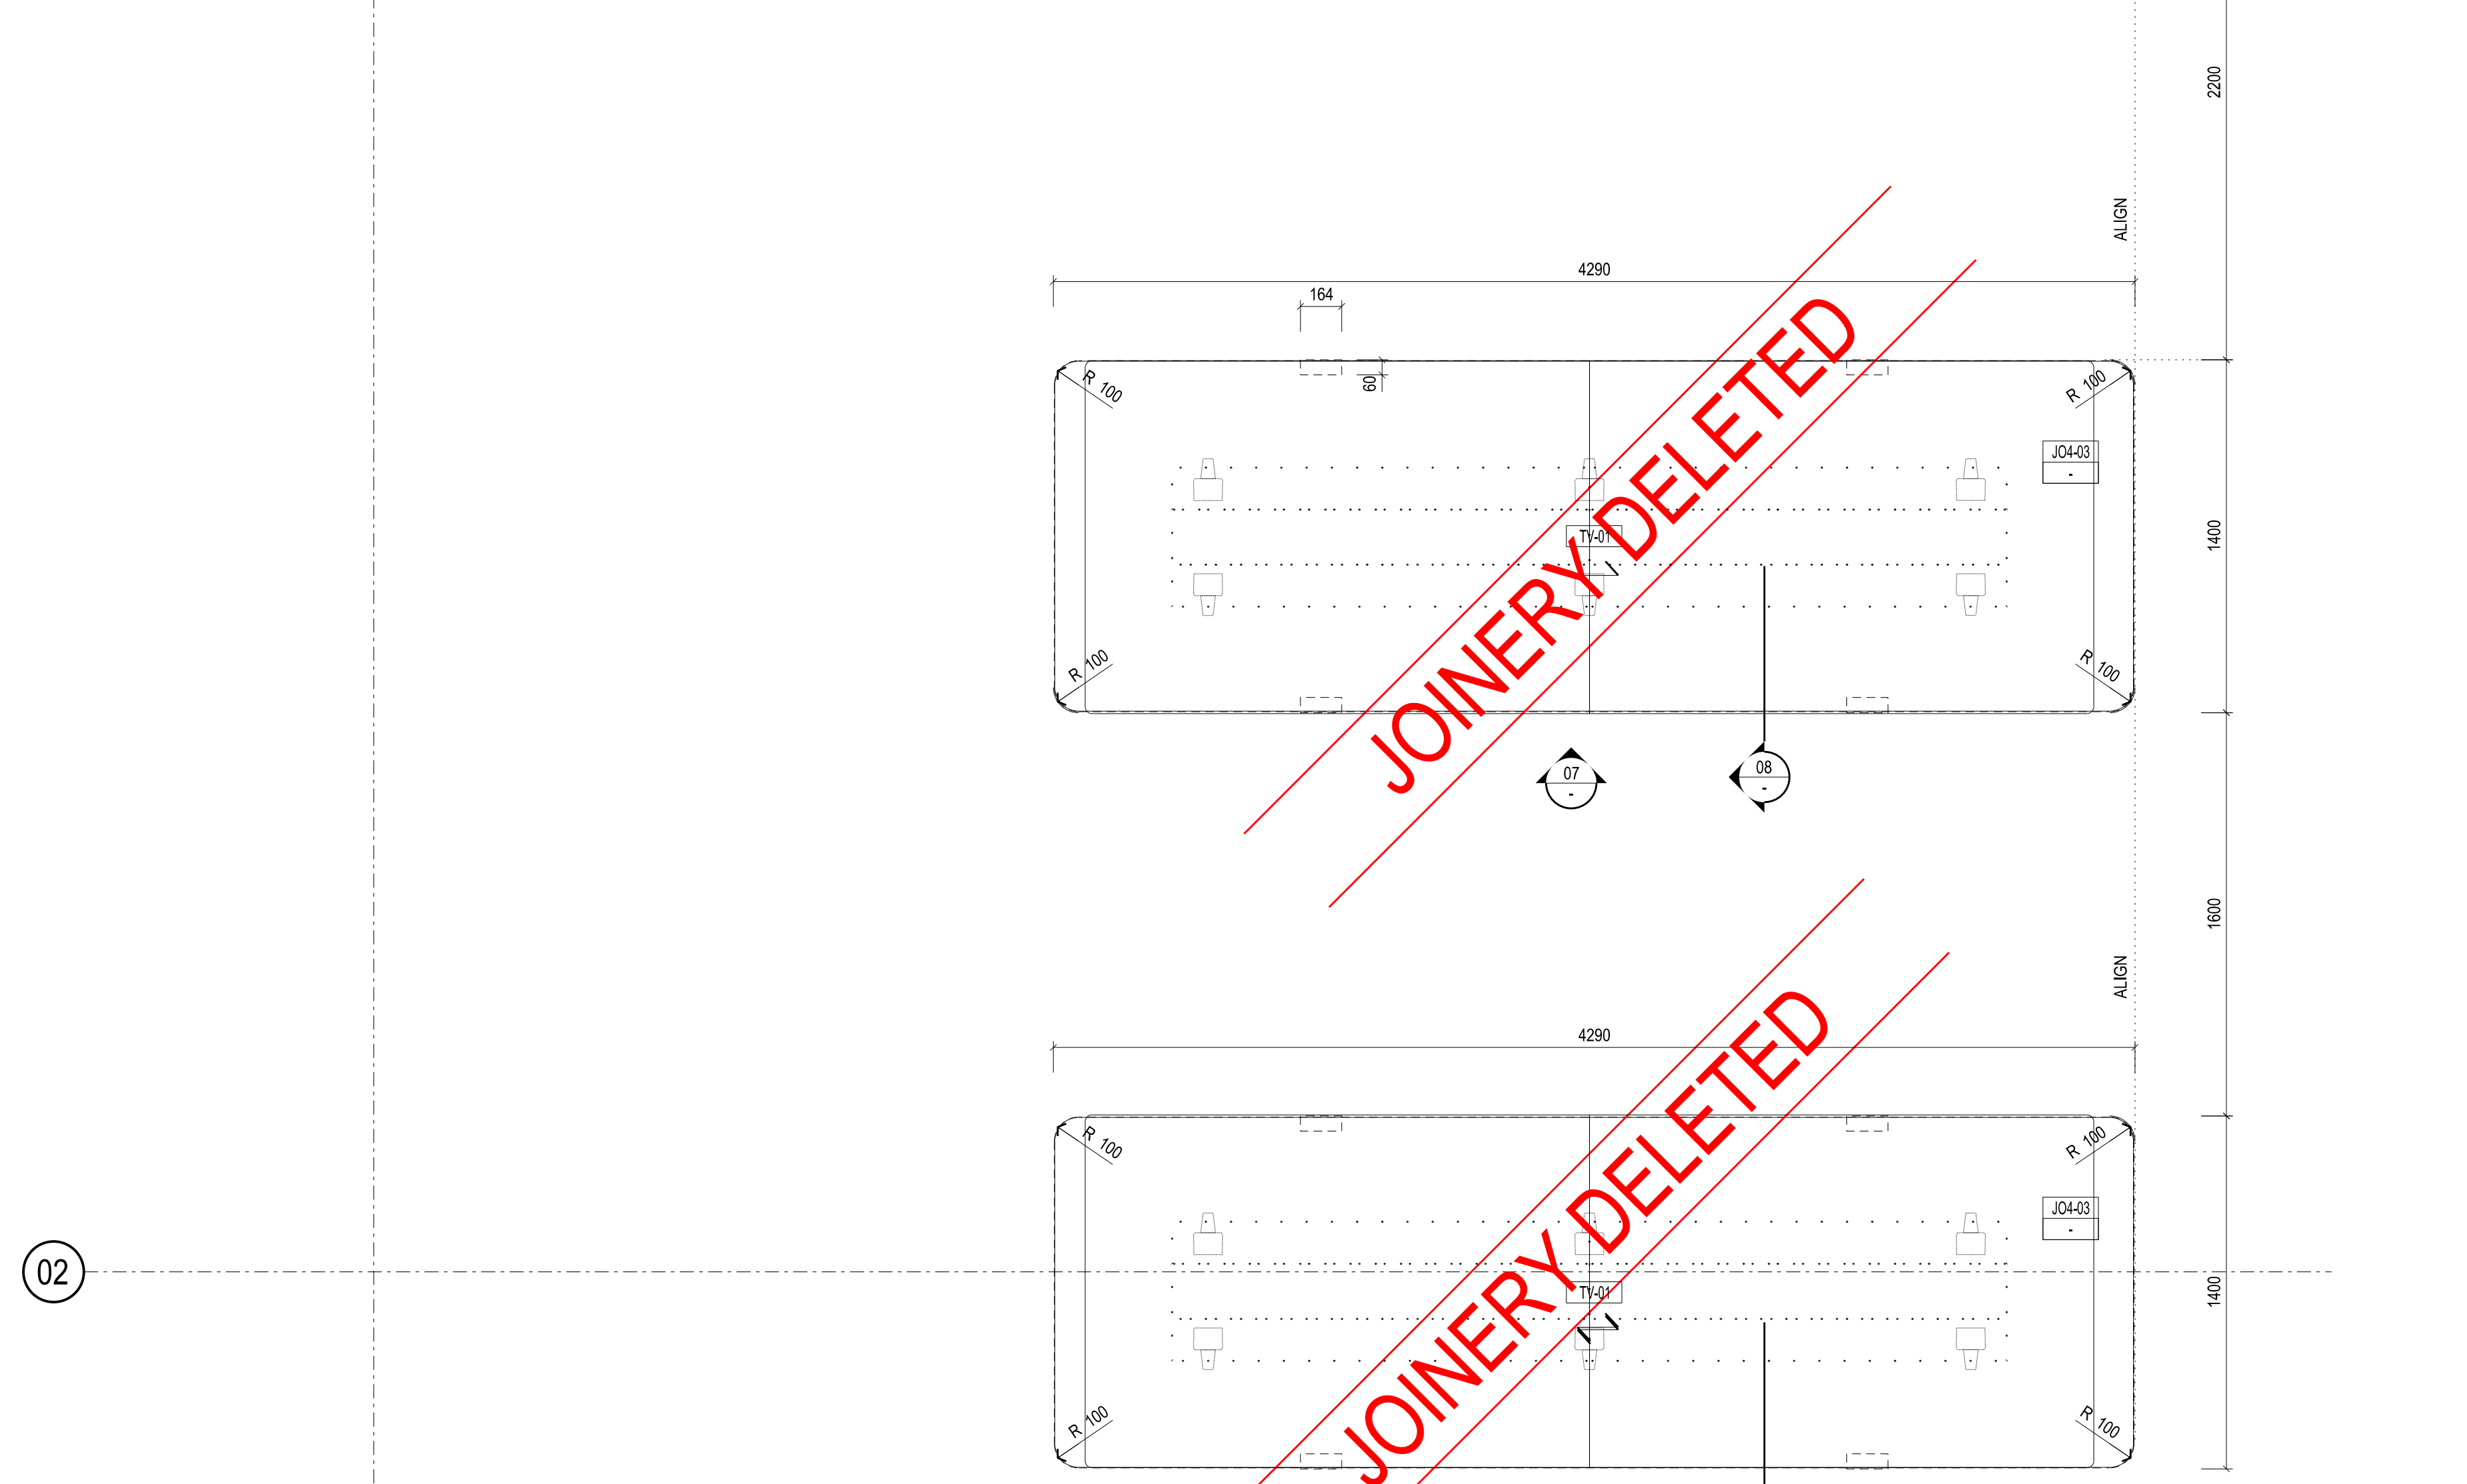


03 ELEVATION  
SCALE 1:20


01 PLAN - J04-01, J04-02 & J04-03 - STAFF HUB  
SCALE 1:20

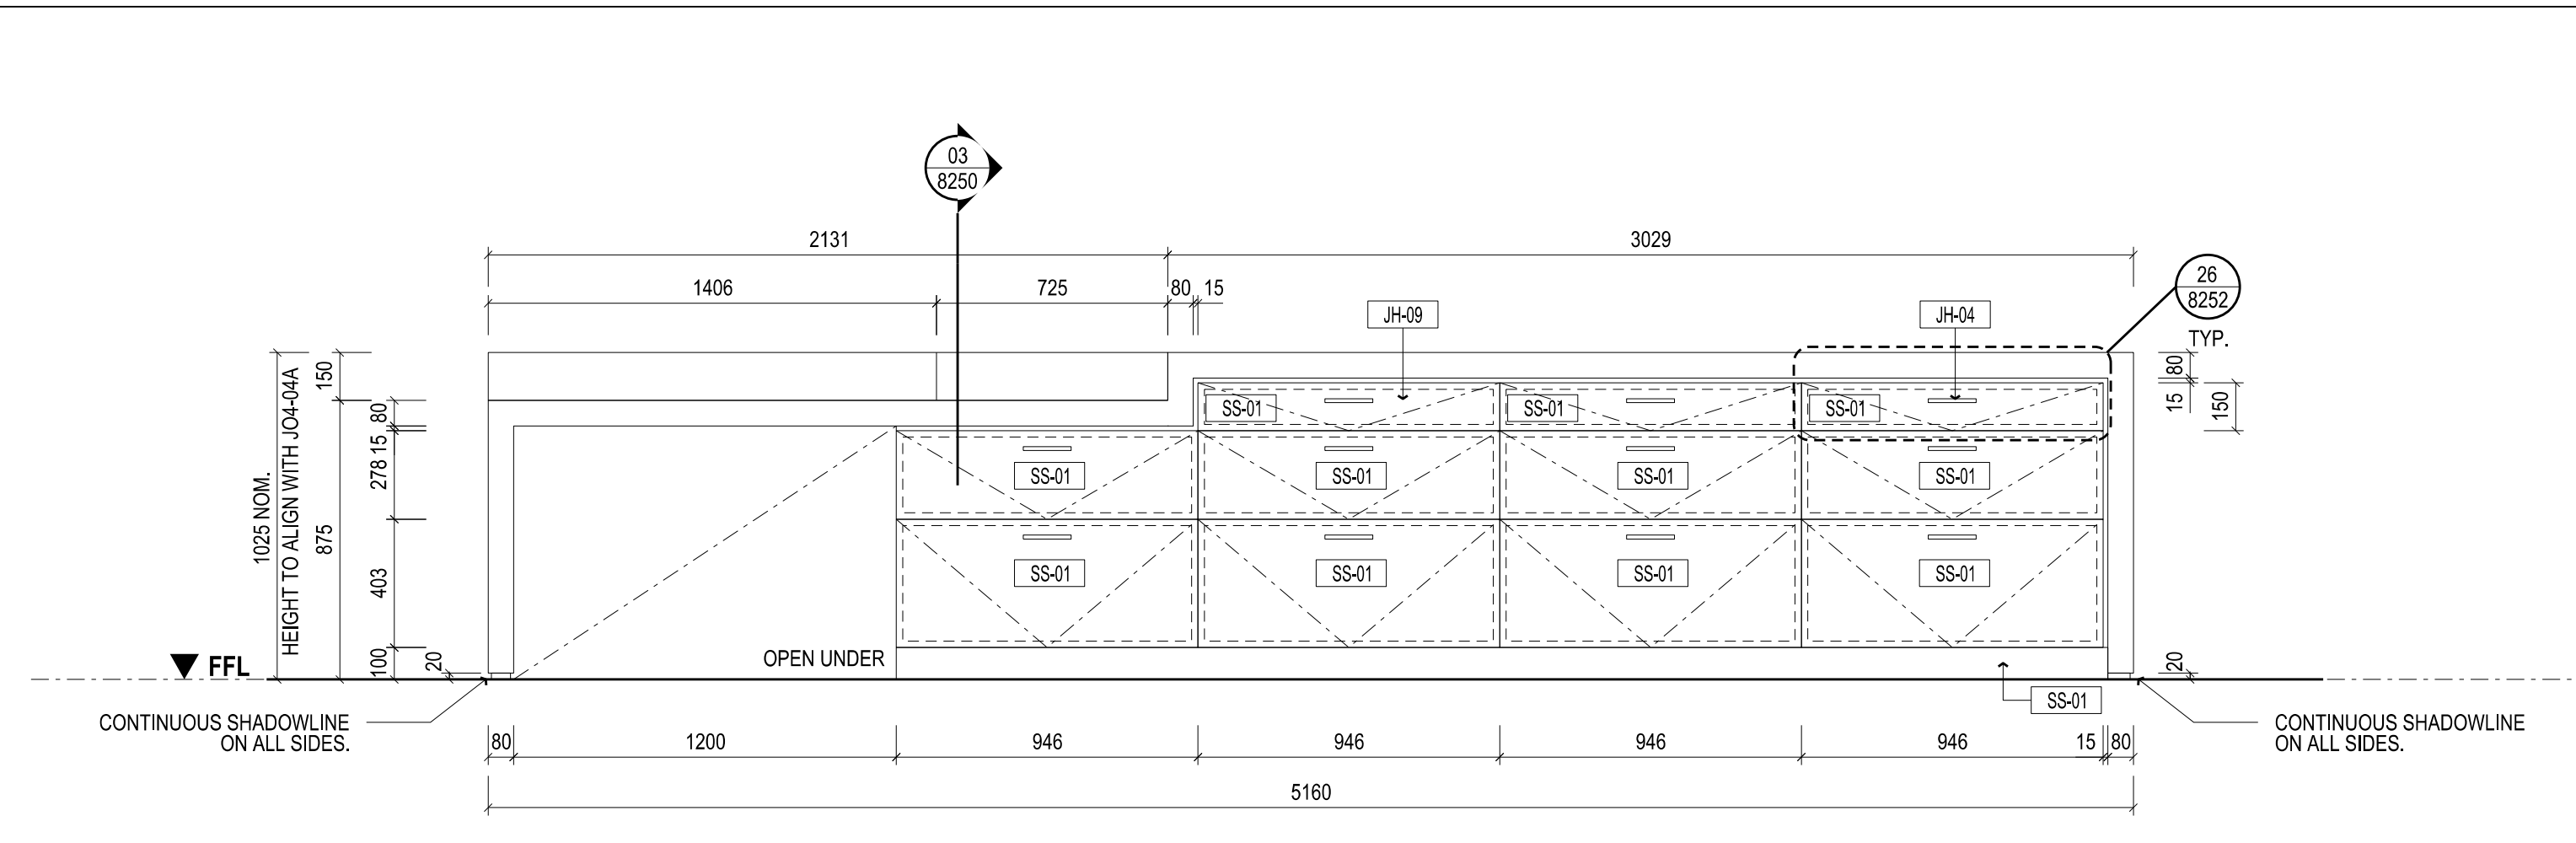


04 ELEVATION  
SCALE 1:20

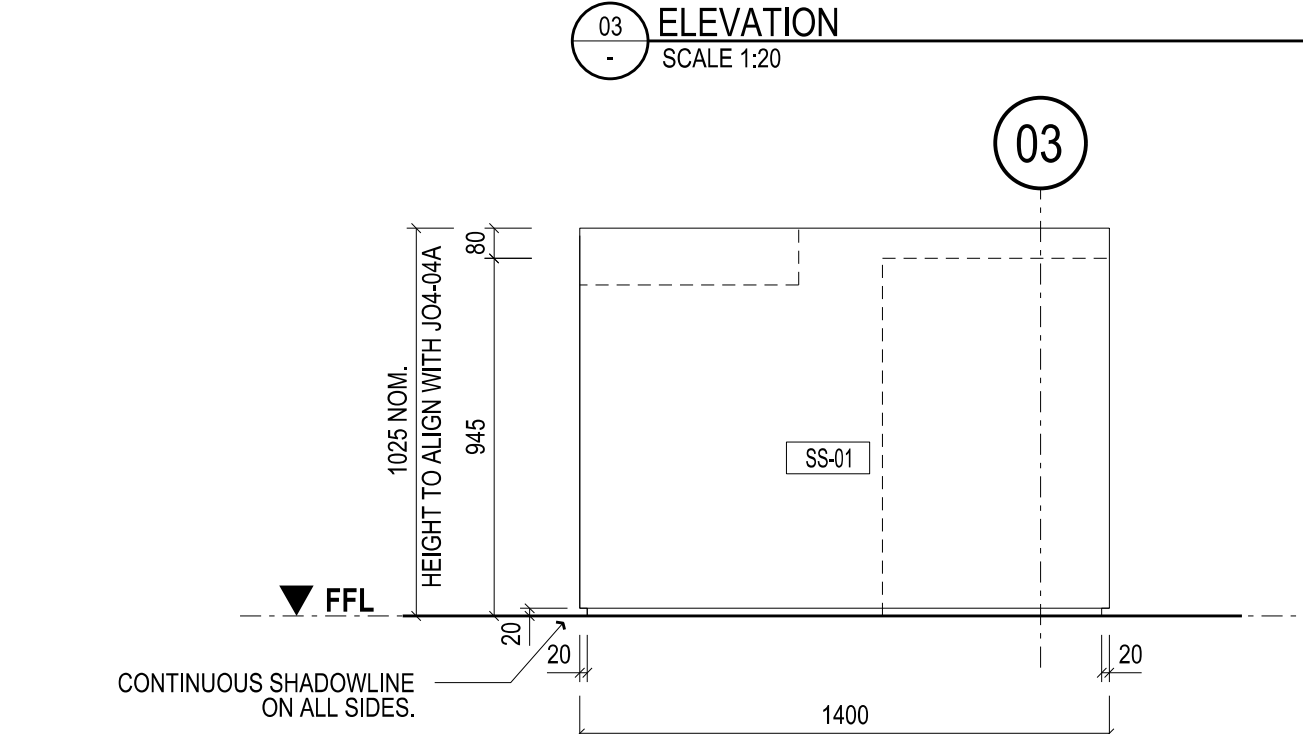


05 ELEVATION  
SCALE 1:20

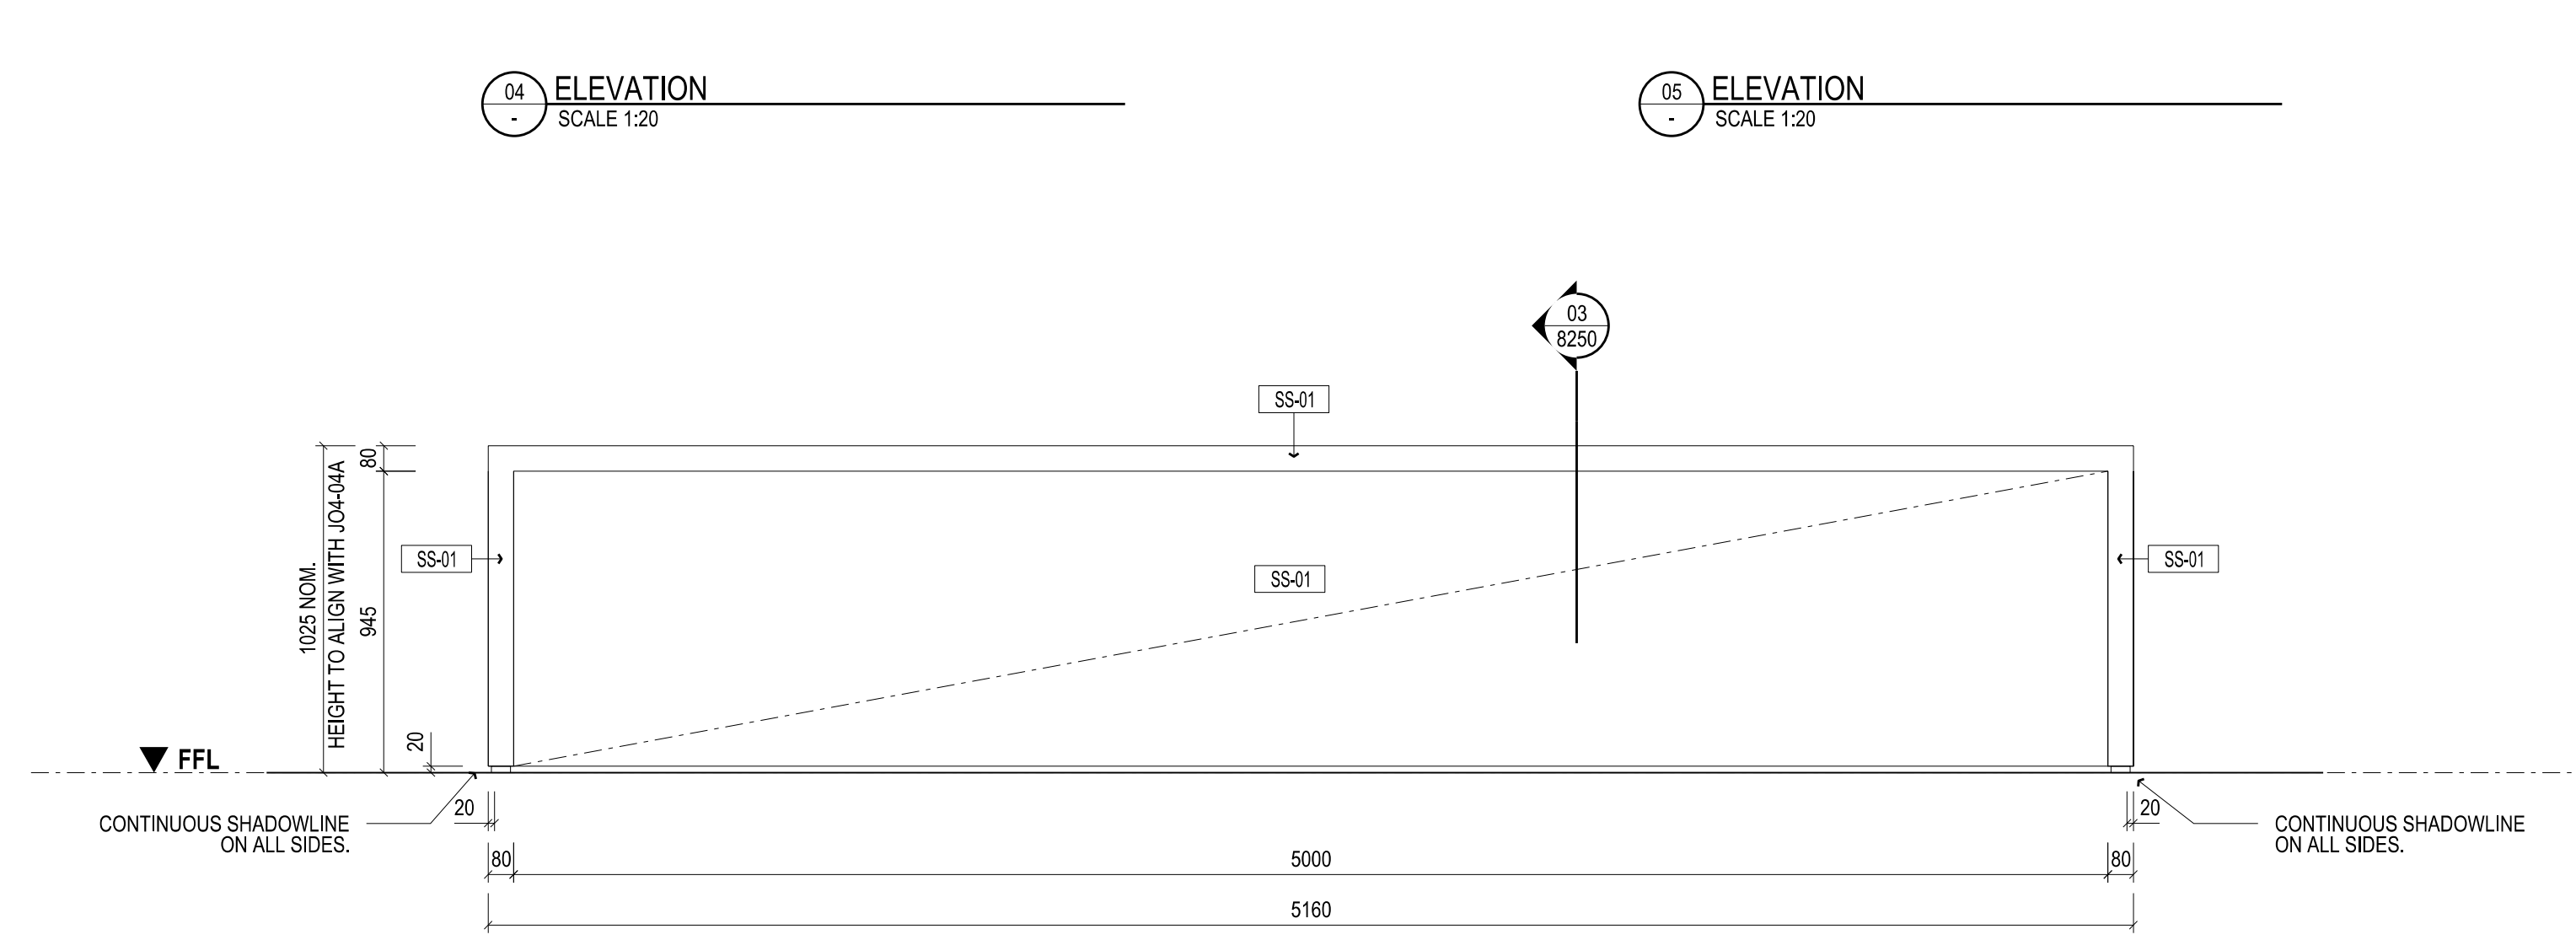

06 ELEVATION  
SCALE 1:20

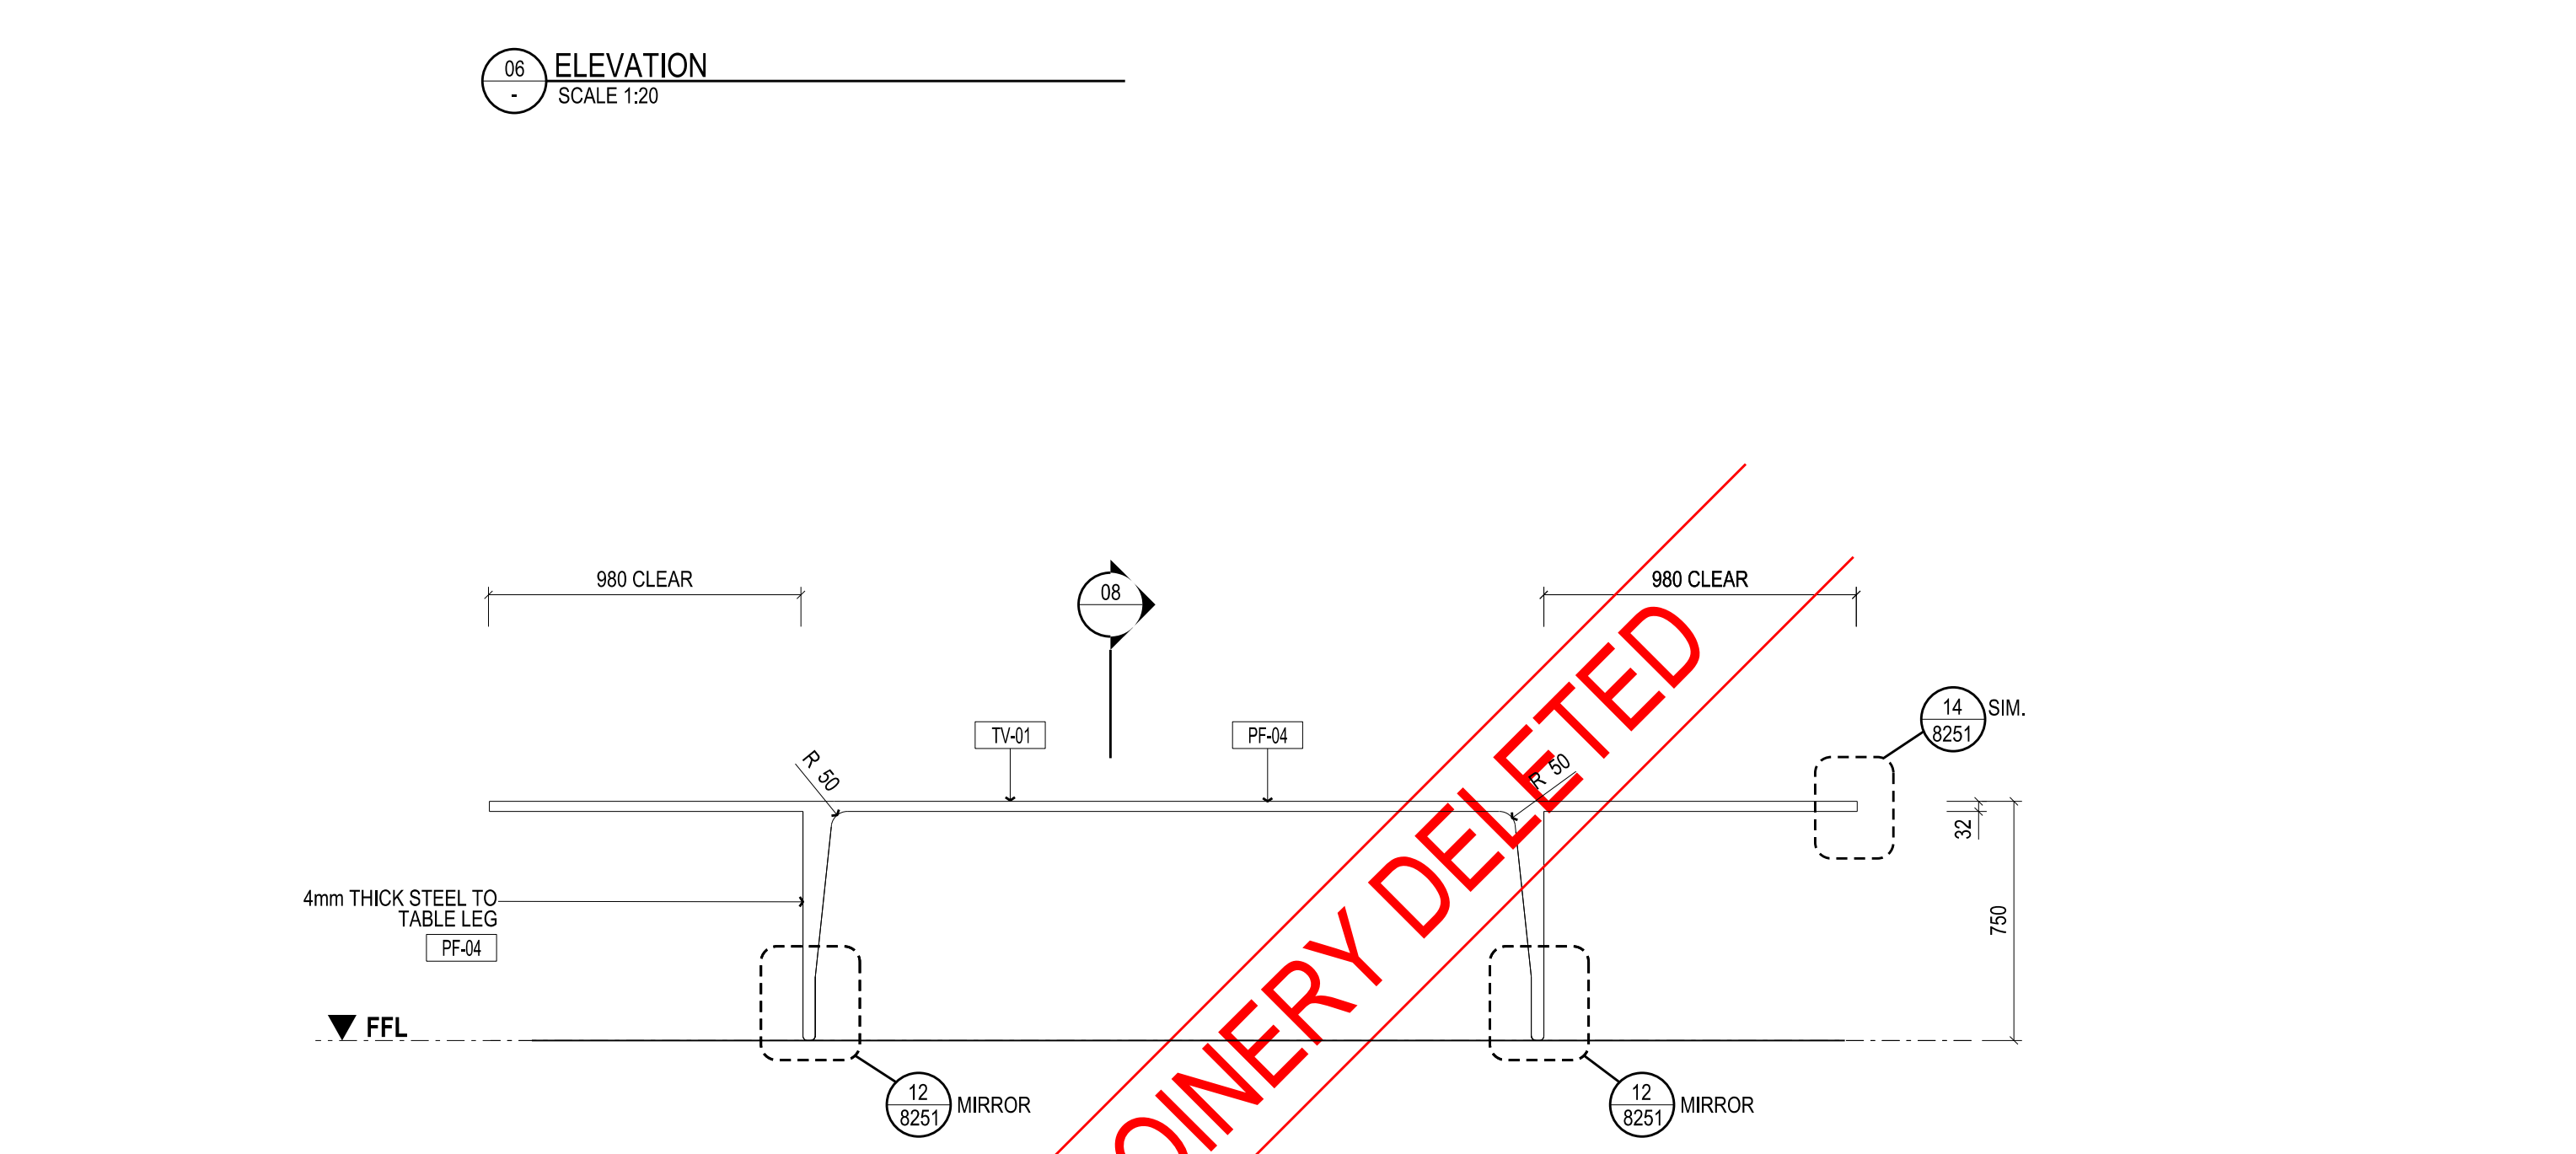

07 ELEVATION  
SCALE 1:20

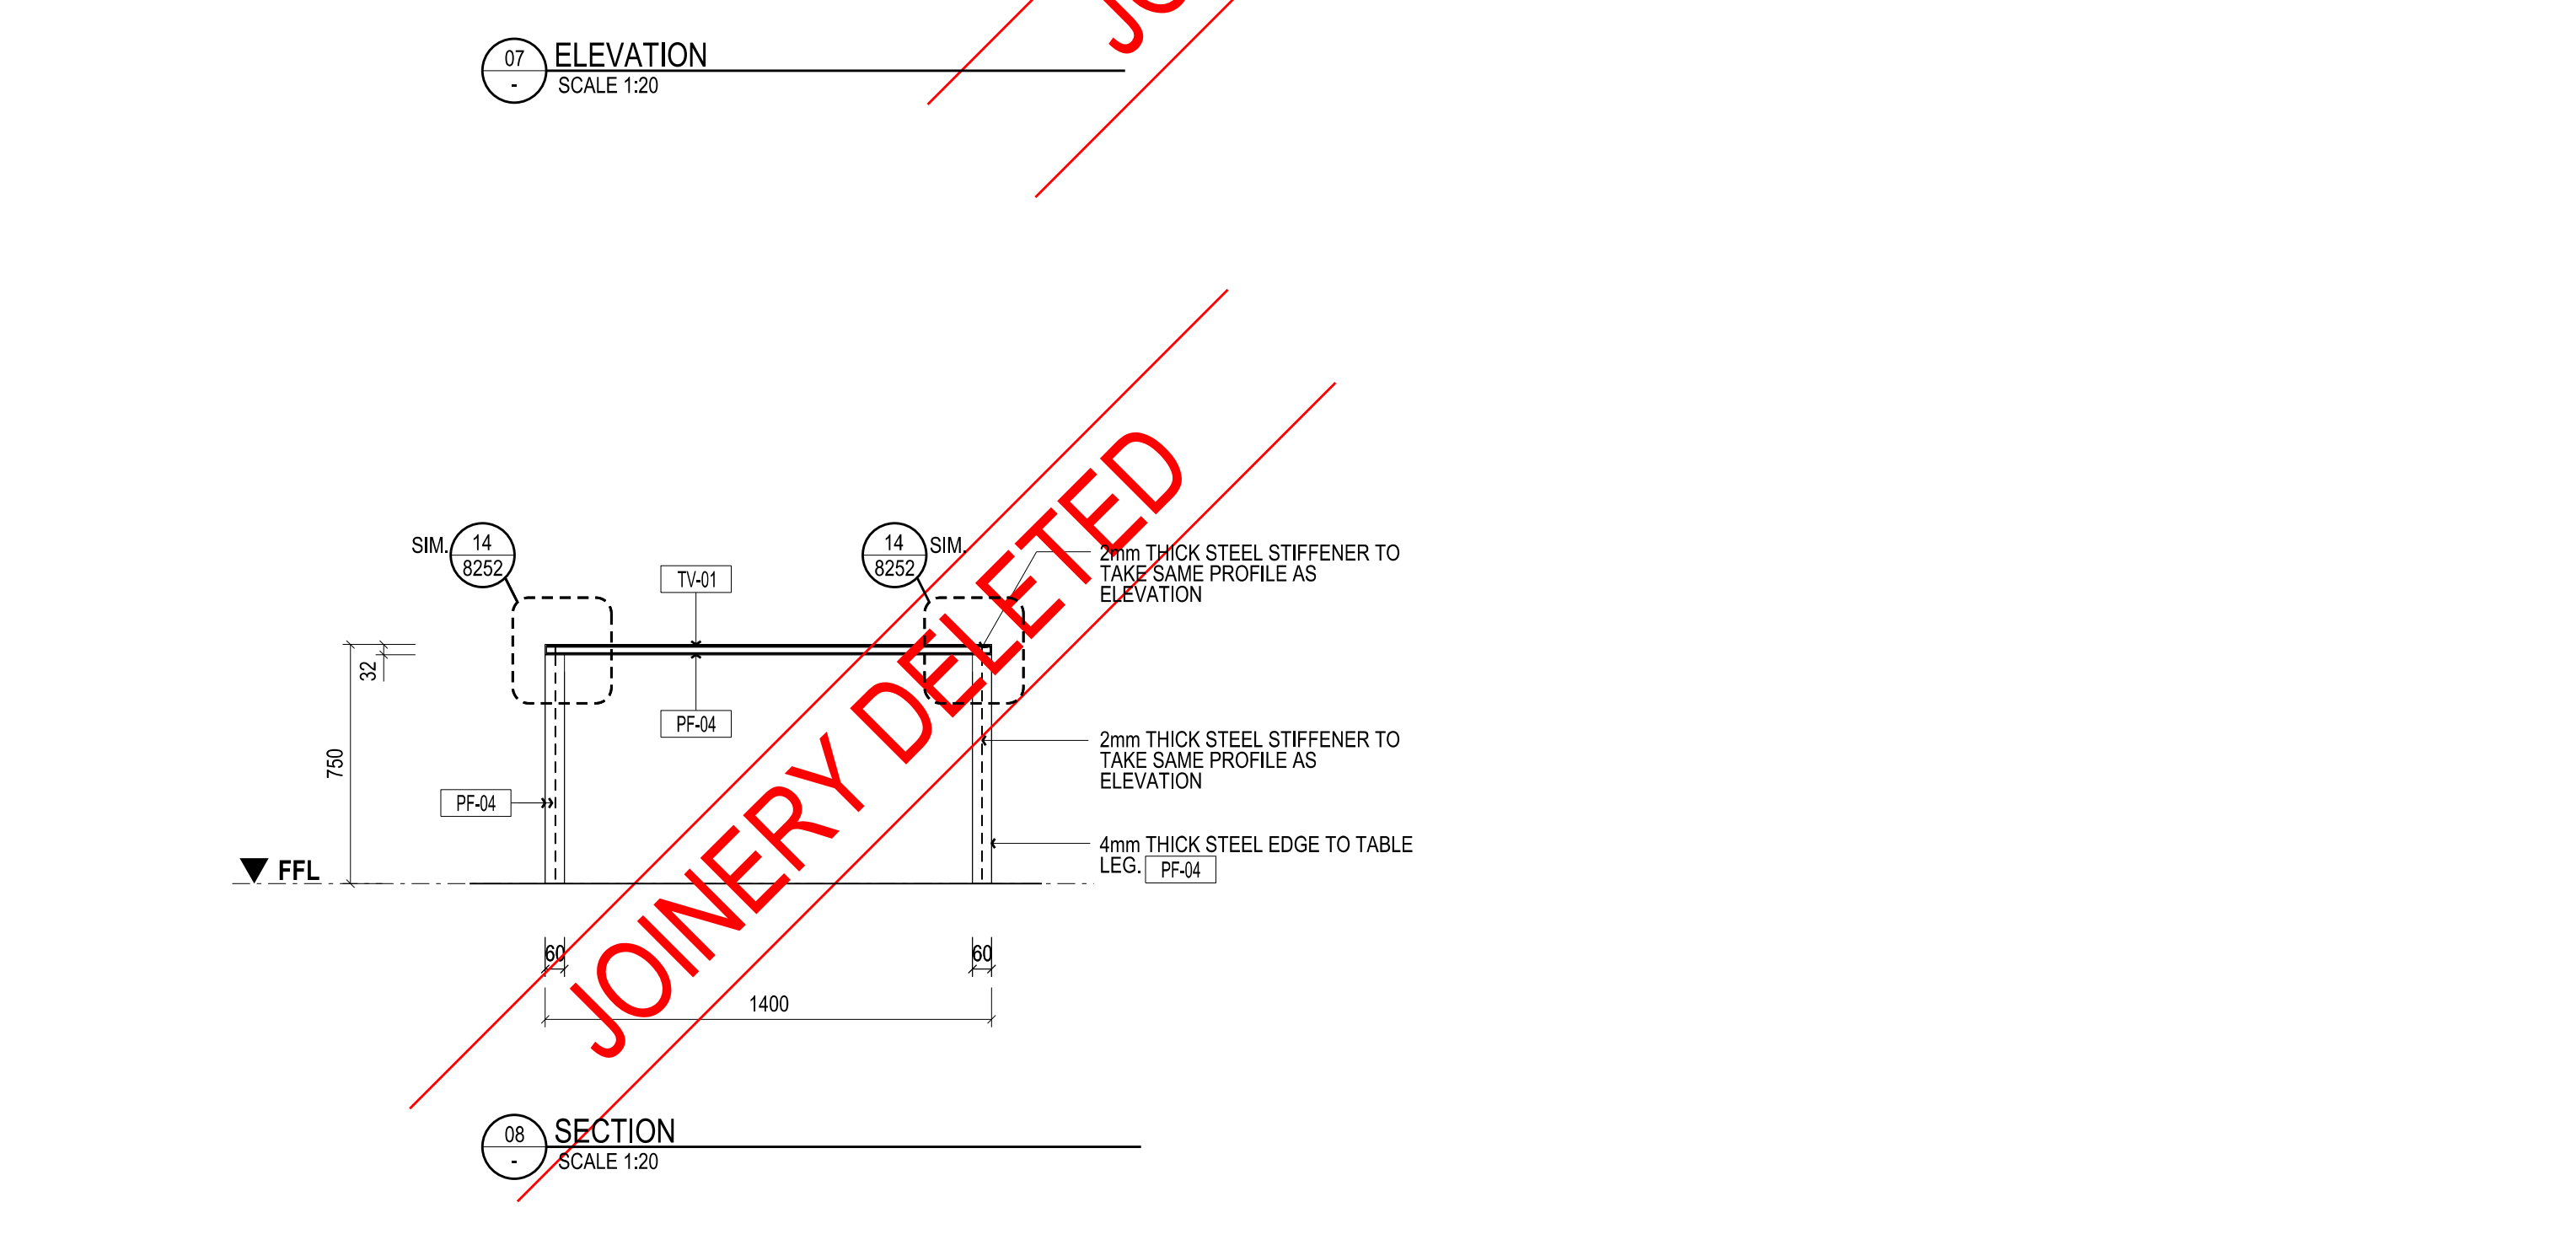

08 SECTION  
SCALE 1:20

THIS DRAWING IS AN UNCONTROLLED COPY UNLESS STAMPED OTHERWISE

CONTRACTORS SHALL VERIFY JOINT DIMENSIONS BEFORE ANY JOINT COMMENCEMENT. ALL JOINT DIMENSIONS SHALL BE SUBMITTED TO THE SUPERINTENDENT AND MANUFACTURER SHALL NOT COMMENCE PRIOR TO THE RETURN OF DIMENSIONED JOINT DRAWINGS. THIS DRAWING SHALL BE READ IN CONJUNCTION WITH ALL RELEVANT CONTRACT SPECIFICATIONS AND DRAWINGS COPYRIGHT OF THIS DRAWING IS VESTED IN NADAAA

General Notes

- 18mm E1 MDF CARCASS THROUGHOUT UNLESS OTHERWISE NOTED.
- ALL NON EXPOSED CARCASS TO BE MATCHING LAMINATE UNLESS OTHERWISE NOTED.
- ALL NON EXPOSED CARCASS TO BE BLACK LAMINATE TO JOINERY RECEIVING TIMBER VENEER FINISH, REFER MATERIALS SCHEDULE [ PL.05 ]
- ALL NON EXPOSED CARCASS TO BE WHITE LAMINATE TO JOINERY RECEIVING STAINLESS STEEL CLADDING, REFER MATERIALS SCHEDULE [ PL.01 ]
- ALL EXPOSED EDGES TO TIMBER VENEER PANELS TV-01 TO RECEIVE 3mm THK MATCHING SOLID EDGES, UNLESS OTHERWISE NOTED.
- SPLIT BATTENS TO BE 12mm UNLESS OTHERWISE NOTED.
- APPLY MATCHING LAMINATE ABS EDGING TO LAMINATED BENCHTOPS, UNLESS OTHERWISE NOTED.

REFER TO '1300 - MATERIALS SCHEDULE' FOR A DESCRIPTION OF THE MATERIAL CODES AS SHOWN ON THIS DRAWING. [ TV.05 ]

REFER TO '1400 - FIXTURES, FITTINGS & EQUIPMENT SCHEDULE' FOR A DESCRIPTION OF THE FF&E CODES AS SHOWN ON THIS DRAWING. [ J04.00 ]

ALL EXPOSED SURFACES TO BE FULLY LINED IN STAINLESS STEEL, UNFINISHED FINISH [ SS.01 ]

ALL JOINERY LOCKS TO BE [ JH.02 ] UNLESS OTHERWISE NOTED.

REFER TO DRAWING AR7300 FOR MOUNTING HEIGHTS FOR ALL SERVICES FIXTURES, UNLESS OTHERWISE DIMENSIONED ON THE JOINERY ELEVATIONS.

ALL CORNER JOINTS TO BE MITRED UNLESS OTHERWISE NOTED.

ALL UPHOLSTERY STITCHING TOO MATCH FABRIC COLOUR UNLESS OTHERWISE NOTED.

DRAWINGS TO BE READ IN CONJUNCTION WITH AR1200 SERIES INTERNAL ARRANGEMENT PLANS TO COORDINATE FIXINGS INTO PARTITIONS WHERE NECESSARY

FS = FIXED SHELF  
AS = ADJUSTABLE SHELF  
PP = FIXED PANEL  
PJ = PANEL JOIN, MAXIMUM WIDTH 2mm

C.O.S = CHECK ON SITE - DIMENSIONS MUST BE VERIFIED ON SITE BY CONTRACTOR PRIOR TO COMMENCEMENT OF CONSTRUCTION.

NOM = NOMINAL  
TYP. = TYPICAL  
SIM. = SIMILAR  
MIRR. = MIRROR  
FCL = FINISHED CEILING LEVEL  
FFL = FINISHED FLOOR LEVEL  
SSL = STRUCTURAL SLAB LEVEL  
C = CENTRELINE  
DIRECTION OF GRAIN / LINISH

03 SG UPDATES AS CLOUDED - 03.03.14  
04 SG UPDATES AS CLOUDED - 17.02.14  
05 SG ISSUE FOR CONSTRUCTION - 20.12.13  
06 SG TENDER ADDENDUM NO. 04 - 08.10.12  
07 SG 100% CD - TENDER ISSUE - 07.09.12  
08 SG 90% CD ISSUE - 10.08.12  
09 SG 75% CD ISSUE - 13.07.12  
10 SG 55% CD ISSUE - 01.08.12

Rev Issue Revision Description And Date



NADAAA  
NADAAA  
1520 Washington Street No.2 Boston Massachusetts 02118 USA  
Telephone +1 617 442 8232 Facsimile +1 688 442 1417 Email nadaaa@nadaaa.com

John Wardle Architects  
25 Rokeby Street, Collingwood, Victoria 3066 Australia  
Tel: +61 3 8662 0400 www.johnwardlearchitects.com  
© 2014 John Wardle Architects ABN 83 006 814 268

Client University of Melbourne Parkville Campus

Project Faculty of Architecture Building and Planning

Title JOINERY DETAILS

Project No.	0913	Scale	1:20 @ A0 1:40 @ A2
Drawing No.	AR8172	Revision	C
Date	Dec 2011	Drawn	SC
		Co-Ord	SG
		Chk	JA

FOR CONSTRUCTION