


THIS DRAWING IS AN UNCONTROLLED COPY UNLESS STAMPED OTHERWISE


CONTRACTORS SHALL VERIFY JOB DIMENSIONS BEFORE ANY JOB COMMENCES. ALL SHOP DRAWINGS SHALL BE SUBMITTED TO THE SUPERINTENDENT AND MANUFACTURER SHALL NOT COMMENCE FROM THE RETURN OF DIMENSIONS SHOP DRAWINGS ISSUED BY THE CONSULTANT. DIMENSIONS SHALL TAKE PRECEDENCE OVER SCALES. THIS DRAWING SHALL BE READ IN CONJUNCTION WITH ALL RELEVANT CONTRACT SPECIFICATIONS AND DRAWINGS COPYRIGHT OF THIS DRAWING IS VESTED IN WARDLE

General Notes

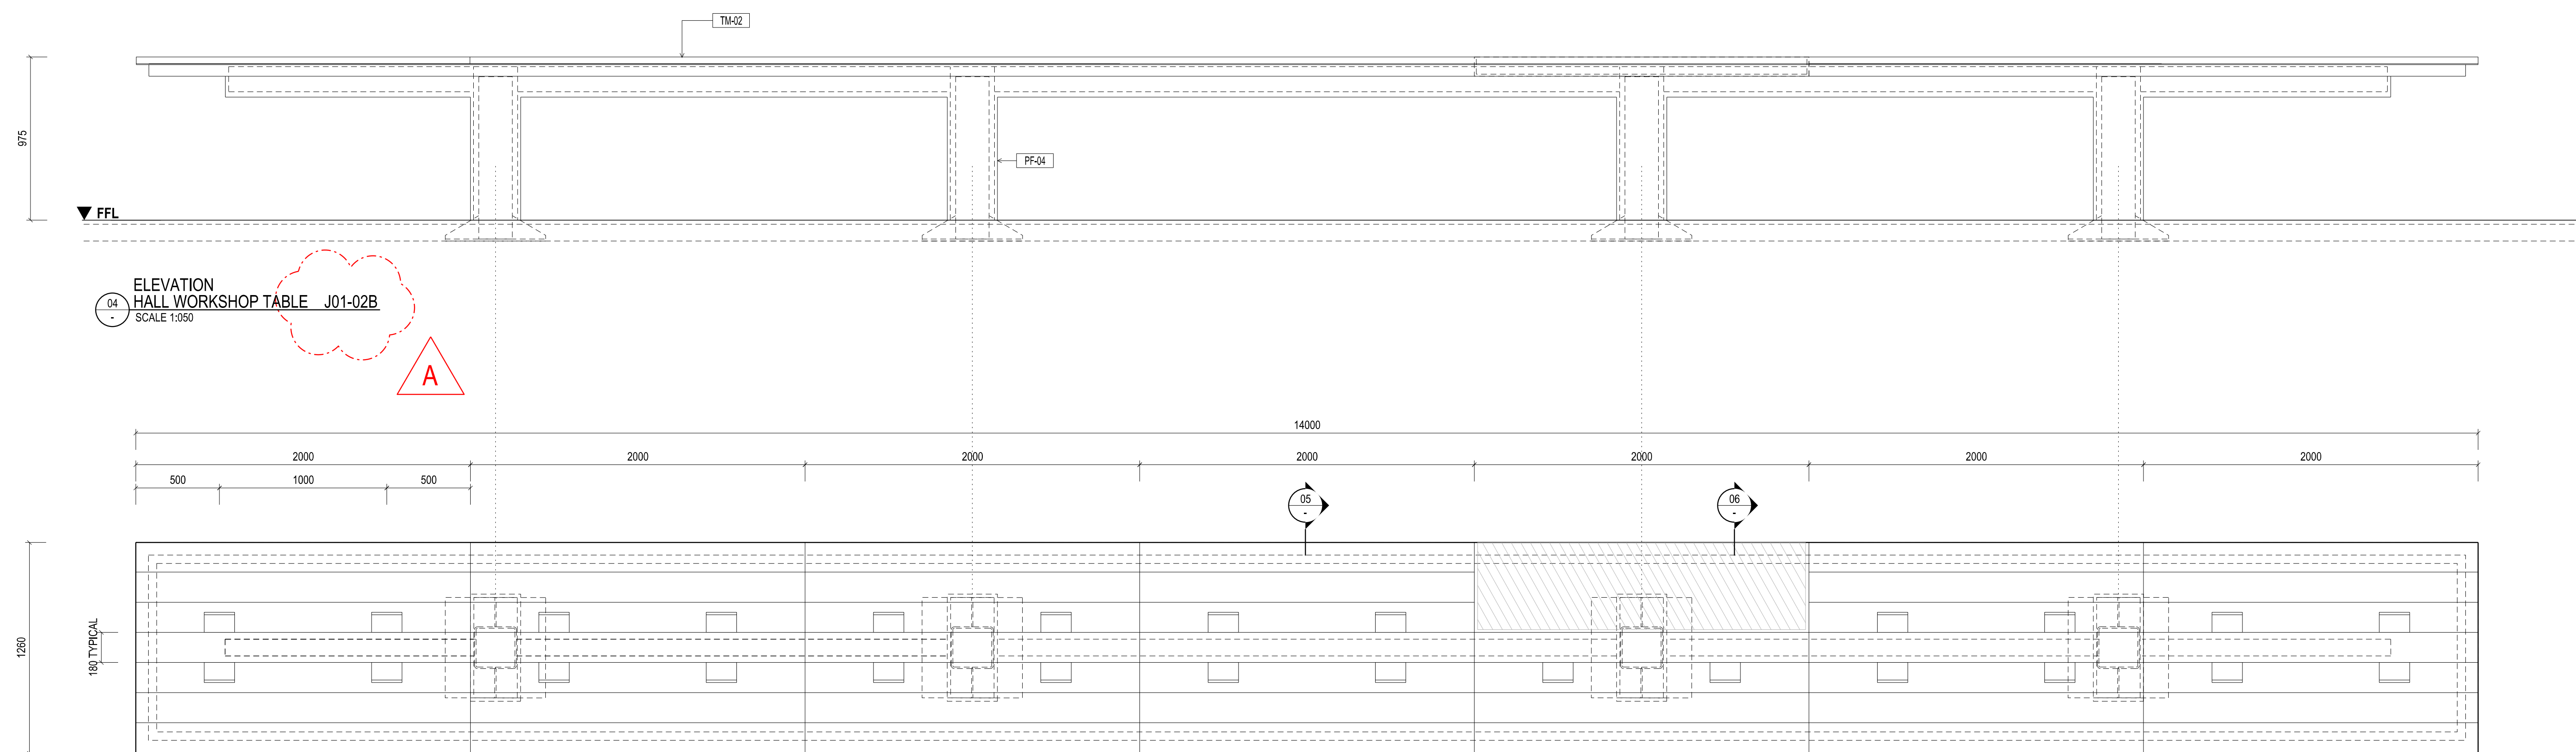


ELEVATION
HALL WORKSHOP TABLE J01-02B
SCALE 1:200

PLAN
HALL WORKSHOP TABLE J01-02B
SCALE 1:200

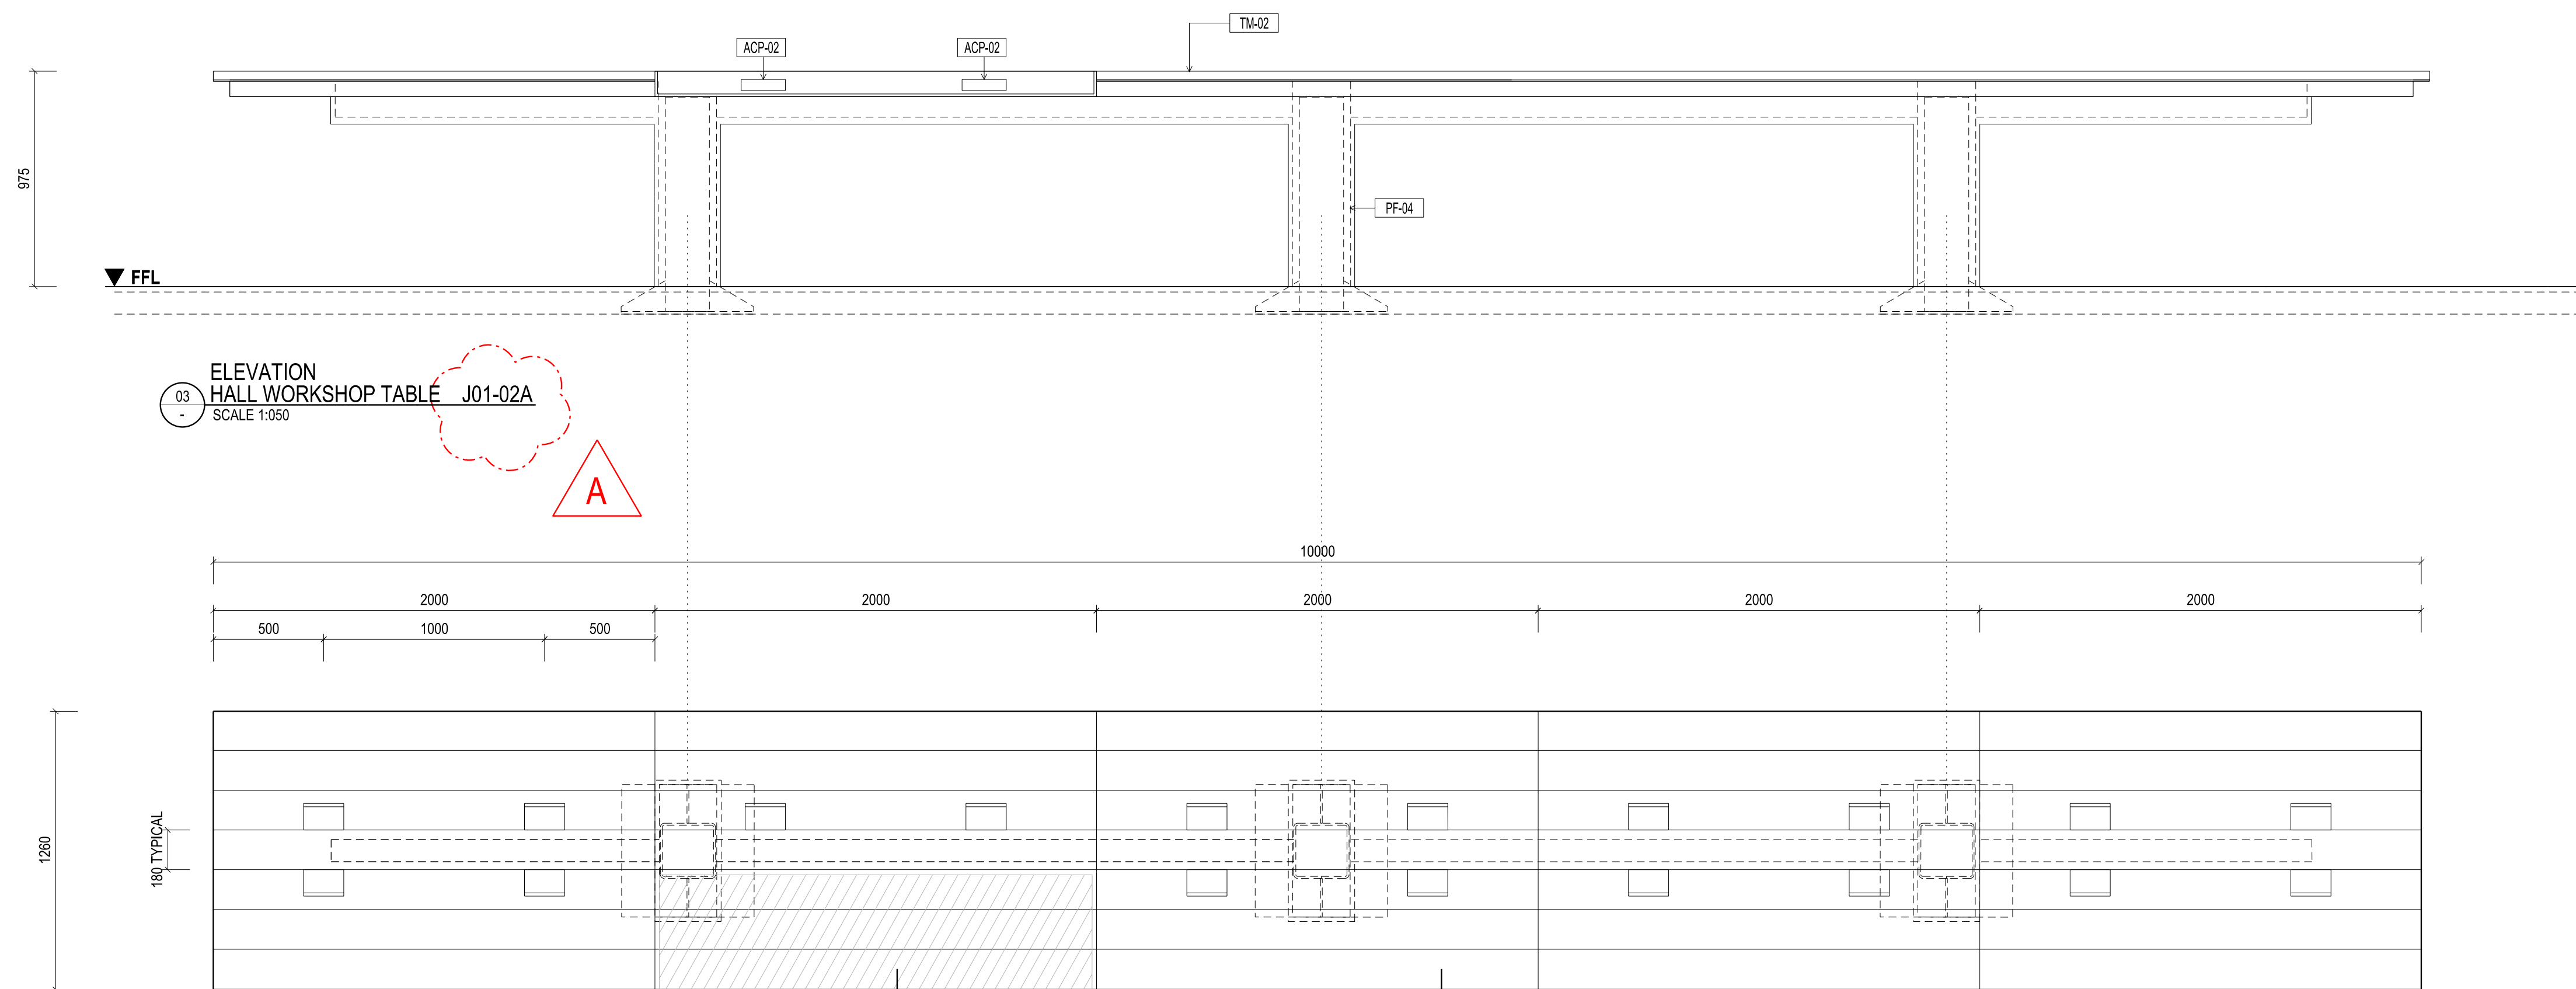


ELEVATION
HALL WORKSHOP TABLE J01-02A
SCALE 1:200

PLAN
HALL WORKSHOP TABLE J01-02A
SCALE 1:200

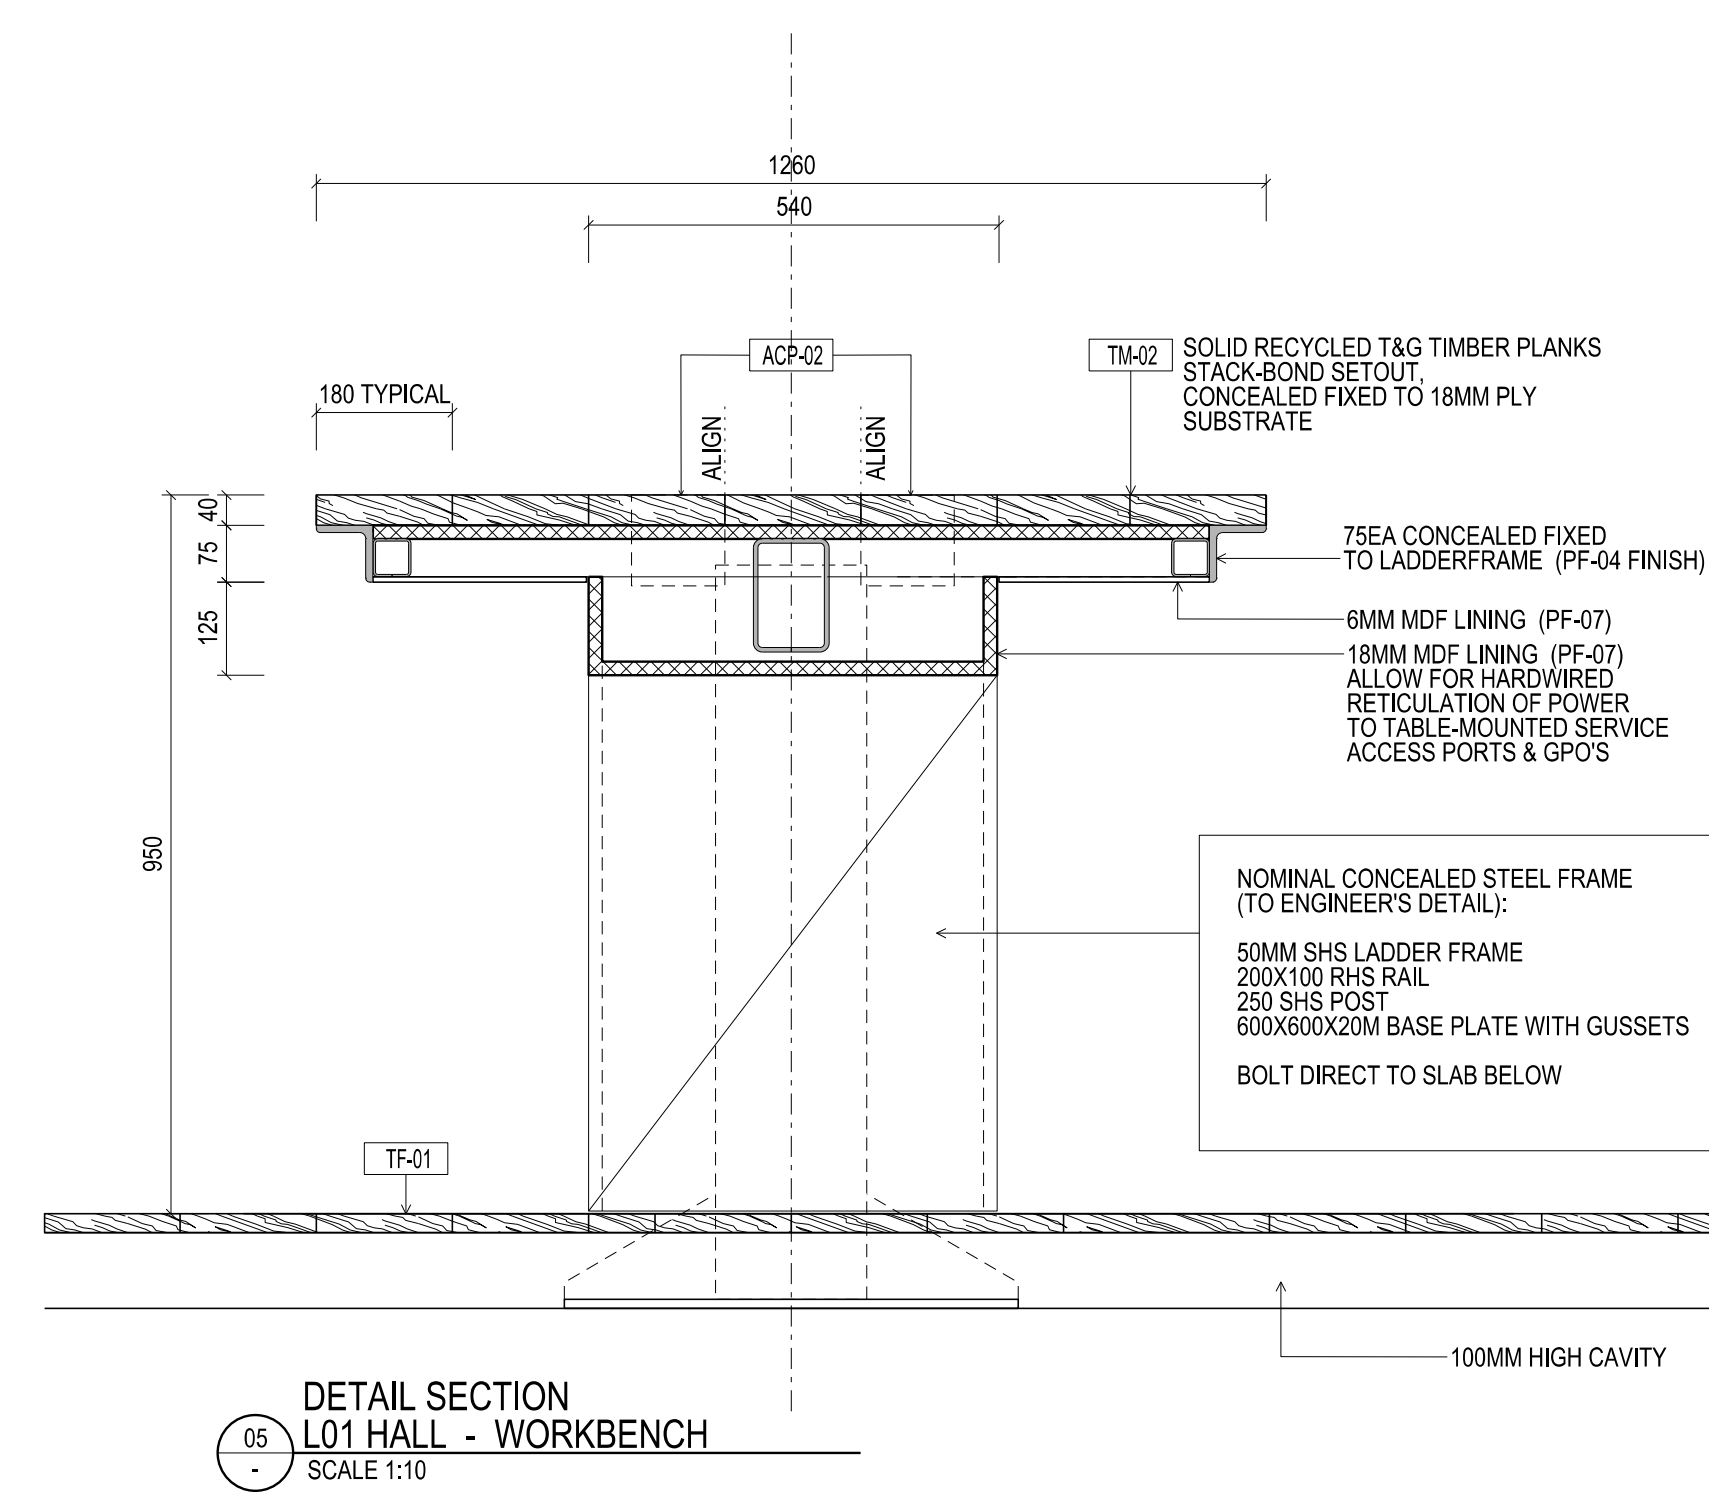

DETAIL SECTION
L01 HALL - WORKBENCH
SCALE 1:10

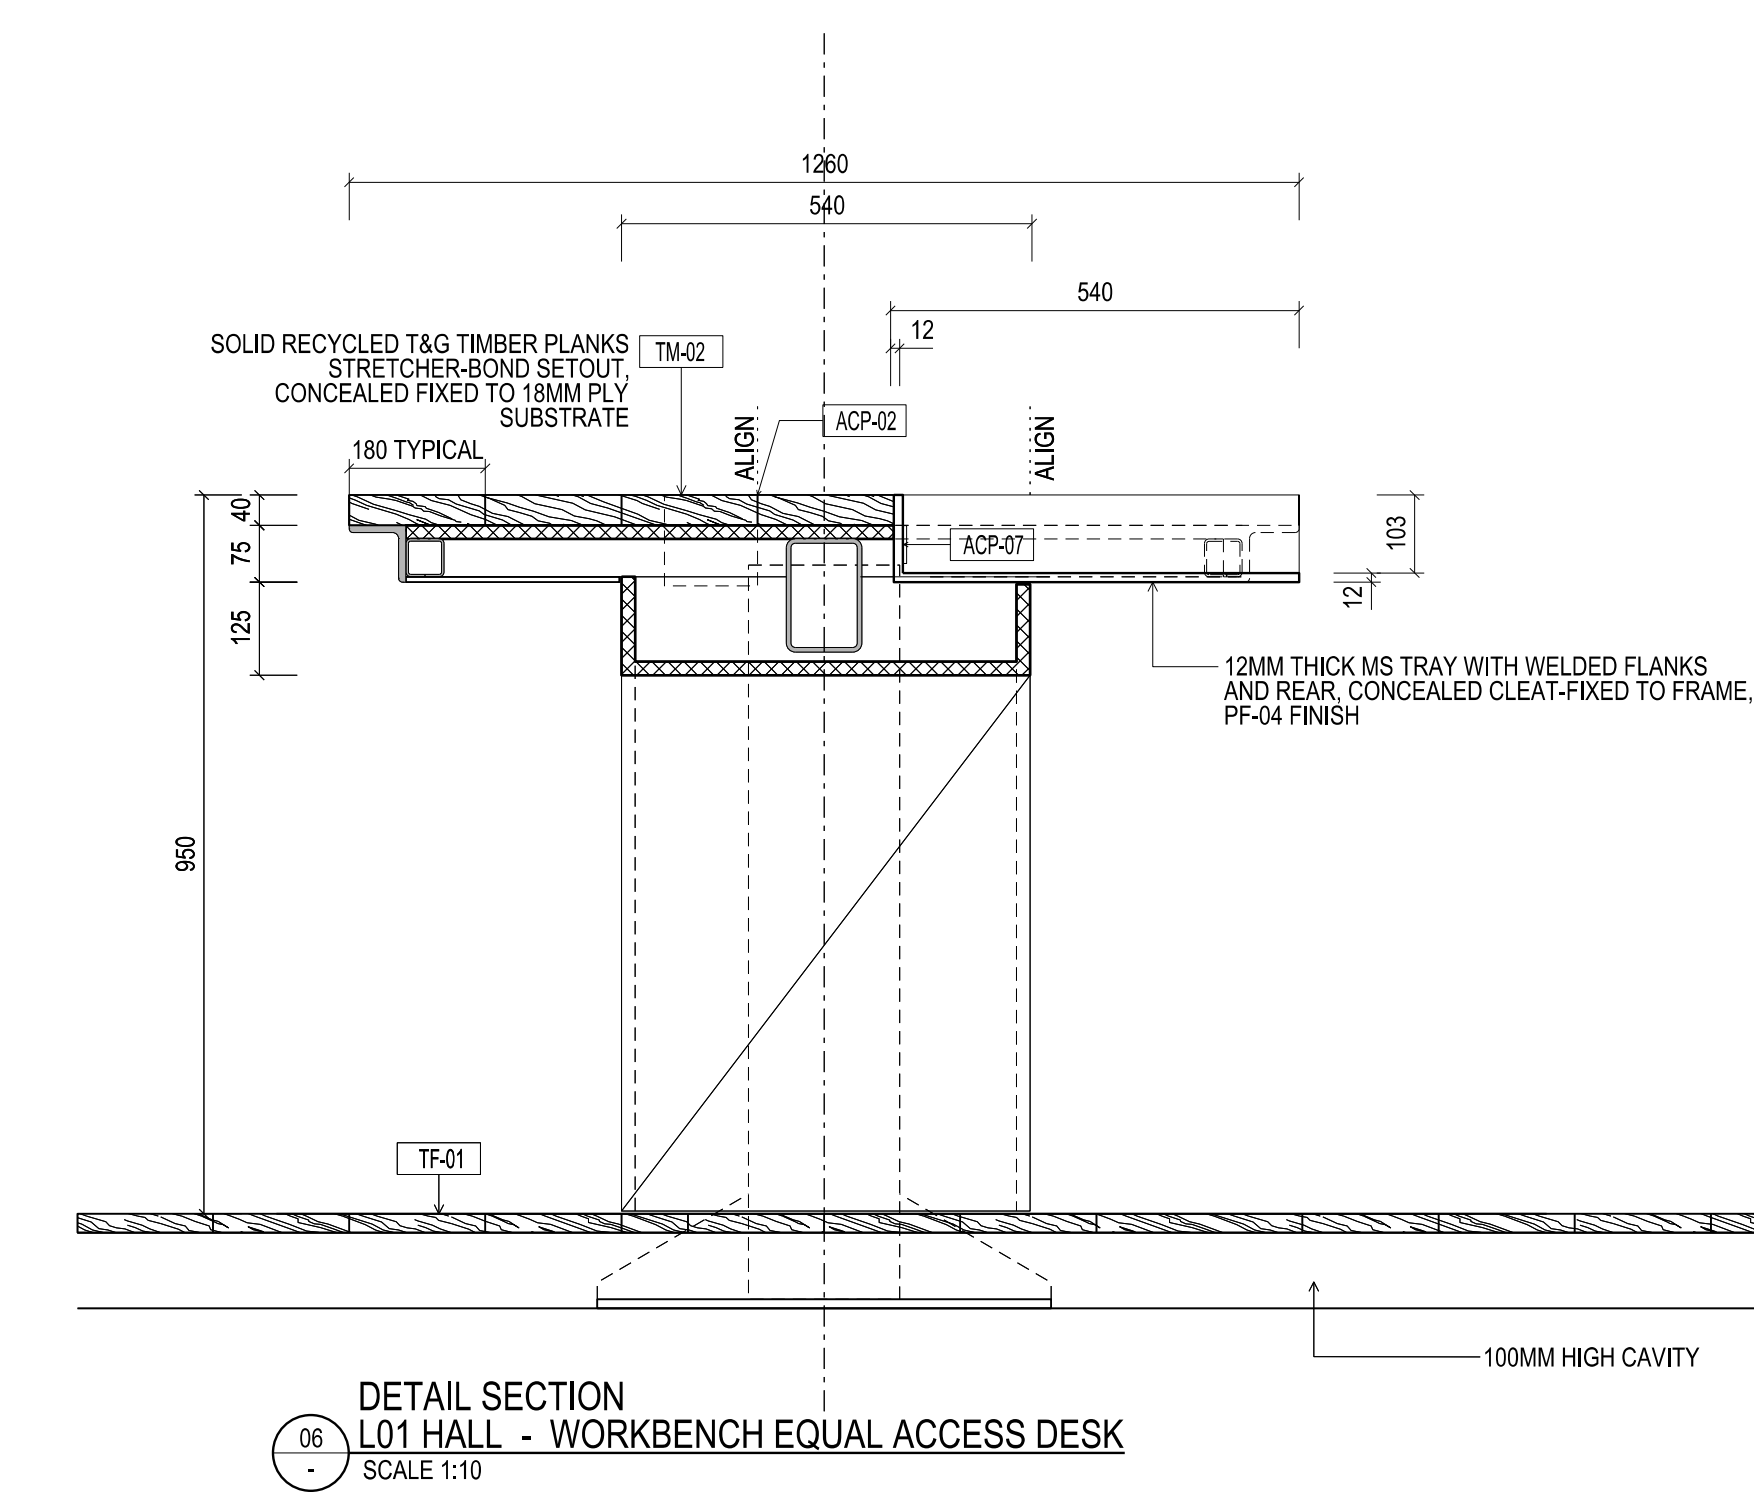

DETAIL SECTION
L01 HALL - WORKBENCH EQUAL ACCESS DESK
SCALE 1:10

Rev	Issue	Revision Description	Amd	Date
A	SG	ISSUE FOR CONSTRUCTION		19.12.13
02	JA	VW AMENDMENT - TABLE SIZE AND LAYOUT		27.02.13
01	SG	TENDER ADDENDUM NO.4		08.10.12



NADAAA
 NADAAA
 1520 Washington Street No.2 Boston Massachusetts 02118 USA
 Telephone +1 817 442 8232 Facsimile +1 888 442 1417 Email nadaa@nadaaa.com

John Wardle Architects
 25 Rokeby Street, Collingwood, Victoria 3066 Australia
 Tel: +61 3 8662 0400 www.johnwardlearchitects.com
 © 2012 John Wardle Architects ABN 83 006 814 268

Client **University of Melbourne Parkville Campus**
 Project **Faculty of Architecture Building and Planning**
 Title **JOINERY DETAILS - HALL WORKBENCH**

Project No.	0913	Scale	1:20 @ A0 1:40 @ A2
Drawing No.	AR8177	Revision	A
Date	Dec 2011	Dwn	-
Co-Ord	-	Chk	-

FILENAME - \$FILES
FOR CONSTRUCTION