

CONTRACTORS SHALL VERIFY DIMENSIONS BEFORE ANY JOB COMMENCES. ALL SHOP DRAWINGS SHALL BE SUBMITTED TO THE SUPERINTENDENT AND MANUFACTURE SHALL NOT COMMENCE PRIOR TO THE RETURN OF DIMANDED SHOP DRAWINGS BEING BY THE CONSULTANT. FINISHED DIMENSIONS SHALL TAKE PRECEDENCE OVER SCALED THIS DRAWING SHOULD BE READ IN CONJUNCTION WITH ALL RELEVANT CONTRACT SPECIFICATIONS AND DRAWING COPYRIGHT OF THIS DRAWING IS VESTED IN NADAAA

General Notes ALL JOINERY TO REFER TO INTERIOR ELEVATIONS (AR1100 SERIES)


- 18mm 'E1' MDF CARCASS THROUGHOUT UNLESS OTHERWISE NOTED.
- ALL NON EXPOSED CARCASS TO BE MATCHING LAMINATE UNLESS OTHERWISE NOTED.
- ALL NON EXPOSED CARCASS TO BE BLACK LAMINATE TO JOINERY RECEIVING TIMBER VENEER FINISH. REFER MATERIALS SCHEDULE [PL-03]
- ALL NON EXPOSED CARCASS TO BE WHITE LAMINATE TO JOINERY RECEIVING STAINLESS STEEL CLADDING. REFER MATERIALS SCHEDULE [PL-01]
- ALL EXPOSED EDGES TO TIMBER VENEER PANELS TV-01 TO RECEIVE 3mm THK MATCHING SOLID EDGES. UNLESS OTHERWISE NOTED.
- SPLIT BATTENS TO BE 12mm UNLESS OTHERWISE NOTED.
- APPLY MATCHING LAMINATE ABS EDGING TO LAMINATED BENCHTOPS, UNLESS OTHERWISE NOTED
- REFER TO '1300 - MATERIALS SCHEDULE' FOR A DESCRIPTION OF THE MATERIAL CODES AS SHOWN ON THIS DRAWING. [TV-02]
- REFER TO '1400 - FIXTURES, FITTINGS & EQUIPMENT SCHEDULE' FOR A DESCRIPTION OF THE FF&E CODES AS SHOWN ON THIS DRAWING. [ZOH-01]
- ALL JOINERY LOCKS TO BE [JH-02] UNLESS OTHERWISE NOTED.
- REFER TO DRAWING AR7300 FOR MOUNTING HEIGHTS FOR ALL SERVICES FIXTURES. UNLESS OTHERWISE DIMENSIONED ON THE JOINERY ELEVATIONS.
- ALL CORNER JUNCTIONS TO BE MITRED UNLESS OTHERWISE NOTED.
- ALL UPHOLSTERY STITCHING TOO MATCH FABRIC COLOUR UNLESS OTHERWISE NOTED

DRAWINGS TO BE READ IN CONJUNCTION WITH AR1200 SERIES INTERNAL ARRANGEMENT PLANS TO COORDINATE FIXINGS INTO PARTITIONS WHERE NECESSARY


- FS = FIXED SHELF
- AS = ADJUSTABLE SHELF
- FP = FIXED PANEL
- PJ = PANEL JOIN. MAXIMUM WIDTH 2mm

C.O.S. = CHECK ON SITE. DIMENSIONS MUST BE VERIFIED ON SITE BY CONTRACTOR PRIOR TO COMMENCEMENT OF CONSTRUCTION.


- NOM. = NOMINAL
- TYP. = TYPICAL
- SMIL. = SIMILAR
- MIRR. = MIRROR
- FCL. = FINISHED CEILING LEVEL
- FFL. = FINISHED FLOOR LEVEL
- SSL. = STRUCTURAL SLAB LEVEL
- C. = CENTRELINE
- ↻ = DIRECTION OF GRAIN / LINISH

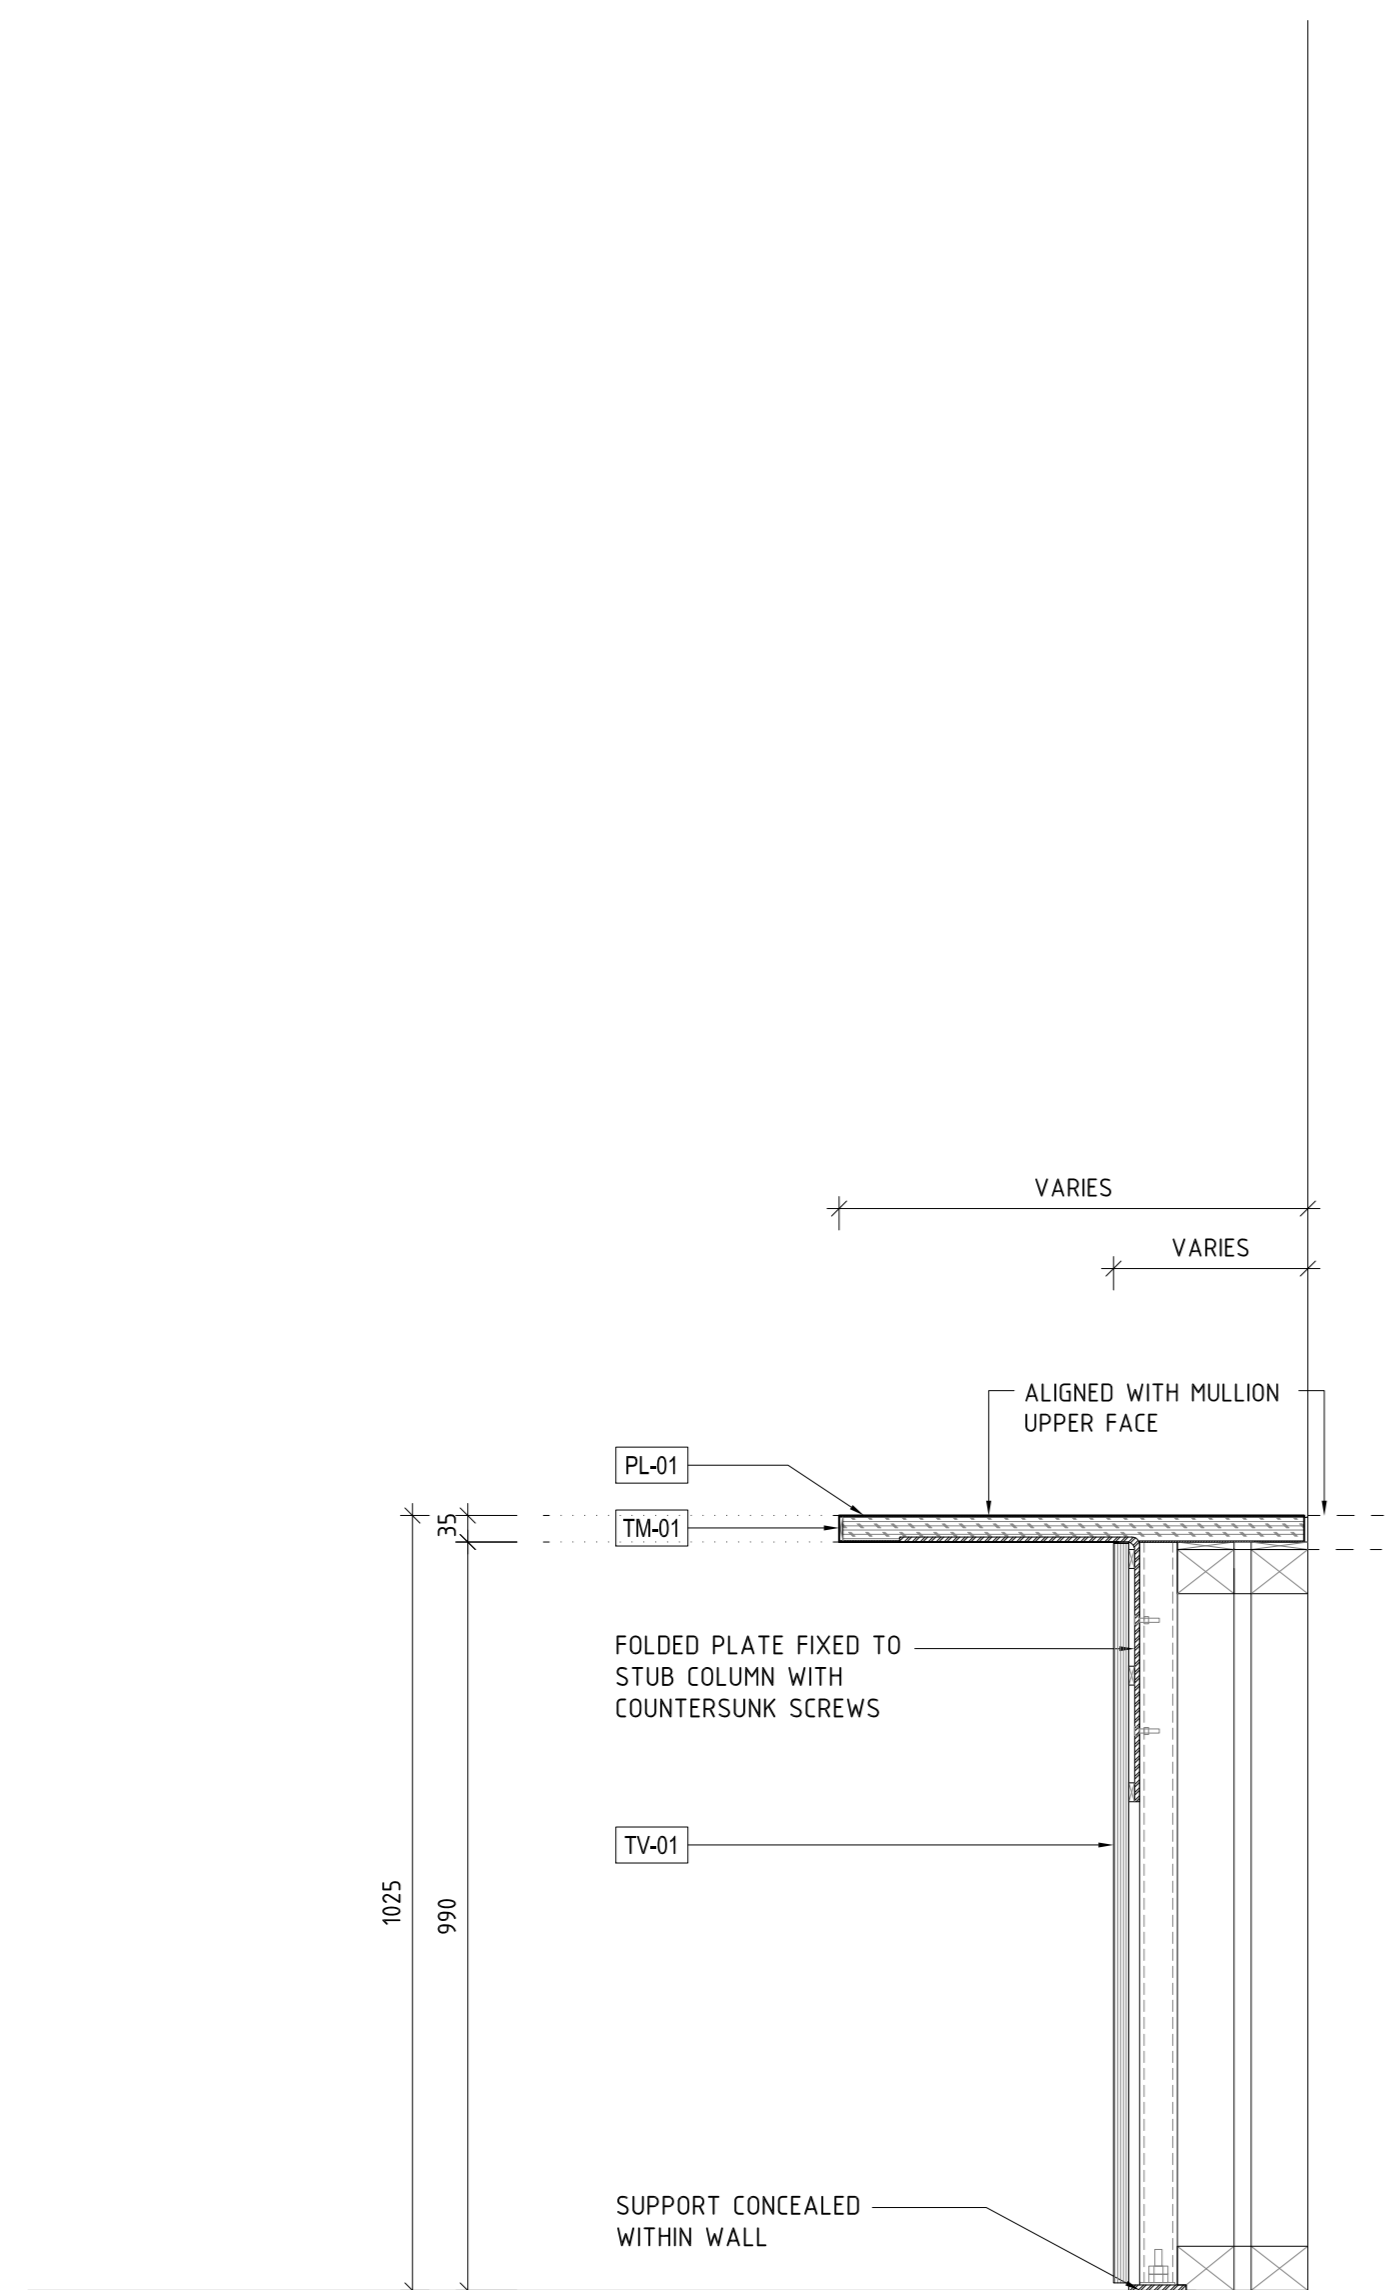


10 INFORMAL SPACE J02-22-SECTION SCALE 1:10

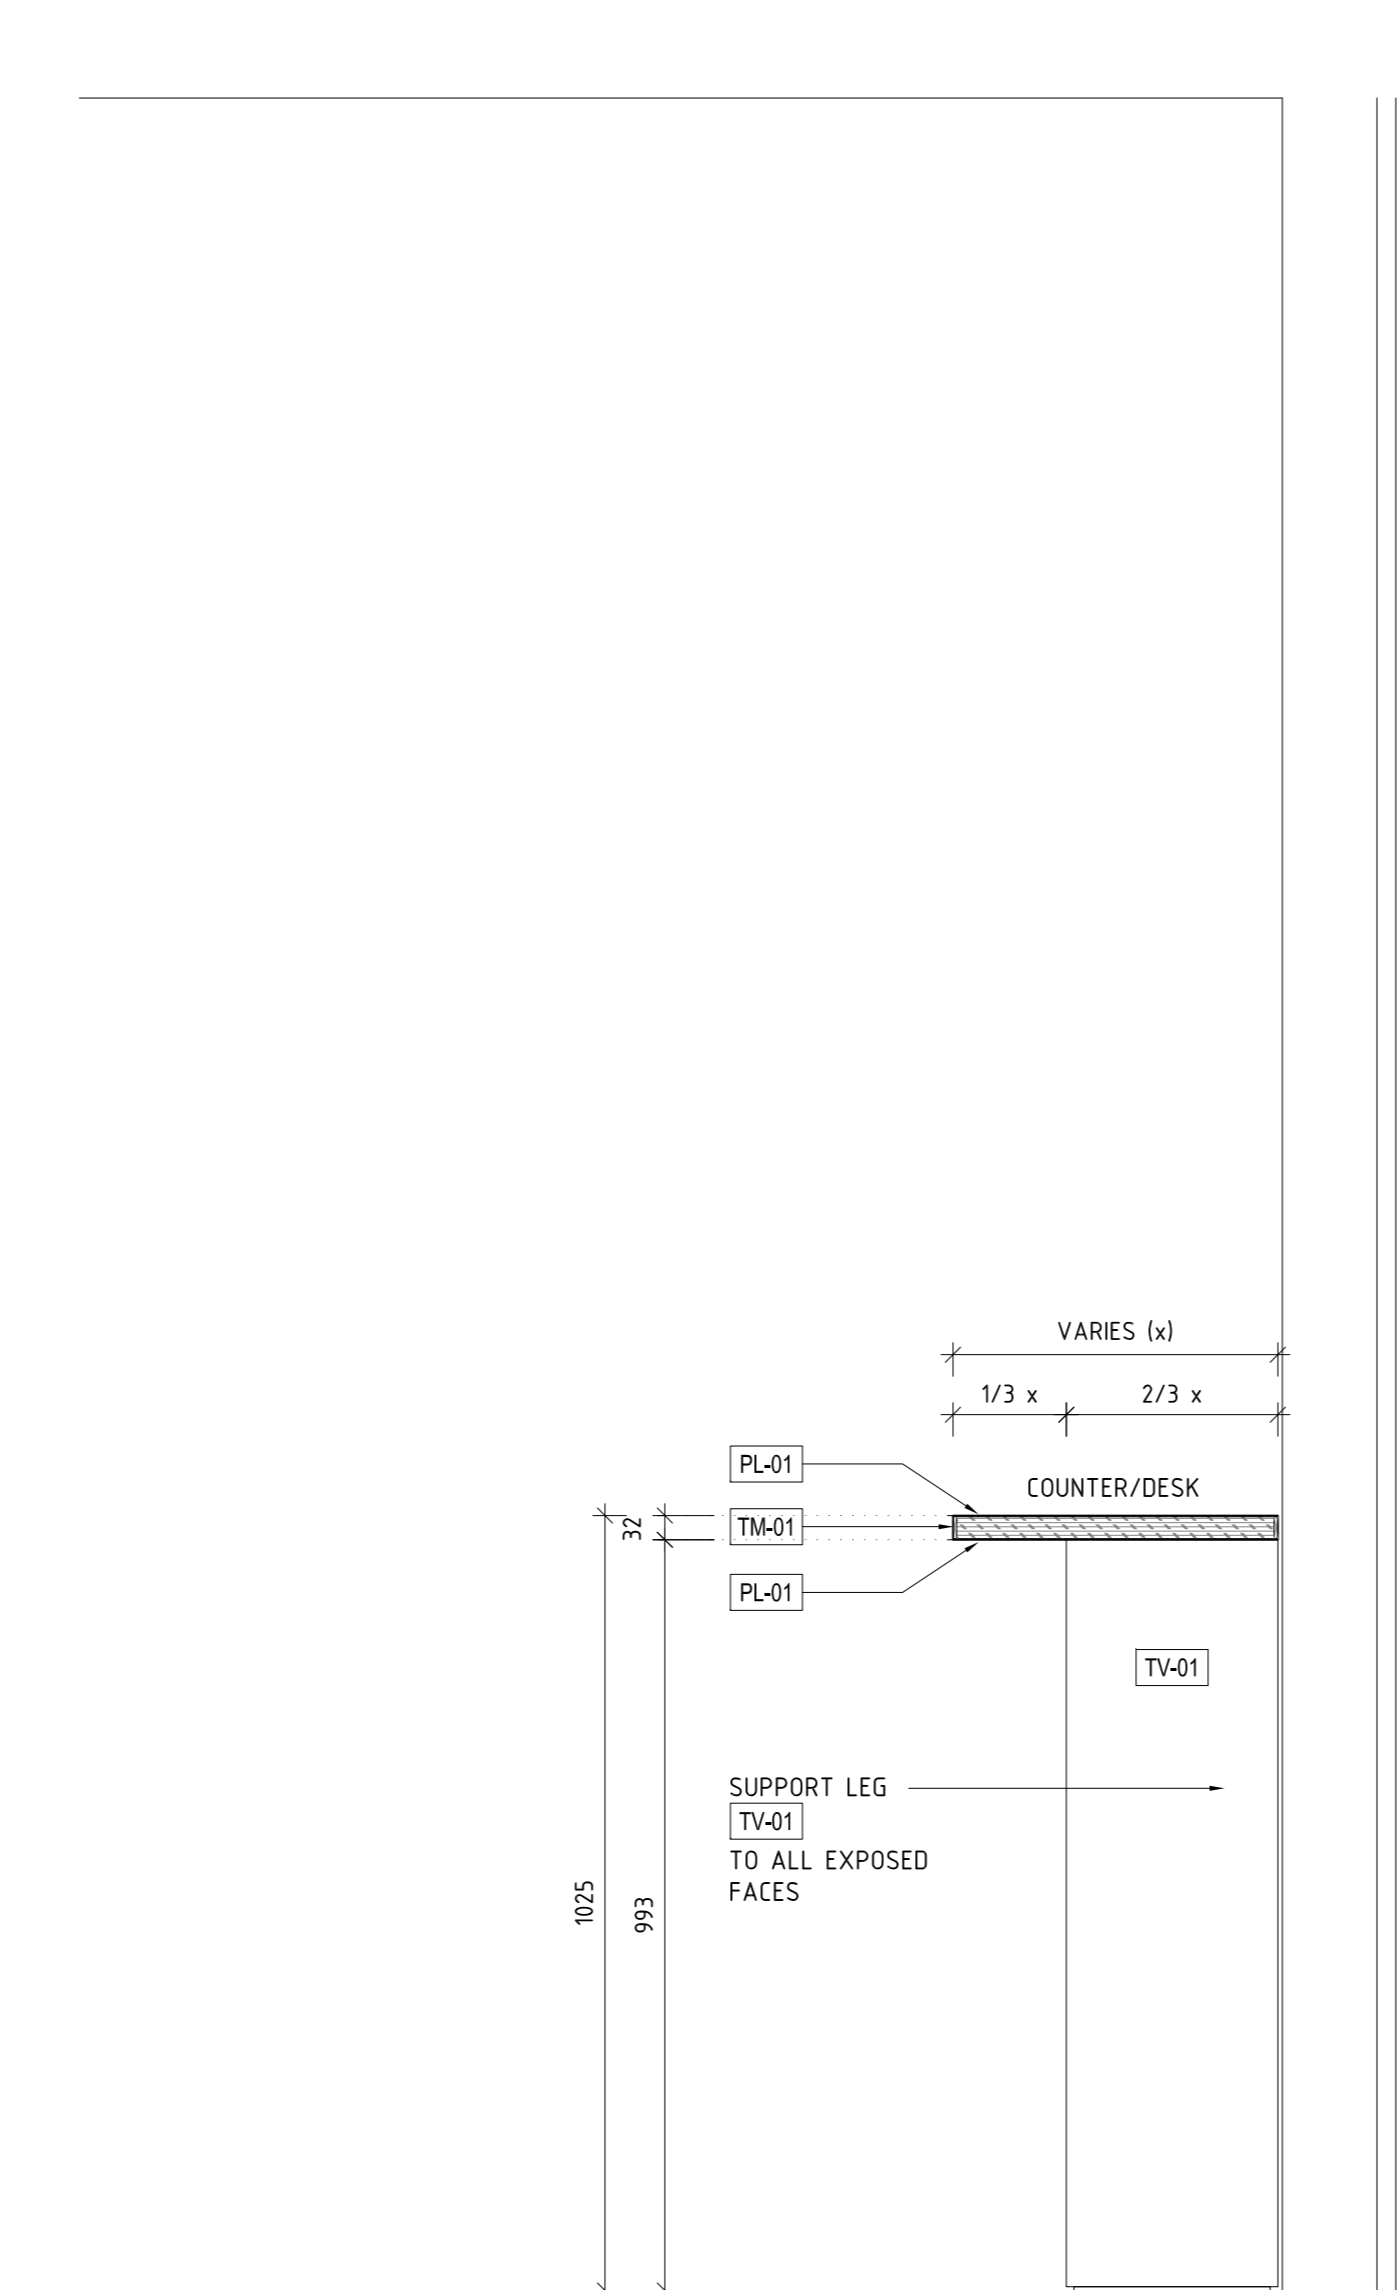

09 REMOVED SCALE 1:10

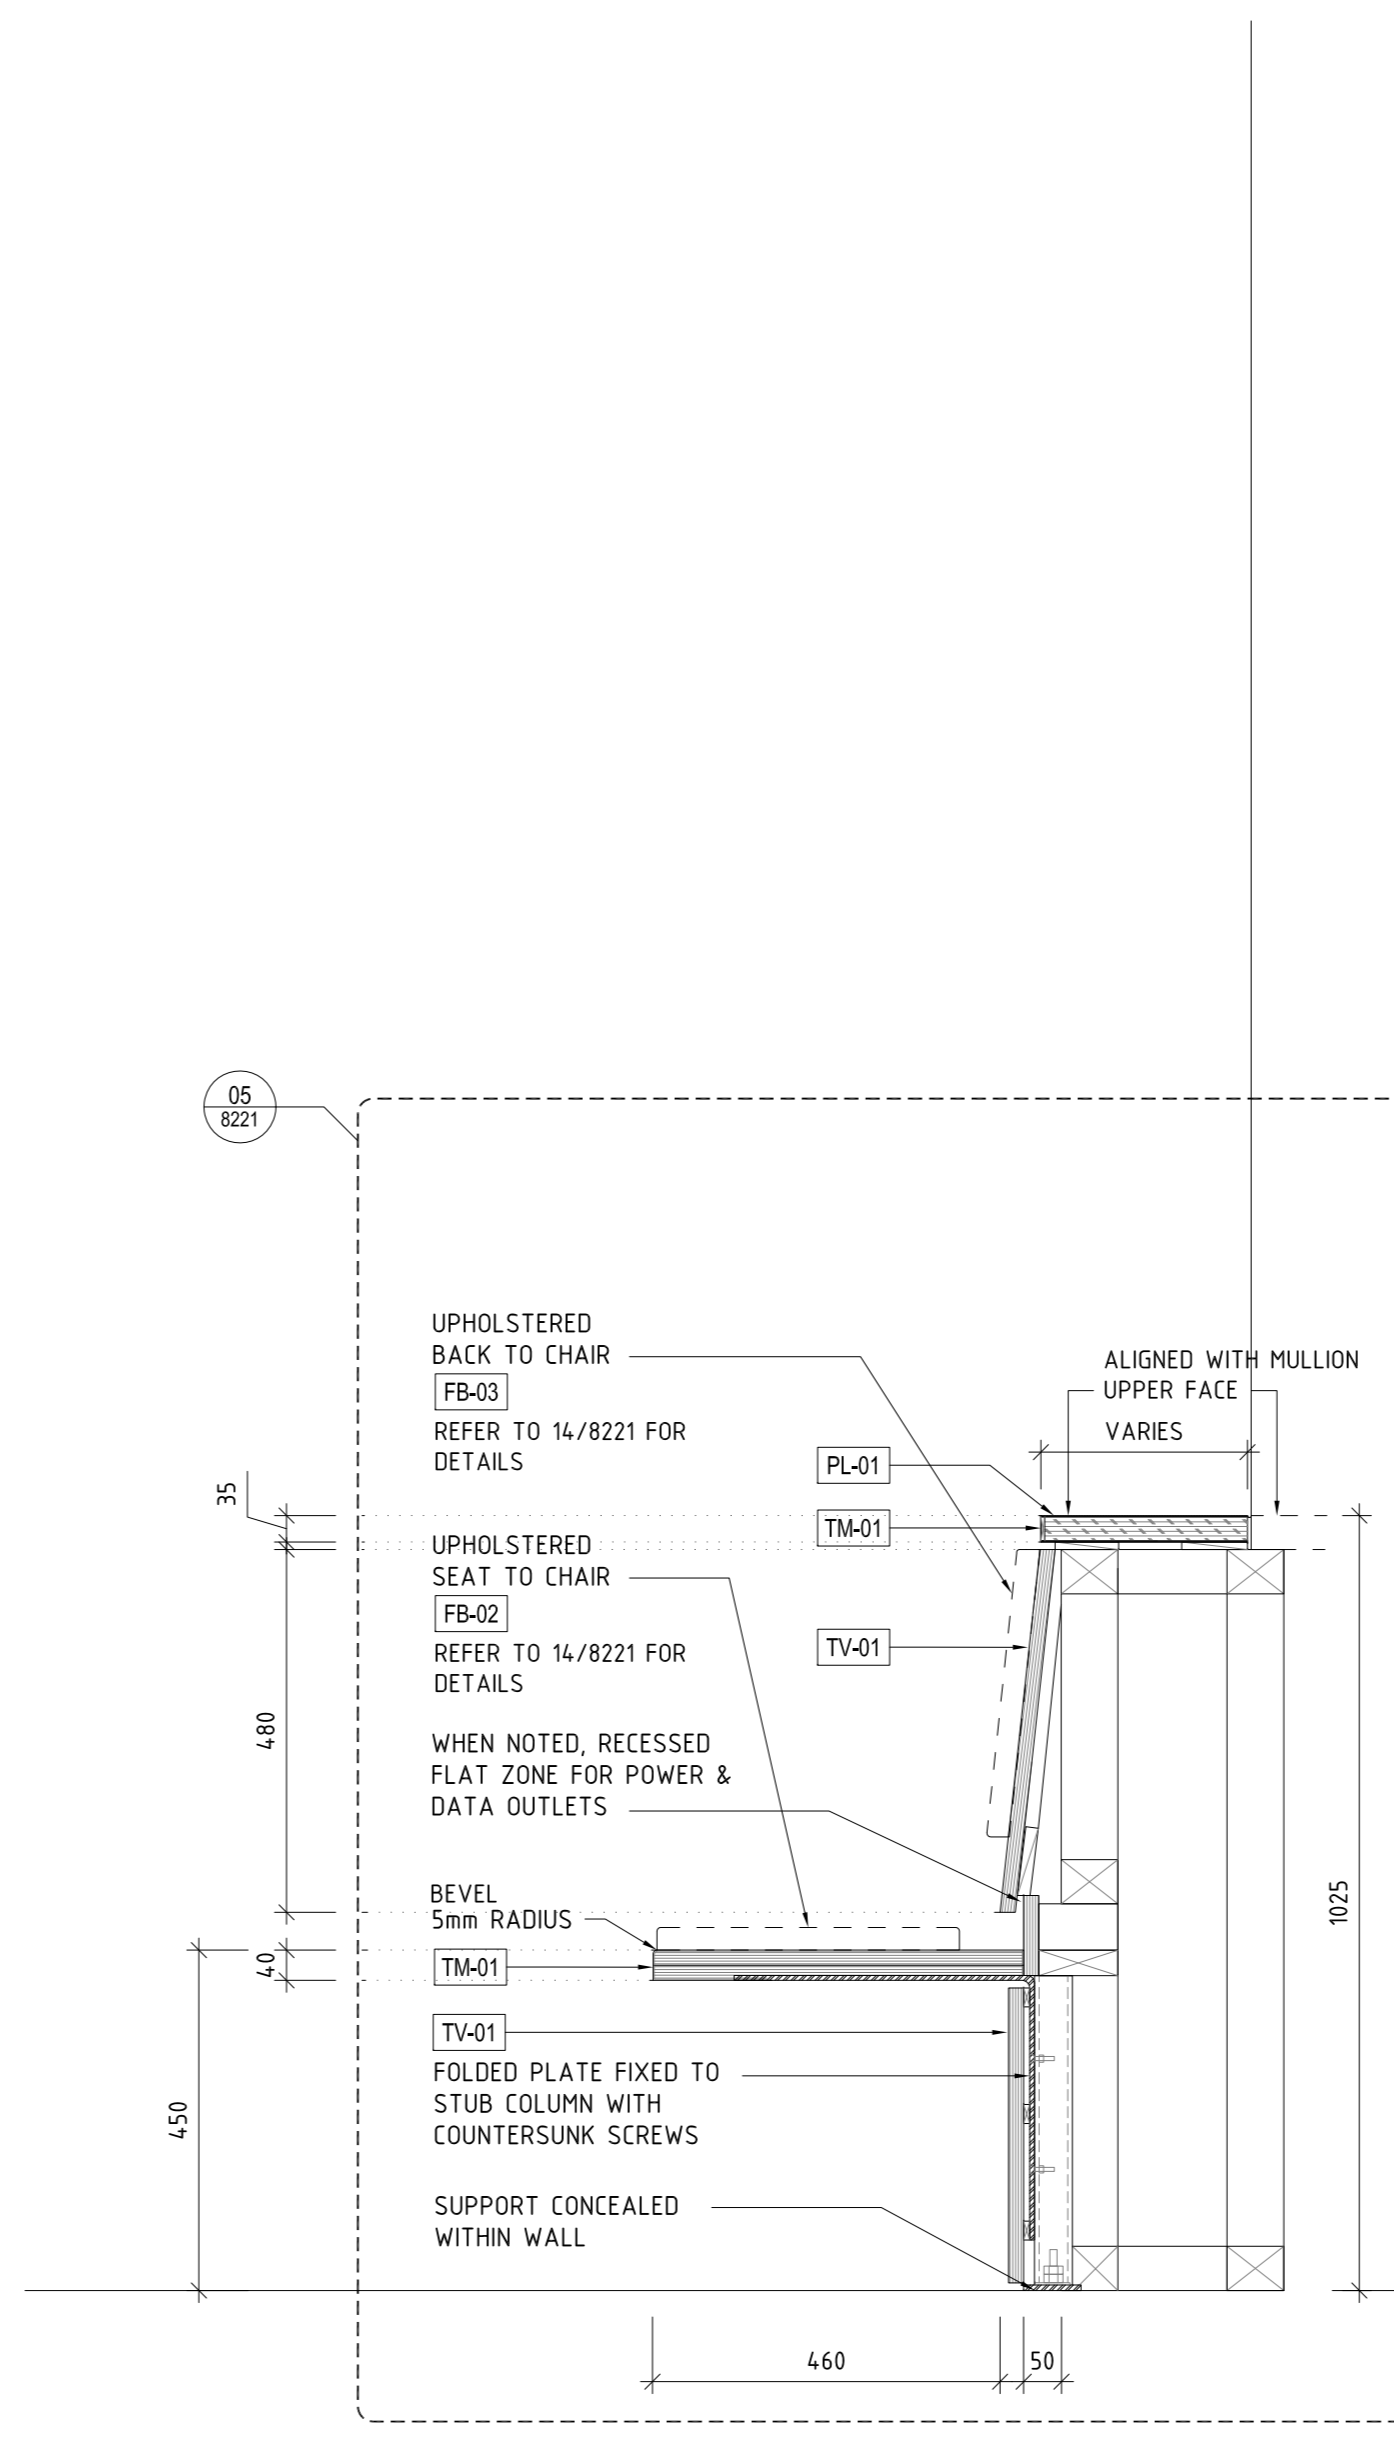


08 INFORMAL SPACE J02-22-SECTION SCALE 1:10

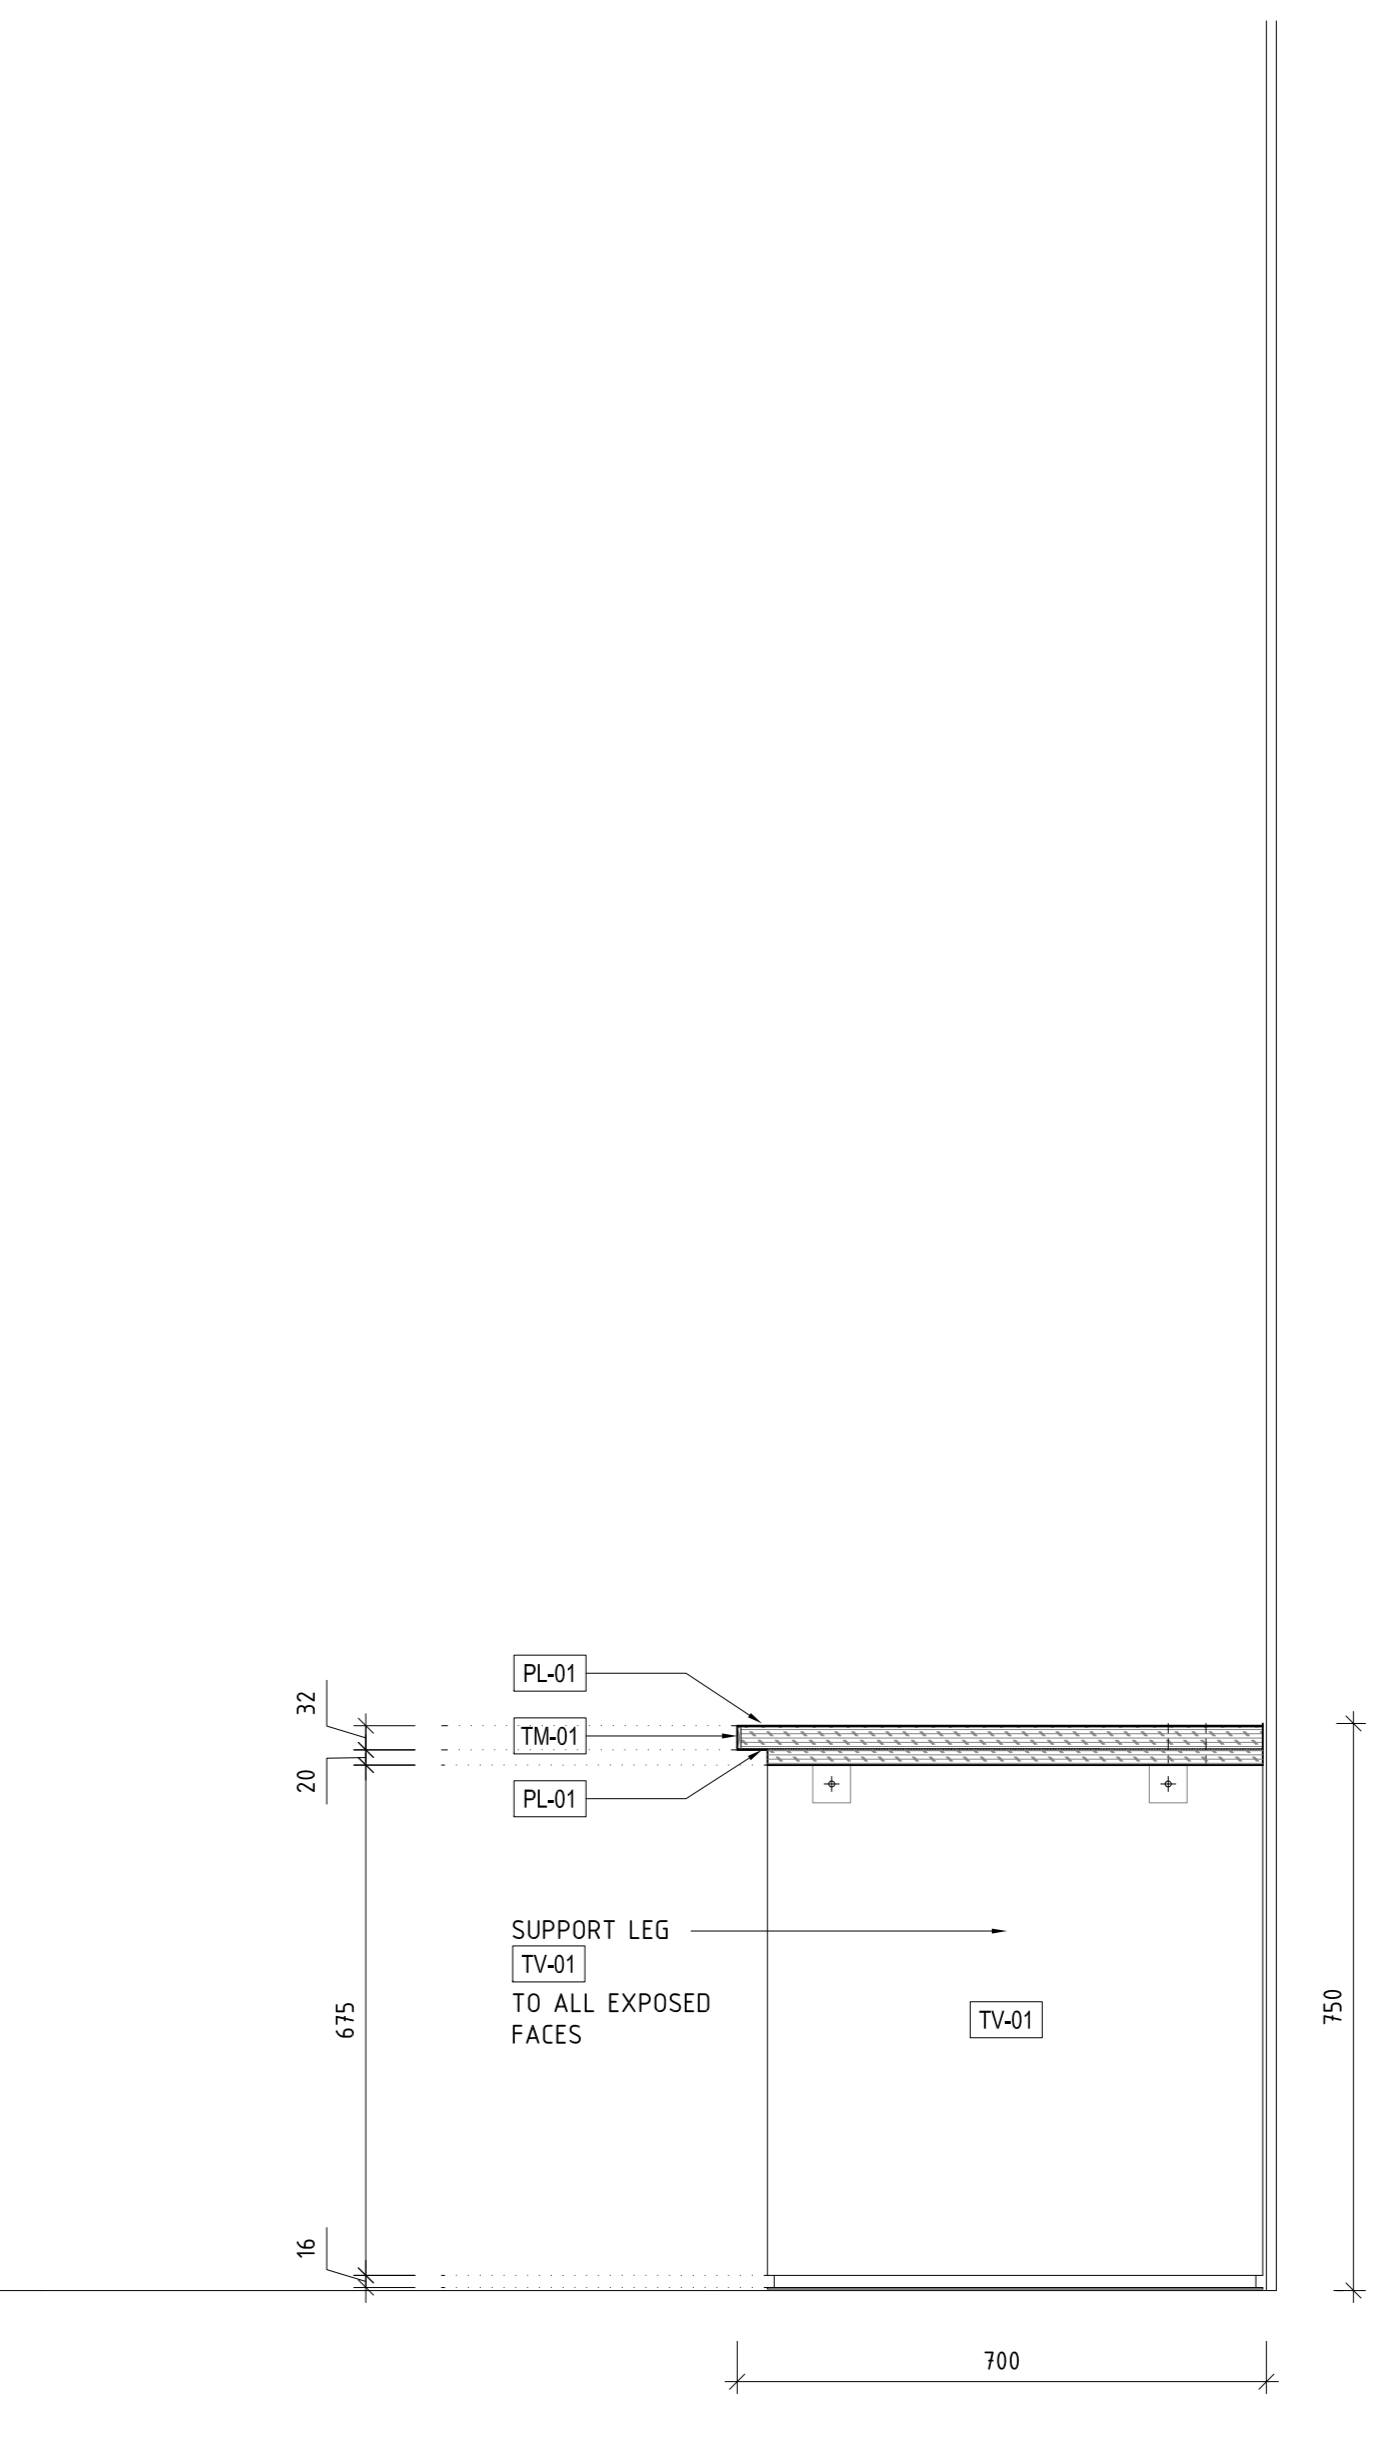


07 J02-36-SECTION SCALE 1:10


J02-21 SIMILAR  
J02-22 SIMILAR  
J04-05 SIMILAR  
J04-13 SIMILAR

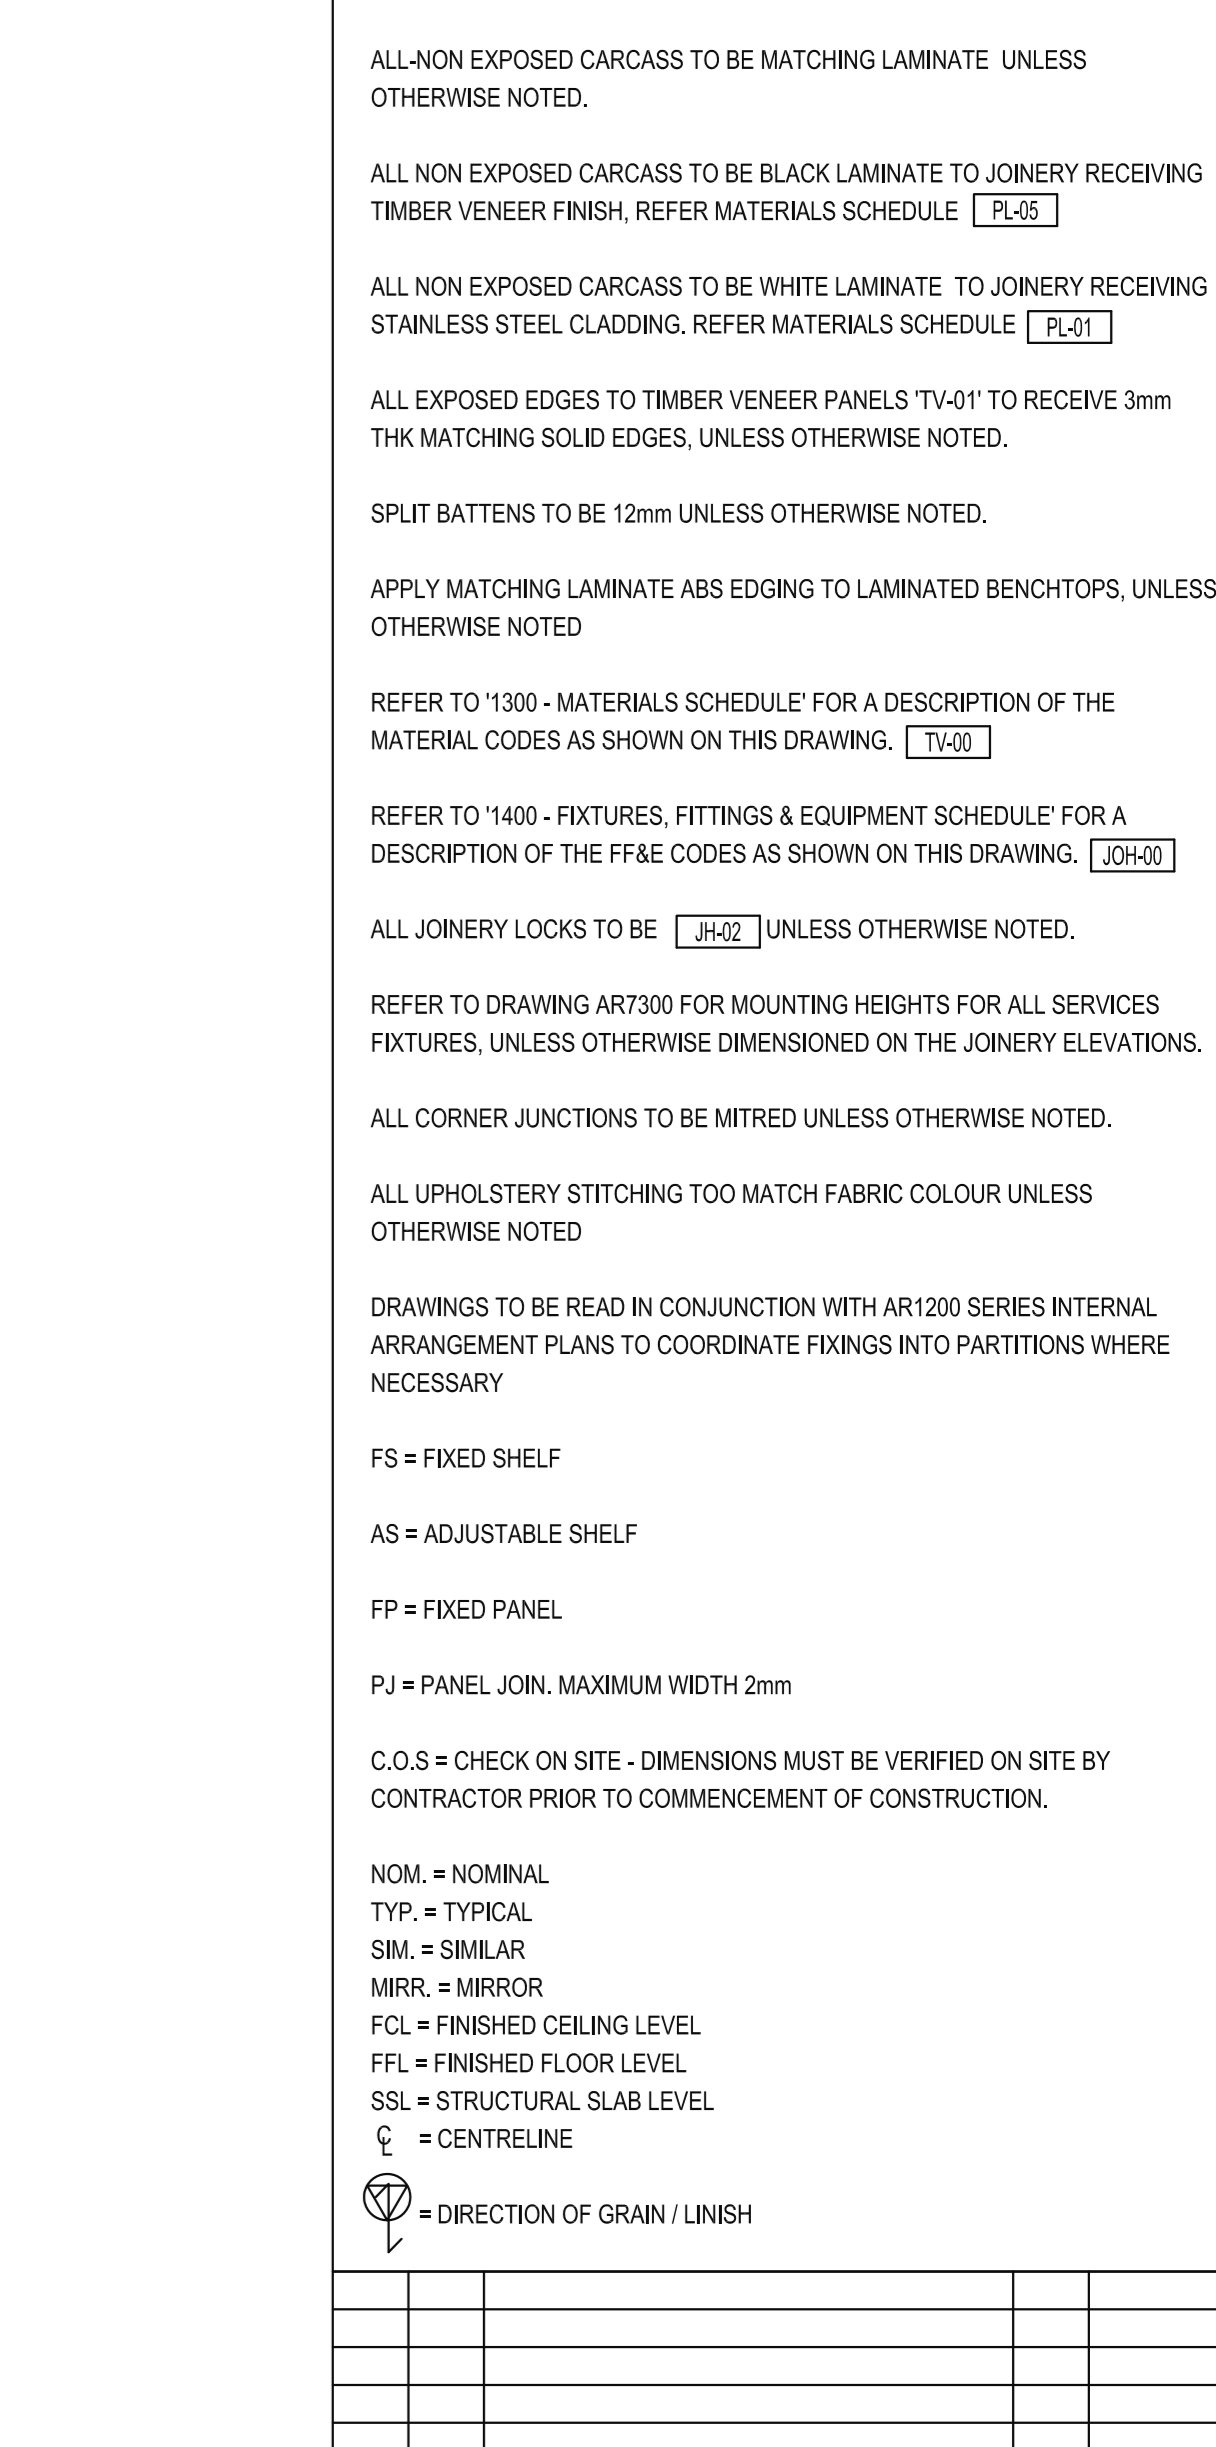

06 INFORMAL SPACE J02-23-SECTION SCALE 1:10

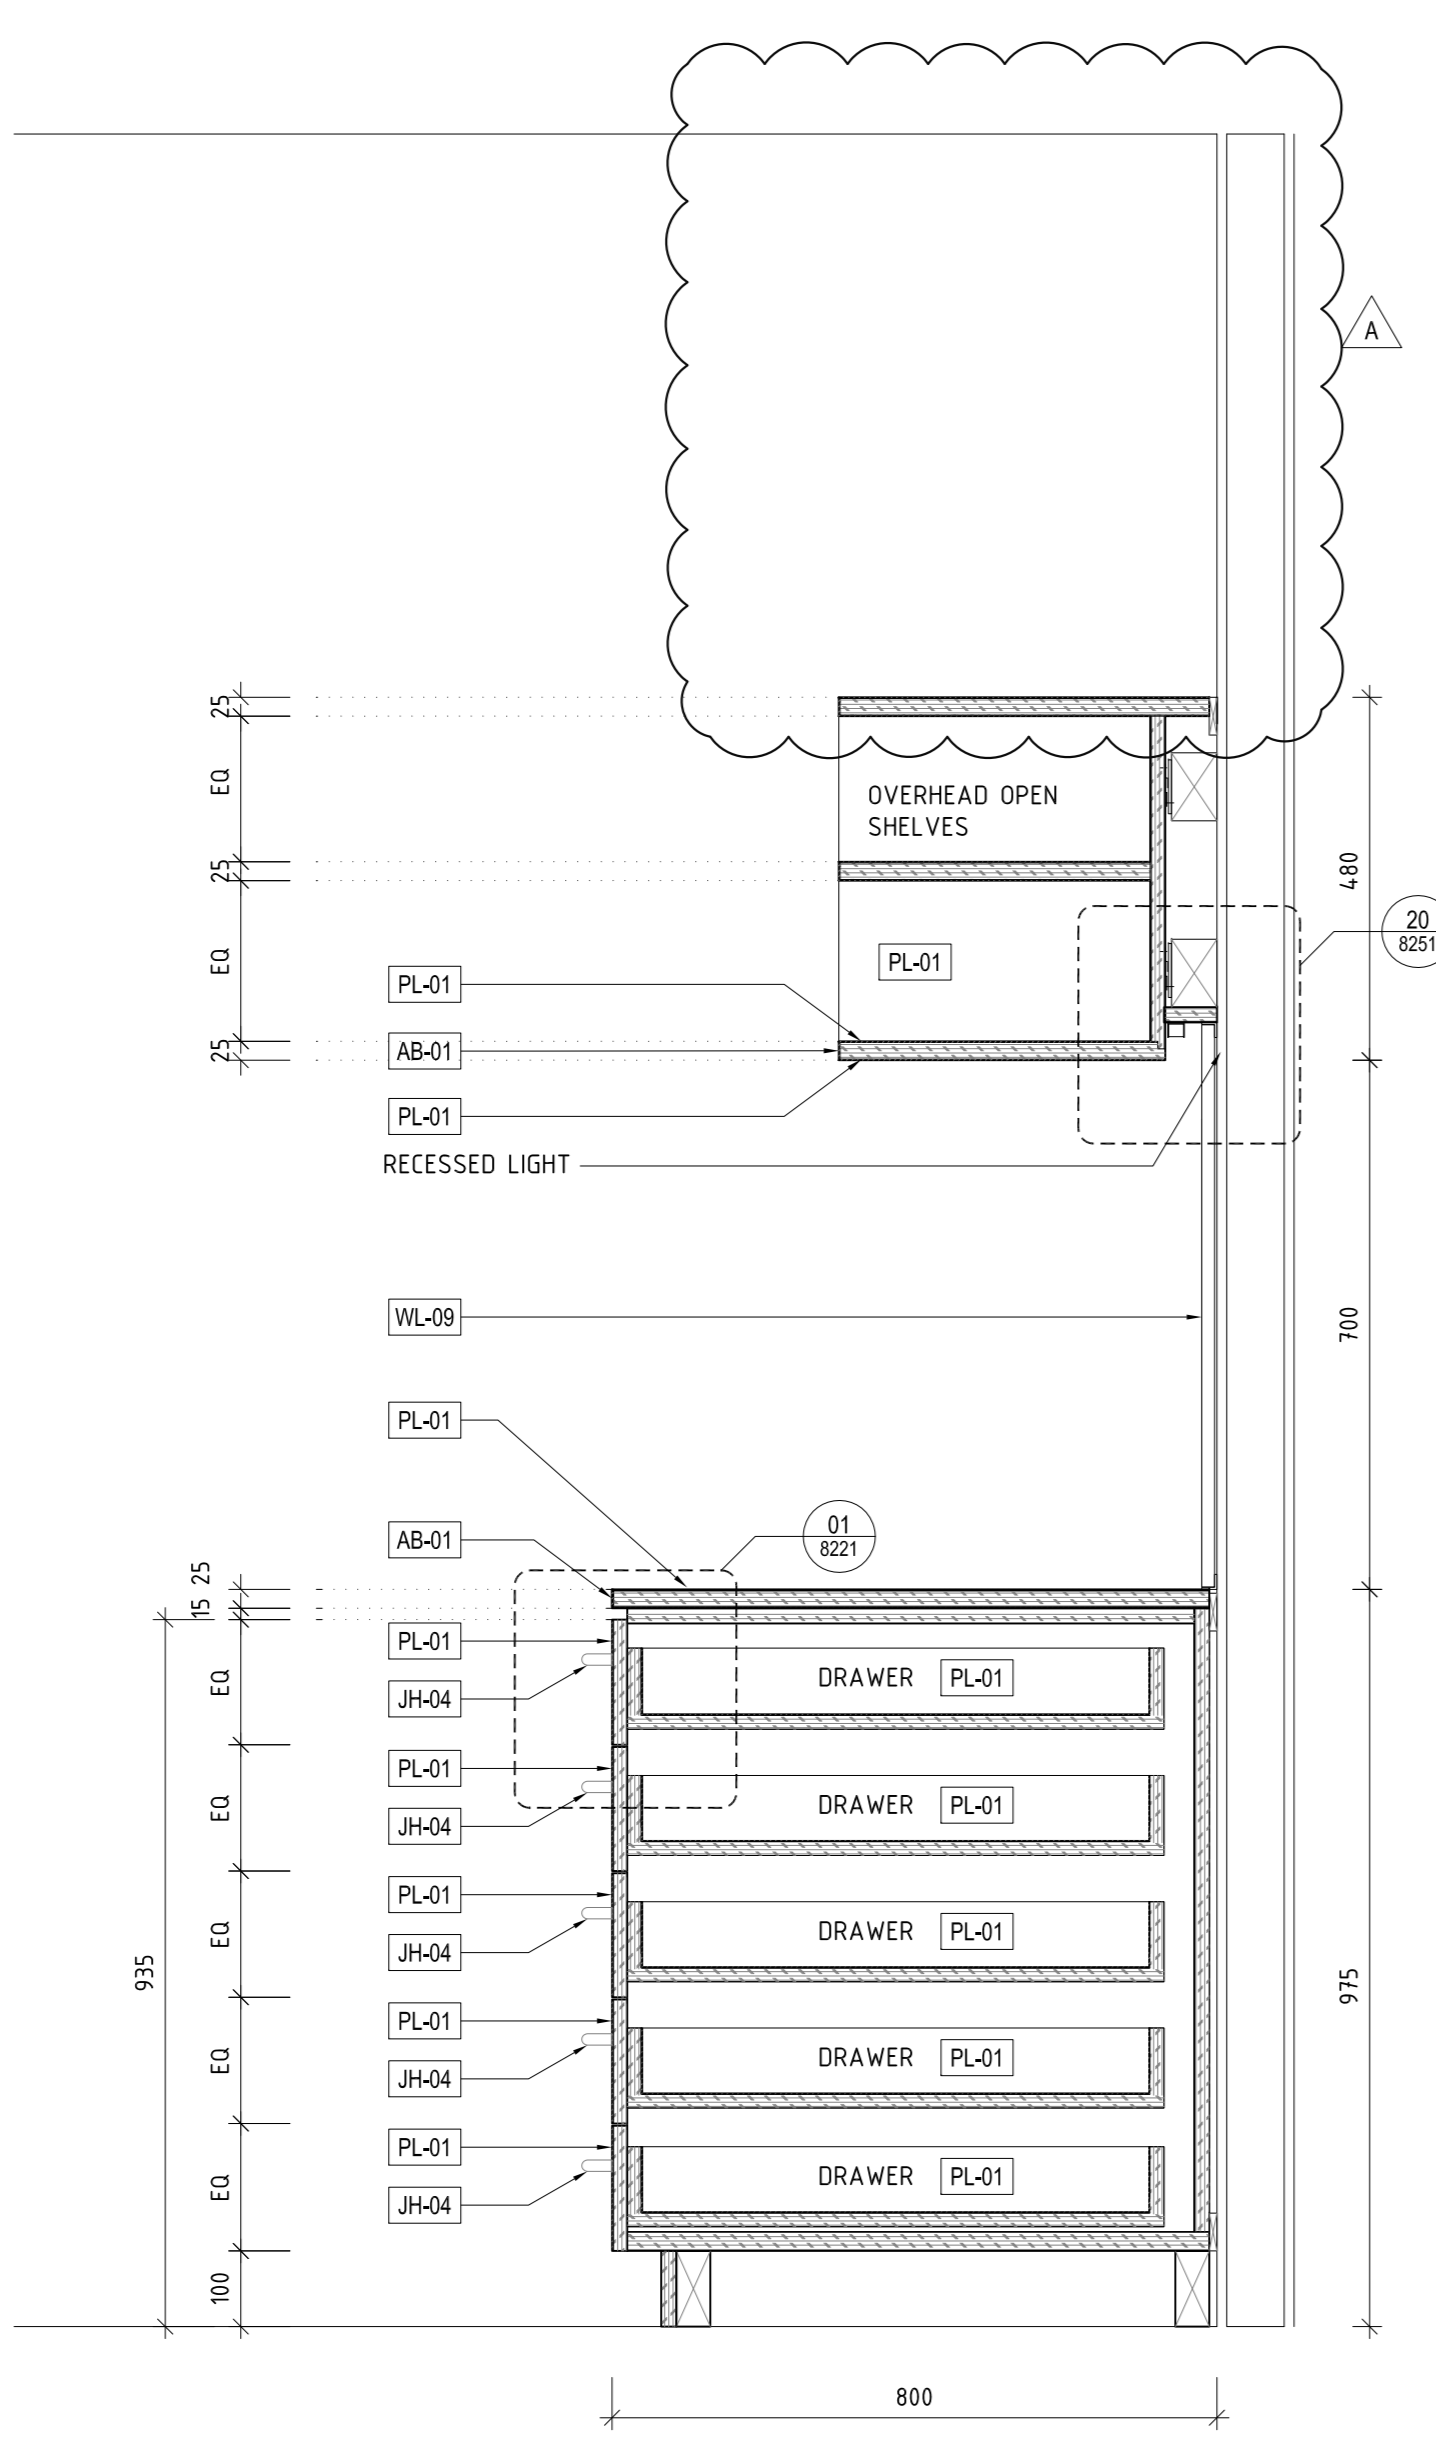


04 IT STORE J02-05-SECTION SCALE 1:10

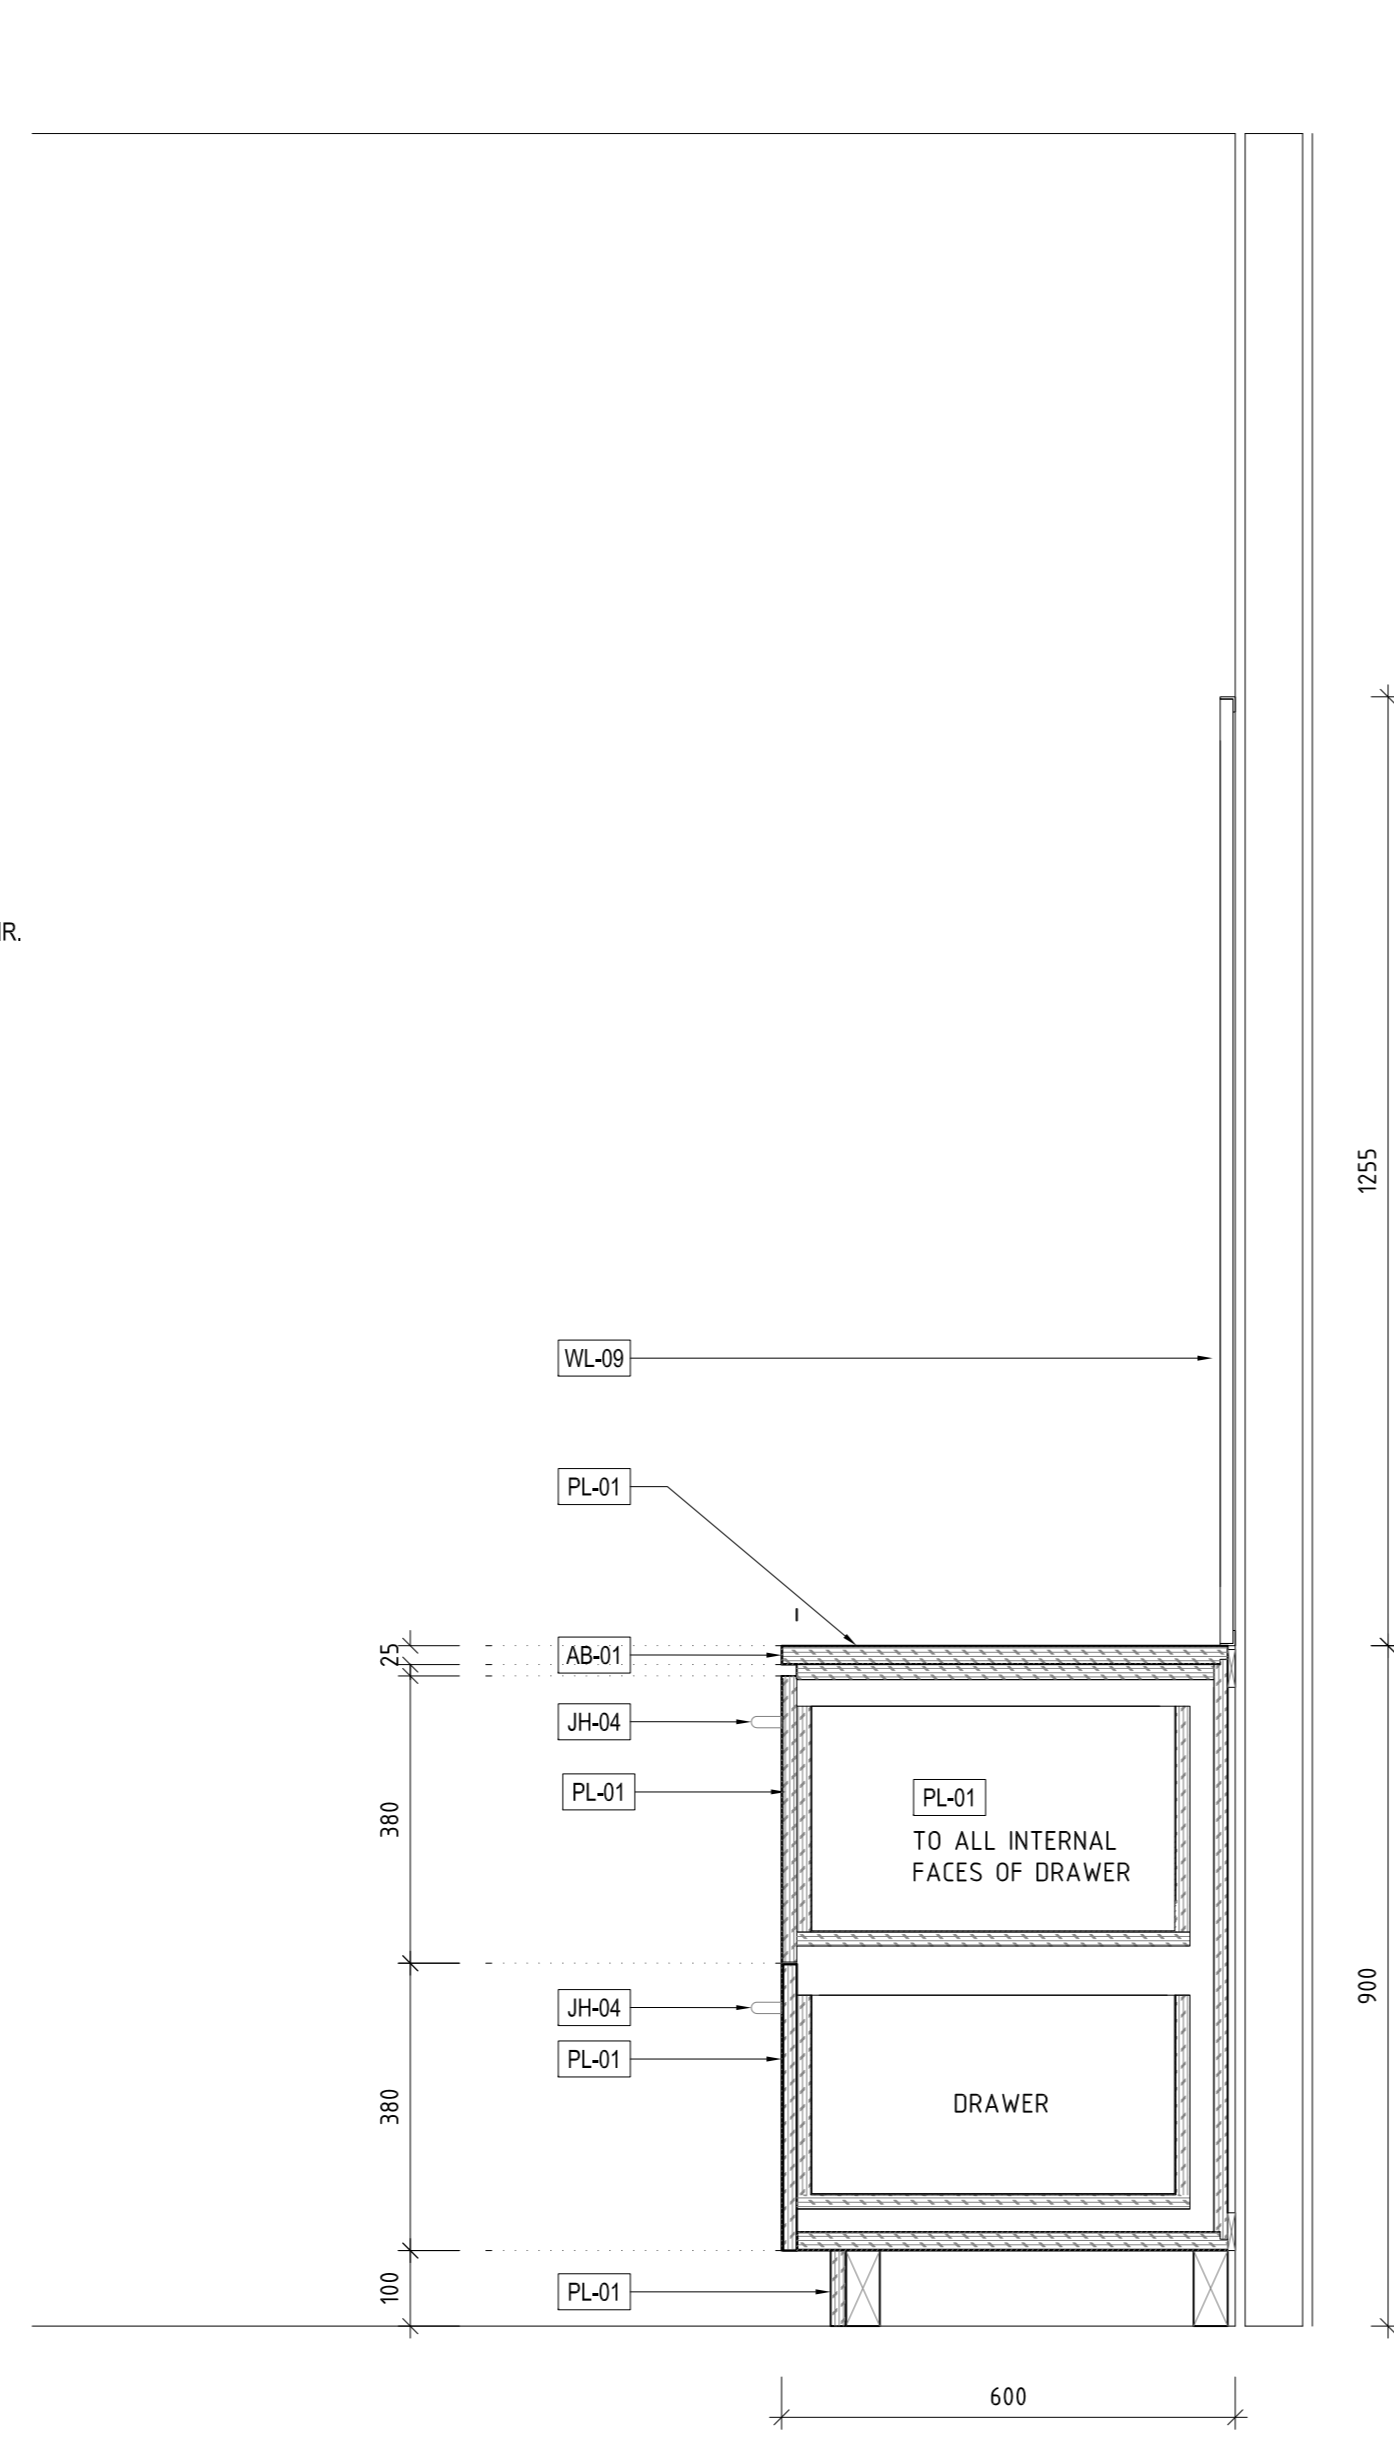


03 IT RECEPTION J02-01-SECTION SCALE 1:10

J02-03 SIMILAR

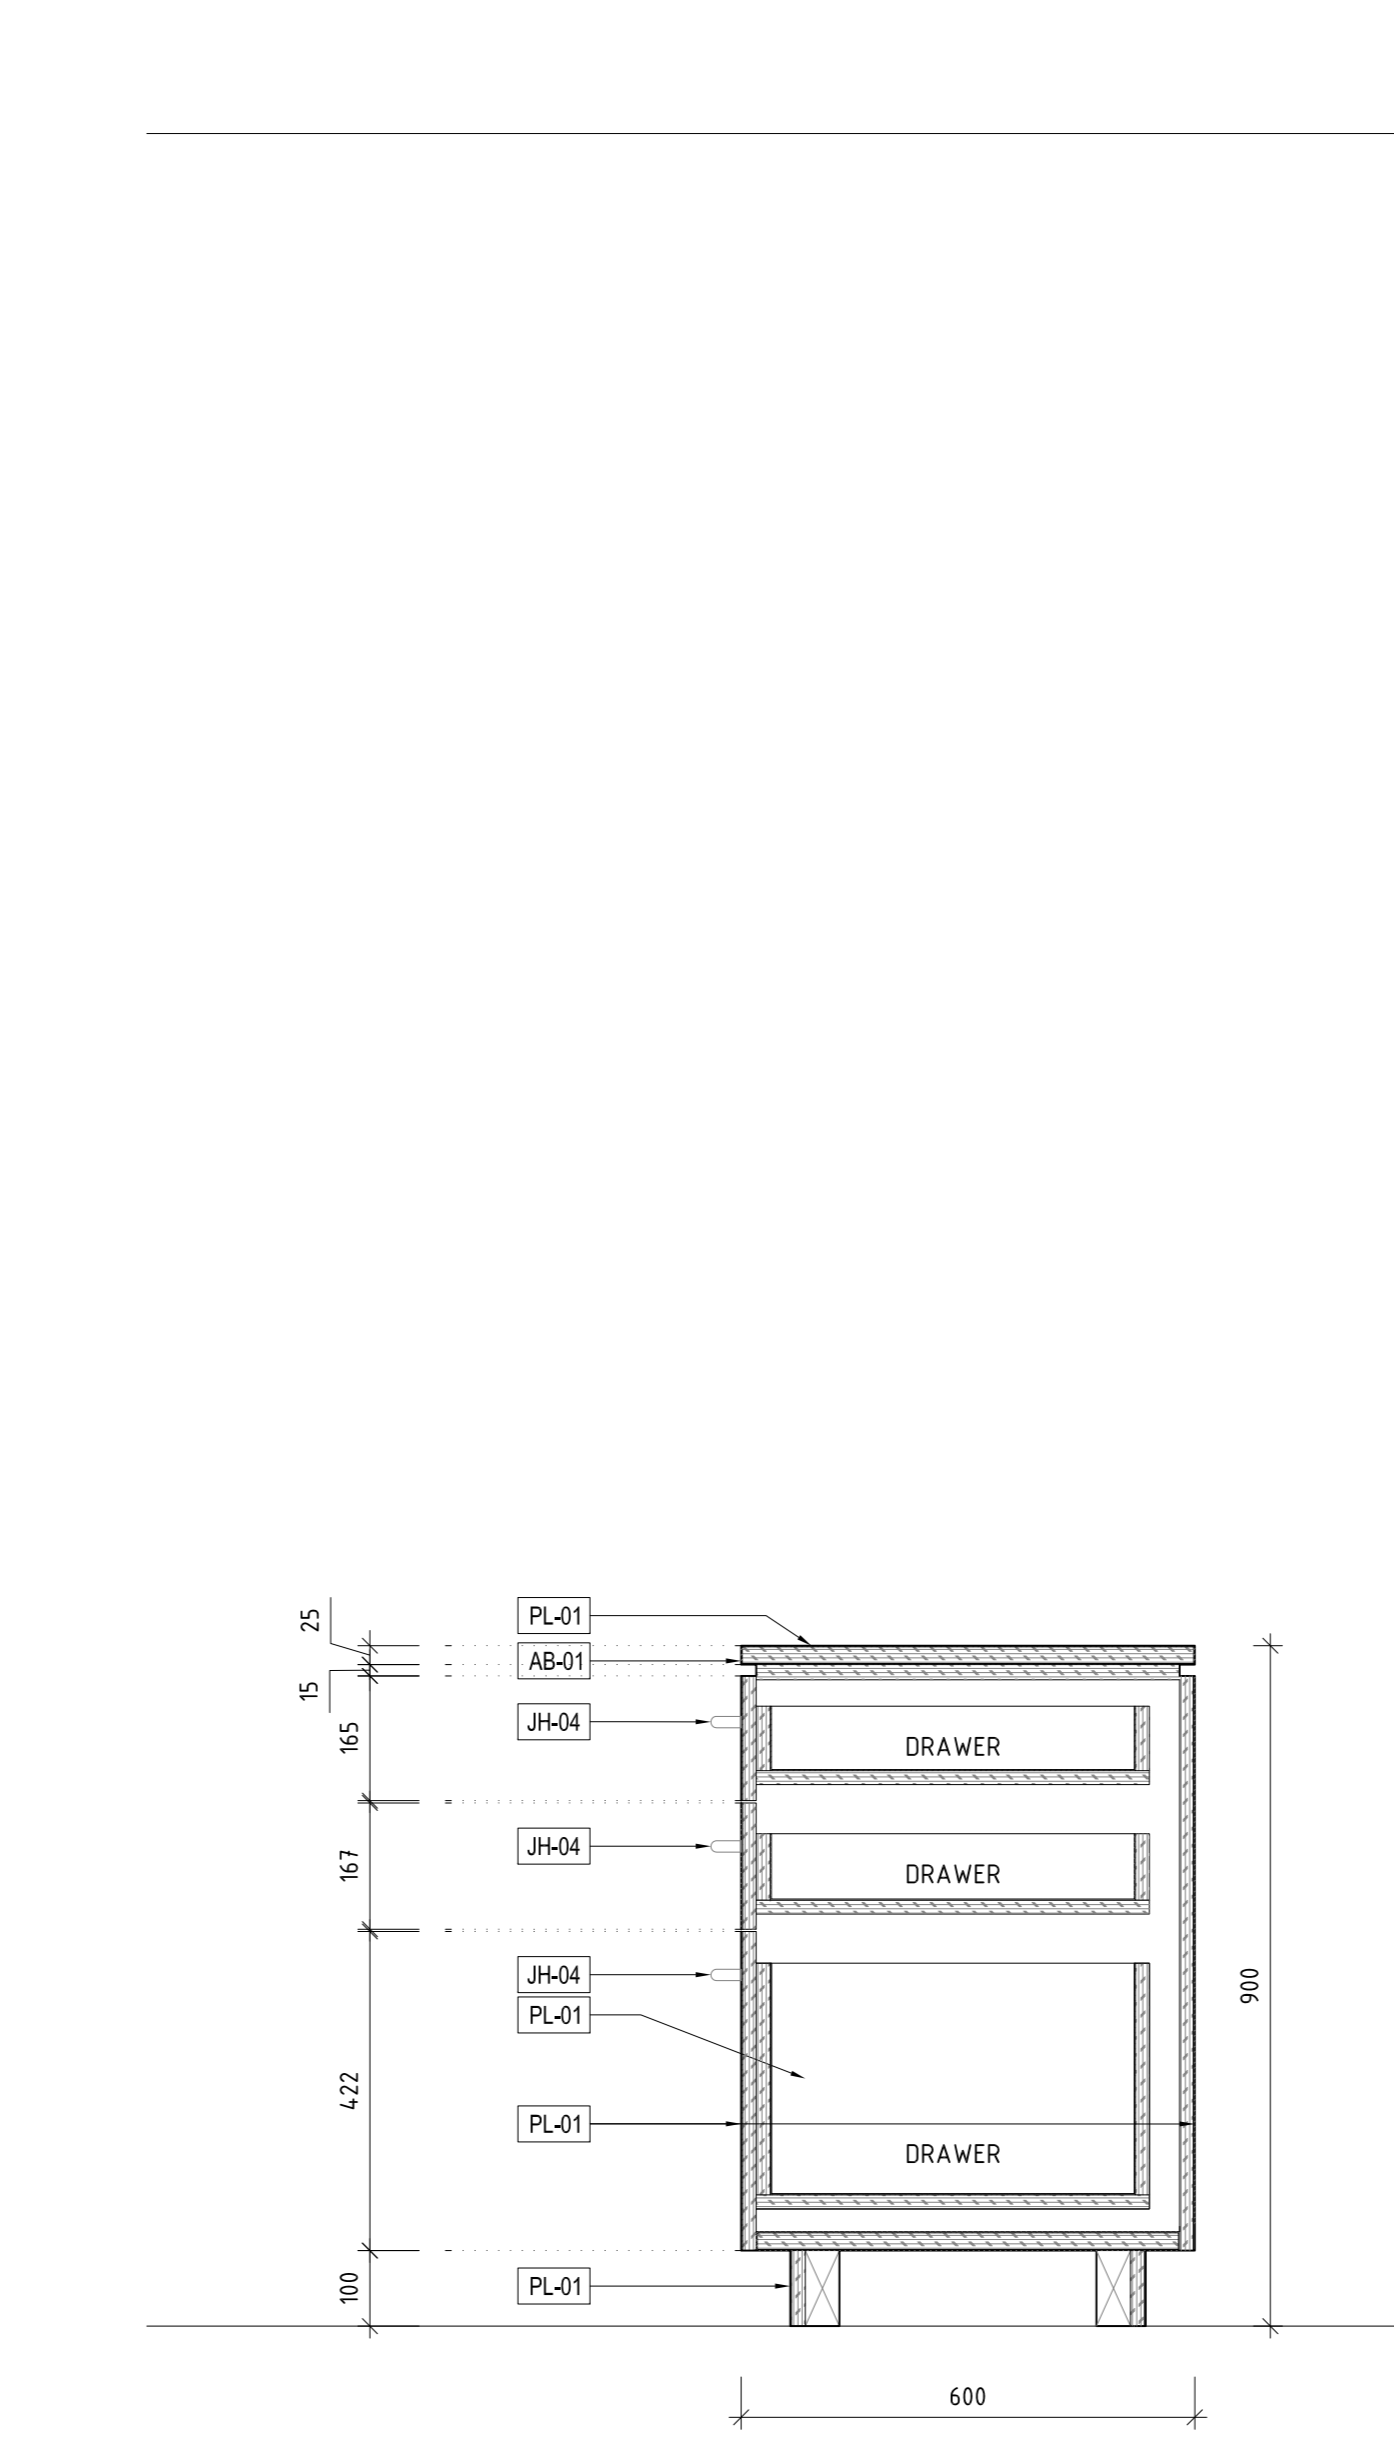


02 IT RECEPTION J02-12-SECTION SCALE 1:10

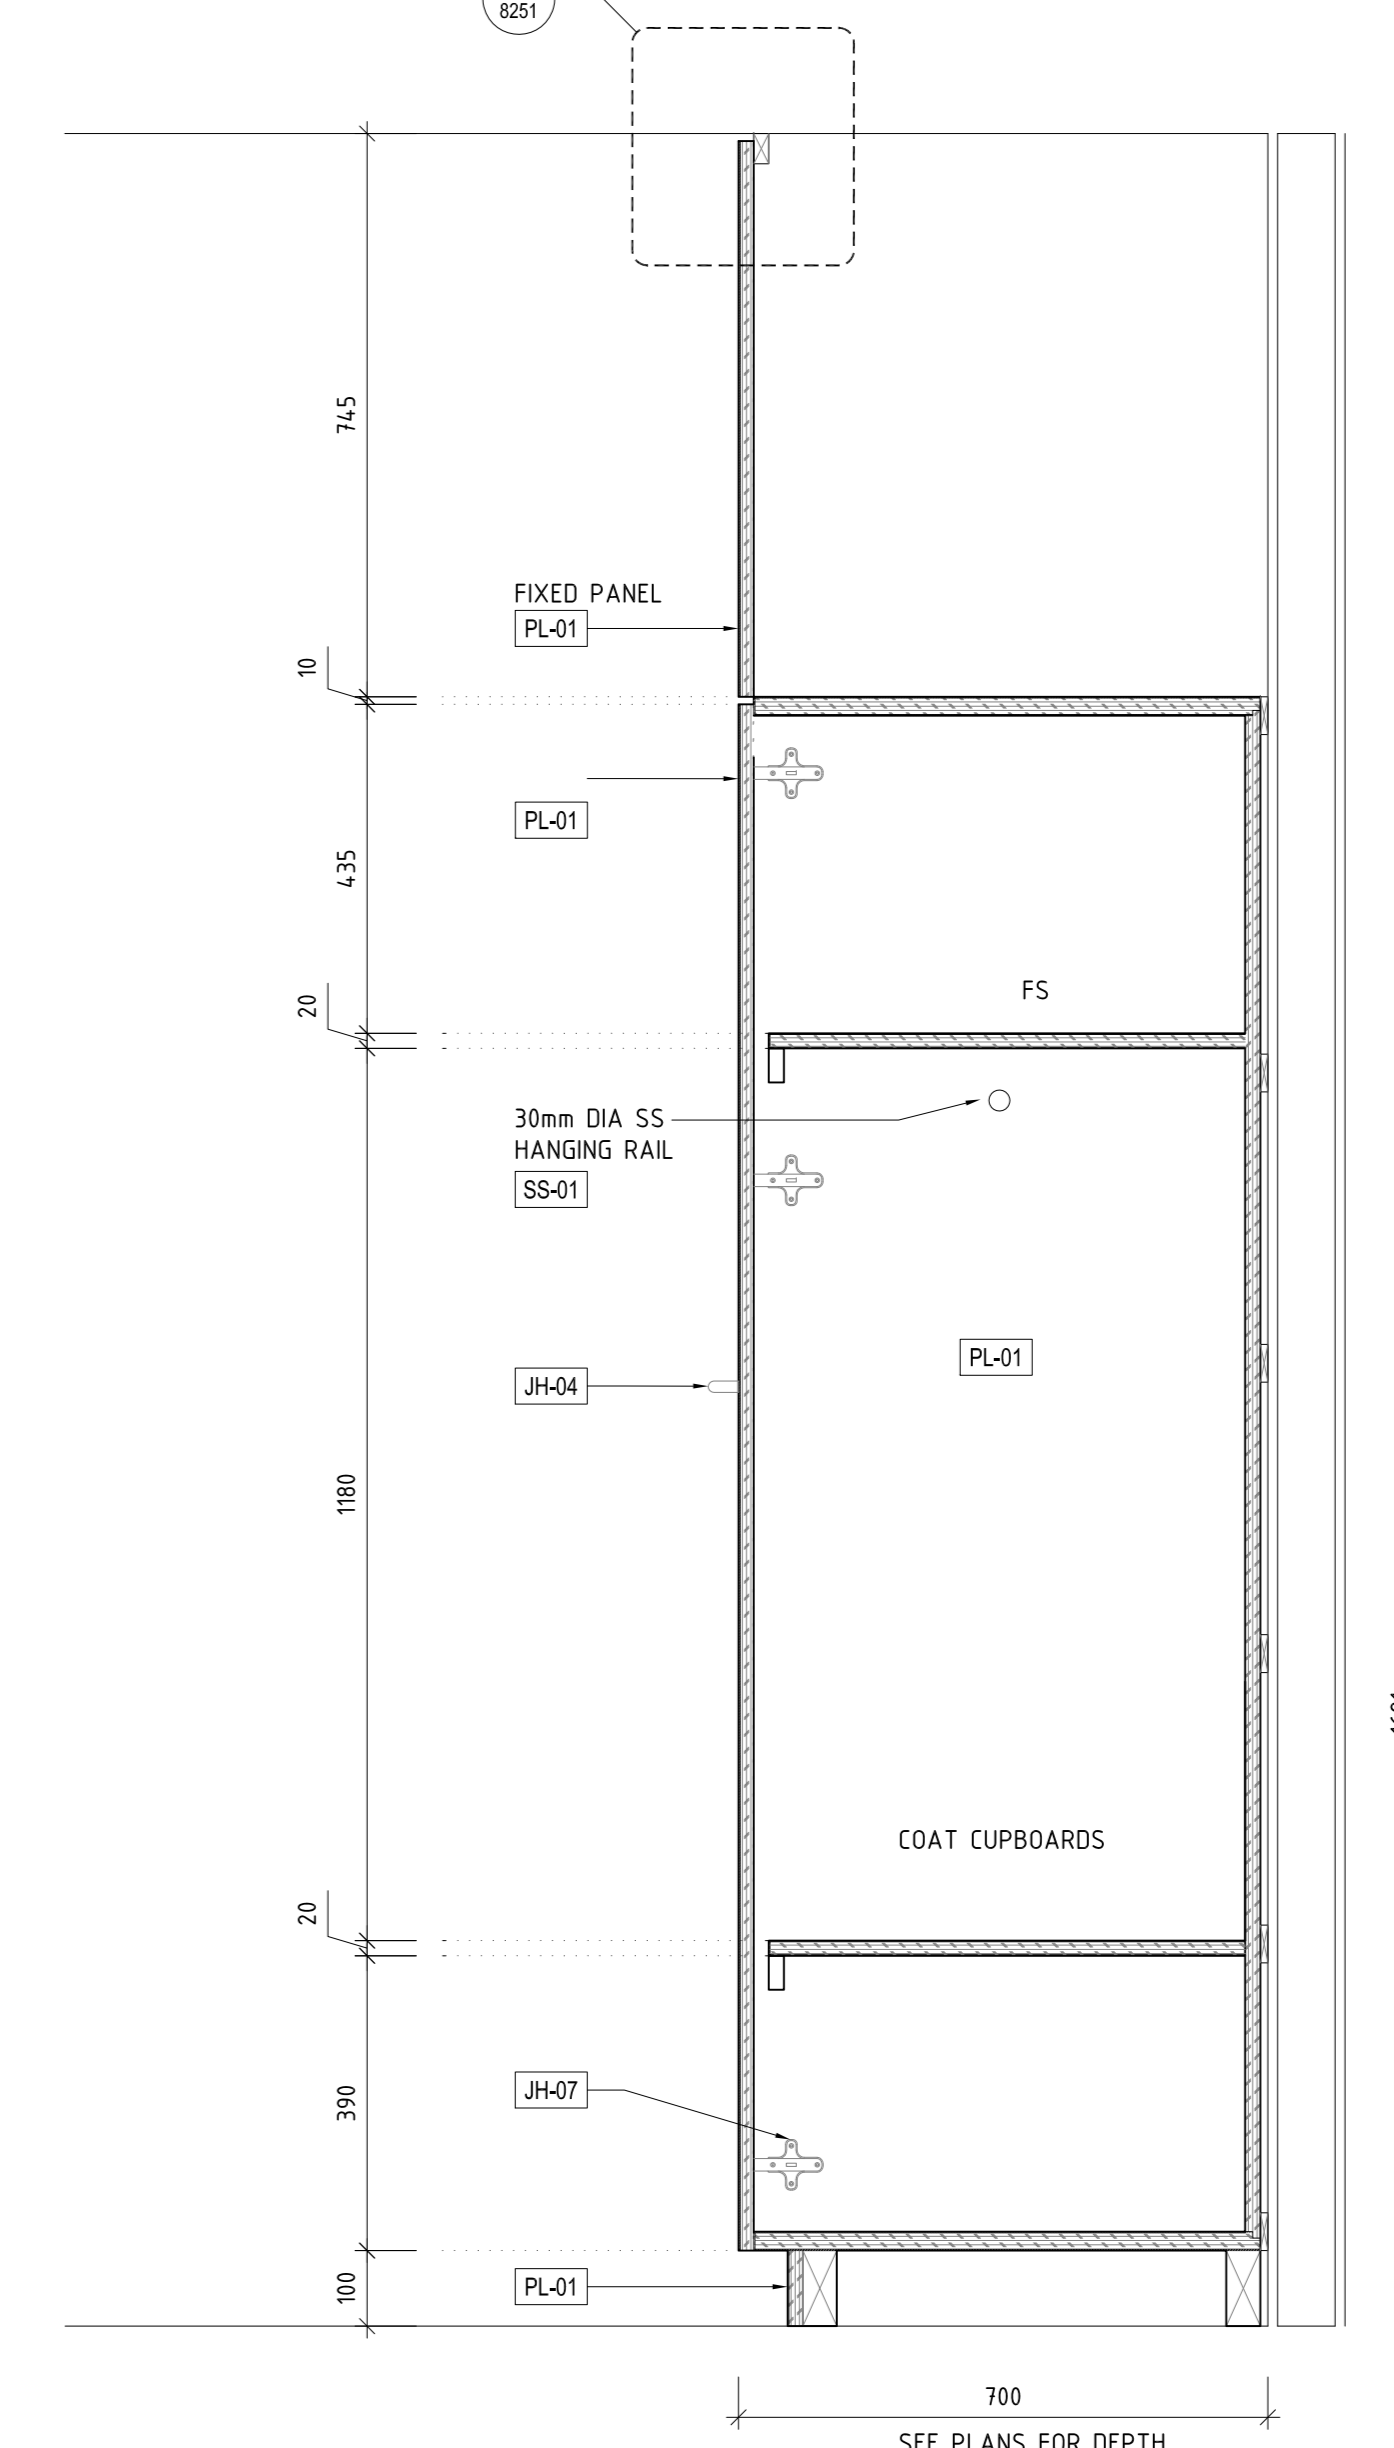

01 WORKSPACE HOTDESK J02-15-SECTION SCALE 1:10

J03-03 SIMILAR

Rev	Issue	Revision Description	Amd	Date
A	SG	CONSTRUCTION ISSUE	-	19.12.13
03	JC	100% CD - TENDER ISSUE	-	07.09.12
02	JC	90% CD ISSUE	-	15.08.12
01	JC	75% CD ISSUE	-	13.07.12

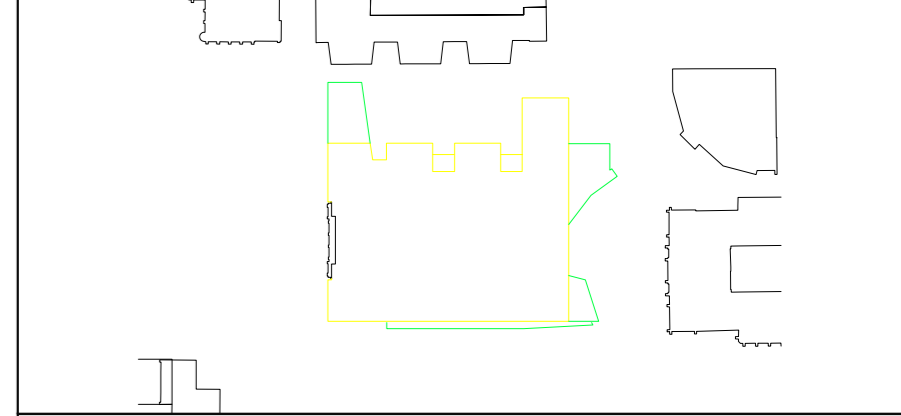

**NADAAA**  
NADAAA  
1900 Washington  
Street No. 2  
Boston  
Massachusetts  
02118 USA  
Telephone  
+1 617 442 6232  
Facsimile  
+1 617 442 1417  
Email  
nad@nadaaa.com

**John Wardle Architects**  
© 2011 John Wardle Architects  
Level 10, 180 Russell Street, Melbourne Victoria 3000 Australia  
Tel : +613 9654 0700 www.johnwardlearchitects.com

Client **University of Melbourne Parkville Campus**

Project **Faculty of Architecture Building and Planning**

Title **JOINERY DETAILS L02**

Project No.	<b>0913</b>	Scale	1:10 @ A0
Drawing No.	<b>AR8202</b>	Revision	<b>A</b>

Date DEC 2013 Dwn - Co-Ord - Chk -

FILENAME - #####

**FOR CONSTRUCTION**