

PL-05

PL-05

TV-01

× TV-01

50

JOINERY SKIRTING WHERE CUPBOARD FRONT 'TV-01'

 $\overline{}$ 

JOINERY SHADOWLINE AT CEILING JUNCTION 21 SECTION DETAIL - SCALE 1:5

DL-01

PF-04


PF-04

FOLDED STEEL BENCH-TOP 15 EDGE DETAIL SCALE 1:5

ᠯ᠊ᡆ᠍᠍ᠯ

27 EDGE DETAIL - SCALE 1:5

TV-01

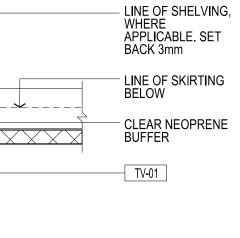

–3mm SOLID TIMBER

EDGE TO MATCH

(UNLESS OTHERWISE NOTED)

FCL

-PAINT OUT SHADOWLINE TO MATCH CEILING COLOUR

FINISHES AS NOMINATED ON JOINERY DETAIL DRAWINGS

ALLOW FOR 20mm W x 1mm H REBATE TO PLY SUBSTRATE TO ALL PERIMETER EDGES

-2mm THICK STEEL STIFFENER. SET-BACK 30mm FROM FRONT EDGE OF

DIRECT STICK DL-01 TO 4mm THICK PLYWOOD SUNSTRATE, DIRECT STICK

TO STEEL BENCH-TOP

– 4mm THICK STEEL PLATE

-2mm THICK STEEL PLATE

— ADHERE STEEL PLATE VIA STRUCTURAL DOUBLE-SIDED TAPE

-4mm THICK STEEL PLATE

BENCHTOP

----FINISH FACE TO JOINERY

