

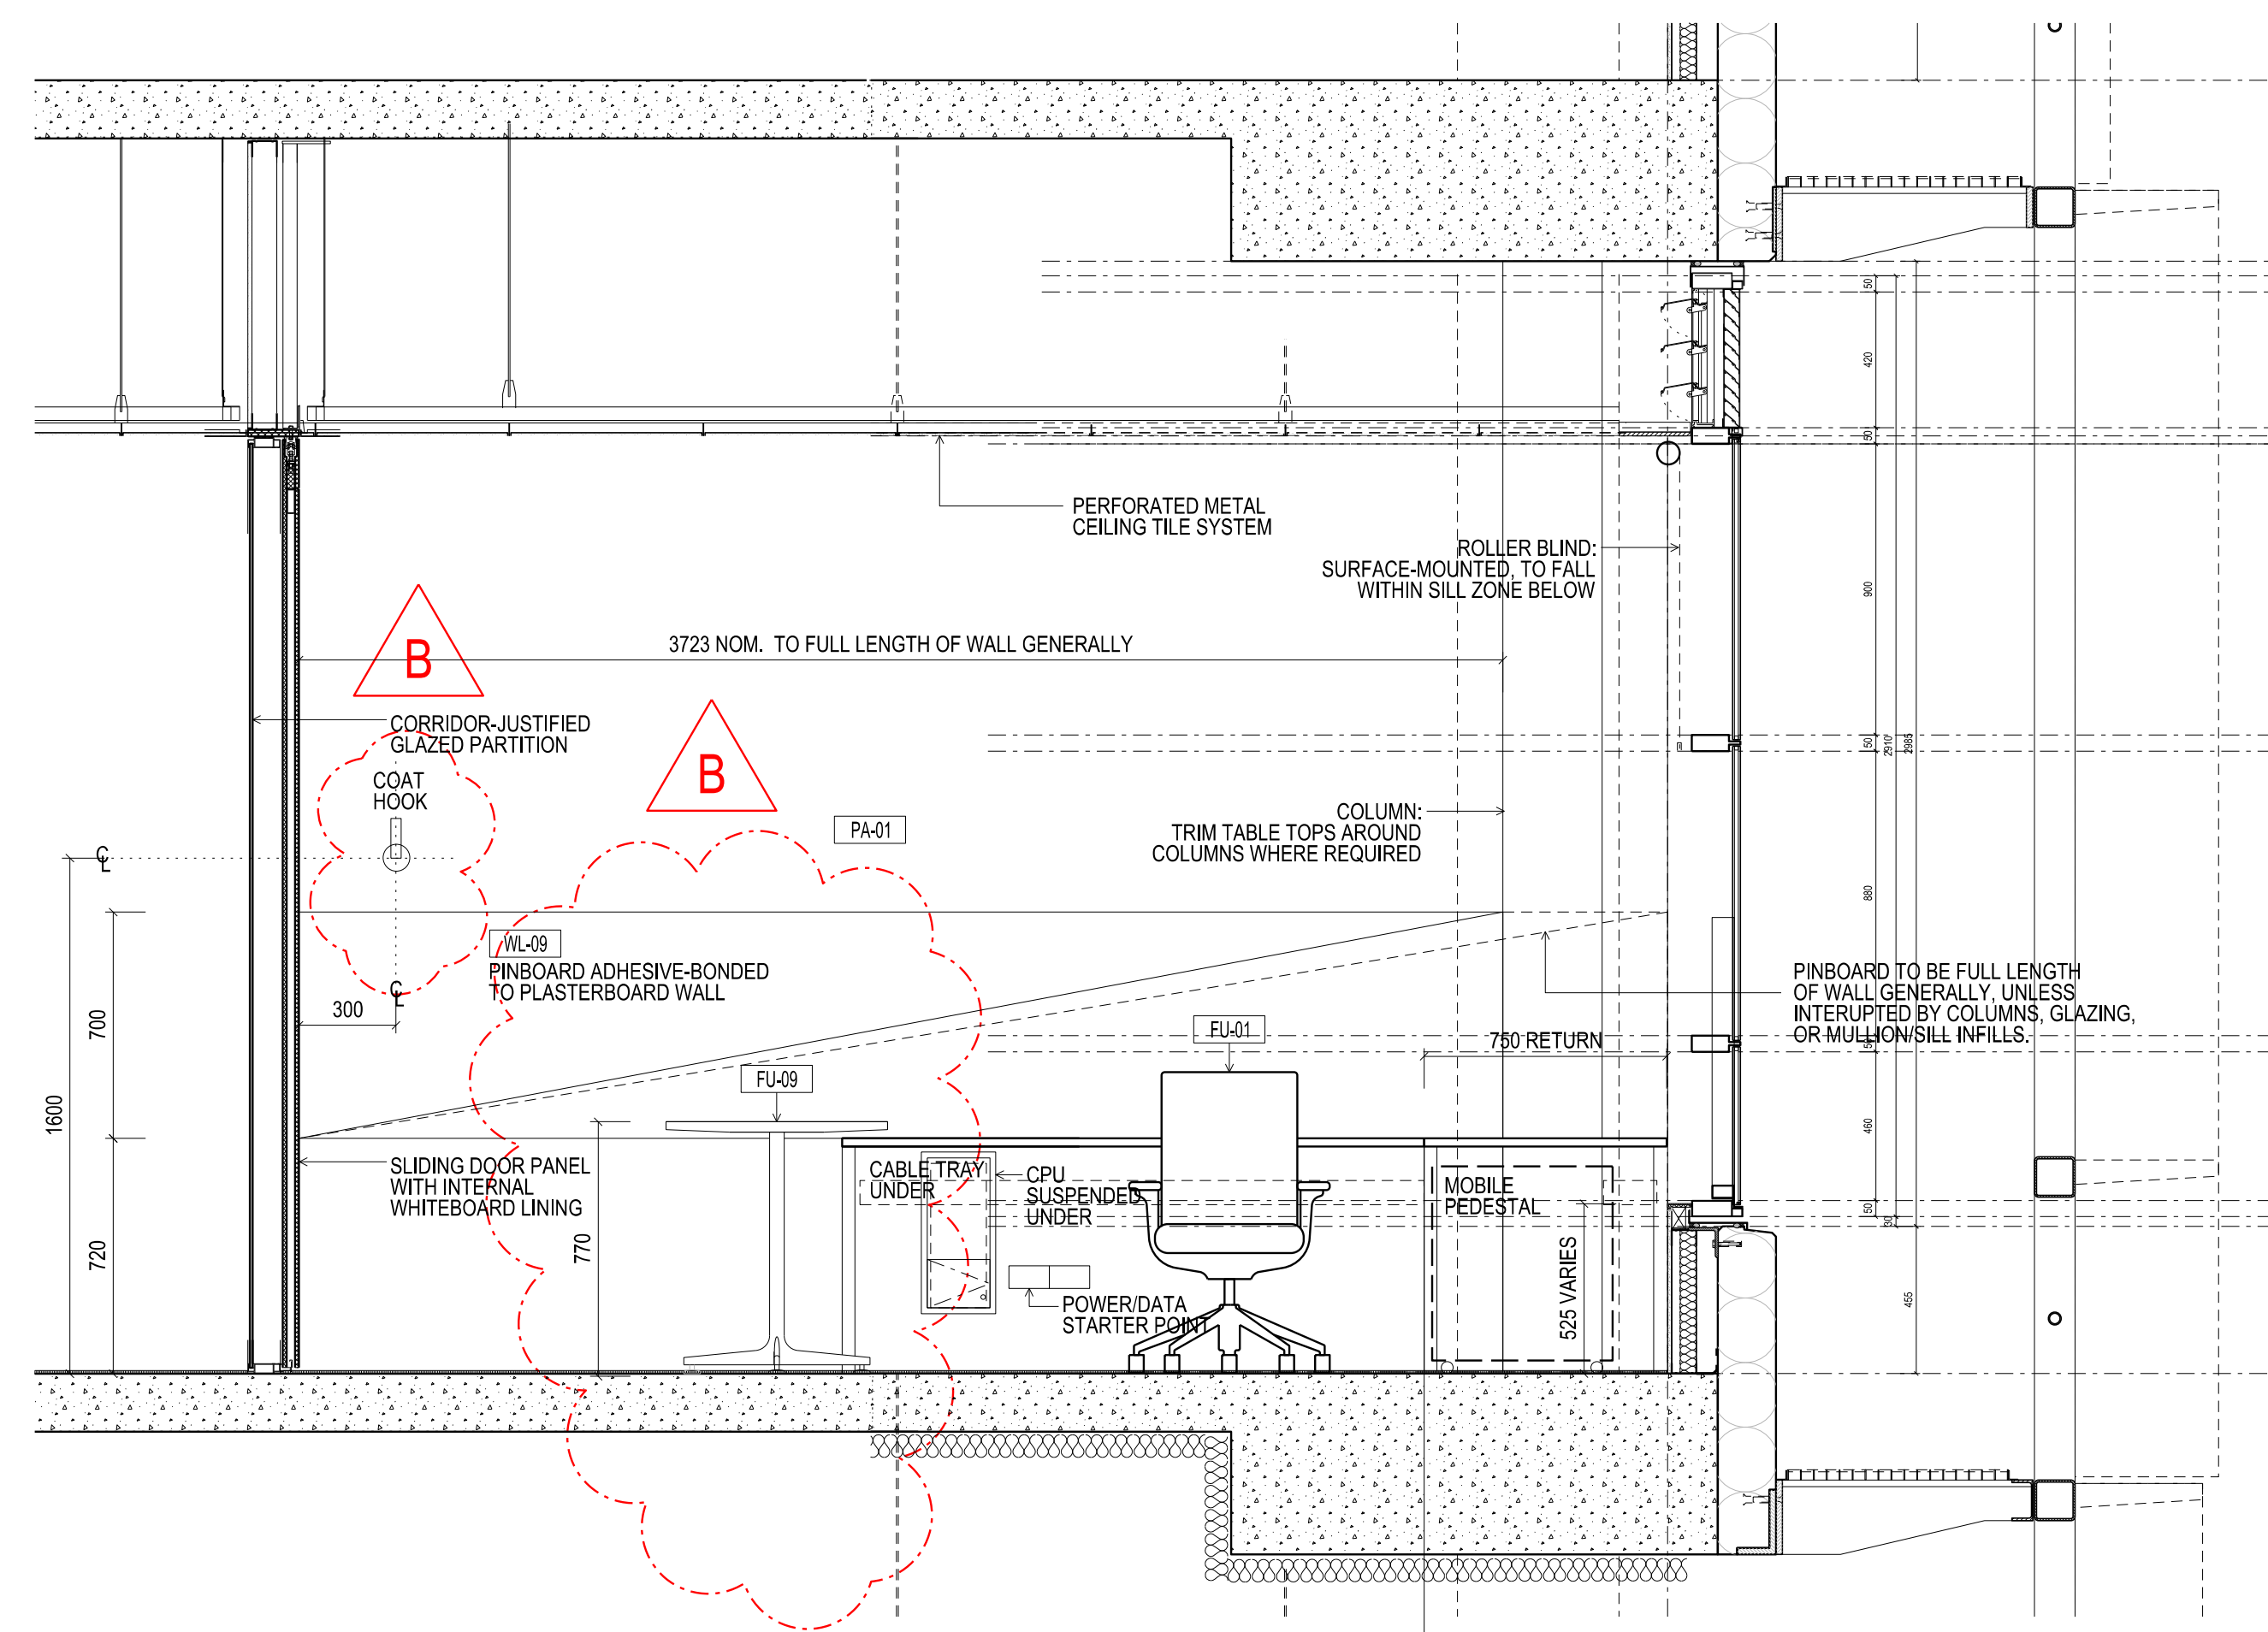
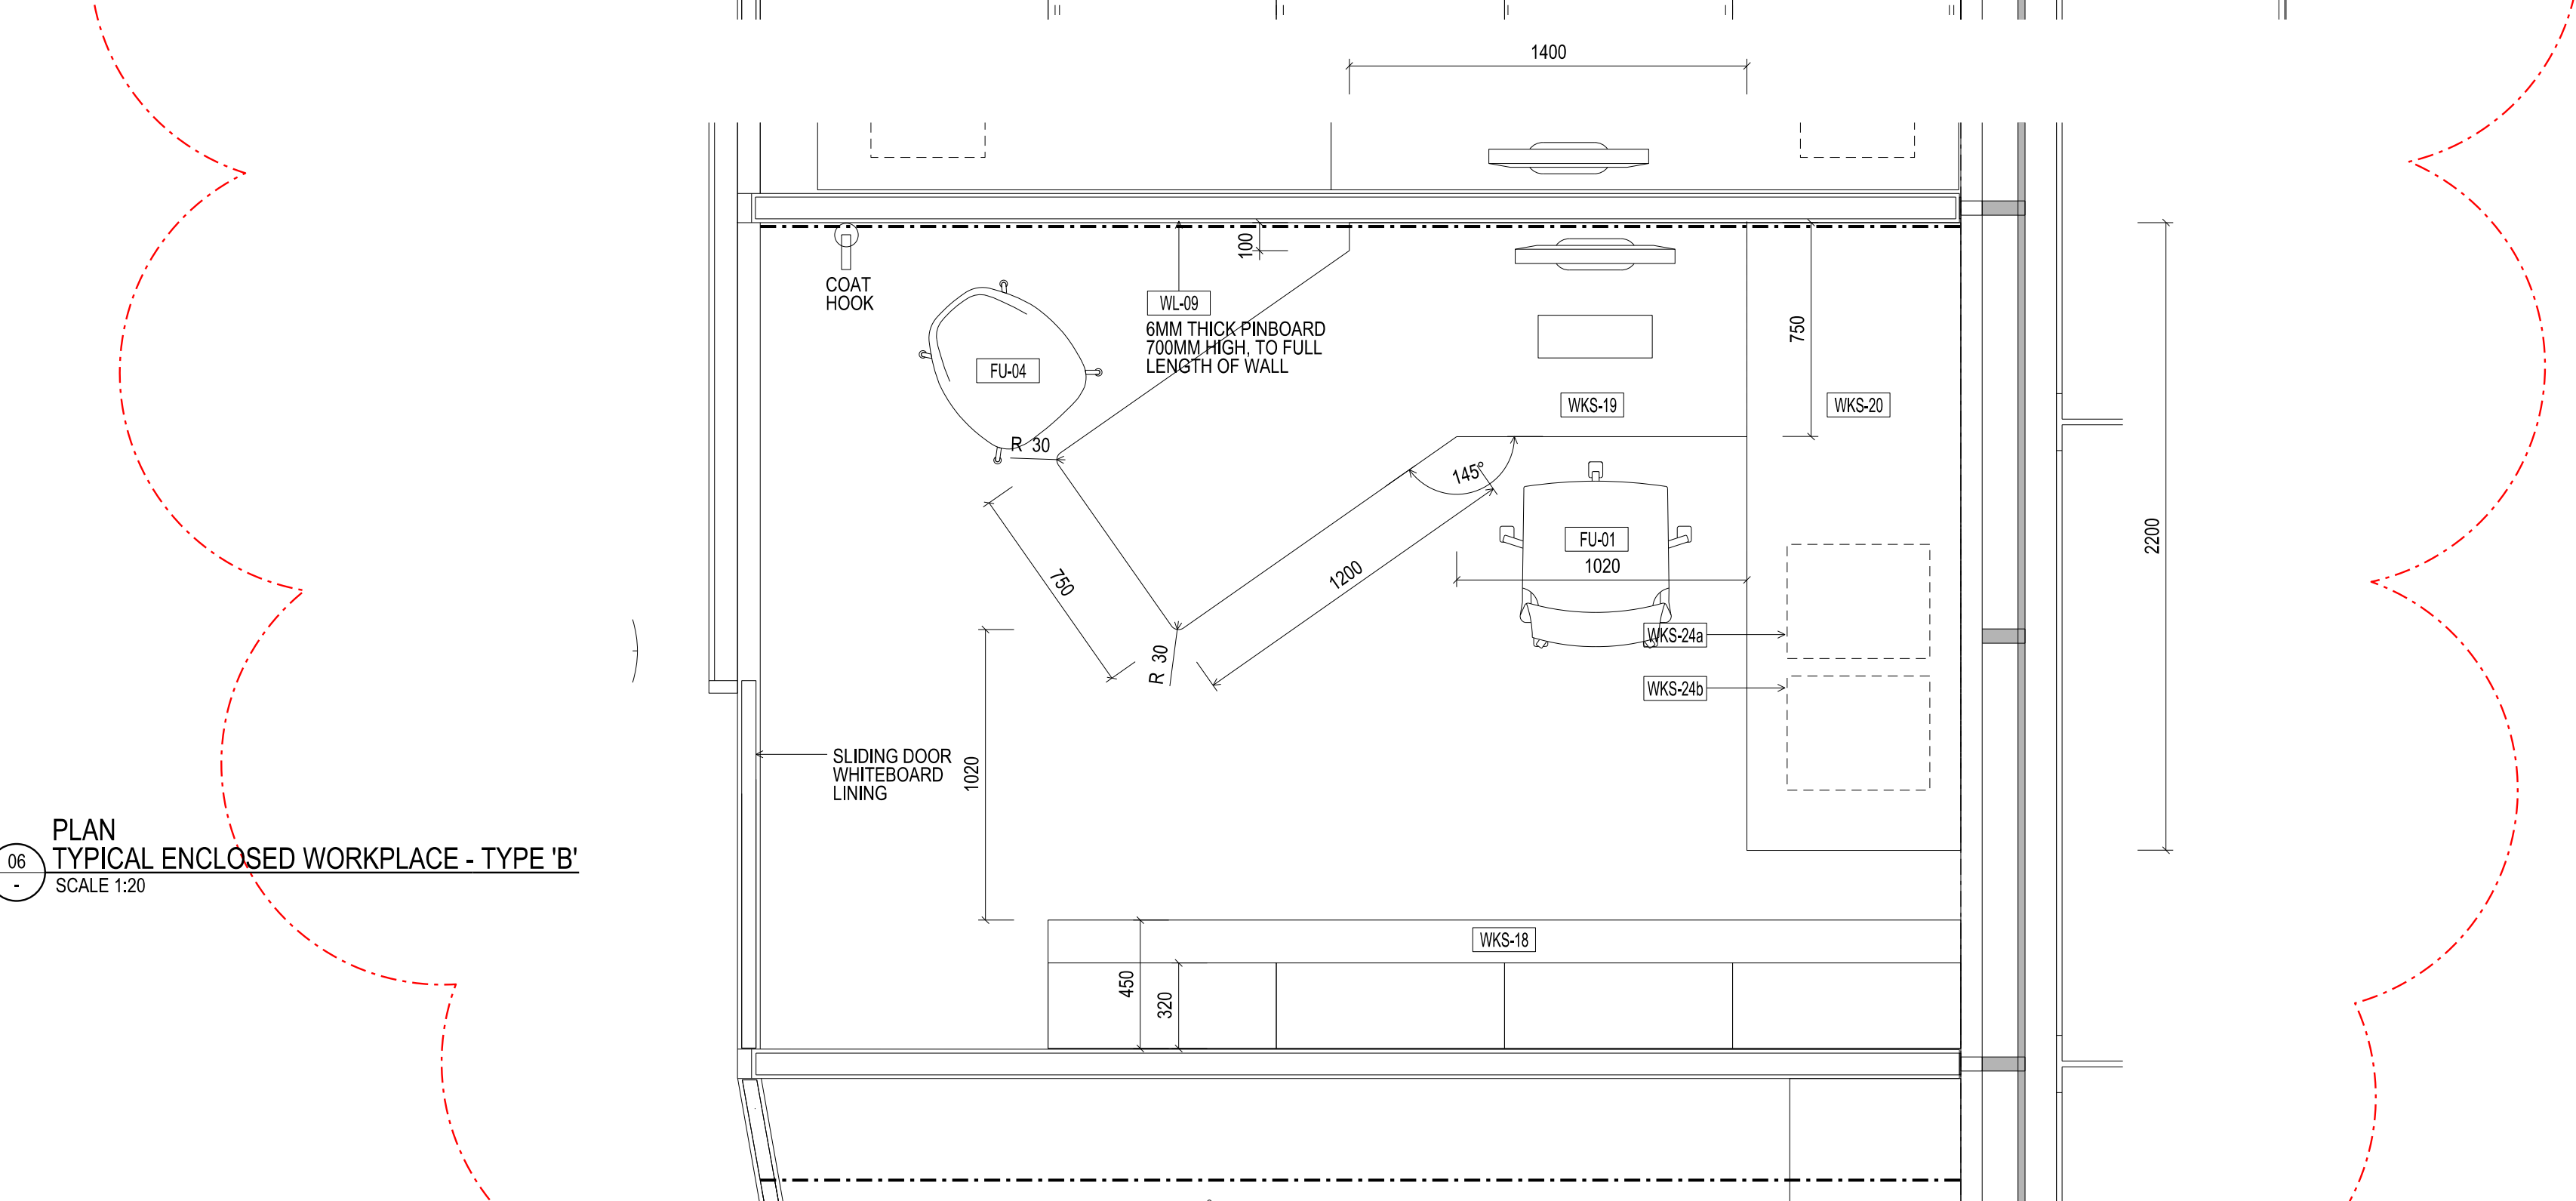
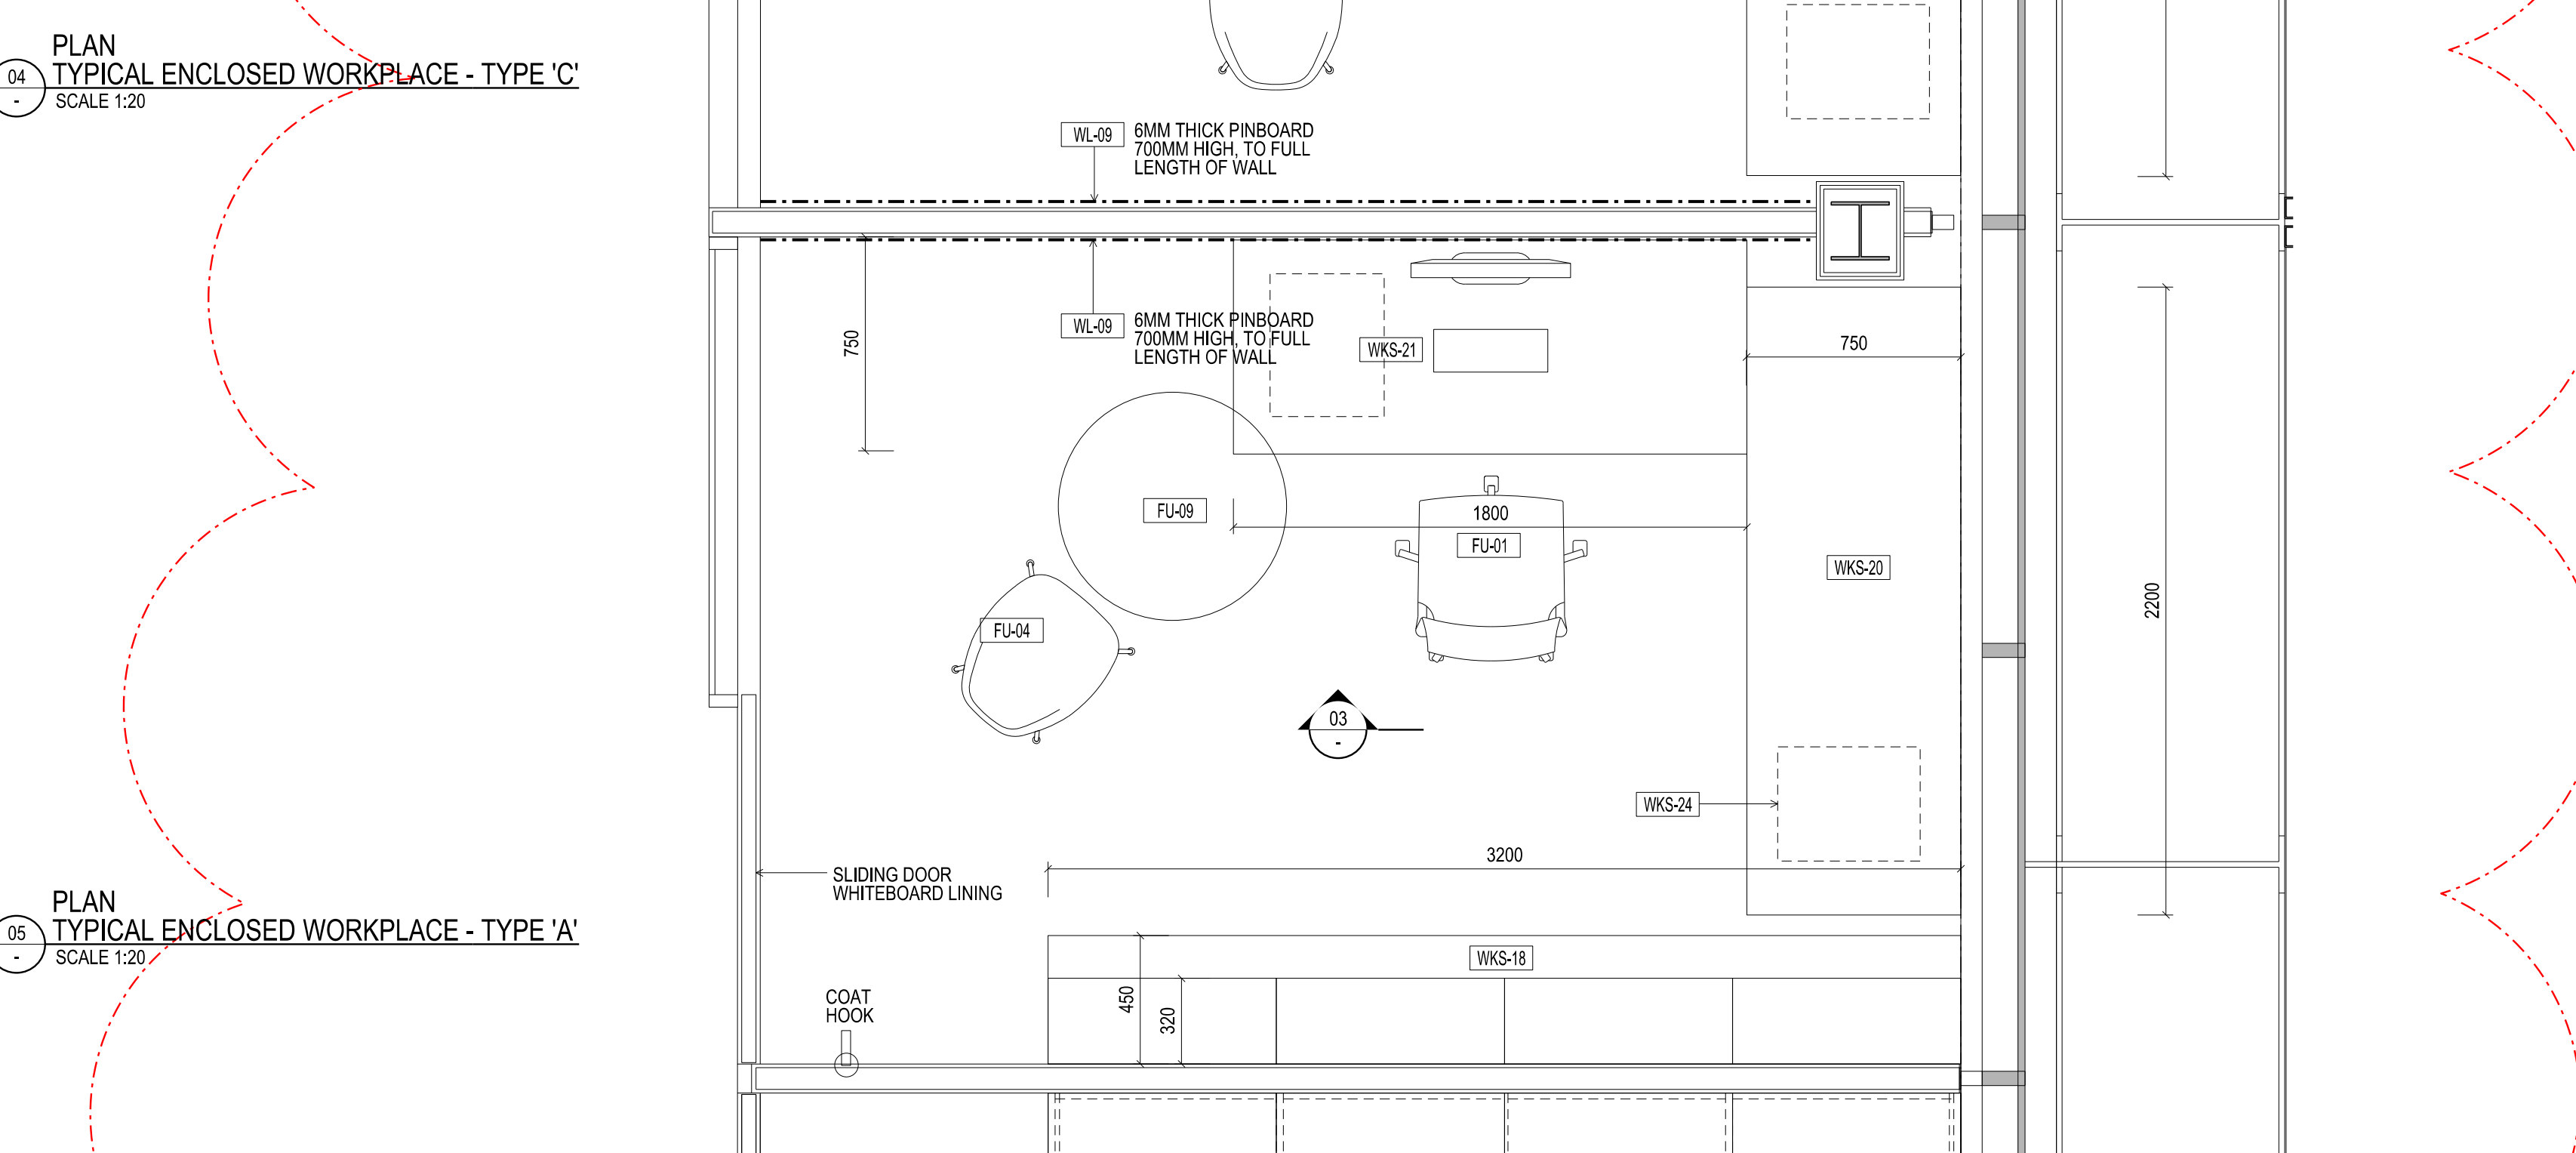


CONTRACTORS SHALL VERIFY JOB DIMENSIONS BEFORE ANY JOB COMMENCES. ALL SHOP DRAWINGS SHALL BE SUBMITTED TO THE SUPERINTENDENT AND MANUFACTURER SHALL NOT COMMENCE WORK PRIOR TO THE RETURN OF DIMENSIONED SHOP DRAWINGS SIGNED BY THE CONSULTANT. DIMENSIONS SHALL TAKE PRECEDENCE OVER SCALES. THIS DRAWING SHOULD BE READ IN CONJUNCTION WITH ALL RELEVANT CONTRACT SPECIFICATIONS AND DRAWINGS COPYRIGHT OF THIS DRAWING IS VESTED IN NADAAA

General Notes

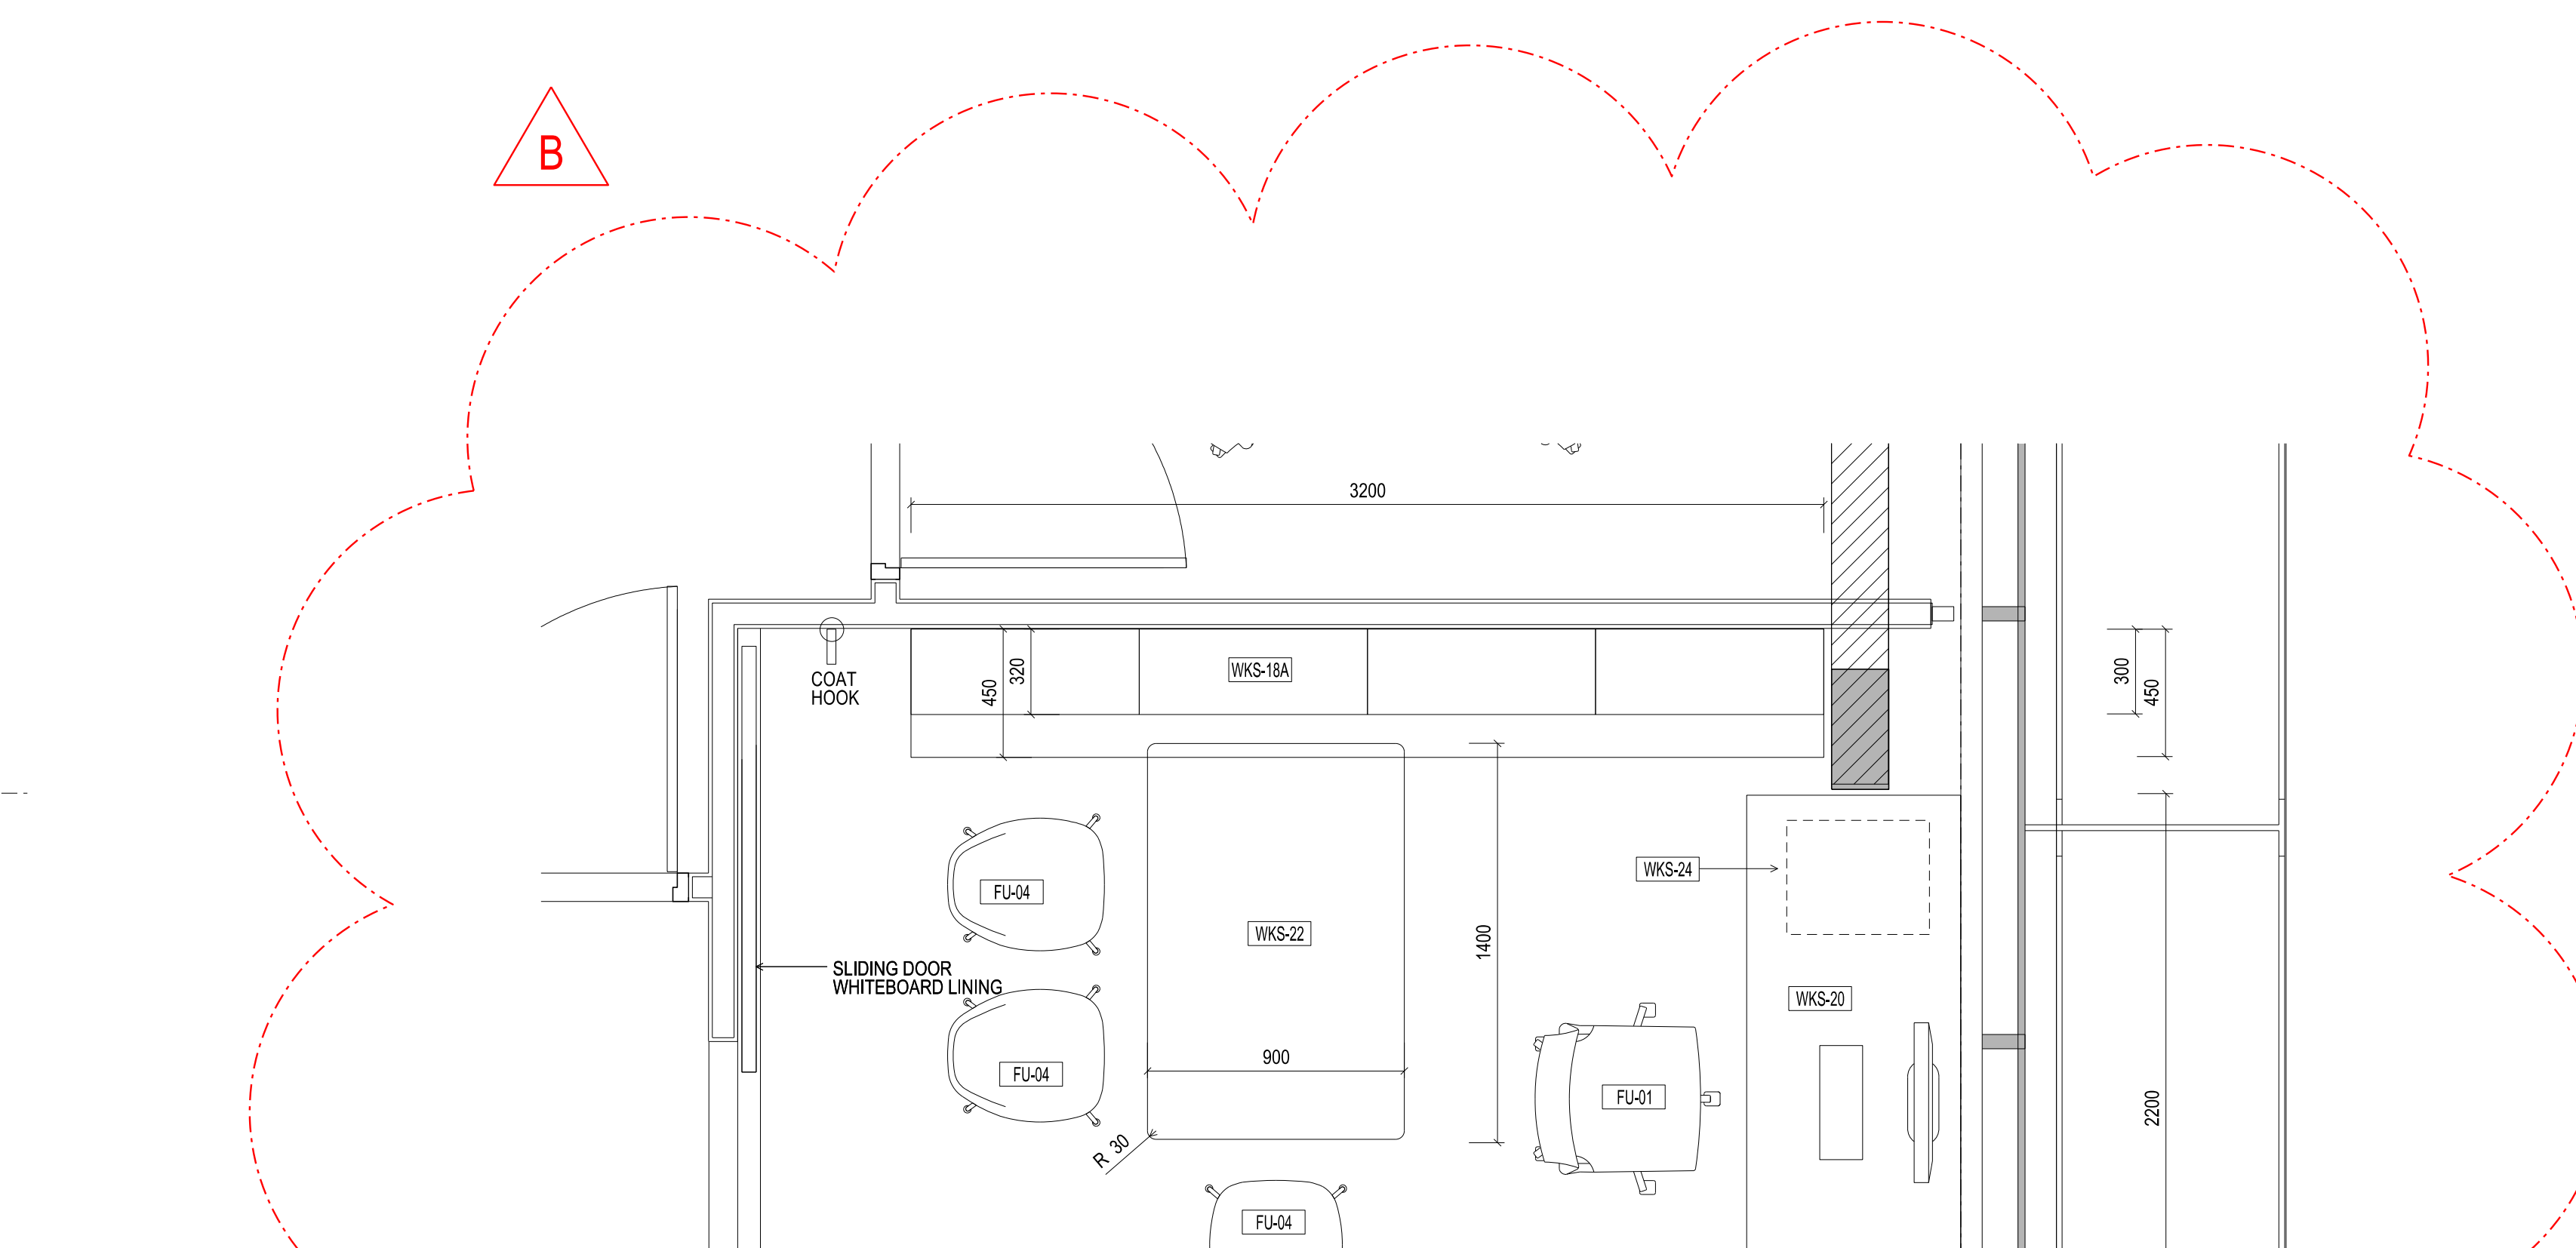

Rev	Issue	Revision Description	Amtd	Date
B	SG	UPDATE WORKSTATION LAYOUTS	-	21.01.14
A	SG	NOTE EXTENT OF PINBOARD	-	10.01.14
02	SG	TENDER ADDENDUM NCL4	-	08.10.12
01	SG	100% CD - TENDER ISSUE	-	07.09.12

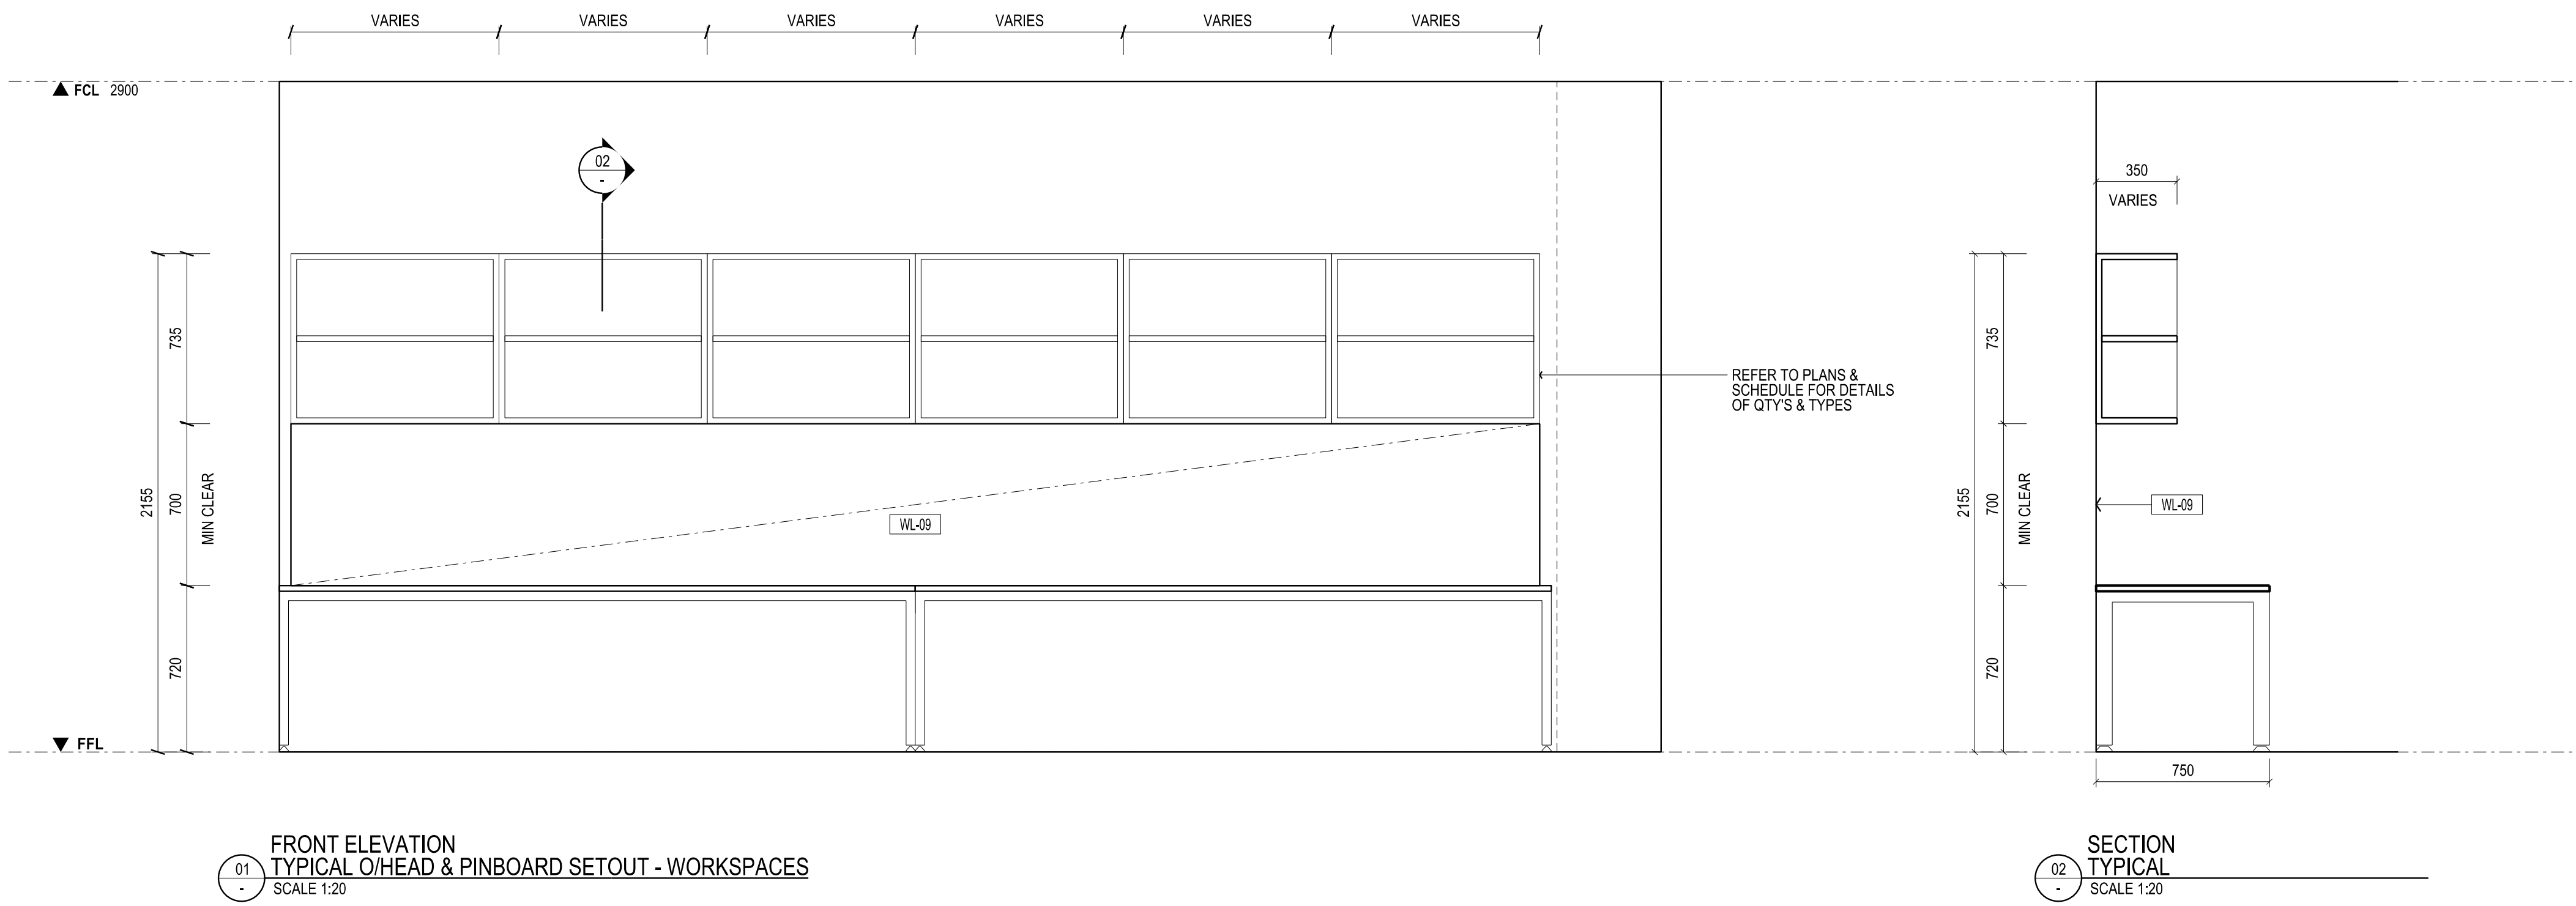

**NADAAA**  
 NADAAA Telephone +1 617 442 6232  
 1920 Washington Street No.2 Foxonville  
 Boston +1 688 442 1417  
 Massachusetts Email nada@nadaaa.com  
 02119 USA

**John Wardle Architects**  
 25 Rokeby Street, Collingwood, Victoria 3066 Australia  
 Tel: +61 3 8662 0400 www.johnwardlearchitects.com  
 © 2014 John Wardle Architects ABN 83 006 814 268

Client: University of Melbourne  
Parkville Campus

Project: Faculty of Architecture  
Building and Planning

Title: ENCLOSED WORKSPACE  
TYPICAL LAYOUTS

Project No.	0913	Scale	1:10 @ A3 1:20 @ A2
Drawing No.	AR8255	Revision	B

Date: Dec 2011  
 Drawn: Co-Ord: Check:

FILENAME - \$FILES\$

**FOR CONSTRUCTION**