



01 TYPICAL ELEVATION - CLUSTER ROOM 322 SCALE 1:20

05 FU-82 TYPICAL ELEVATION CLUSTER ROOM 322 SCALE 1:20


06 FU-85 TYPICAL ELEVATION ROOM 218 SCALE 1:20

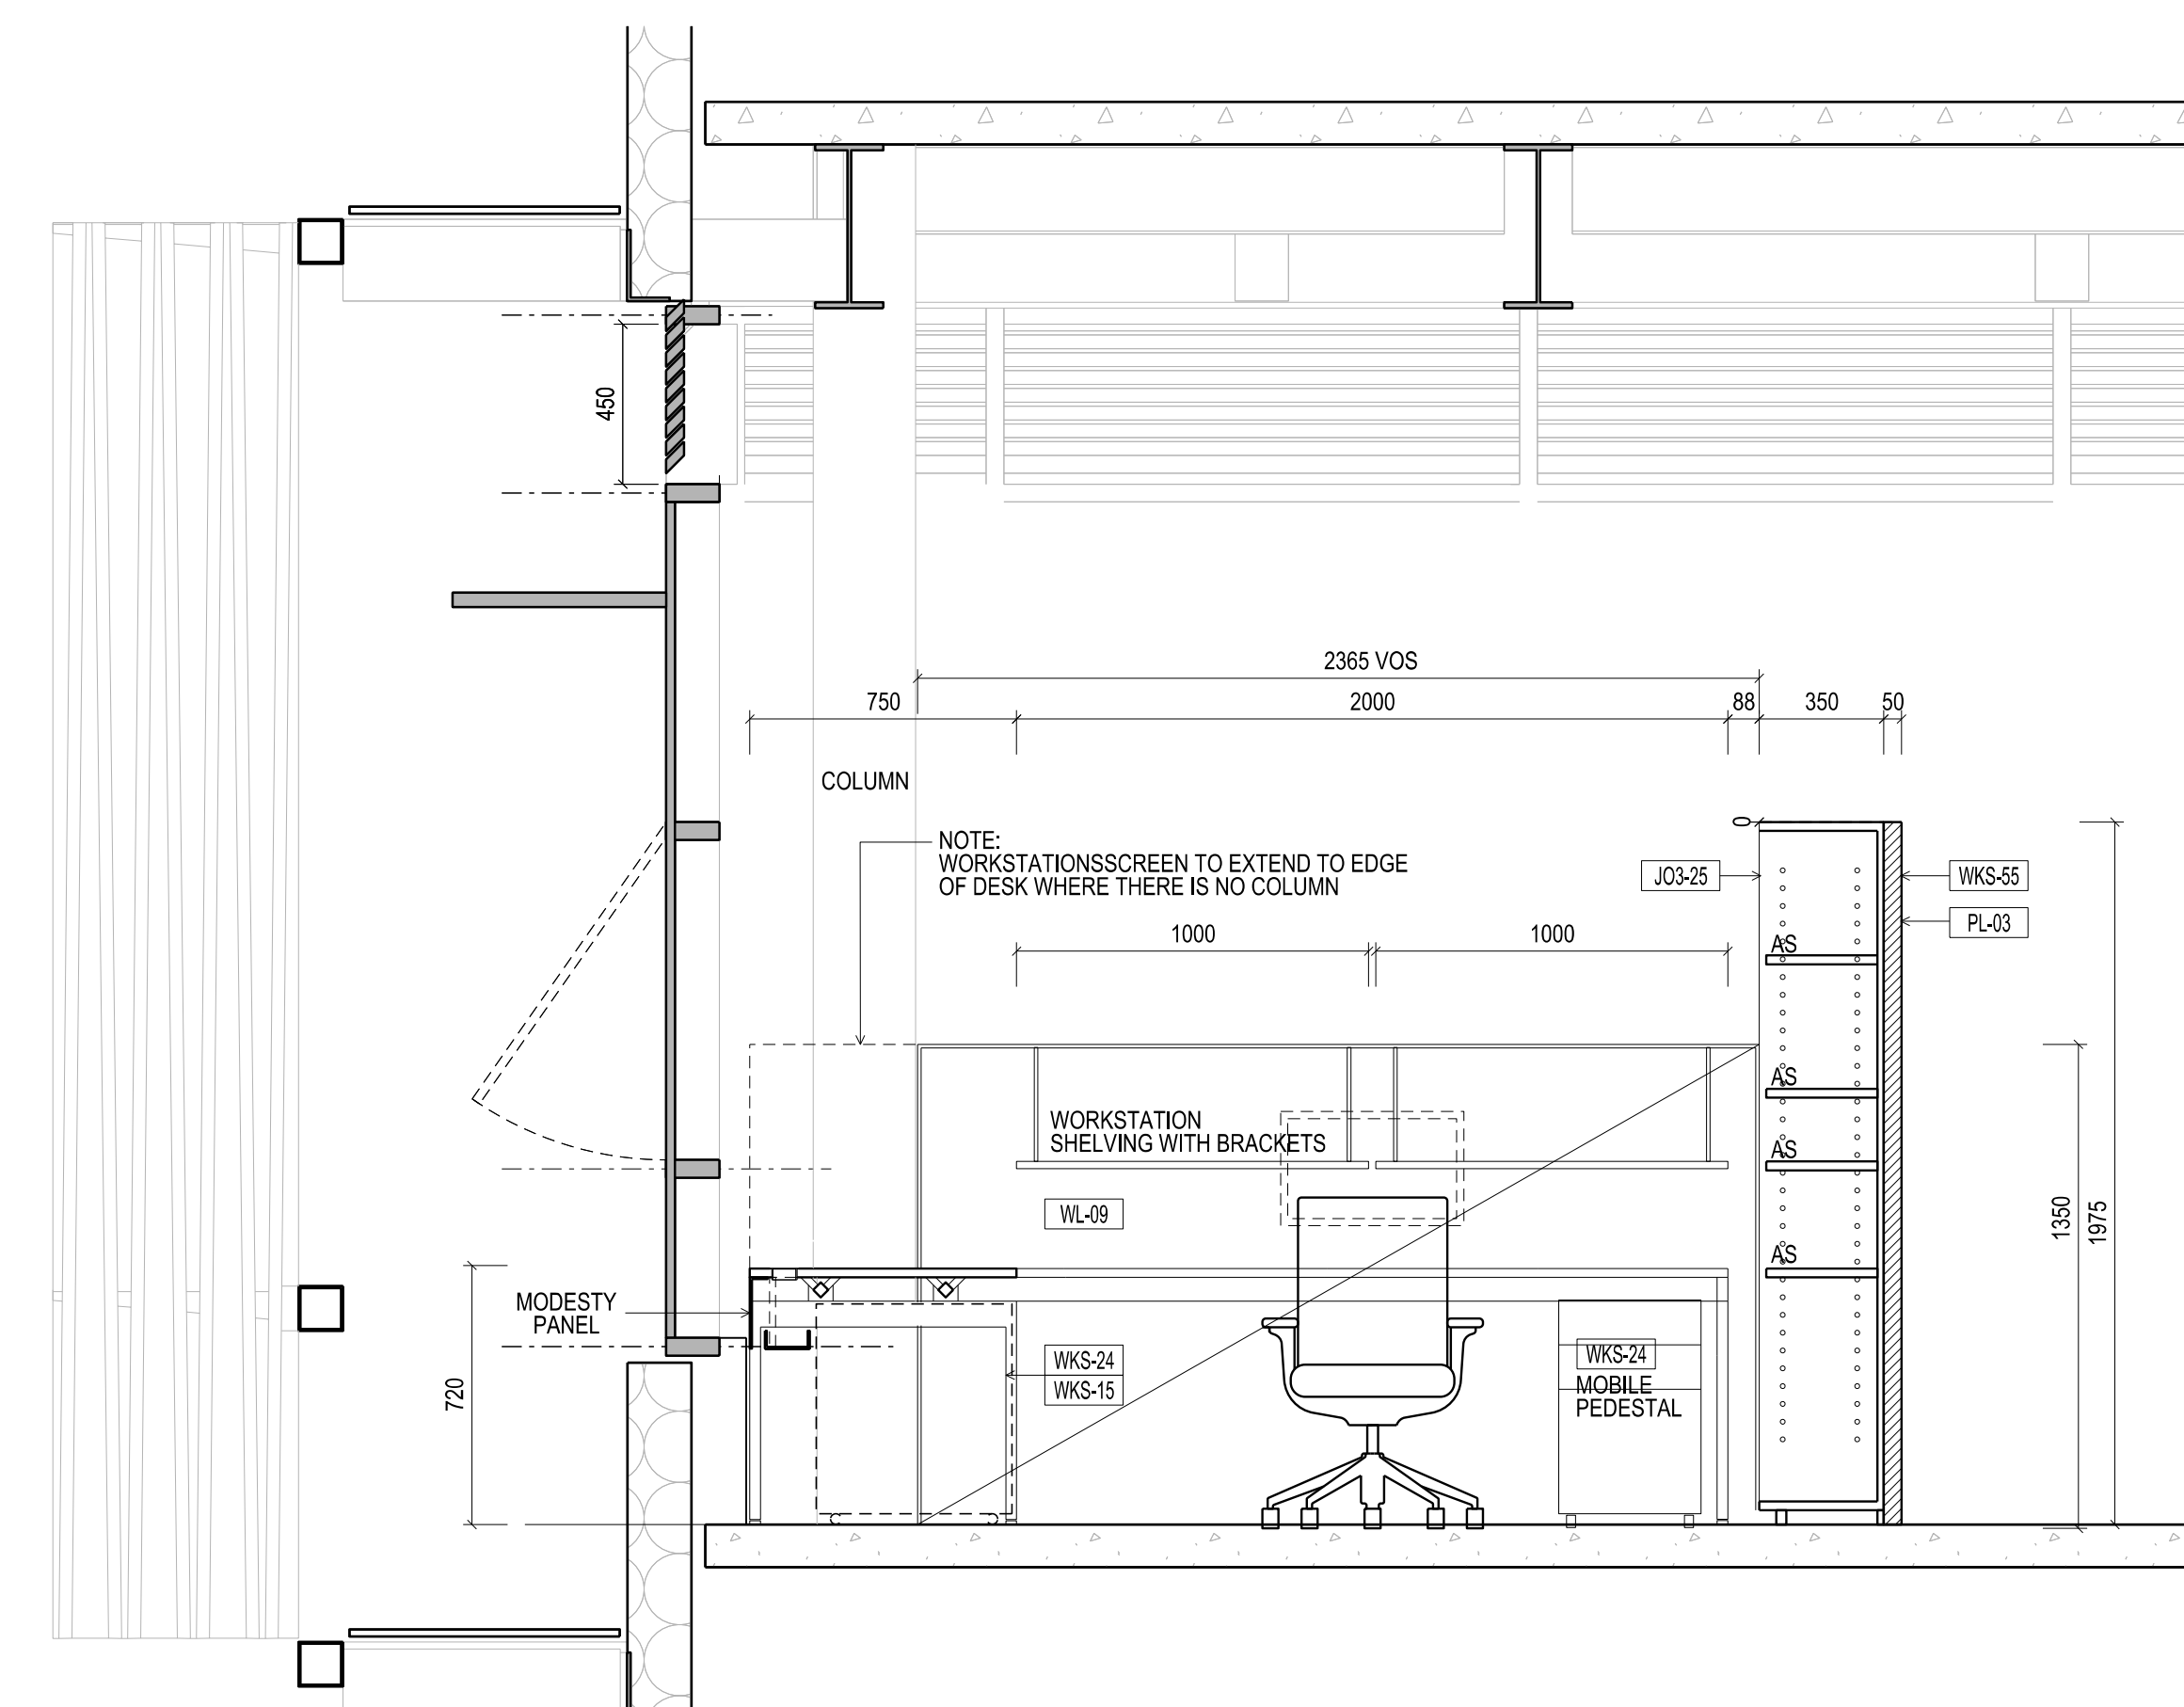


02 TYPICAL ELEVATION - CLUSTER ROOM 322 SCALE 1:20

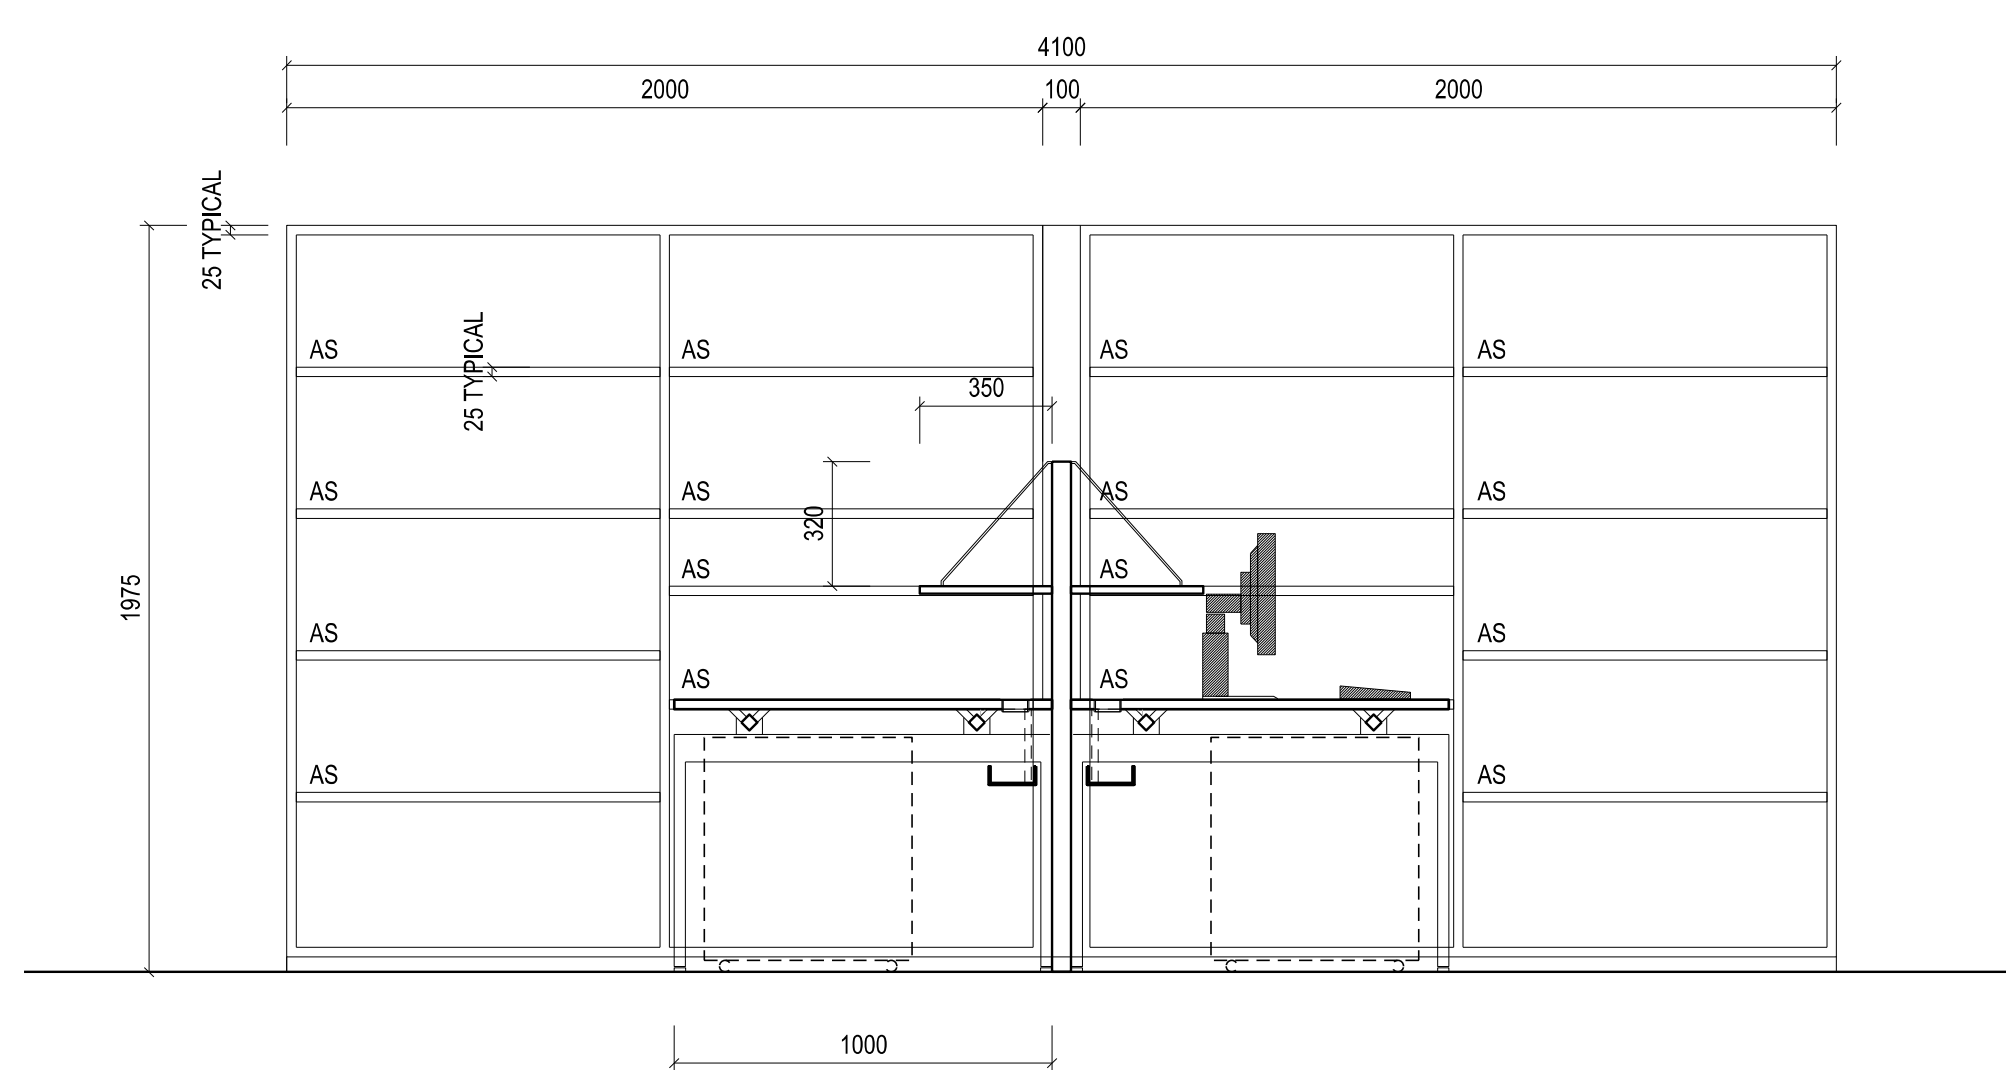

03 J03-23 TYPICAL ELEVATION - CLUSTER ROOM 322 SCALE 1:20

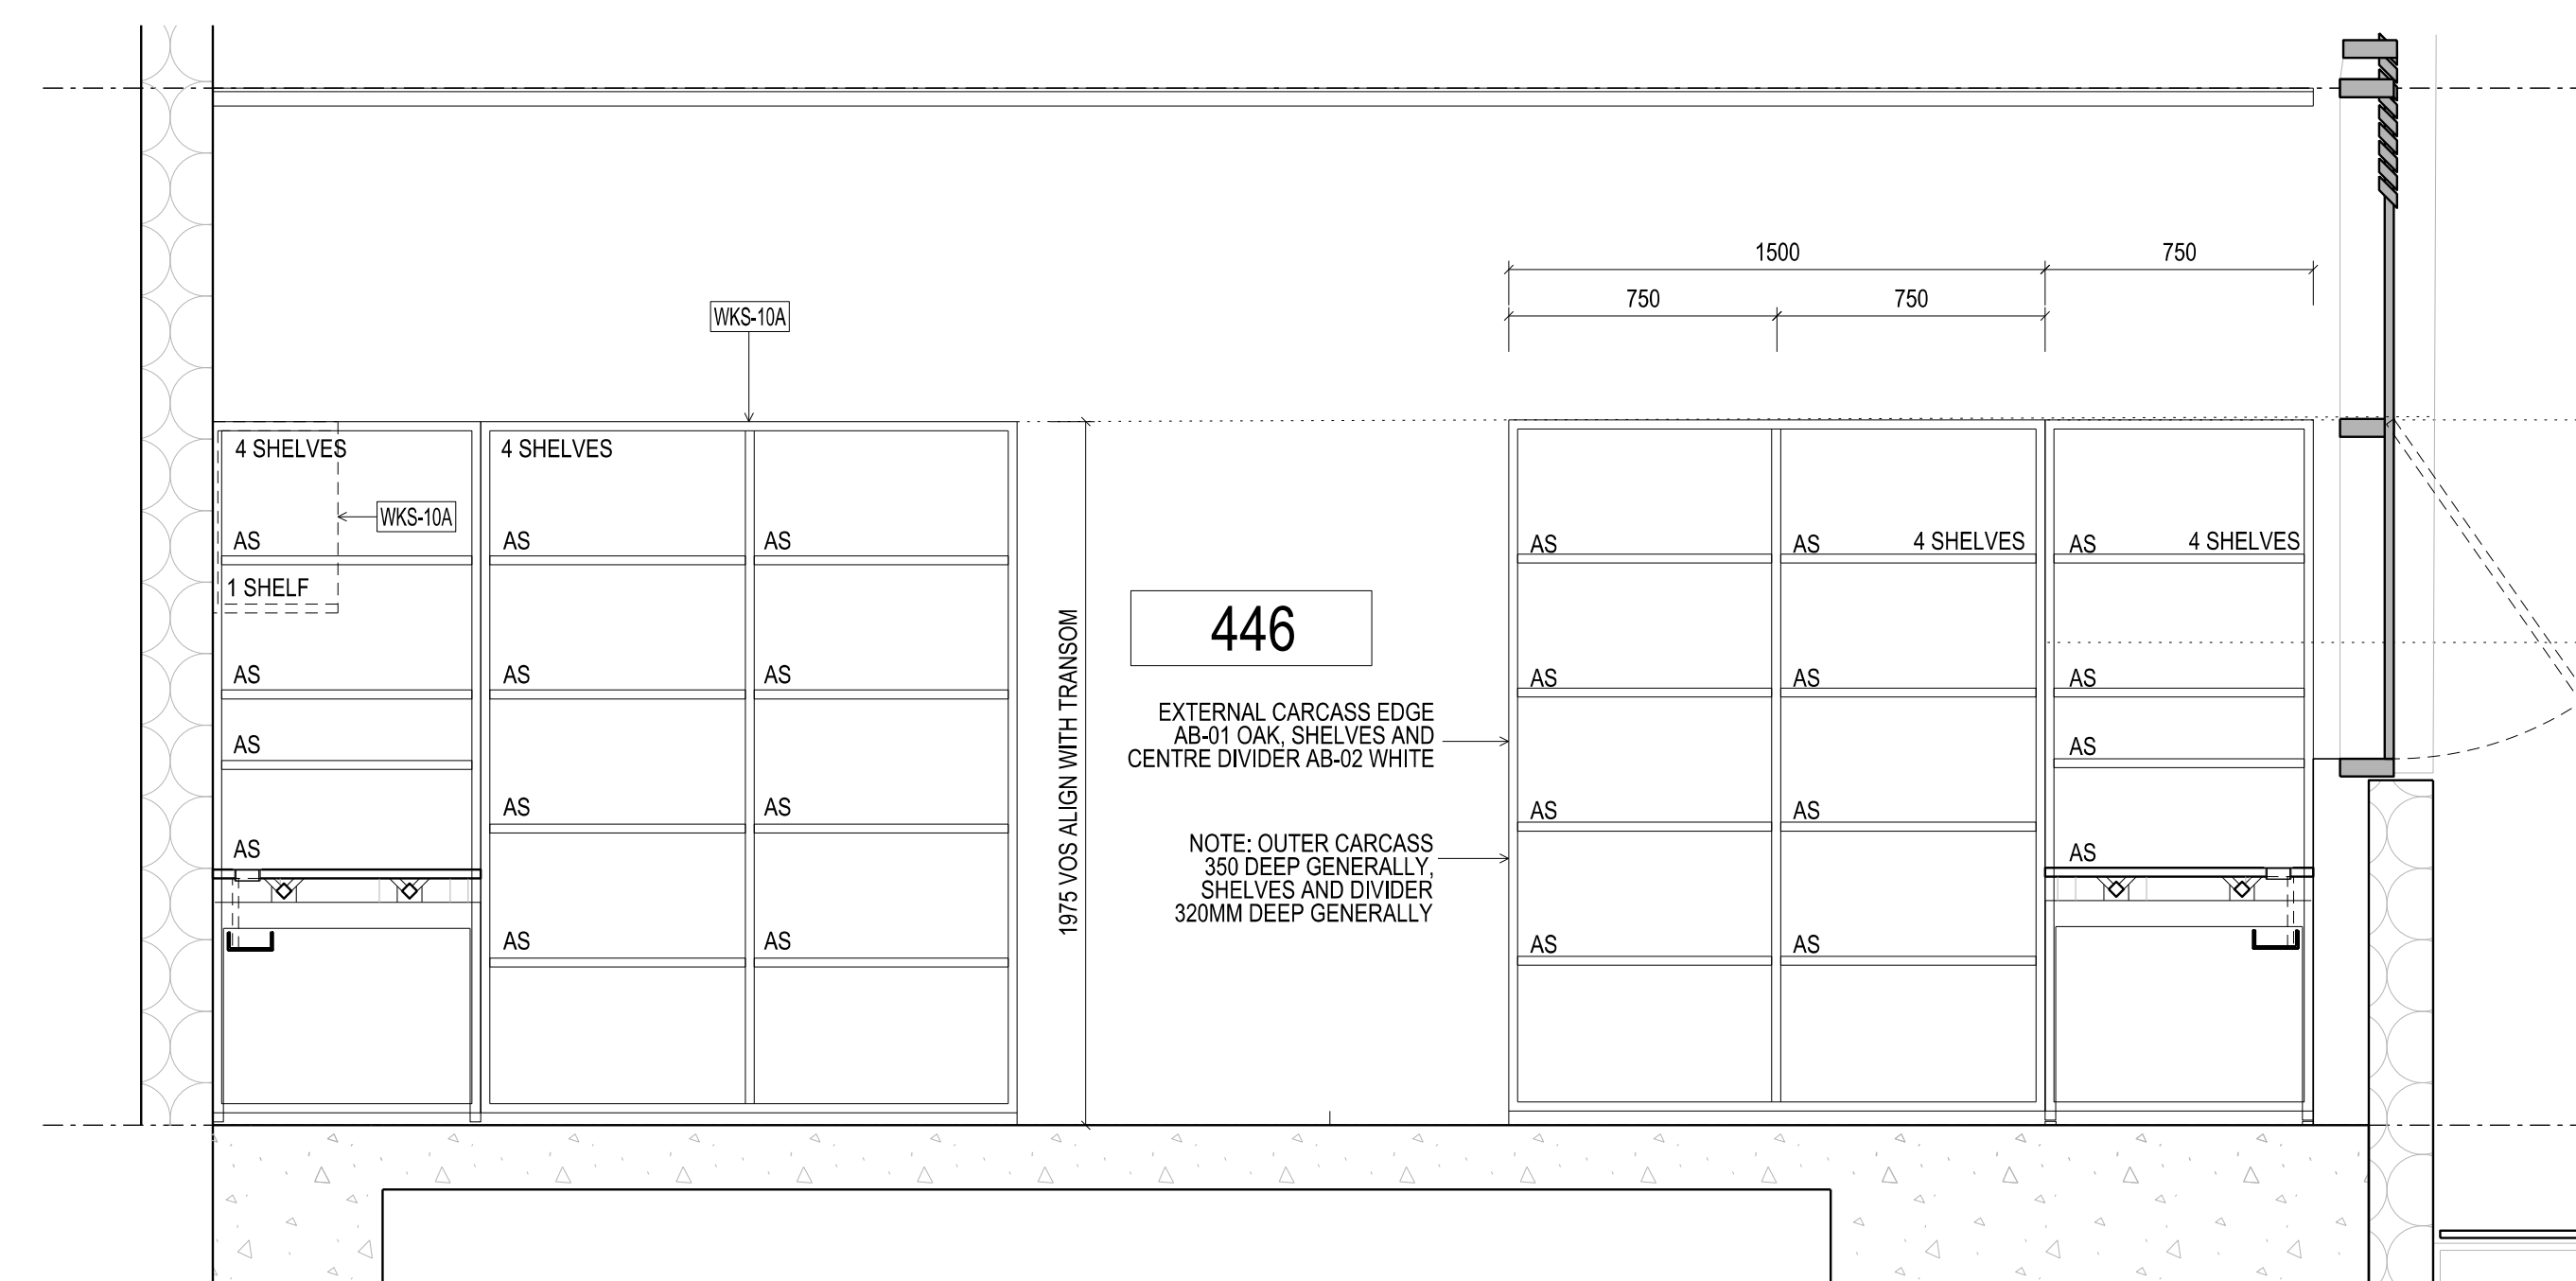

07 FU-84 TYPICAL ELEVATION ROOM 446 & 353 SCALE 1:20

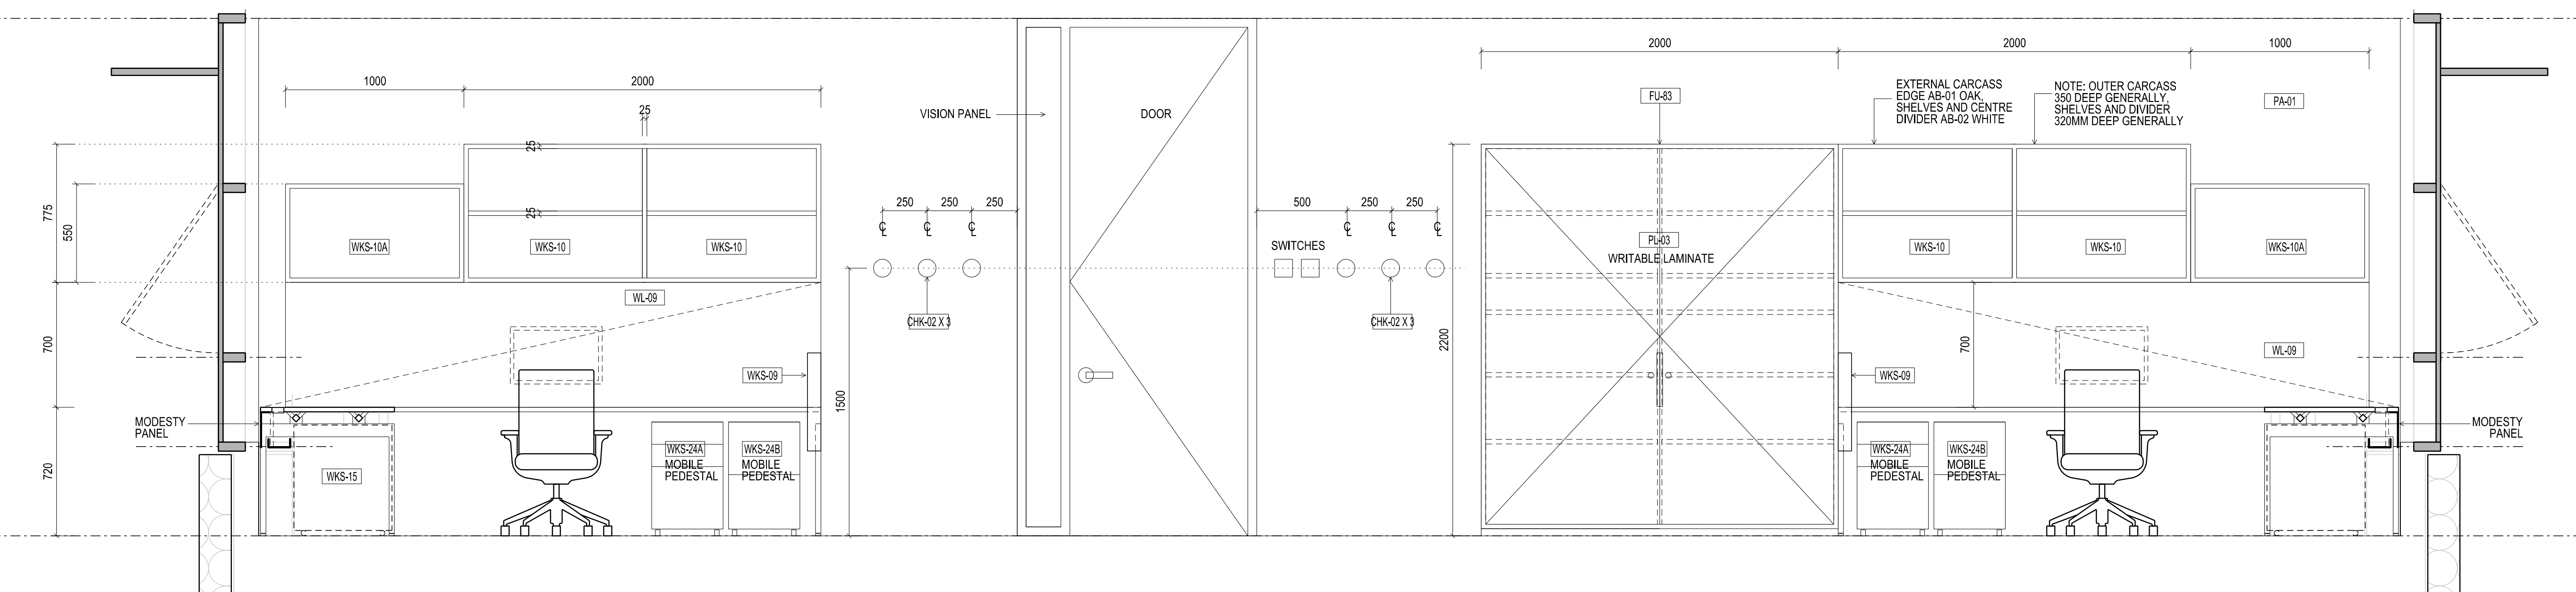

04 CROSS SECTION TYPICAL WORKPLACE CLUSTER SCALE 1:20

A	JA	FOR CONSTRUCTION	29.01.14
01	JA	FOR CLIENT APPROVAL	27.03.13

Rev	Issue	Revision Description	And	Date



**NADAAA**  
 NADAAA Telephone: +1 617 442 6232  
 1900 Washington Street No. 2 Facsimile: +1 888 442 1417  
 Boston Massachusetts Email: nad@nadaaa.com  
 02118 USA

**John Wardle Architects**  
 25 Rokeby Street, Collingwood, Victoria 3066 Australia  
 Tel: +61 3 8662 0400 www.johnwardlearchitects.com  
 © 2014 John Wardle Architects ABN 53 006 614 266

Client: University of Melbourne  
 Parkville Campus

Project: Faculty of Architecture  
 Building and Planning

Title: ENCLOSED WORKSPACE  
 TYPICAL LAYOUTS

Project No.	0913	Scale	1:10 @ A0 1:20 @ A2
Drawing No.	AR8257	Revision	A
Date	Dec 2011	Drawn	Co-Ord

FILENAME - \$FILES  
**FOR CONSTRUCTION**