

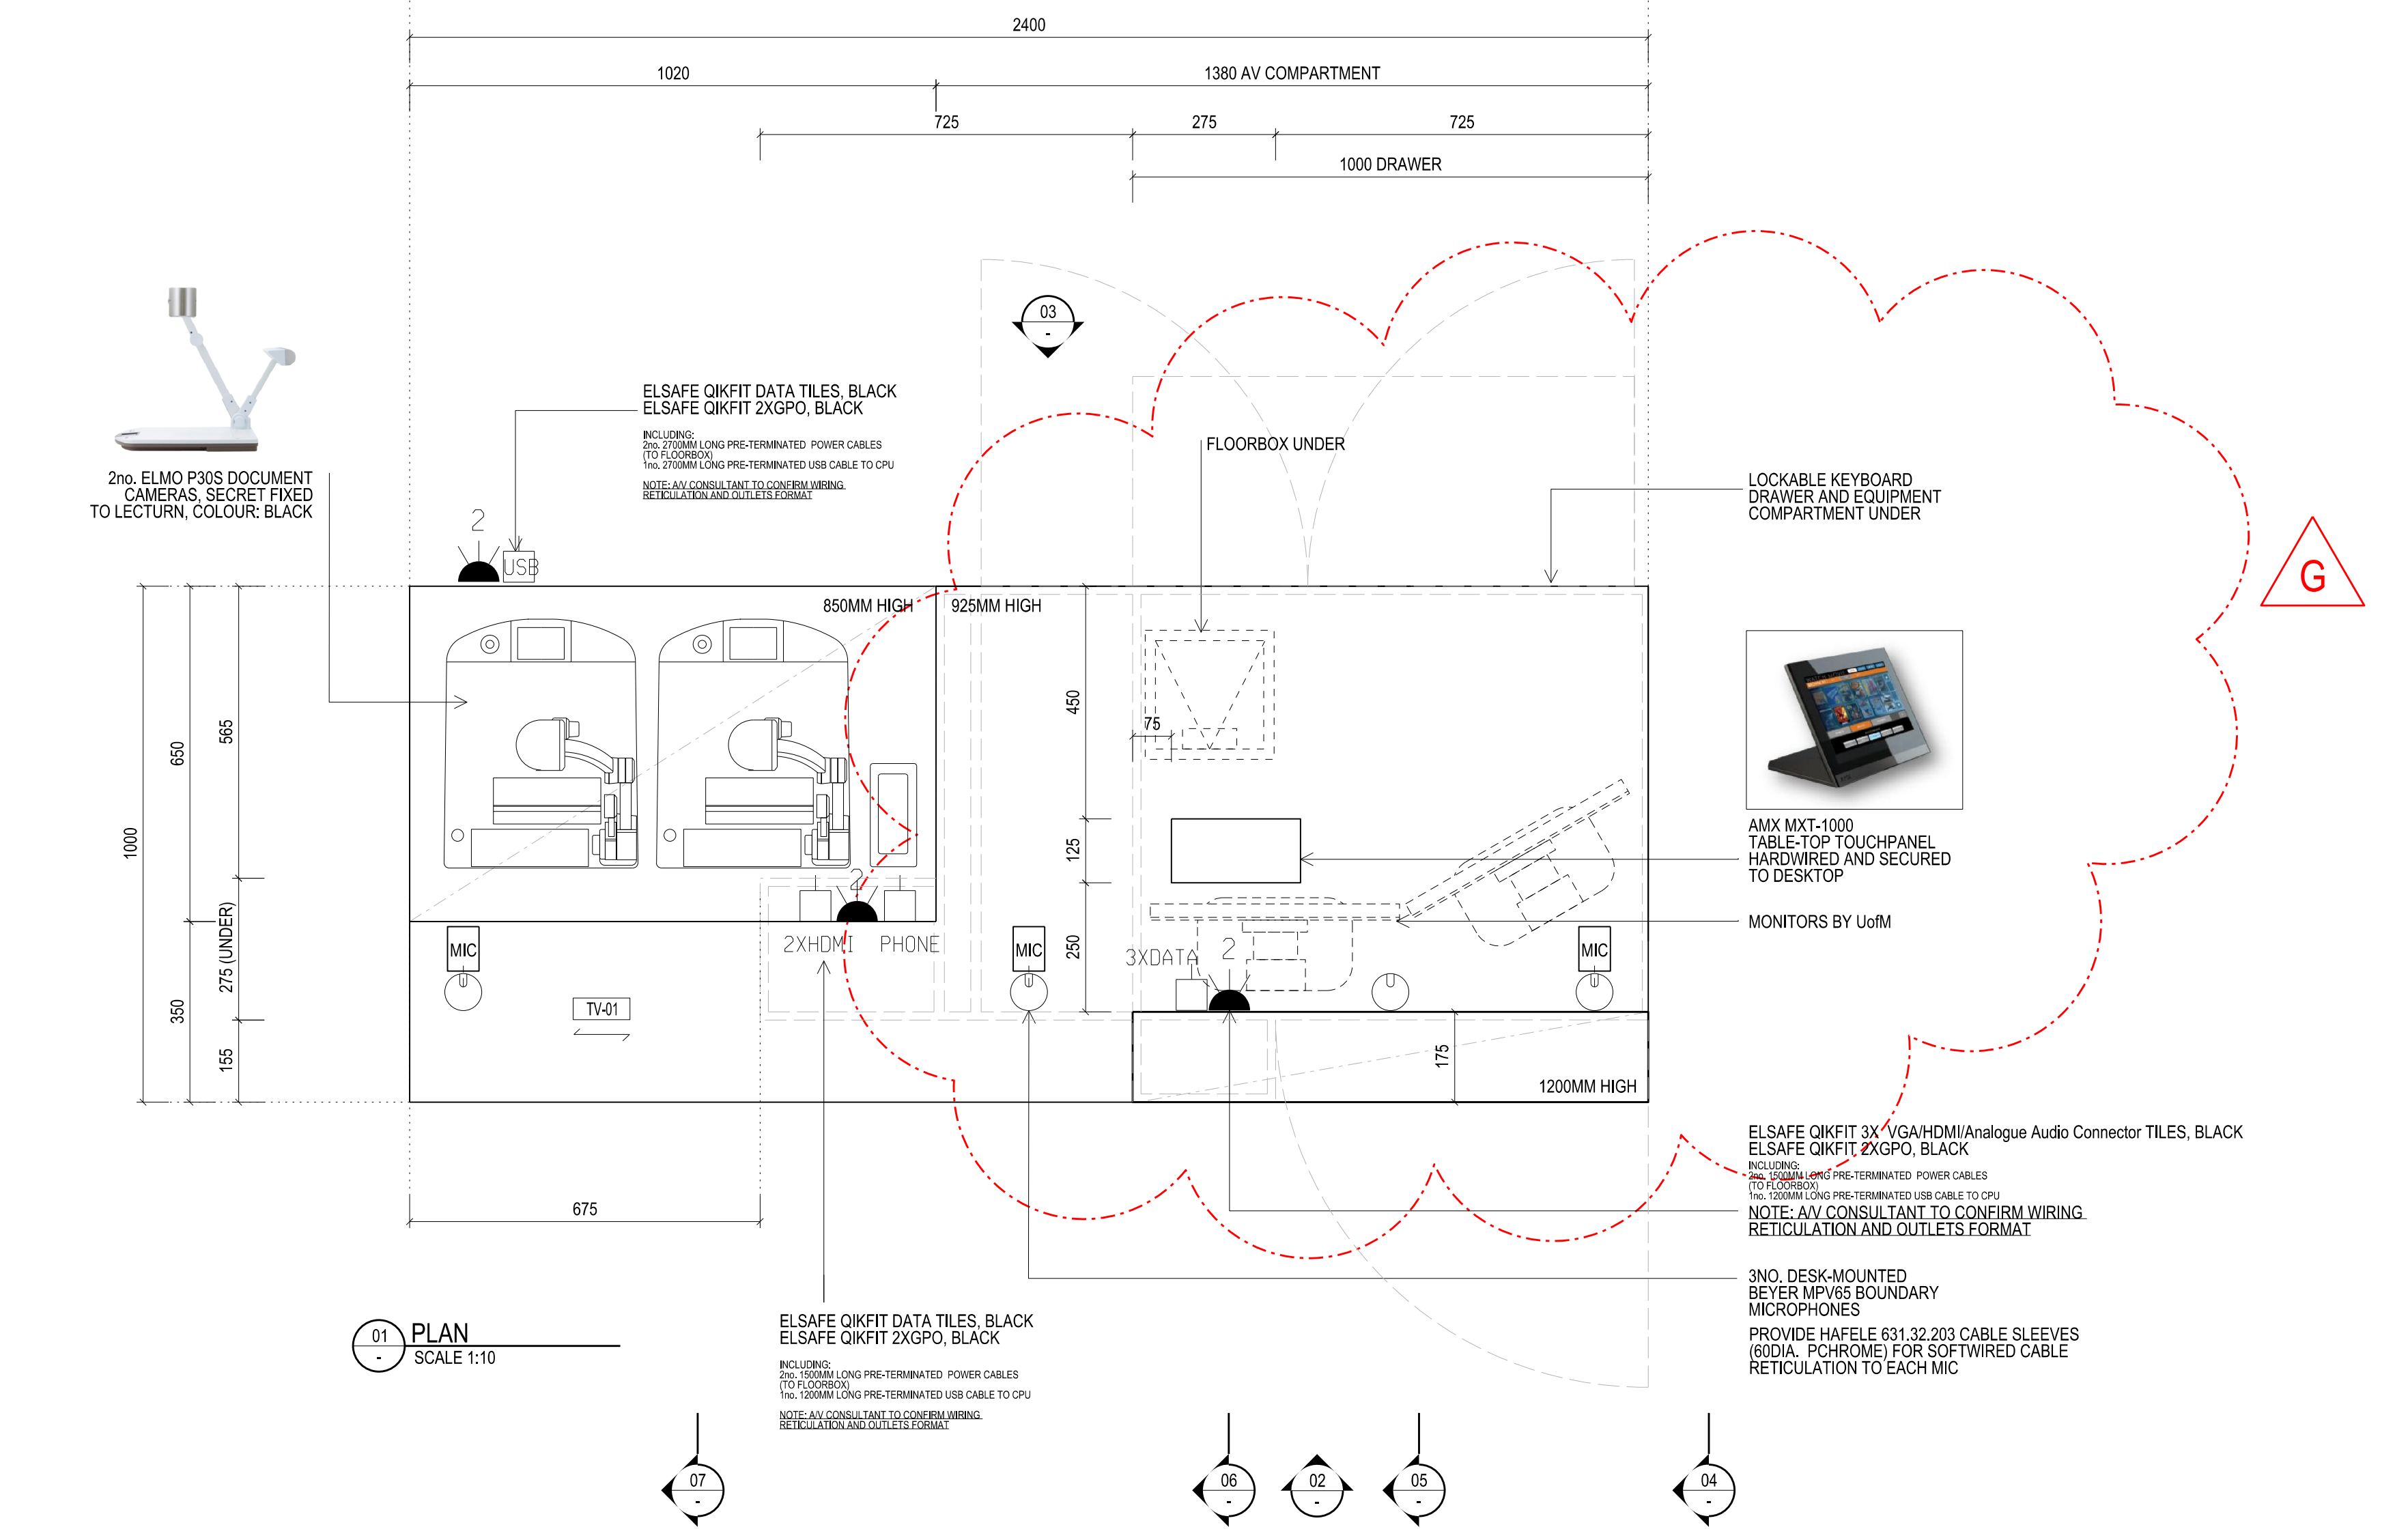


CONTRACTORS SHALL VERIFY JOB DIMENSIONS BEFORE ANY JOB COMMENCES. ALL SHOP DRAWINGS SHALL BE SUBMITTED TO THE SUPERINTENDENT AND MANUFACTURE SHALL NOT COMMENCE PRIOR TO THE RECEIPT OF DIMENSIONS SHOP DRAWINGS ISSUED BY THE CONSULTANT. MEASUREMENTS SHALL BE PRECISELY TO SCALE. THE DRAWING SHOULD BE READ IN CONJUNCTION WITH ALL RELEVANT CONTRACT SPECIFICATIONS AND DRAWINGS COPYRIGHT OF THIS DRAWING IS VESTED IN HANDLE.

General Notes

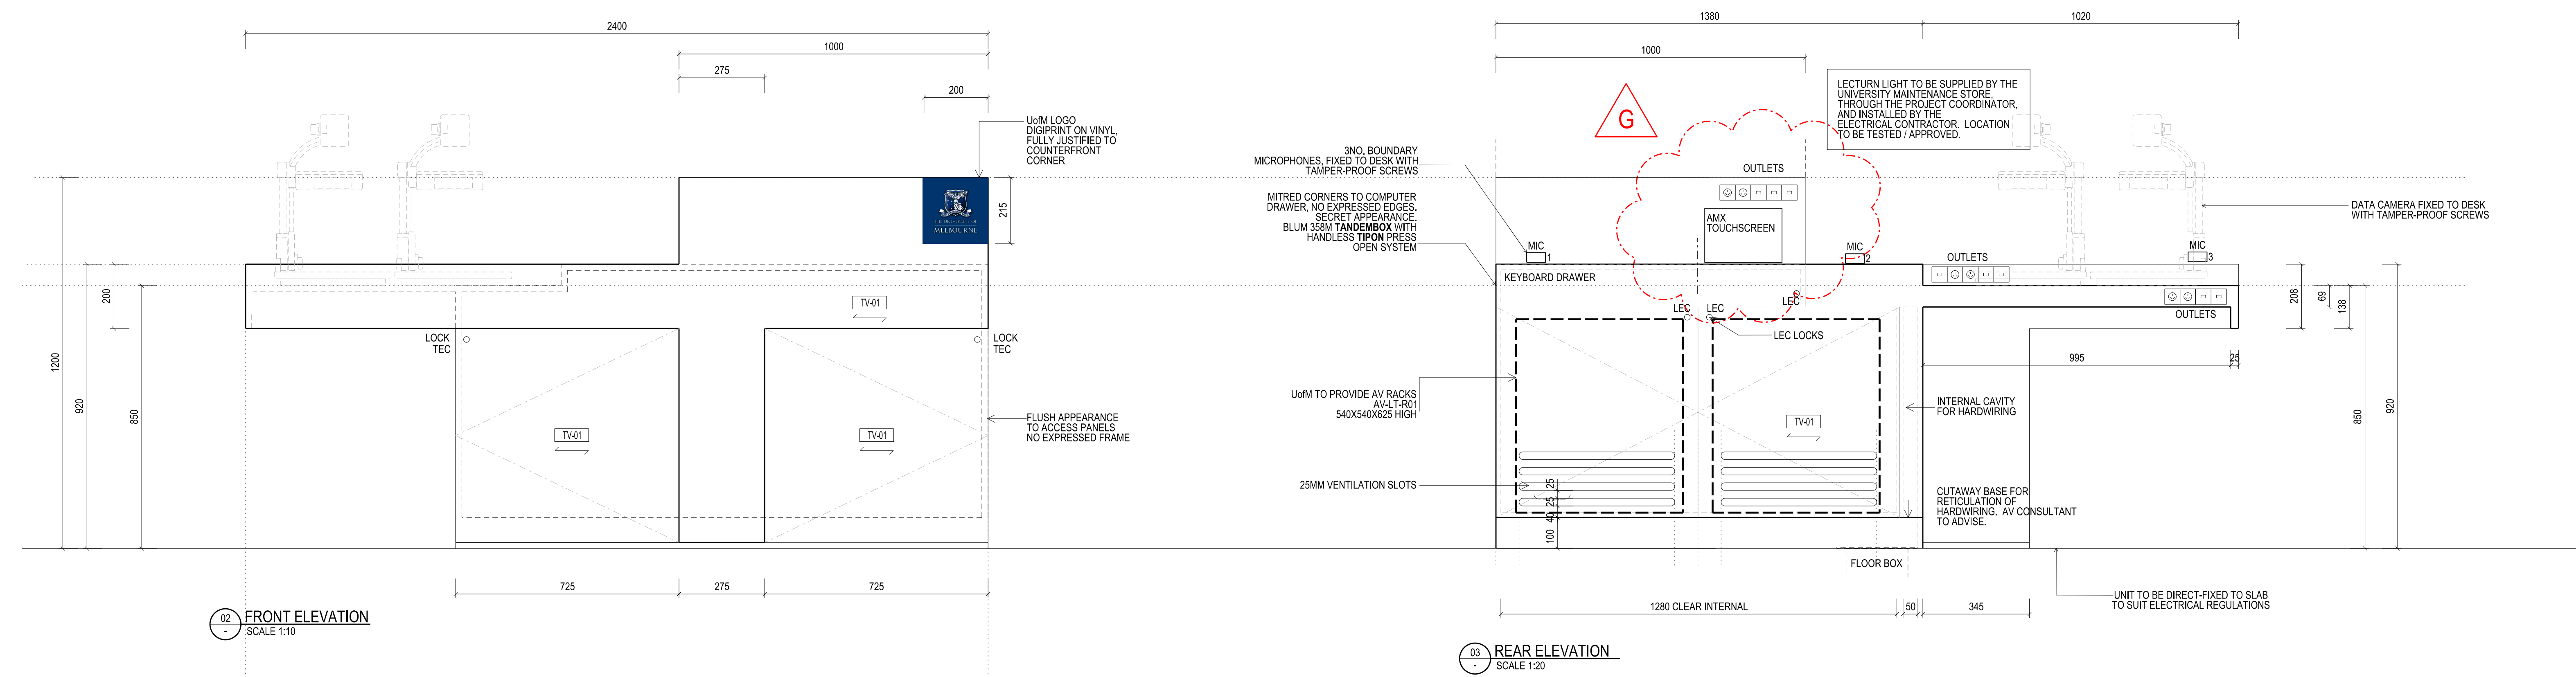

Rev	Issue	Revision Description	Amd	Date
G	JA	TOUCHSCREEN LOCATION	-	03.08.14
F	JA	FOR CONSTRUCTION	-	19.03.14
E	JA	FOR CONSTRUCTION	-	19.03.14
D	JA	FOR CONSTRUCTION	-	15.11.13
C	JA	FOR CLIENT APPROVAL	-	14.10.13
B	JA	FOR CLIENT APPROVAL	-	11.10.13
01	JA	FOR CLIENT APPROVAL	-	30.09.13

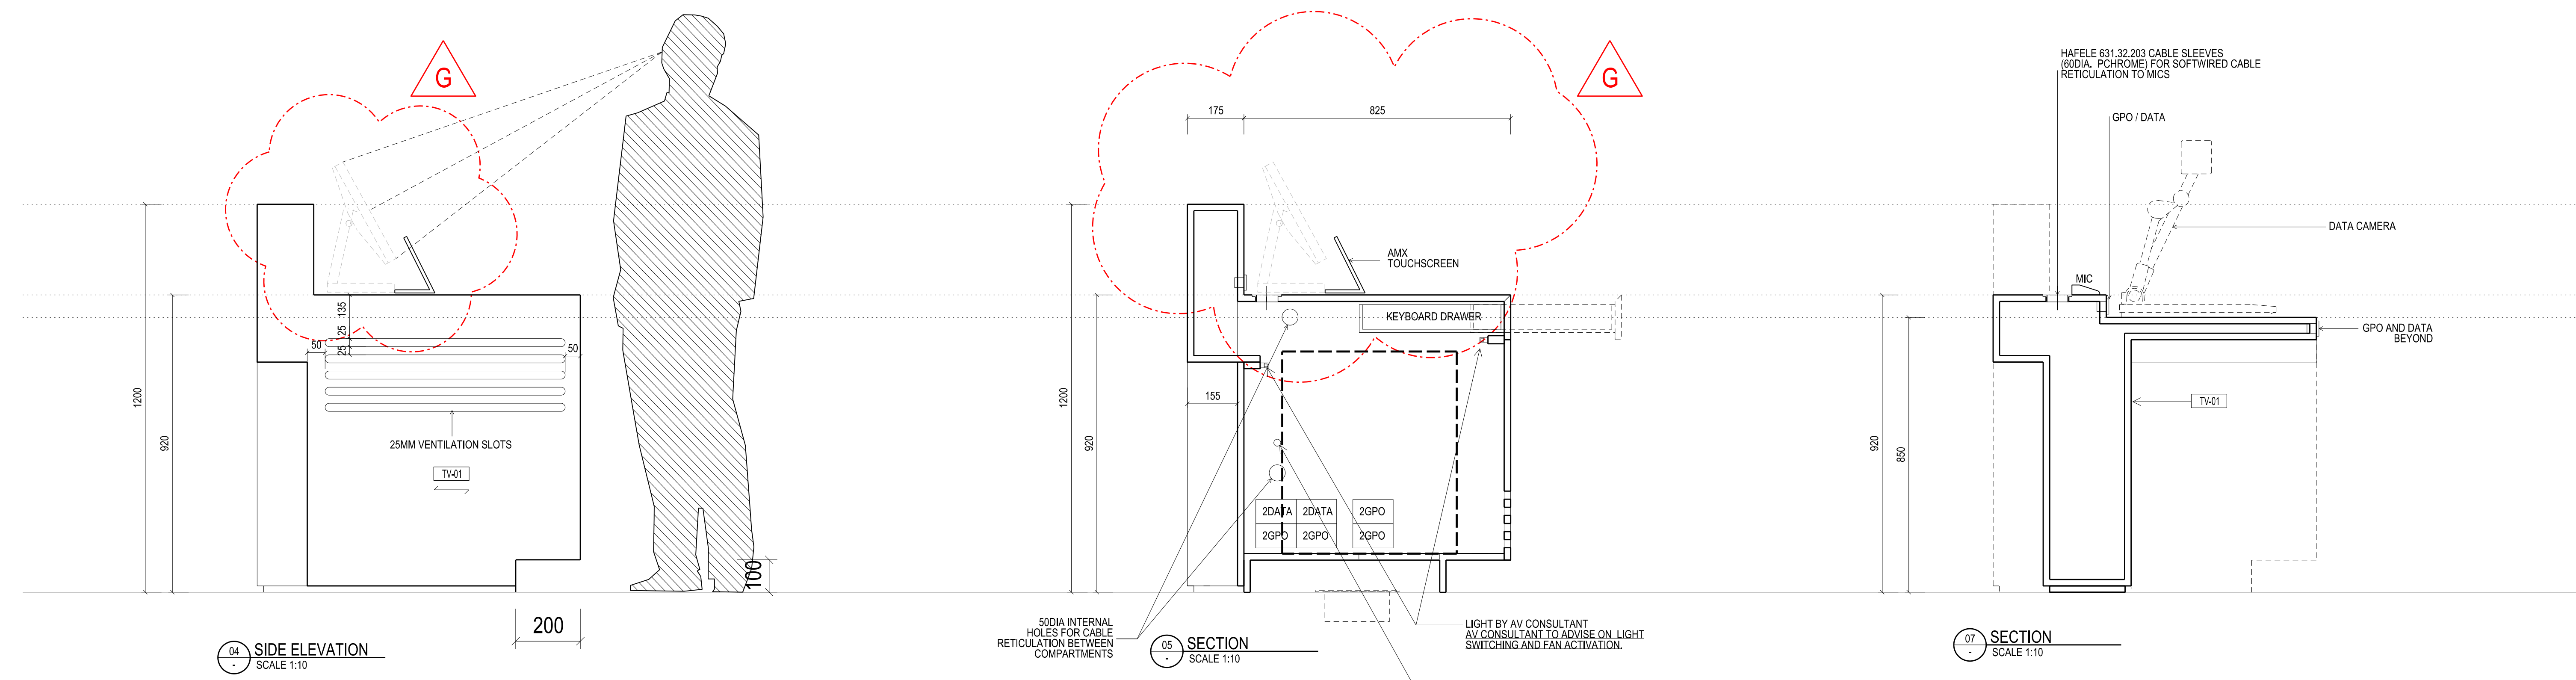

NADAAA
 NADAAA
 1920 Washington Street No.2
 Boston, Massachusetts 02118 USA
 Telephone: +1 617 442 6232
 Facsimile: +1 688 442 1417
 Email: nadaaa@nadaaa.com

John Wardle Architects
 25 Rokeby Street, Collingwood, Victoria 3066 Australia
 Tel: +61 3 8662 0400 www.johnwardlearchitects.com
 © 2014 John Wardle Architects ABN 63 006 814 268

Client: University of Melbourne
 Parkville Campus
 Project: Faculty of Architecture Building and Planning
 Title: LECTURN DETAILS AUD 01

Project No.	0913	Scale	1:10 @ A0 1:20 @ A2
Drawing No.	AR 8258	Revision	G
Date	Dec 2011	Drawn	-
Co-Ord	-	Chk	-

FOR CONSTRUCTION