


CONTRACTORS SHALL VERIFY ALL DIMENSIONS BEFORE ANY JOB COMMENCES. ALL SHOP DRAWINGS SHALL BE SUBMITTED TO THE SUPERINTENDENT AND MANUFACTURE SHALL NOT COMMENCE PRIOR TO THE RETURN OF UNAMENDED SHOP DRAWINGS ISSUED BY THE CONSULTANT. FIGURED DIMENSIONS SHALL TAKE PRECEDENCE OVER SCALED. THE DRAWING SHOULD BE READ IN CONJUNCTION WITH ALL RELEVANT CONTRACT SPECIFICATIONS AND DRAWINGS COPYRIGHT OF THIS DRAWING IS VESTED IN WARDLE

General Notes

03
-
ELEVATION
LIBRARY SERVIC
SCALE 1:20

JOINER TO INCLUDE
DOUBLE MONITOR ARM:
HOOLIN LA7GQWA,
2.8-10KG, GROMMET MOUNT,
CABLES CONCEALED WITHIN UNIT BASE

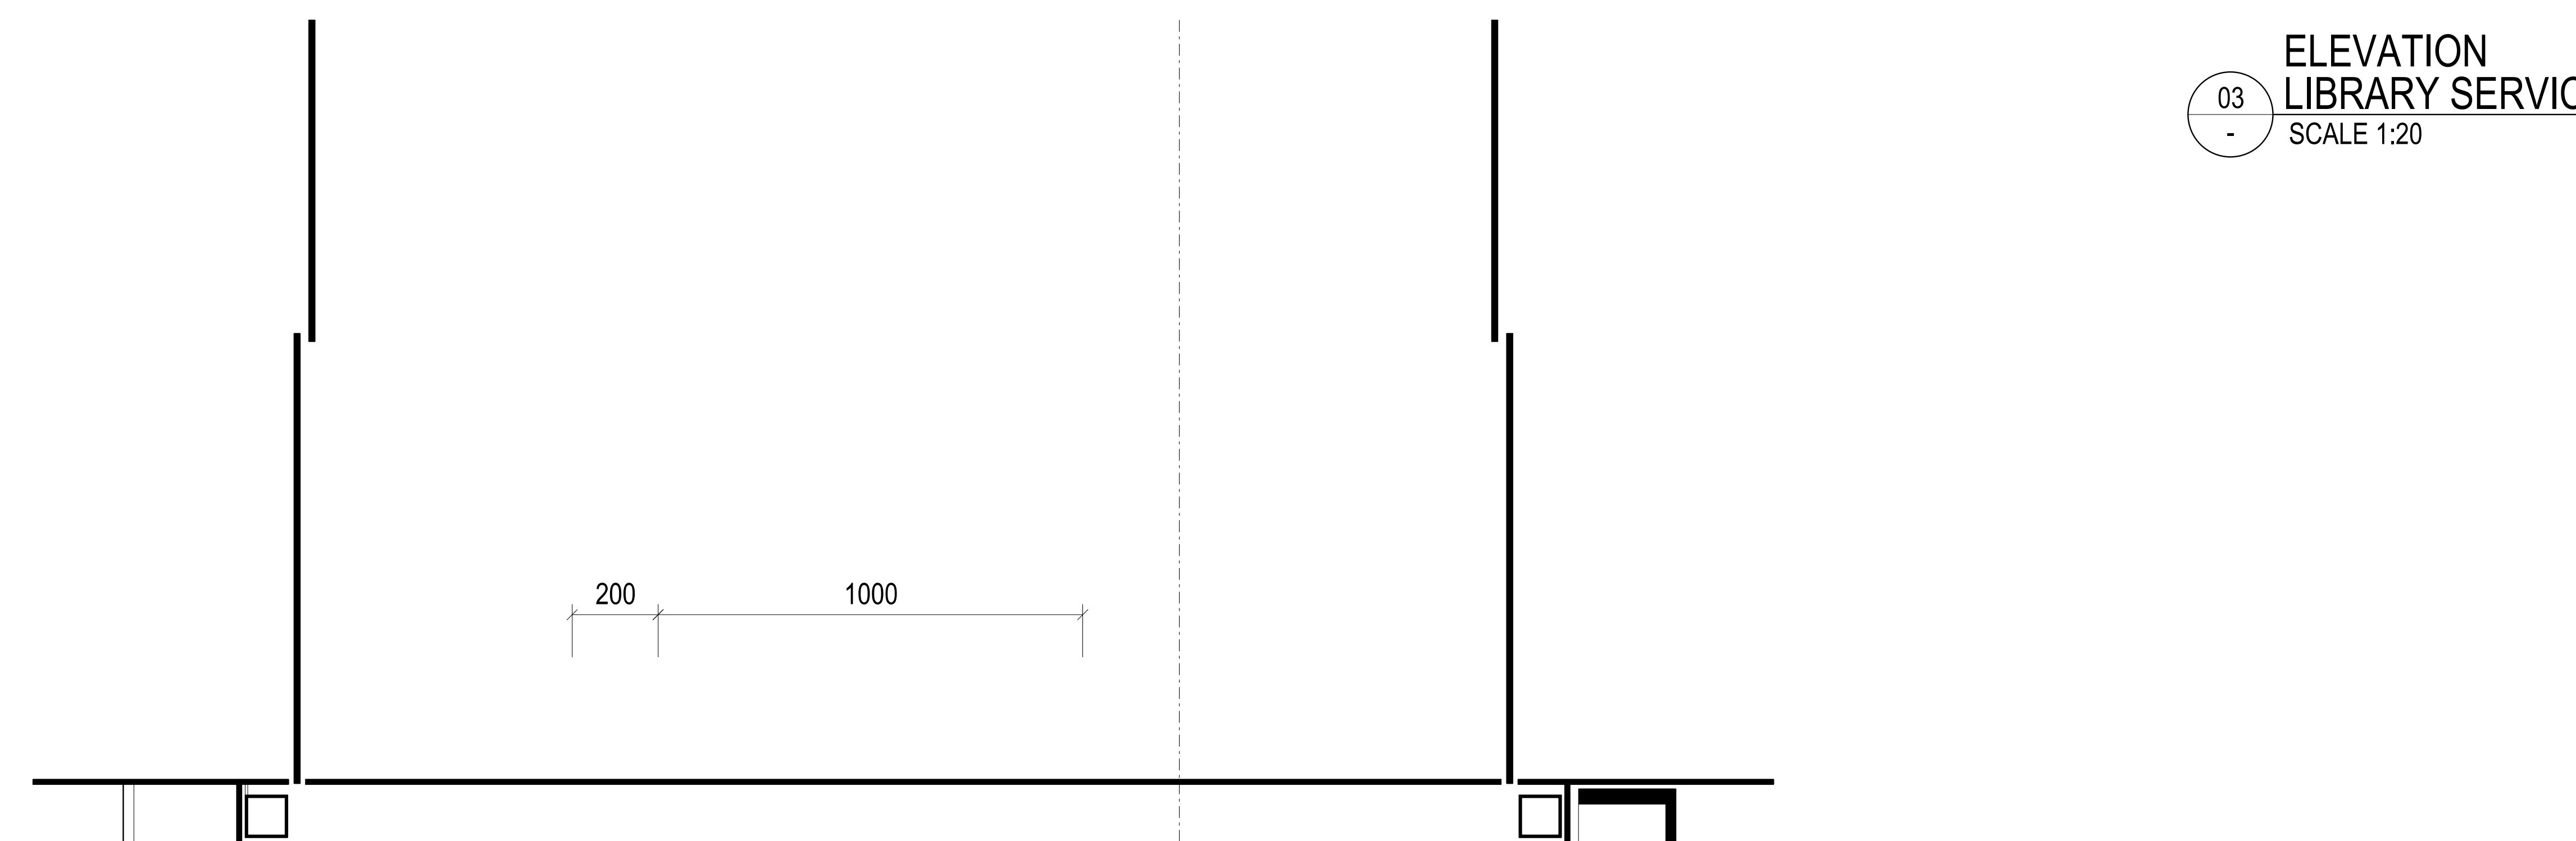


SERVICES DUCTED
FROM STEEL ENTRY
VESTIBULE WALL
VIA TRENCH DUCT

250 400 50

800

600 CLEAR
2000

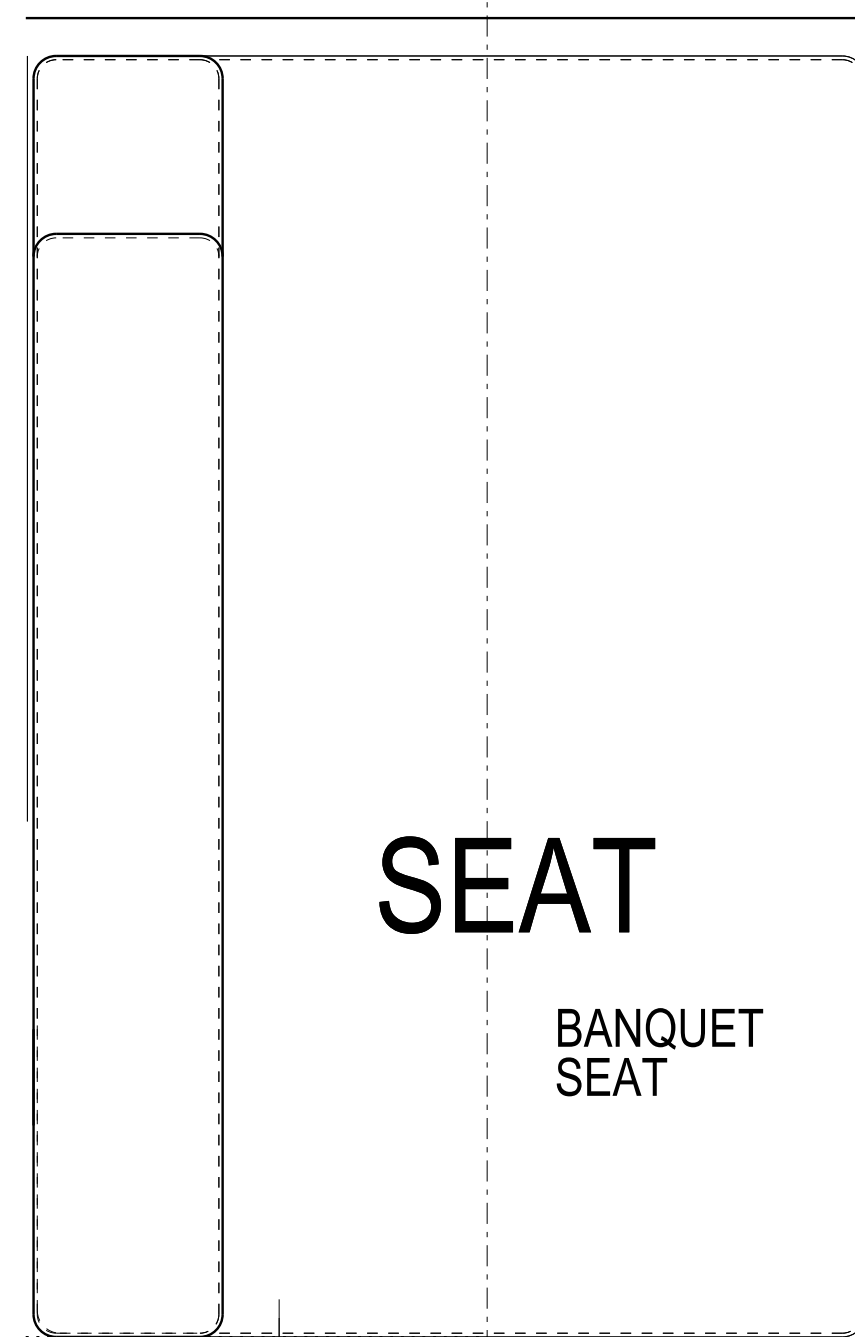

SEAT
BANQUET SEAT

CARPET TILE

DURESS ALARM UNDER
(BY OTHERS)

2-DRAWER
FILE PEDESTAL
UNDER WITH RECESSED
ACCESS BOX OVER

DESKTOP LIBRARY EQUIPMENT
AND PHONE BY OTHERS.
MONITOR ARM BY JOINER.


2-DRAWER
FILE PEDESTAL UNDER, WITH
RECESSED ACCESS BOX OVER.
CAVITY TO REAR FOR SERVICES RISING
FROM FLOOR TRENCH DUCT

DURESS ALARM UNDER
(BY OTHERS)

SIT STAND STOOLS

32MM THICK EDGE
ONLY, NO FASCIA

BANQUET SEAT

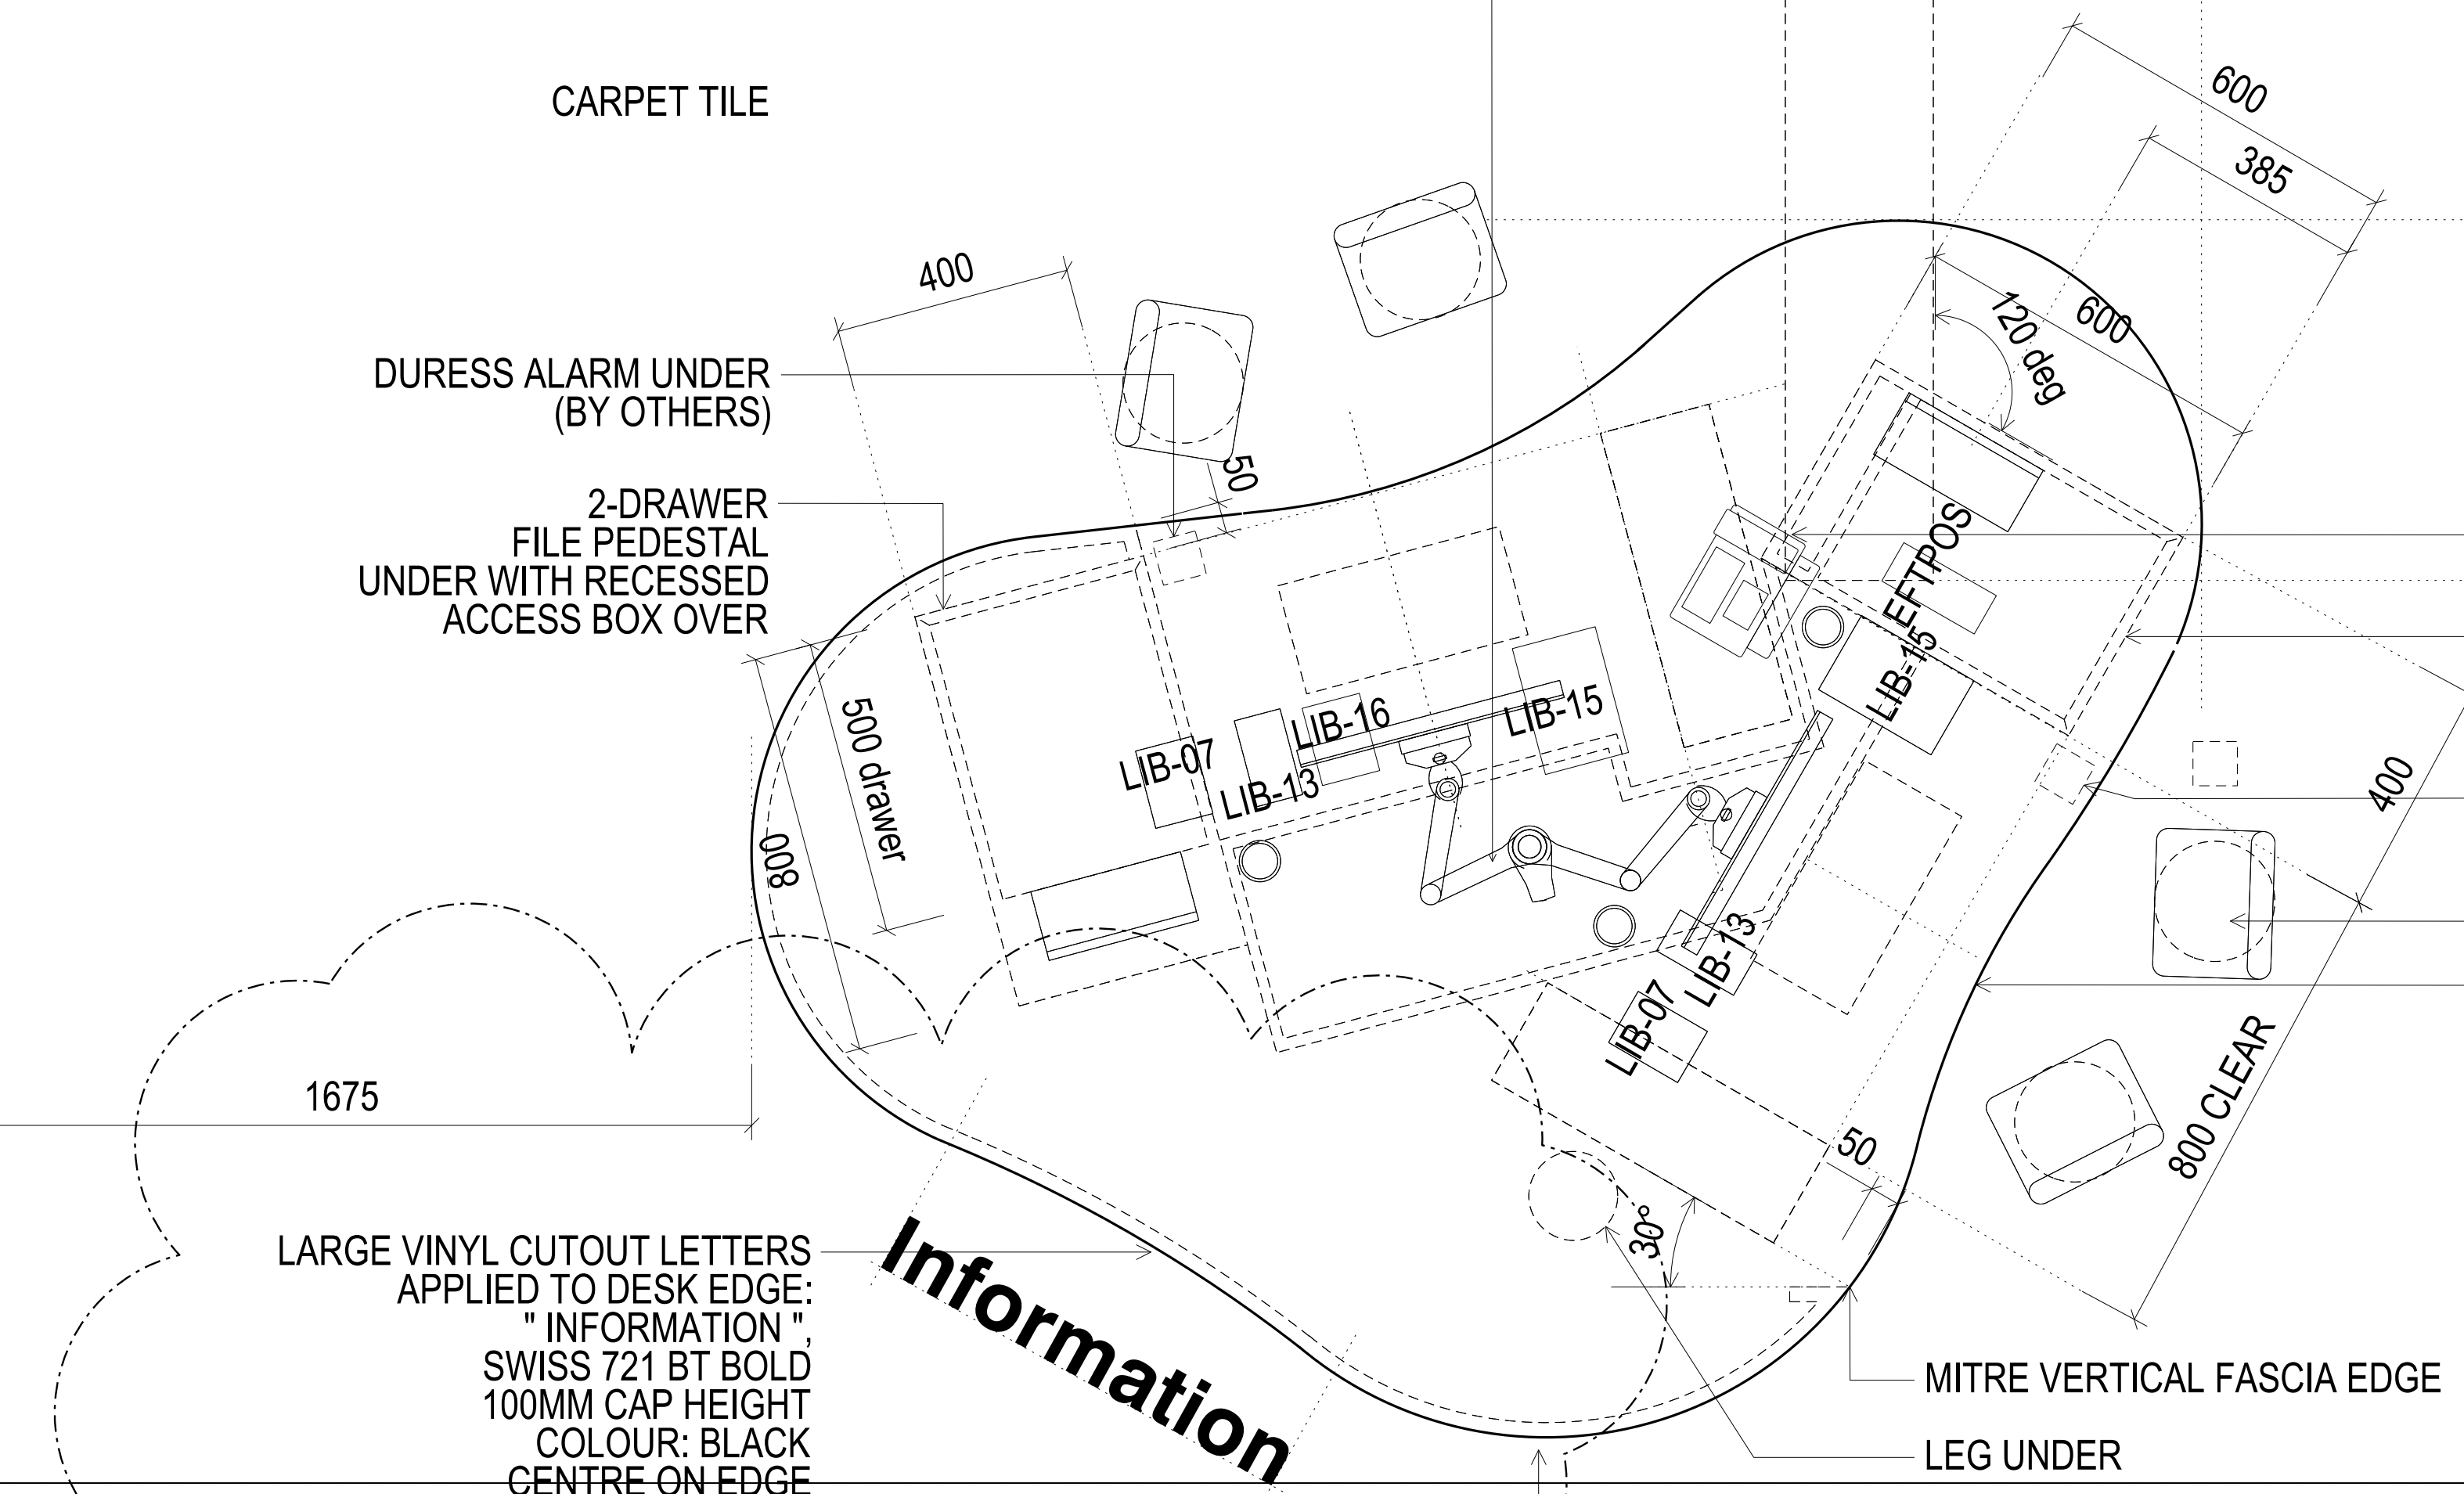

LARGE VINYL CUTOUT LETTERS
APPLIED TO DESK EDGE:
" INFORMATION "
SWISS 721 BT BOLD
100MM CAP HEIGHT
COLOUR: BLACK
CENTRE ON EDGE

Information

MITRE VERTICAL FASCIA EDGE

LEG UNDER

32MM ABS EDGE WITH 125MM DEEP
FASCIA BELOW. ALLOW FOR 80MM
HIGH LASER CUT VINYL SIGNAGE
DIRECT TO FASCIA

01
-
PLAN - JOG-02
LIBRARY SERVICE COUNTER
SCALE 1:20

Rev	Issue	Revision Description	Amd	Date
C	JA	ADJ. SIGNAGE	-	22.07.14
B	JA	ADD. EQUIPMENT	-	11.04.14
A	JA	FOR CONSTRUCTION	-	11.04.14



NADAAA
NADAAA
1920 Washington
Street No.2
Boston
Massachusetts
02118 USA
Telephone
+1 617 462 6232
Facsimile
+1 855 442 1417
Email
nad@nadaaa.com

John Wardle
Architects
25 Rokeby Street, Collingwood, Victoria 3066 Australia
Tel : +61 3 8662 0400 www.johnwardlearchitects.com
© 2014 John Wardle Architects ABN 83 006 814 268

Client
University of Melbourne
Parkville Campus

Project
Faculty of Architecture
Building and Planning

Title
AMENDED LIBRARY
SERVICE DESK

Project No.	0913	Scale	1:20 @ A0 1:20 @ A2
Drawing No.	AR8265	Revision	B
Date	Dec 2011	Drawn	Co-Ord
		Chk	

