


CONTRACTORS SHALL VERIFY JOB DIMENSIONS BEFORE ANY JOB COMMENCES. ALL SHOP DRAWINGS SHALL BE SUBMITTED TO THE SUPERINTENDENT AND MANUFACTURER SHALL NOT COMMENCE PRIOR TO THE RETURN OF DIMENSIONED SHOP DRAWINGS REVIEWED BY THE CONSULTANT. DIMENSIONS SHALL TAKE PRECEDENCE OVER SCALES. THIS DRAWING SHALL BE READ IN CONJUNCTION WITH ALL RELEVANT CONTRACT SPECIFICATIONS AND DRAWINGS COPYRIGHT OF THIS DRAWING IS VESTED IN WARDLE.

General Notes

REFER ARCHITECTURAL DRAWINGS:

- FAÇADE SETOUT AR1502-AR1507
- PRECAST SETOUT AR1512-AR1517
- SCREEN SETOUT AR1502-AR1557
- SCREEN DETAILS AR6550-AR6554

Rev	Issue	Revision Description	And	Date
B	KW	SEATING WALL DETAIL UPDATED	-	20.01.14
A	SG	ISSUE FOR CONSTRUCTION	-	20.09.13
06	SG	TENDER ISSUE	-	16.04.13
05	SG	VALUE MANAGEMENT ISSUE	-	28.03.13
04	SG	PRECAST REVIEW	-	21.03.13
03	SG	100% CD - TENDER ISSUE	-	07.09.12
02	SG	90% CD ISSUE	-	10.08.12
01	SG	75% CD ISSUE	-	13.07.12

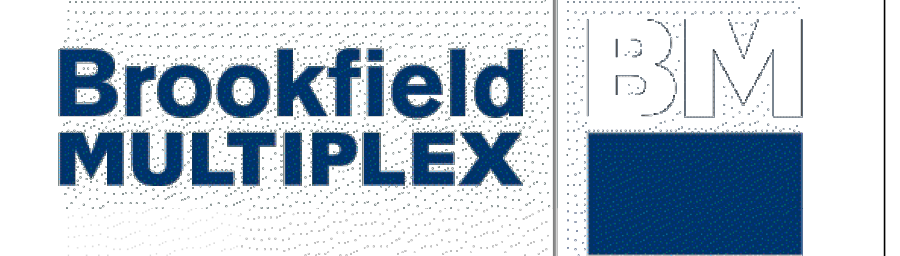

**NADAAA**  
 NADAAA  
 1520 Washington Street No.2 Boston Massachusetts 02118 USA  
 Telephone +1 617 442 8232 Facsimile +1 688 442 1417 Email nadaaa@nadaaa.com

**John Wardle Architects**  
 25 Rokeby Street, Collingwood, Victoria 3066 Australia  
 Tel: +61 3 8662 0400 www.johnwardlearchitects.com  
 © 2012 John Wardle Architects ABN 83 006 814 268

Client **University of Melbourne Parkville Campus**

Project **Faculty of Architecture Building and Planning**


Title **SECTION DETAILS SHEET 11**

Project No.	<b>0913</b>	Scale	1:10 @ A0 1:20 @ A2
Drawing No.	<b>AR6110</b>	Revision	<b>B</b>


Date: Dec 2011 Dwn - Co-Ord - Chk -

FILENAME - SFILES


**FOR CONSTRUCTION**

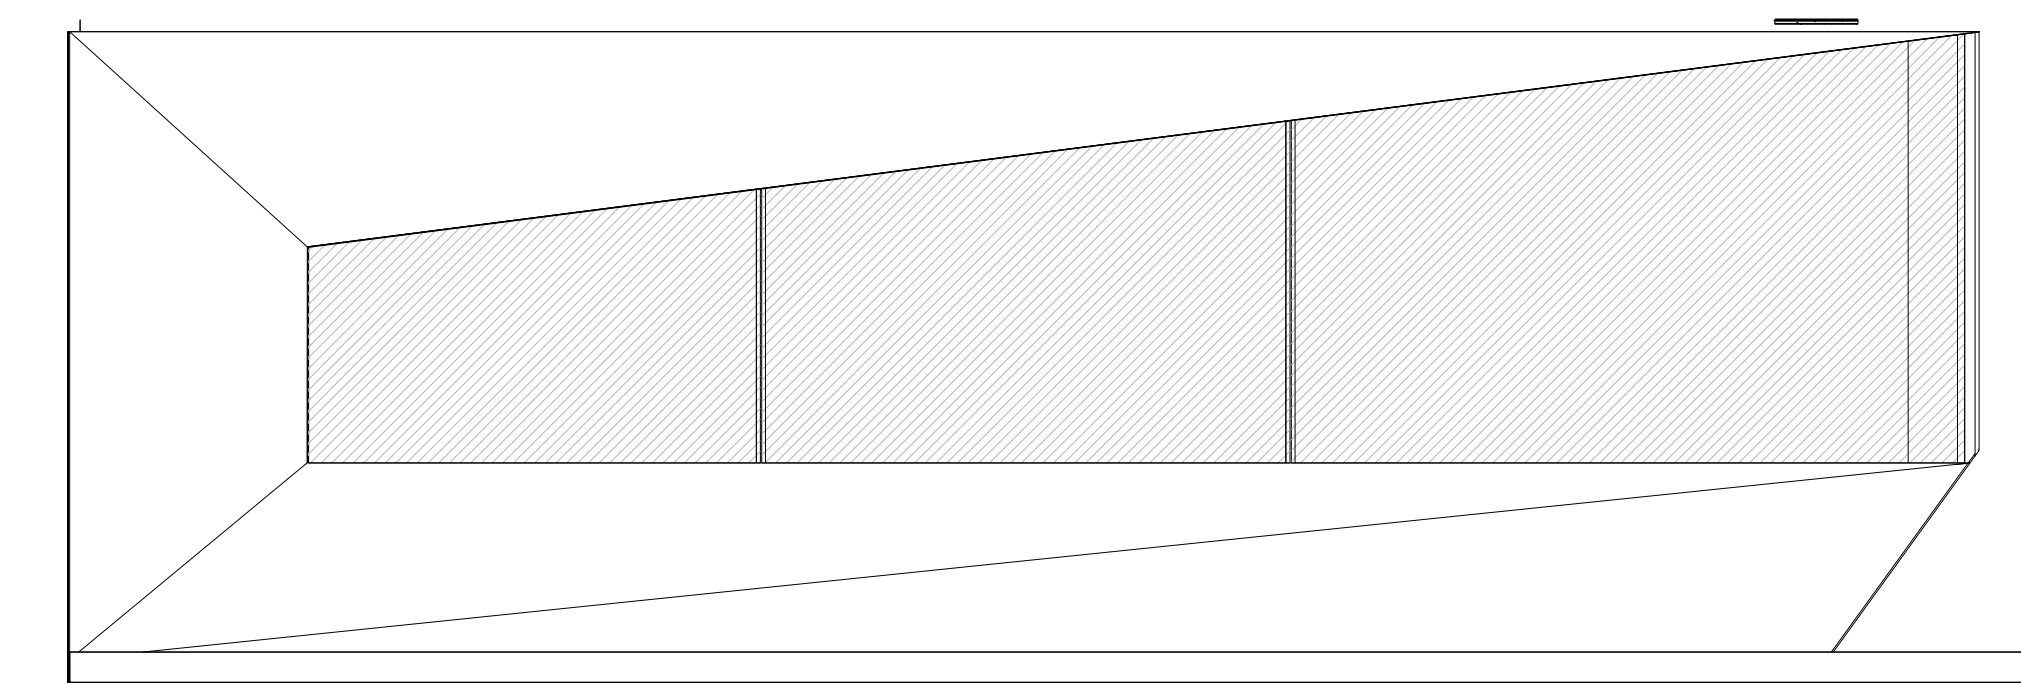

FS-18 ELEVATION  
SCALE 1:50

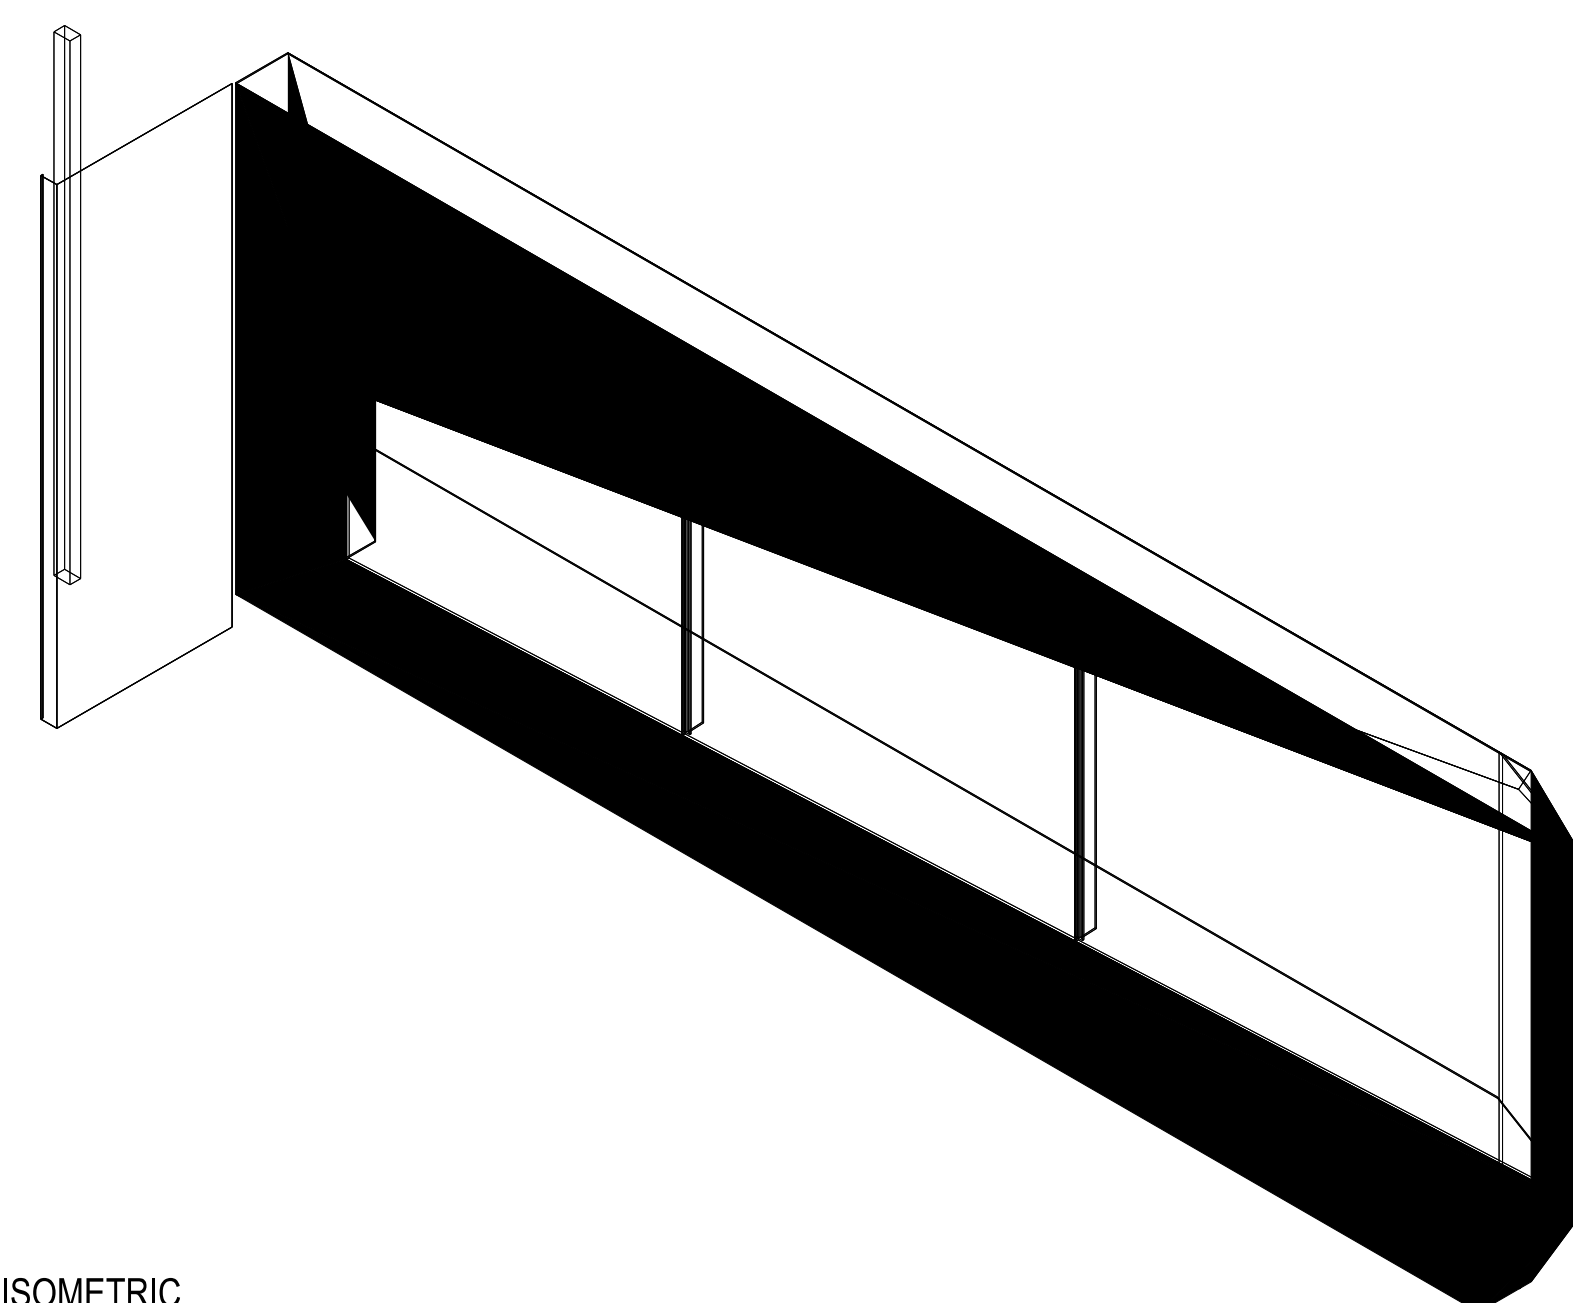

FS-18 ISOMETRIC  
SCALE 1:50

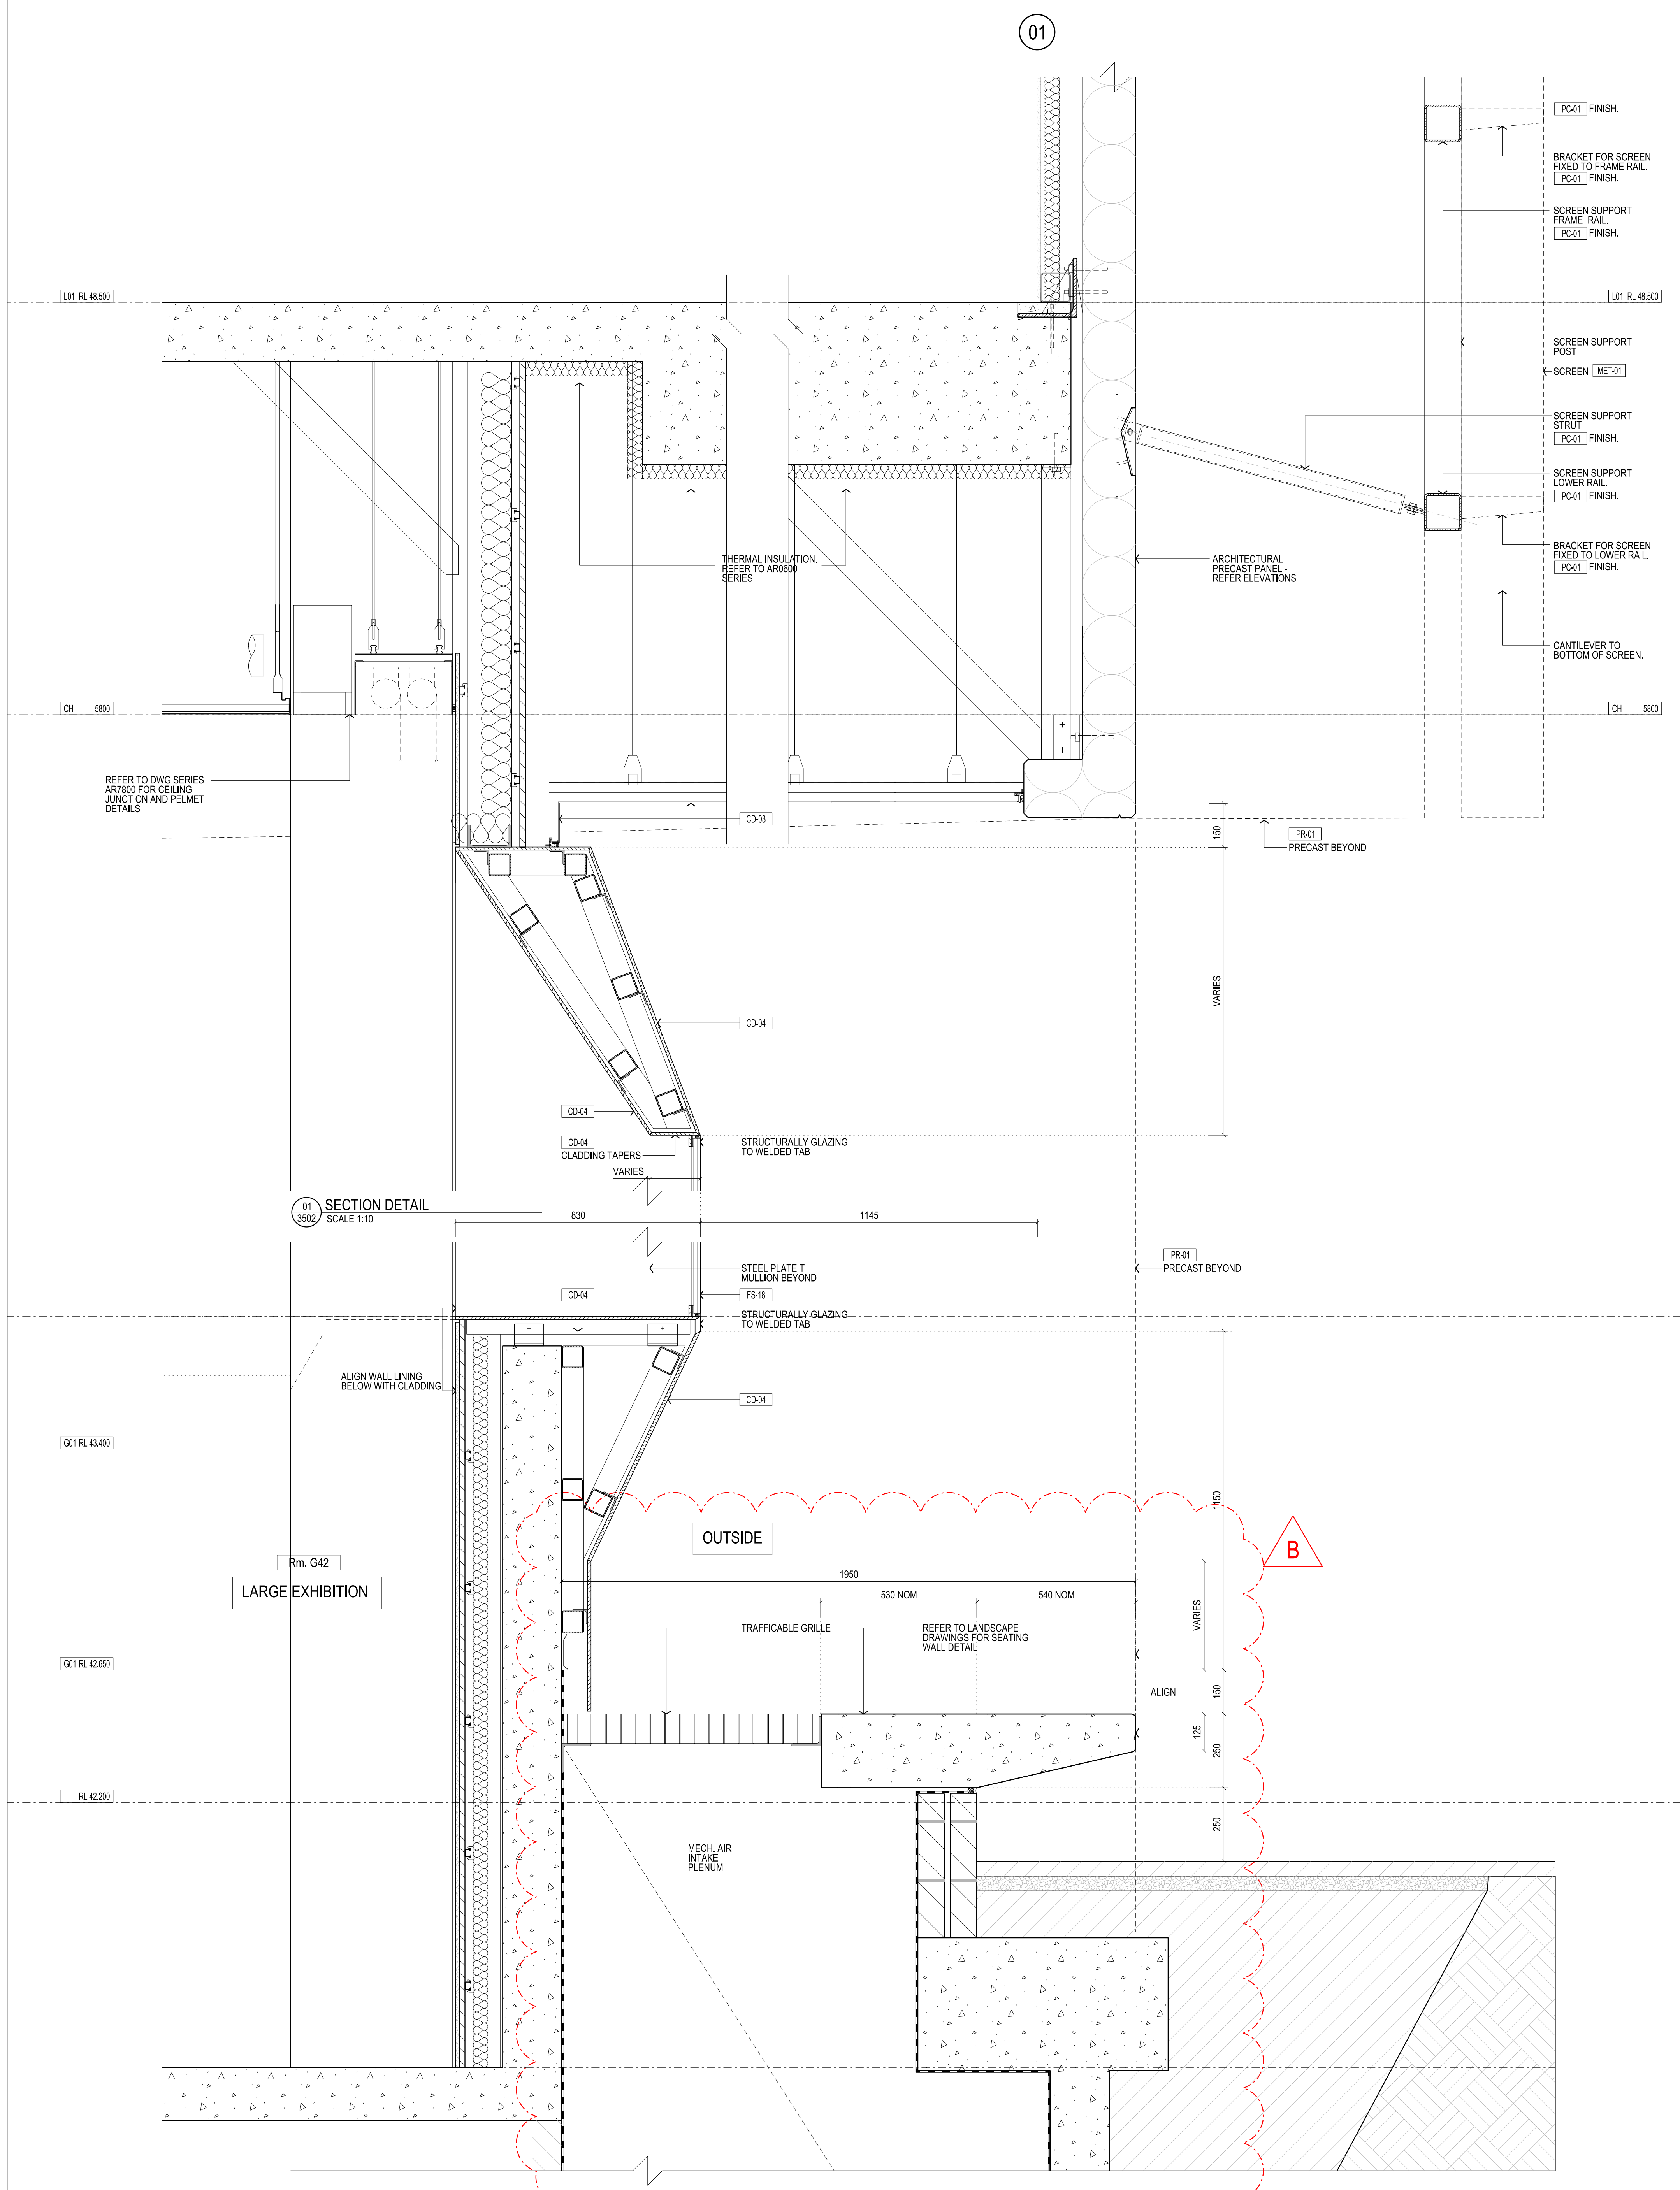

SECTION DETAIL  
SCALE 1:10

SECTION DETAIL  
SCALE 1:10

Rm. G42  
LARGE EXHIBITION

RL 43.400

RL 42.850

RL 42.200

RL 43.850

TOP OF WALL

RL 43.400

RL 42.850

RL 42.200