



THIS DRAWING IS AN UNCONTROLLED COPY UNLESS STAMPED OTHERWISE  
CONTRACTORS SHALL VERIFY JOB DIMENSIONS BEFORE ANY JOB COMMENCES.  
ALL DRAWINGS ARE THE PROPERTY OF THE CONTRACTOR AND THE MANUFACTURER.  
SHALL NOT COMMENCE PRIOR TO THE RETURN OF UNAMENDED SHOP DRAWINGS SIGNED  
BY THE CONTRACTOR AND THE MANUFACTURER. THIS DRAWING IS THE PROPERTY OF THE  
DRAWING SHOULD BE READ IN CONJUNCTION WITH ALL RELEVANT CONTRACT SPECIFICATIONS  
AND DRAWINGS COPY-NIGHT OF THIS DRAWING IS VESTED IN THE CONTRACTOR.

General Notes & Legend


03 SG REVISED PATTERN #5, ADDITION OF PATTERN #7	-	27.06.13
02 SG ADDITION OF PERFORATION PATTERN #5	-	07.06.13
01 SG ISSUE FOR TENDER	-	05.06.13
Rev Issue	Revision Description	Amd Date
[Blank grid area]		
03 SG REVISED PATTERN #5, ADDITION OF PATTERN #7 - 27.06.13		
02 SG ADDITION OF PERFORATION PATTERN #5 - 07.06.13		
01 SG ISSUE FOR TENDER - 05.06.13		
Rev Issue Revision Description Amd Date		
NADA NADA 1020 Washington Street No.2 Boston Massachusetts 02118 USA Telephone +1 617 442 6232 Facsimile +1 888 442 1417 Email nada@nadasa.com		
John Wardle Architects + NADA John Wardle Architects 25 Rokeby Street, Collingwood, Victoria 3066 Australia Tel: +61 3 8662 0400 www.johnwardlearchitects.com © 2012 John Wardle Architects ABN 83 006 814 268		
Client University of Melbourne Parkville Campus Project Faculty of Architecture Building and Planning Title METALWORK DETAILS EXTERNAL SCREENS - PATTERN 1,4,5,7		
0913	Scale 1:10 @ A0	Project No.
SK471	Scale 1:20 @ A2	Drawing No.
03	Revision 03	Revision
Date Dec 2011	Drawn -	Co-Ord -
		Check -
TENDER ISSUE		

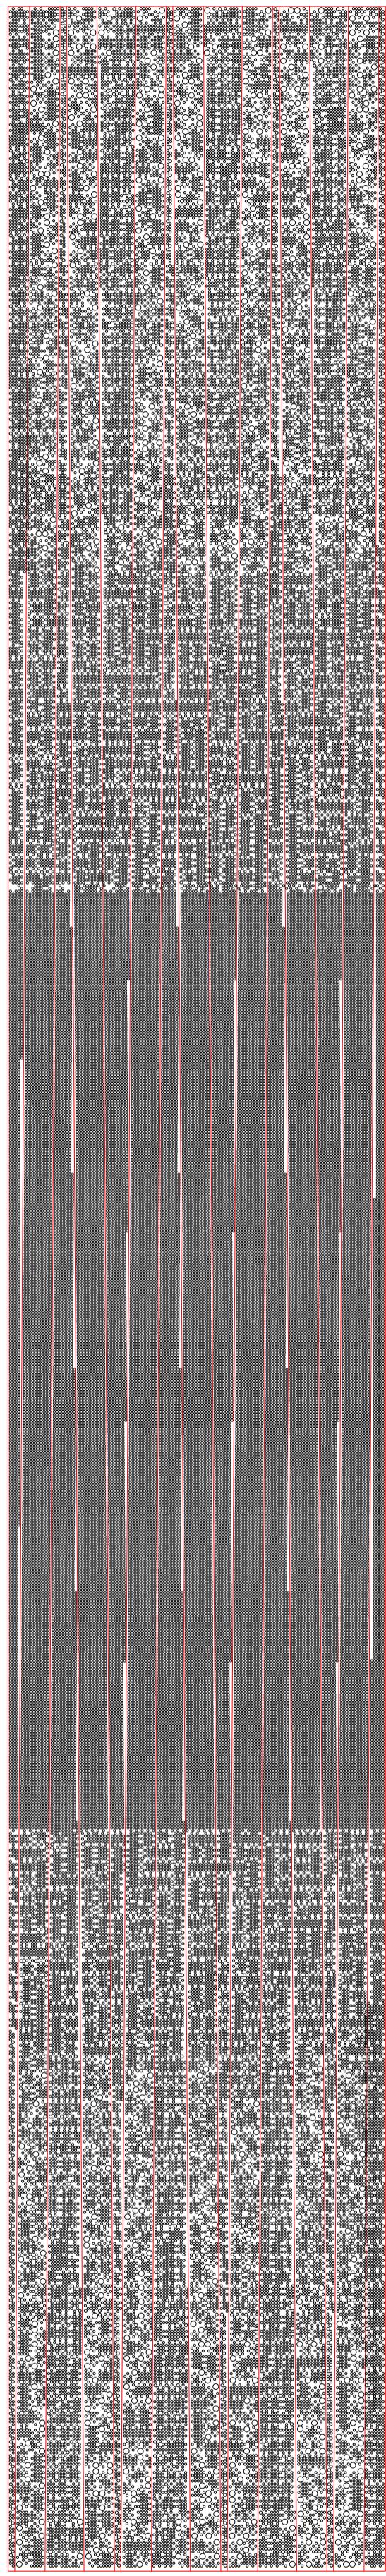


1 PERFORATION PATTERN NO.1  
SCALE 1:10

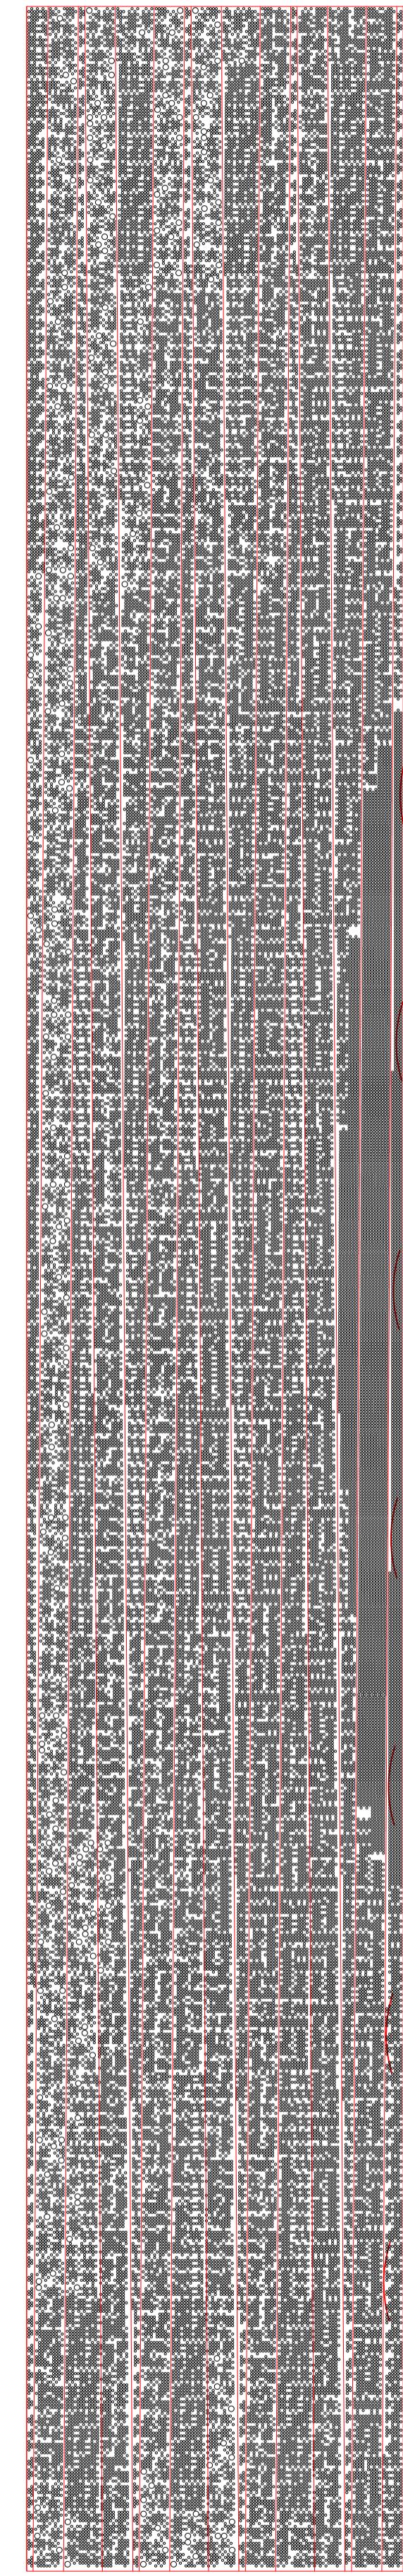

2 PERFORATION PATTERN NO.4  
SCALE 1:10

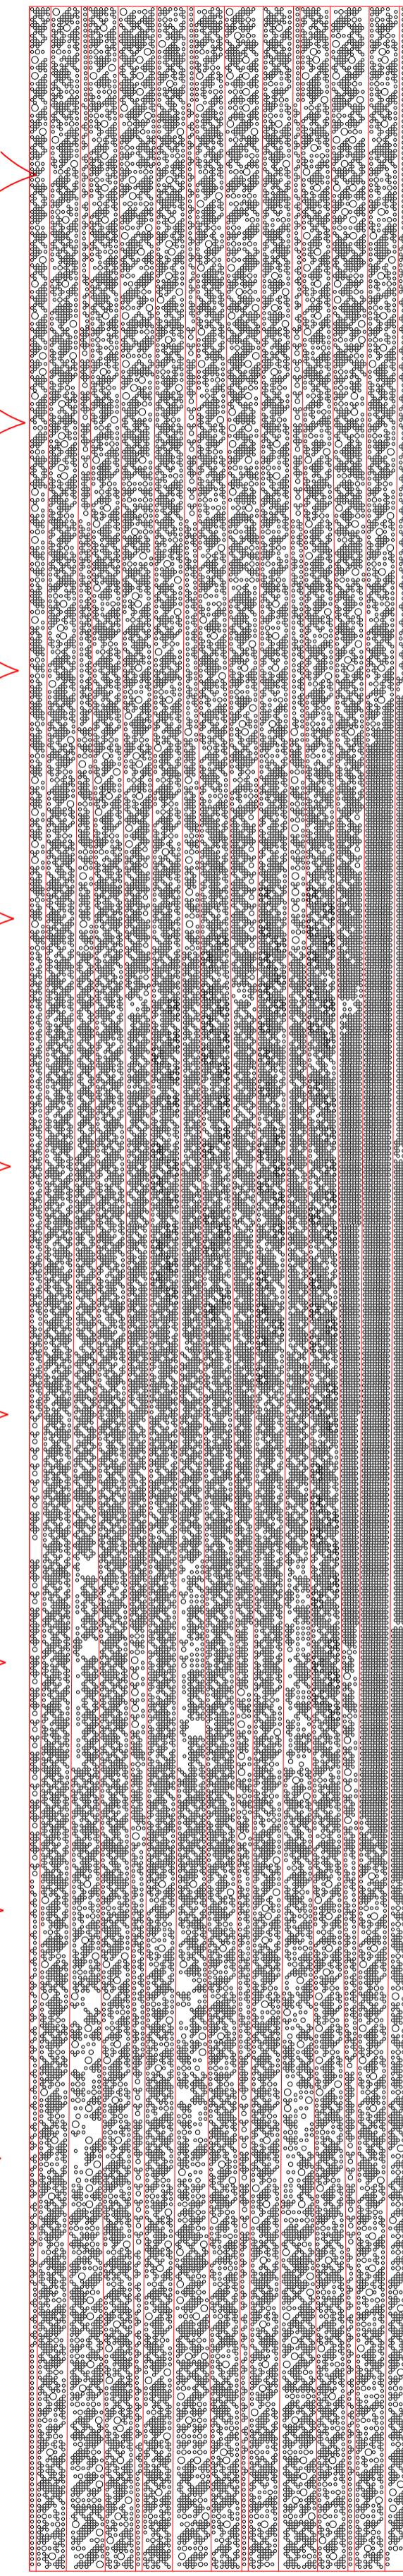

3 PERFORATION PATTERN NO.5  
SCALE 1:10

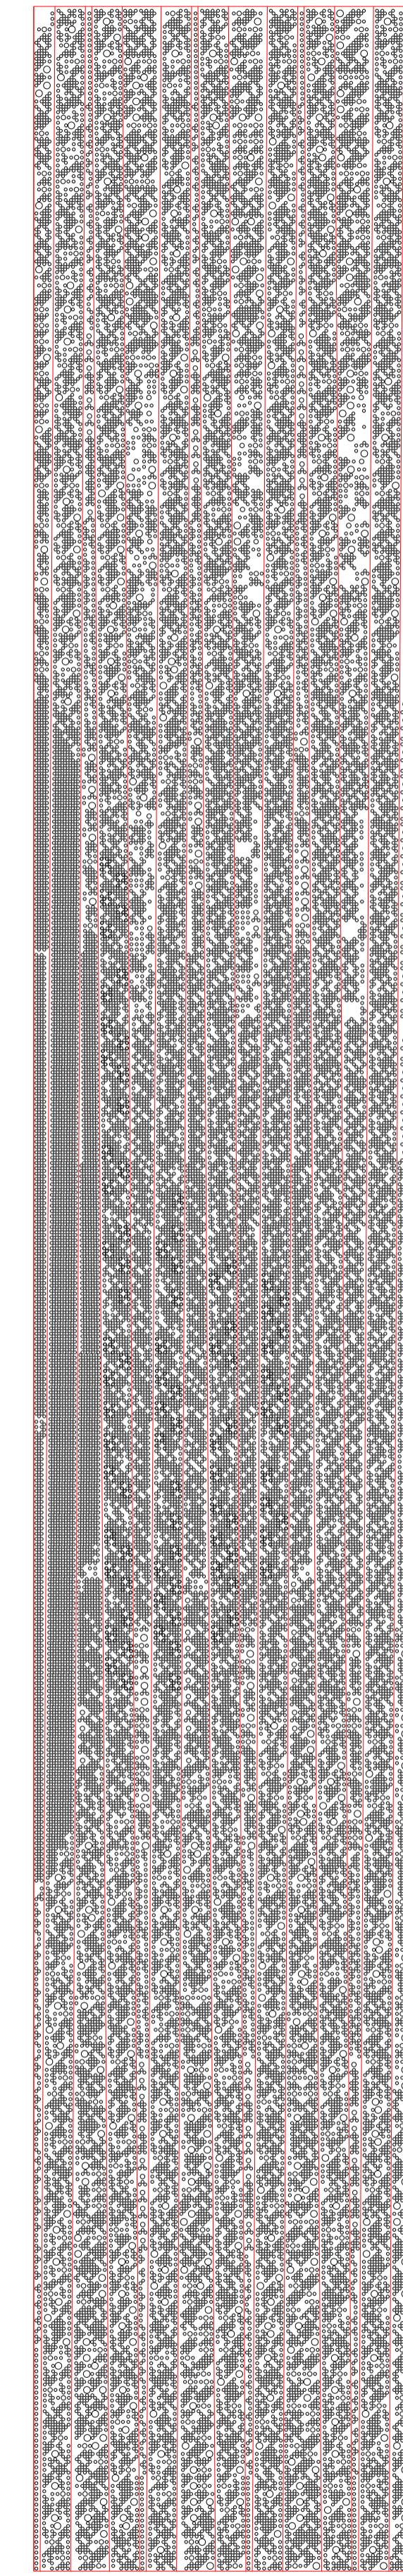

4 PERFORATION PATTERN NO.7  
SCALE 1:10

5 CLUSTER RANGE FOR PERFORATION PATTERNS 1, 4 & 5  
SCALE 1:1

03

John Wardle Architects + NADA

TYPE	A	B	C	D	E	F	G	H	I	J	K	L	M	N
PATTERN														
PATTERN/ARC														
ARC														