

CONTRACTORS SHALL VERIFY JOB DIMENSIONS BEFORE ANY JOB COMMENCES. ALL SHOP DRAWINGS SHALL BE SUBMITTED TO THE SUPERINTENDENT AND MANUFACTURER SHALL NOT COMMENCE FROM THE RETURN OF DIMENSIONS SHOP DRAWINGS ISSUED BY THE CONSULTANT. FURNISHED DIMENSIONS SHALL TAKE PRECEDENCE OVER SCALES. THIS DRAWING SHALL BE READ IN CONJUNCTION WITH ALL RELEVANT CONTRACT SPECIFICATIONS AND DRAWINGS COPYRIGHT OF THIS DRAWING IS VESTED IN WARDLE.

General Notes

Rev	Issue	Revision Description	And	Date
B	SG	UPDATES AS CLOUDED	-	21.01.14
A	SG	UPDATES AS CLOUDED	-	16.12.13
02	SG	100% CD - TENDER ISSUE	-	07.09.12
01	SG	90% CD ISSUE	-	10.08.12



NADAAA
 NADAAA
 1020 Washington Street No.2 Boston Massachusetts 02118 USA
 Telephone: +1 617 442 8232
 Facsimile: +1 688 442 1417
 Email: nad@nadaaa.com

John Wardle Architects
 25 Rokeby Street, Collingwood, Victoria 3066 Australia
 Tel: +61 3 8662 0400 www.johnwardlearchitects.com
 © 2014 John Wardle Architects ABN 83 006 814 268

Client: University of Melbourne Parkville Campus

Project: Faculty of Architecture Building and Planning


Title: INTERNAL PLAN DETAILS B01 - SHEET 3

Project No.	0913	Scale	1:10 @ A0 1:20 @ A2
Drawing No.	AR 7702	Revision	B

Date: Jul 2012 Dwn: Co-Ord: Chk:

FILENAME - \$FILES

FOR CONSTRUCTION

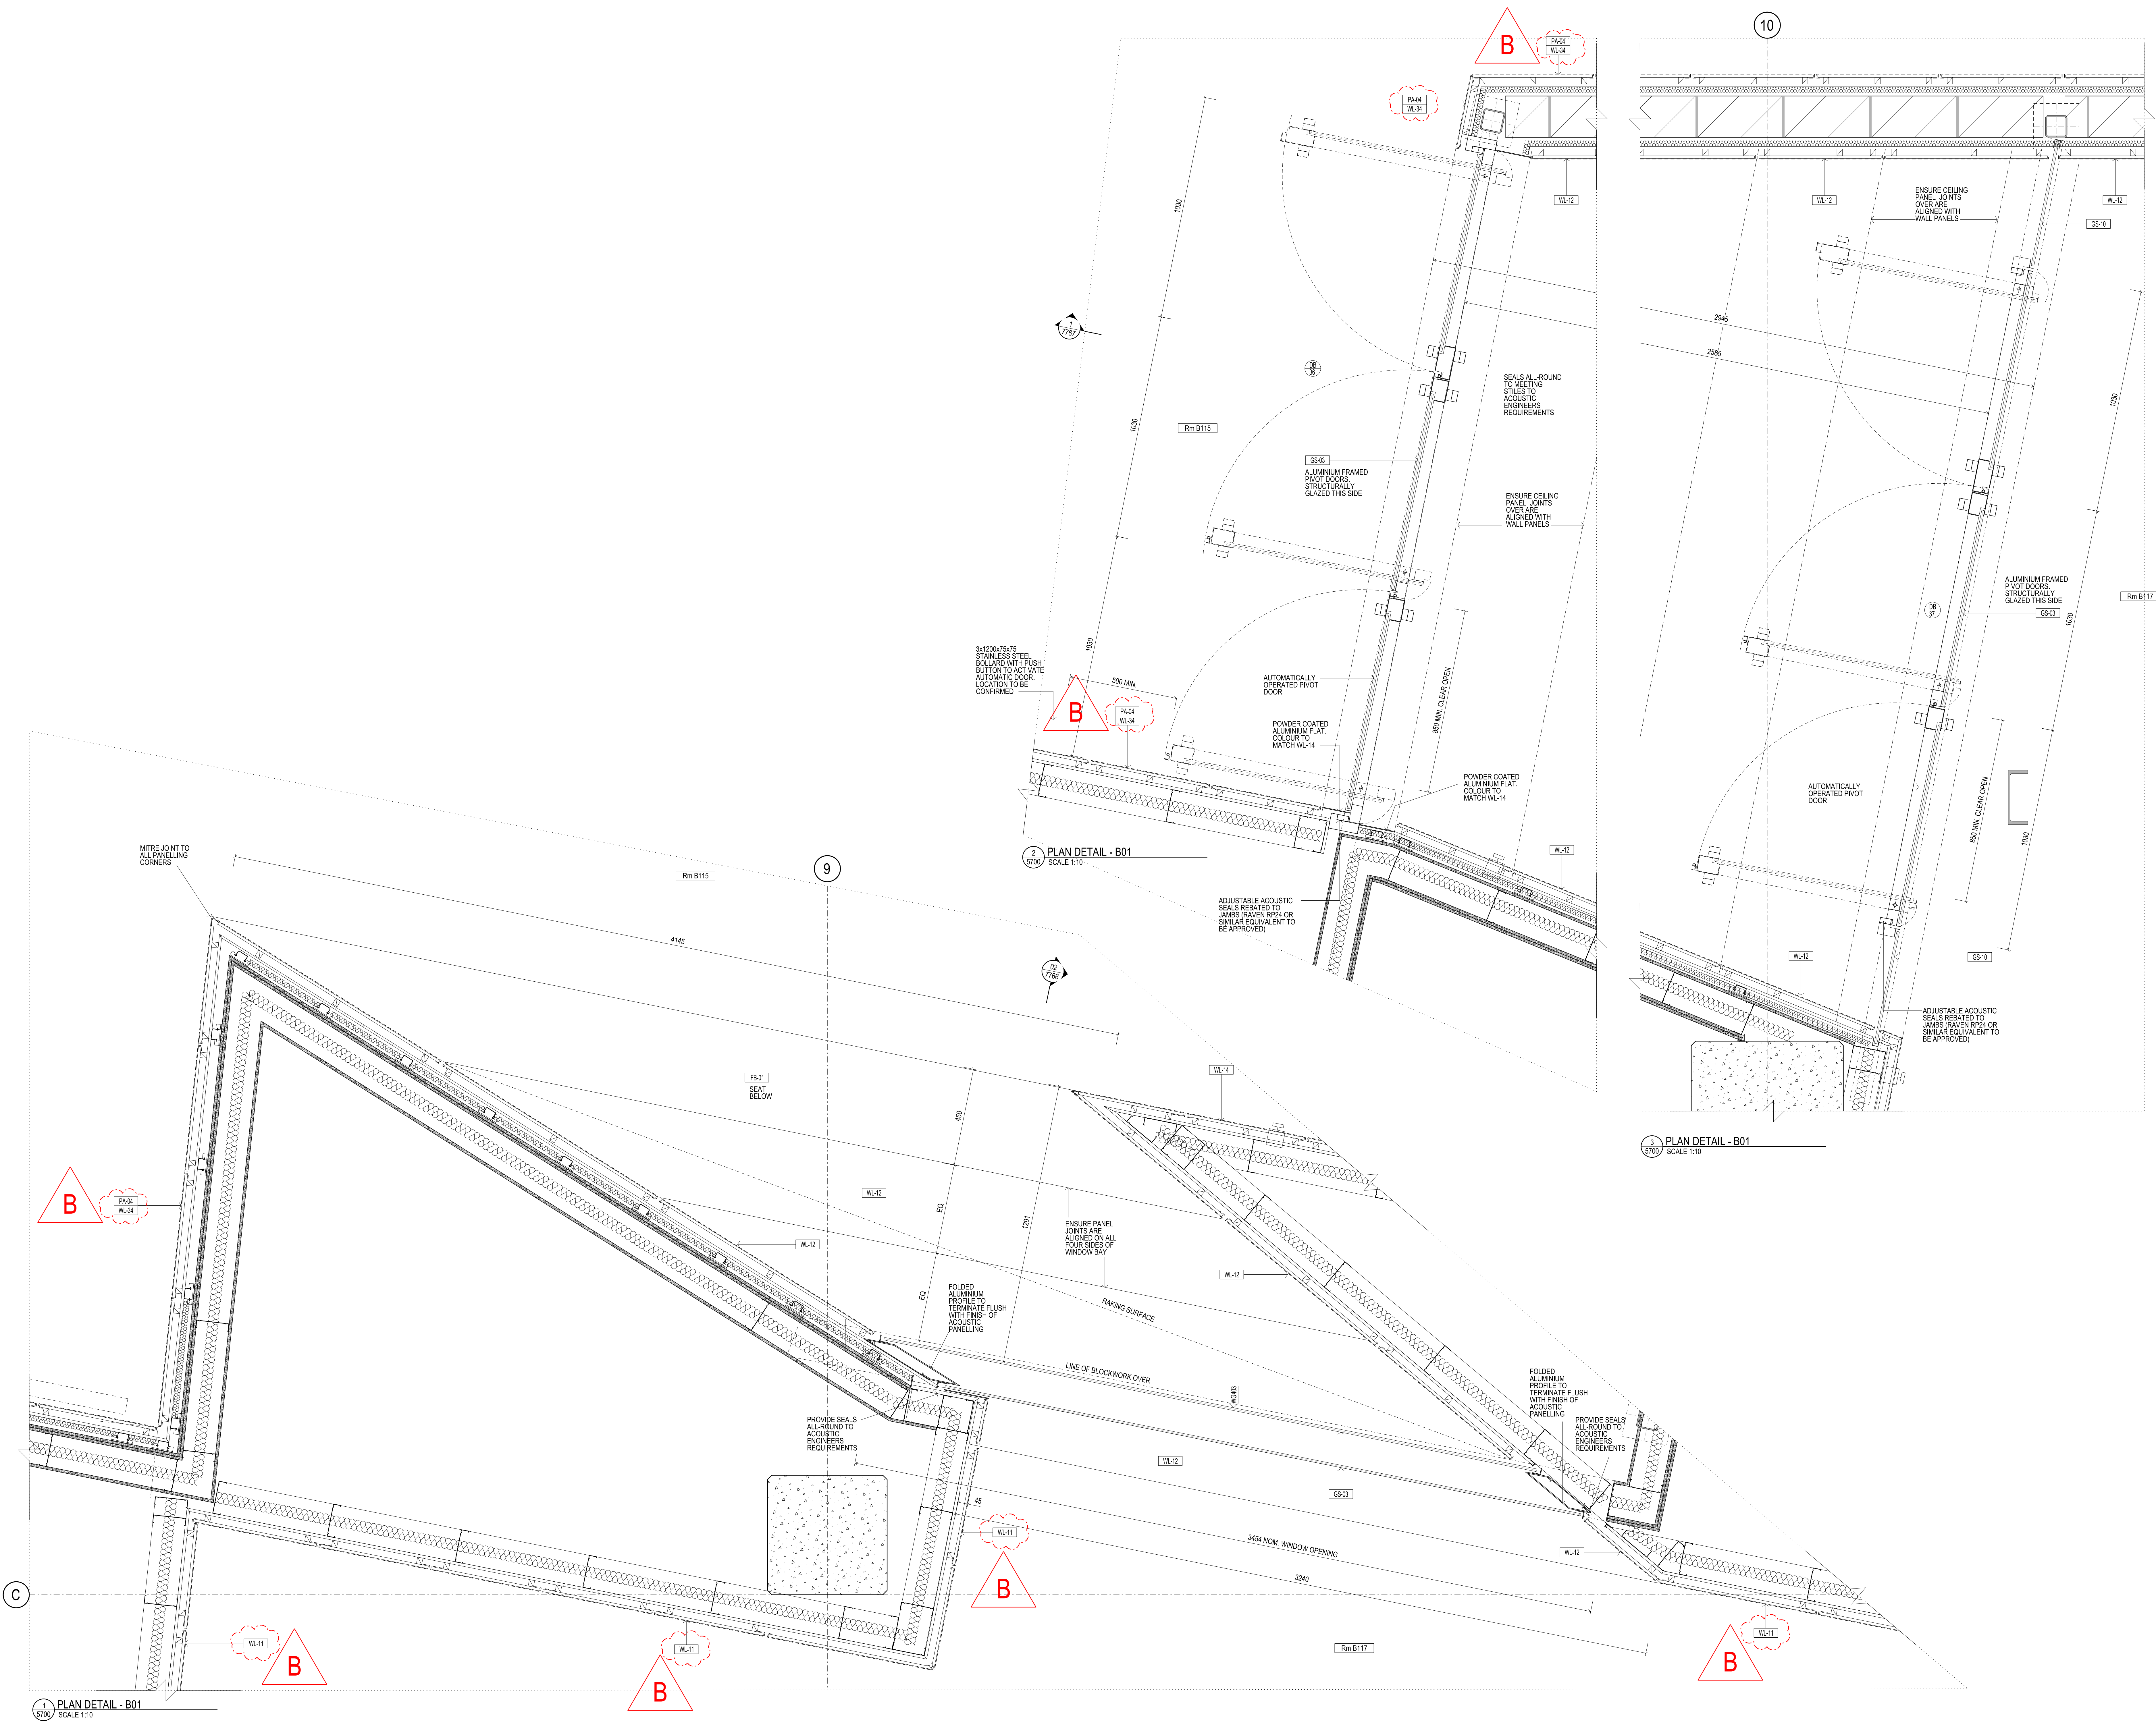

1 PLAN DETAIL - B01
SCALE 1:10

2 PLAN DETAIL - B01
SCALE 1:10

3 PLAN DETAIL - B01
SCALE 1:10