


02 / 1503 DEANS OFFICE WEST
SCALE 1:50

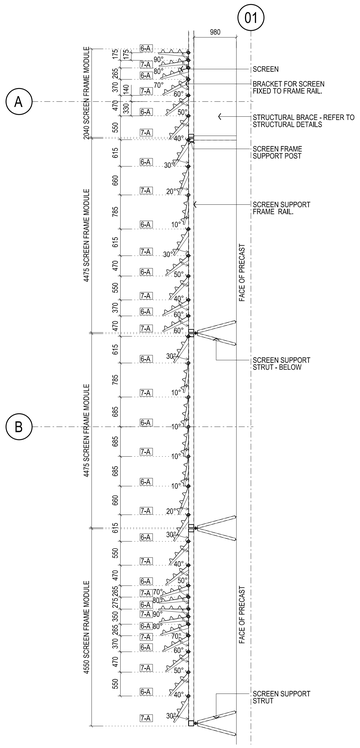


01 / 1503 LARGE SEMINAR ROOM WEST
SCALE 1:50

THIS DRAWING IS AN UNCONTROLLED COPY UNLESS STAMPED OTHERWISE

CONTRACTORS SHALL VERIFY JOB DIMENSIONS BEFORE ANY JOB COMMENCES. ALL SHOP DRAWINGS SHALL BE SUBMITTED TO THE SUPERINTENDENT AND MANUFACTURE SHALL NOT COMMENCE PRIOR TO THE RETURN OF UNAMENDED SHOP DRAWINGS SIGNED BY THE CONSULTANT. FIGURED DIMENSIONS SHALL TAKE PRECEDENCE OVER SCALED. THIS DRAWING SHOULD BE READ IN CONJUNCTION WITH ALL RELEVANT CONTRACT, SPECIFICATIONS AND DRAWINGS COPYRIGHT OF THIS DRAWING IS VESTED IN WARDLE

General Notes

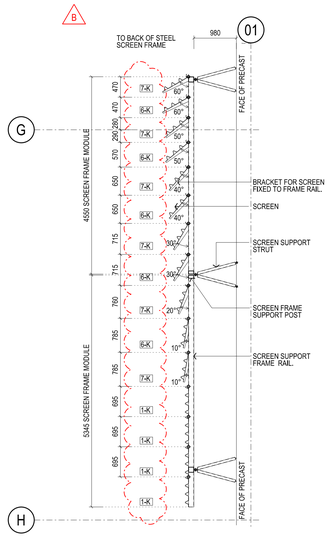**REFER ARCHITECTURAL DRAWINGS:**

| | |
|---|---|
| FACADE SETOUT | AR1502-AR1507 |
| PRECAST SETOUT | AR1512-AR1517 |
| SCREEN SETOUT | AR1552-AR1557 |
| SCREEN DETAILS | AR6550-AR6554 |

PERFORATION PATTERN NO. REFER AR6551
PANEL HEIGHT AND PERFORATION SETOUT. REFER AR6550
T-31 SCREEN TYPE

| Rev | Issue | Revision Description | Amd | Date |
|---|---|---|---|---|
| B | SG | L01 SOUTH WEST SCREENS EXTENDED | - | 13.12.13 |
| A | SG | ISSUED FOR CONSTRUCTION | - | 04.09.13 |
| 04 | SG | VALUE MANAGEMENT ISSUE | - | 28.03.13 |
| 03 | SG | 100% CD - TENDER ISSUE | - | 07.09.12 |
| 02 | SG | 90% CD ISSUE | - | 10.08.12 |
| 01 | SG | 75% CD ISSUE | - | 13.07.12 |

Brookfield MULTIPLEX

NADAAA

NADAAA
1920 Washington Street No.2
Boston Massachusetts
02118 USA

Telephone +1 617 442 6232
Facsimile +1 888 442 1417
Email nada@nadaaa.com

John Wardle Architects

25 Rokeby Street, Collingwood, Victoria 3066 Australia
Tel : +61 3 8662 0400 www.johnwardlearchitects.com
© 2012 John Wardle Architects ABN 83 006 814 268

Client
University of Melbourne
Parkville Campus

Project
Faculty of Architecture
Building and Planning

Title
EXTERNAL SCREEN SETOUT PLAN
LEVEL 01

| | | |
|---|---|---|
| Project No. 0913 | | Scale 1:50 @ A0 |
| Drawing No. AR1553 | | Revision B |
| Date July 2012 | Drwn - | Co-Ord - | Chck - |

FILENAME - $FILE$

FOR CONSTRUCTION