


CONTRACTORS SHALL VERIFY DIMENSIONS BEFORE ANY JOB COMMENCES. ALL SHOP DRAWINGS SHALL BE SUBMITTED TO THE SUPERINTENDENT AND MANUFACTURERS SHALL NOT COME FROM TO THE RETURN OF DIMENSIONS SHOWN IN THE DRAWING. DIMENSIONS SHALL TAKE PRECEDENCE OVER SCALES. THIS DRAWING SHALL BE READ IN CONJUNCTION WITH ALL RELEVANT CONTRACT, SPECIFICATIONS AND DRAWINGS COPYRIGHT OF THIS DRAWING IS VESTED IN NADAAA.

General Notes

REFER ARCHITECTURAL DRAWINGS:  
 FACADE SETOUT AR1502-AR1507  
 PRECAST SETOUT AR1512-AR1517  
 SCREEN SETOUT AR1552-AR1557  
 SCREEN DETAILS AR8550-AR8554

PERFORATION PATTERN NO. REFER AR6051  
 PANEL HEIGHT AND PERFORATION SETOUT. REFER AR6050  
 SCREEN TYPE

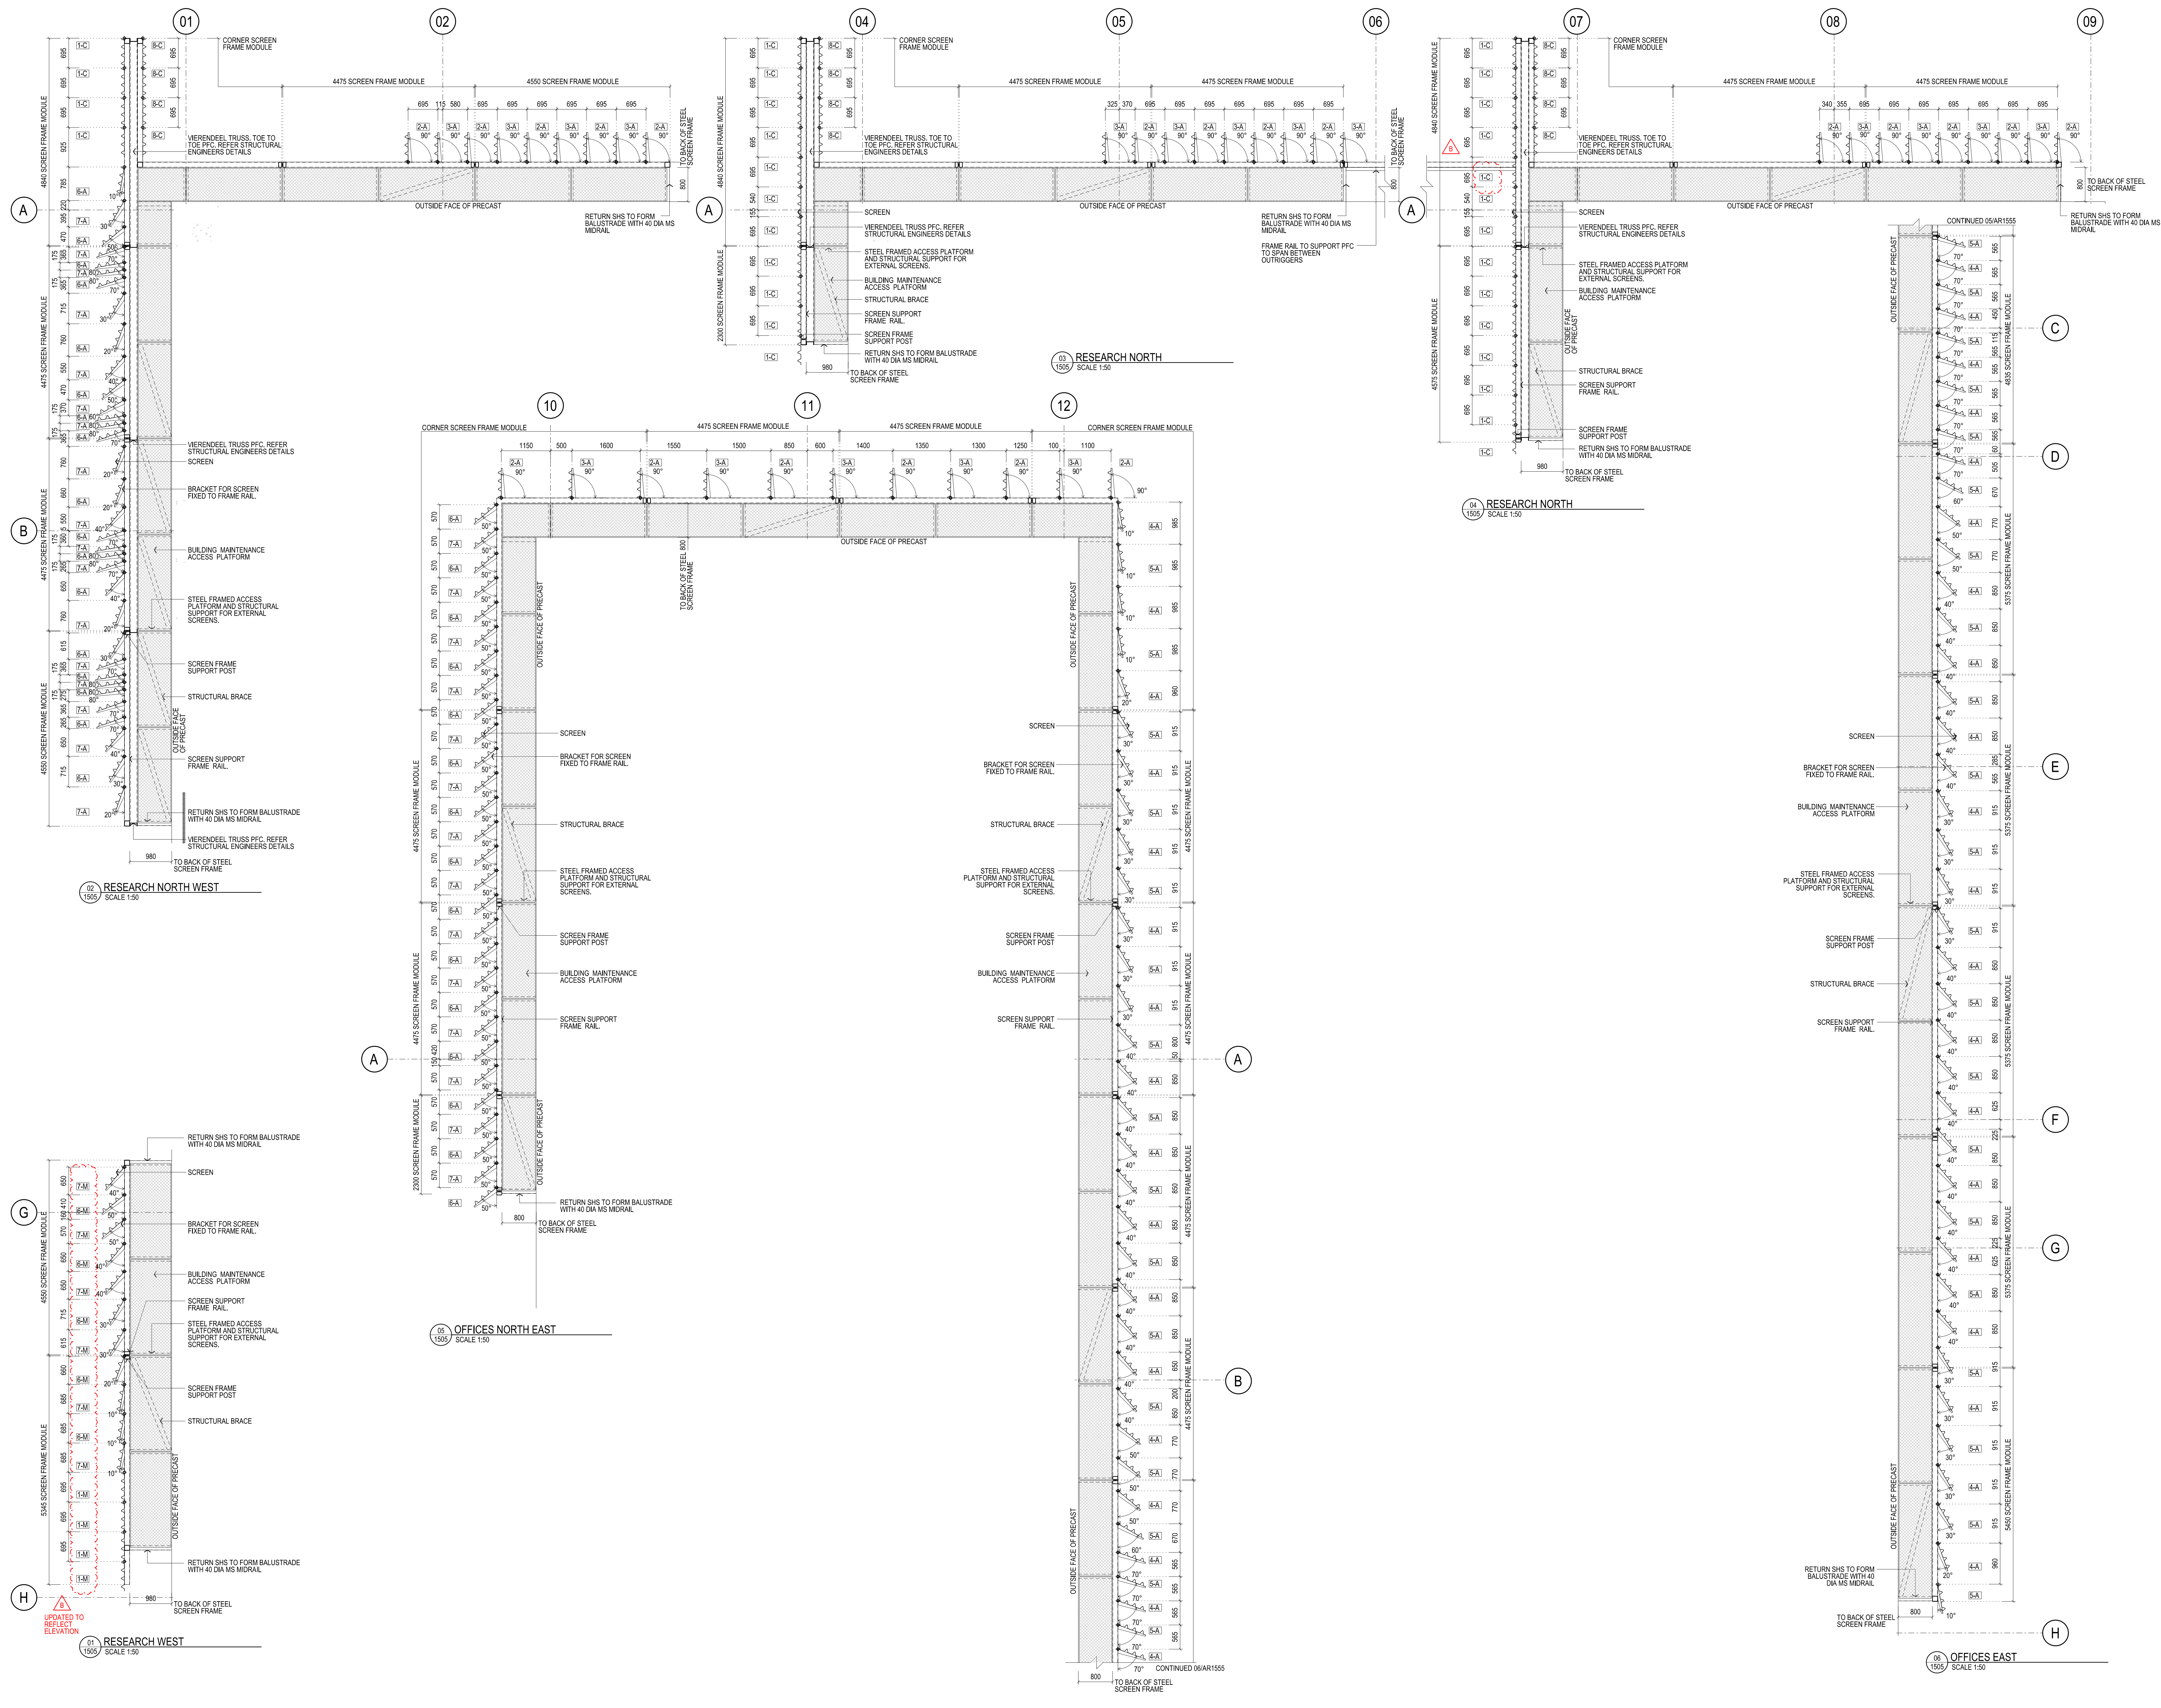

Rev	Issue	Revision Description	And	Date
B	SC	SCREEN TYPES REVISED	-	13.12.13
A	SG	ISSUED FOR CONSTRUCTION	-	04.08.13
04	SG	VALUE MANAGEMENT ISSUE	-	28.03.13
03	SG	100% CD - TENDER ISSUE	-	07.09.12
02	SG	90% CD ISSUE	-	10.08.12
01	SG	75% CD ISSUE	-	13.07.12



**NADAAA**  
 NADAAA  
 1520 Washington Street No.2 Boston Massachusetts 02115 USA  
 Telephone +1 617 442 2232 Facsimile +1 688 442 1417 Email nad@nadaaa.com

**John Wardle Architects**  
 25 Rokeby Street, Collingwood, Victoria 3066 Australia  
 Tel: +61 3 8662 0400 www.johnwardlearchitects.com  
 © 2012 John Wardle Architects ABN 83 006 814 268

Client **University of Melbourne Parkville Campus**  
 Project **Faculty of Architecture Building and Planning**

Title **EXTERNAL SCREEN SETOUT PLAN LEVEL 03**

Project No. **0913** Scale 1:50 @ A0  
 Drawing No. **AR1555** Revision **B**

Date July 2012 Drawn - Co-Ord - Check -

FILENAME - \$FILES  
**FOR CONSTRUCTION**