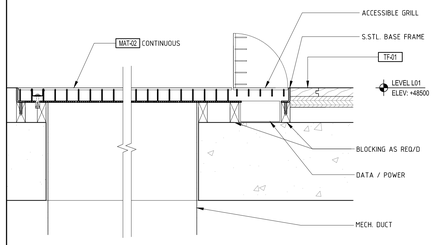

06 SECTION DETAIL - DATA AND POWER
SCALE: 1:5

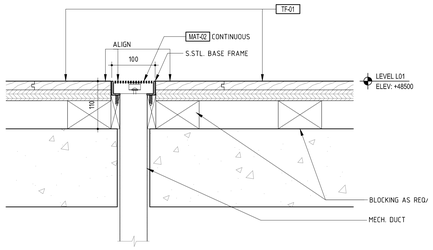

05 SECTION DETAIL - GRILL
SCALE: 1:5

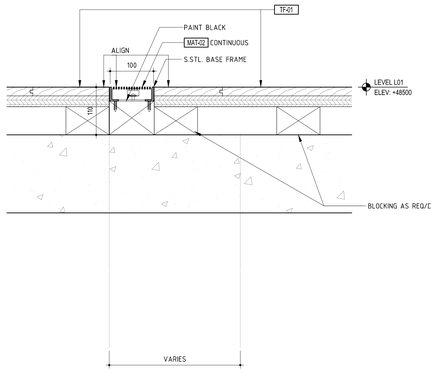

04 SECTION DETAIL - GRILL @ BEAM
SCALE: 1:5

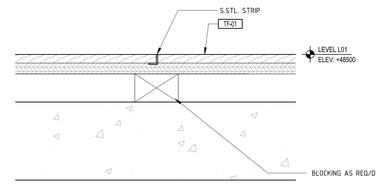

09 SECTION DETAIL - S.S. DIVIDER STRIP
SCALE: 1:5

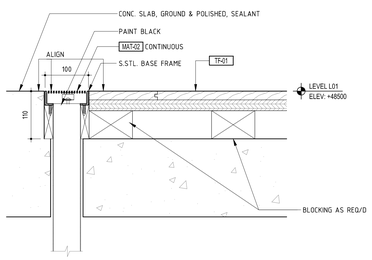

03 SECTION DETAIL - TIMBER FLOOR PERIMETER
SCALE: 1:5

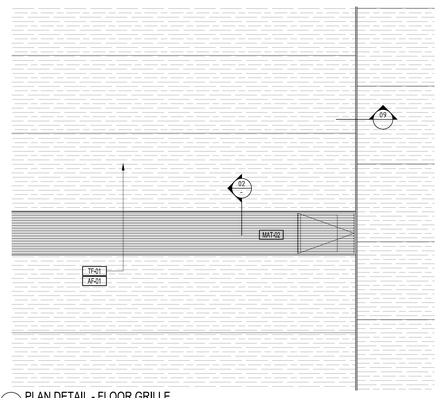

08 PLAN DETAIL - FLOOR GRILLE
SCALE: 1:5

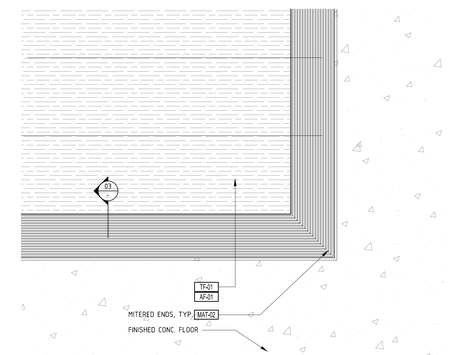

07 PLAN DETAIL - FLOOR GRILLE
SCALE: 1:5

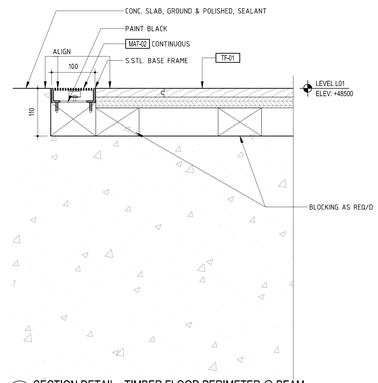

02 SECTION DETAIL - TIMBER FLOOR PERIMETER @ BEAM
SCALE: 1:5

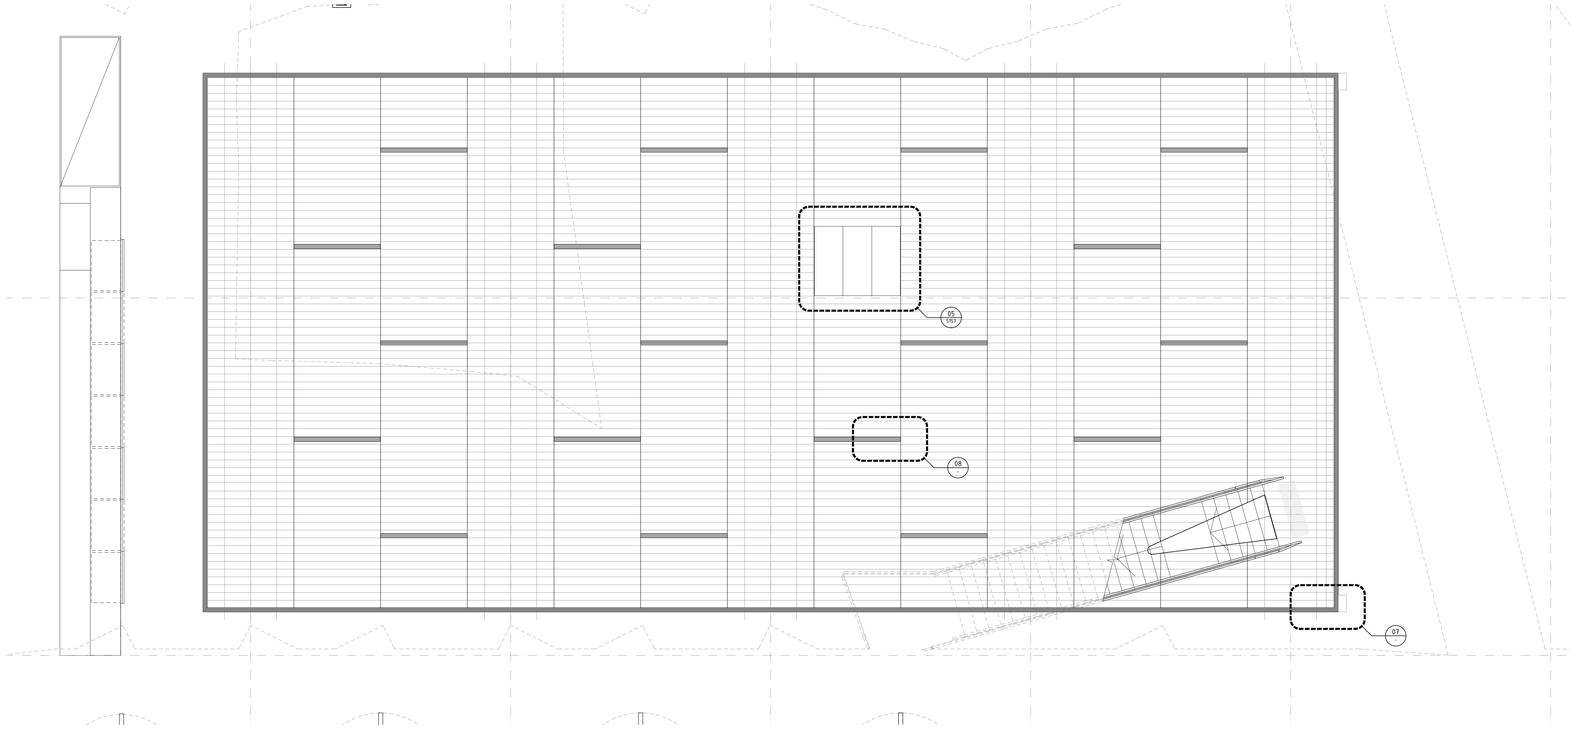

01 ENLARGED PLAN @ HALL FLOOR
SCALE: 1:50

THIS DRAWING IS AN UNCONTROLLED COPY UNLESS STAMPED OTHERWISE

CONTRACTORS SHALL VERIFY JOB DIMENSIONS BEFORE ANY JOB COMMENCES.
ALL SHOP DRAWINGS SHALL BE SUBMITTED TO THE SUPERINTENDENT AND MANUFACTURE SHALL NOT COMMENCE PRIOR TO THE RETURN OF UNMARKNDED SHOP DRAWINGS SIGNED BY THE CONSULTANT. FIGURED DIMENSIONS SHALL TAKE PRECEDENCE OVER SCALED. THIS DRAWING SHOULD BE READ IN CONJUNCTION WITH ALL RELEVANT CONTRACT, SPECIFICATIONS AND DRAWINGS COPYRIGHT OF THIS DRAWING IS VESTED IN WARDLE

General Notes

1. SEE SHEET AR5152 FOR ADDITIONAL DETAIL INFORMATION
2. REFER TO STRUCTURAL ENG. DRAWINGS FOR SLAB AND INFO

Rev	Issue	Revision Description	Amd	Date
A	SG	CONSTRUCTION ISSUE		24.01.14
04	SG	VALUE MANAGEMENT ISSUE		28.03.13
03	JC	100% CD – TENDER ISSUE		07.09.12
02	JC	90% CD ISSUE		10.08.12
01	JC	75% CD ISSUE		13.07.12

NADAAA

NADAAA
1920 Washington
Street No.2
Boston
Massachusetts
02118 USA

Telephone
+1 617 442 6232
Facsimile
+1 888 442 1417
Email
nada@nadaaa.com

John Wardle Architects

© 2011 John Wardle Architects
Level 10, 180 Russell Street, Melbourne Victoria 3000 Australia
Tel : +613 9654 8700 www.johnwardlearchitects.com

Client: University of Melbourne
Parkville Campus

Project: Faculty of Architecture
Building and Planning

Title: FINISH FLOOR SETOUT - LEVEL 01

Project No. 0913
Scale 1:100 @ A0
1:200 @ A2
Drawing No. AR1703
Revision A
Date JAN 2014
Drwn -
Co-Ord -
Chck -
FILENAME - ###

FOR CONSTRUCTION