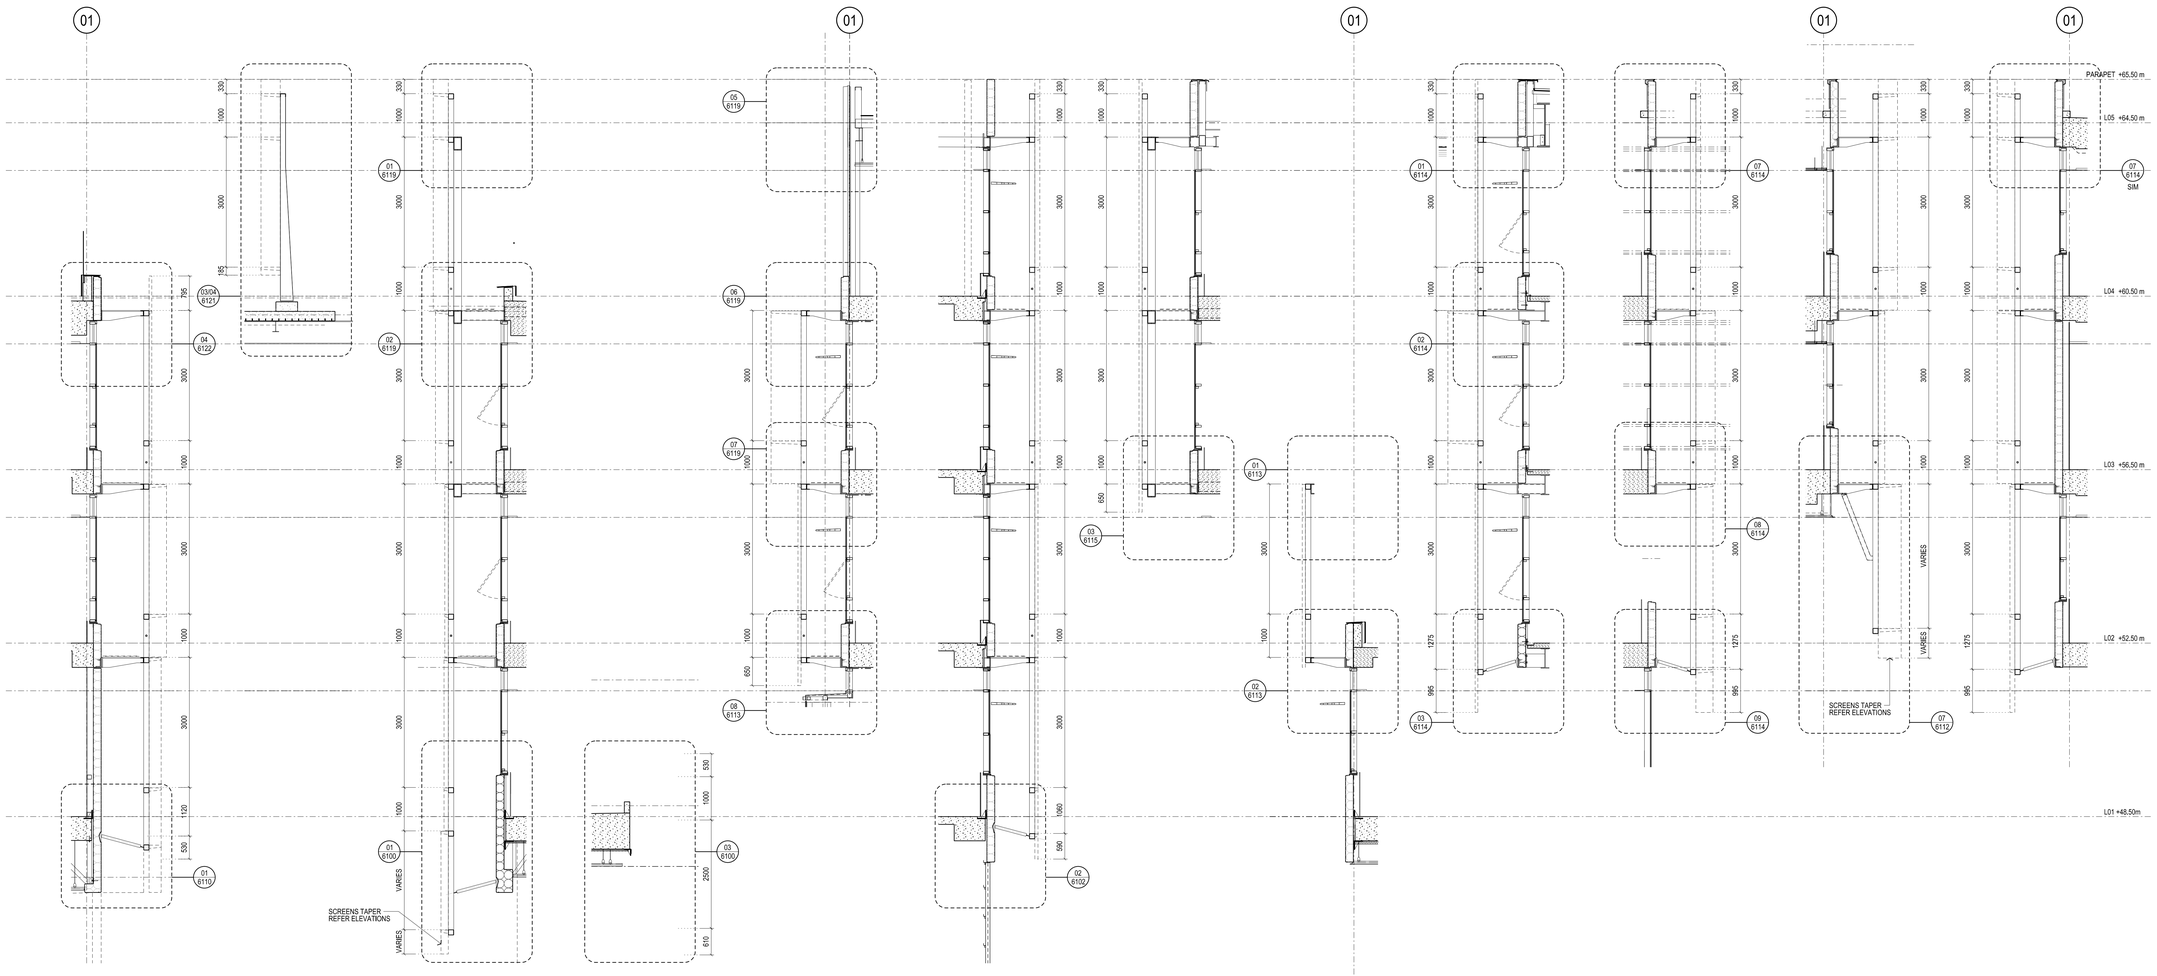
01
330
1000
3000
185
795
03/04 6121
04 6122
1000
3000
1000
3000
1000
3000