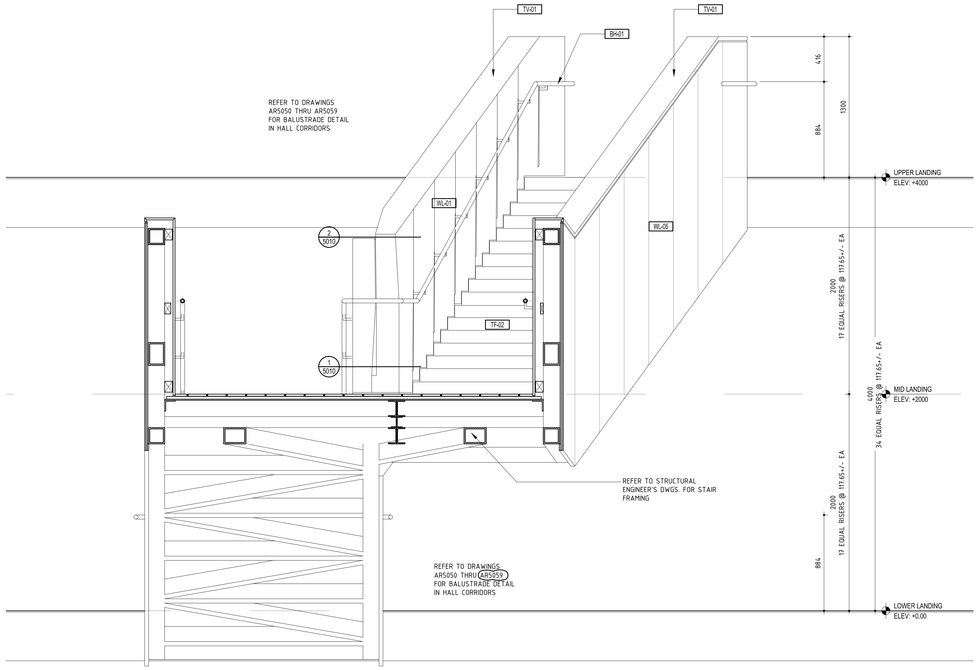

04 TRANSVERSE SECTION/ ELEVATION OF 000H STAIR
SCALE: 1:20

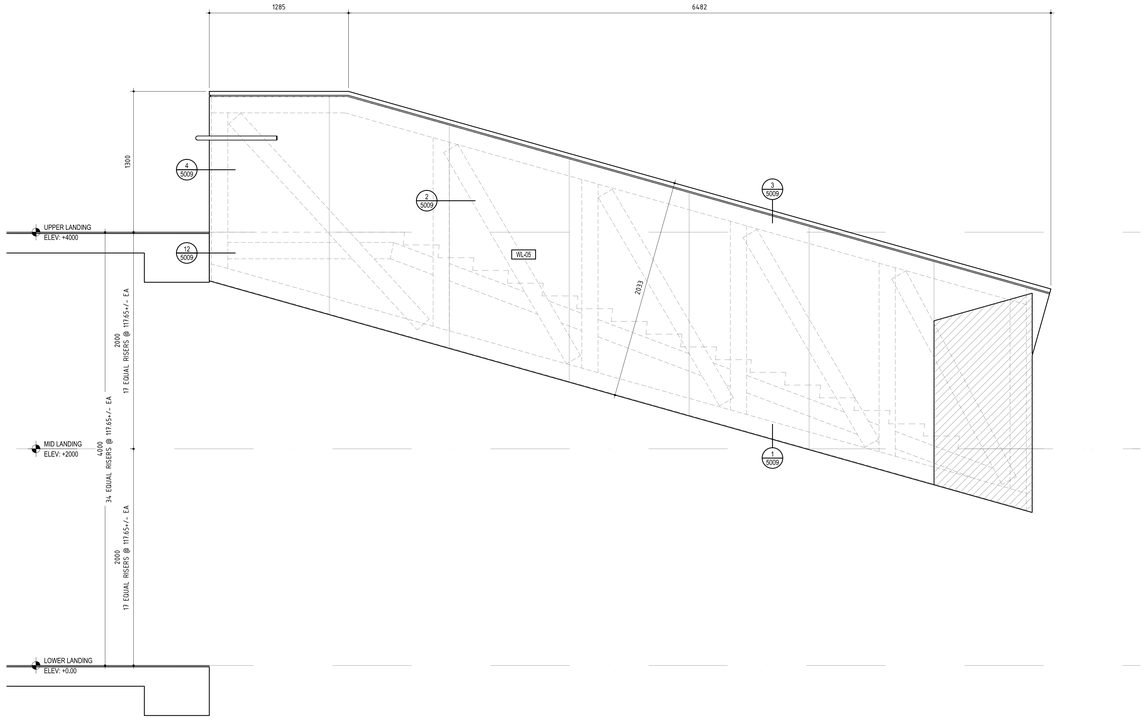

02 WEST ELEVATION OF 000H STAIR
SCALE: 1:20

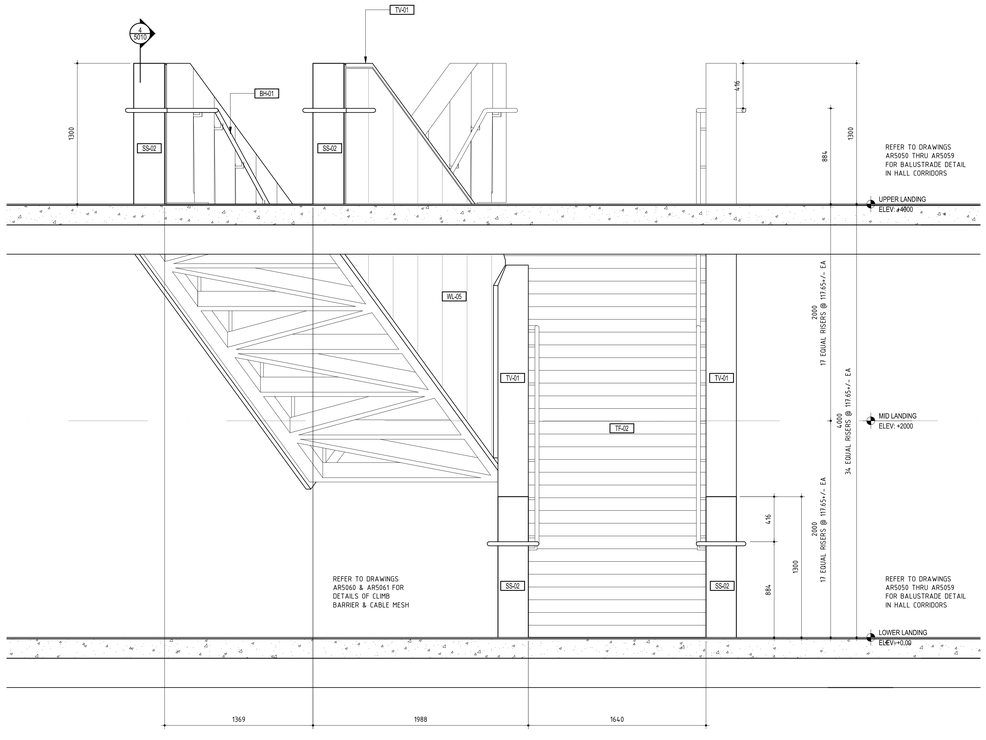

03 END ELEVATION OF 000H STAIR
SCALE: 1:20

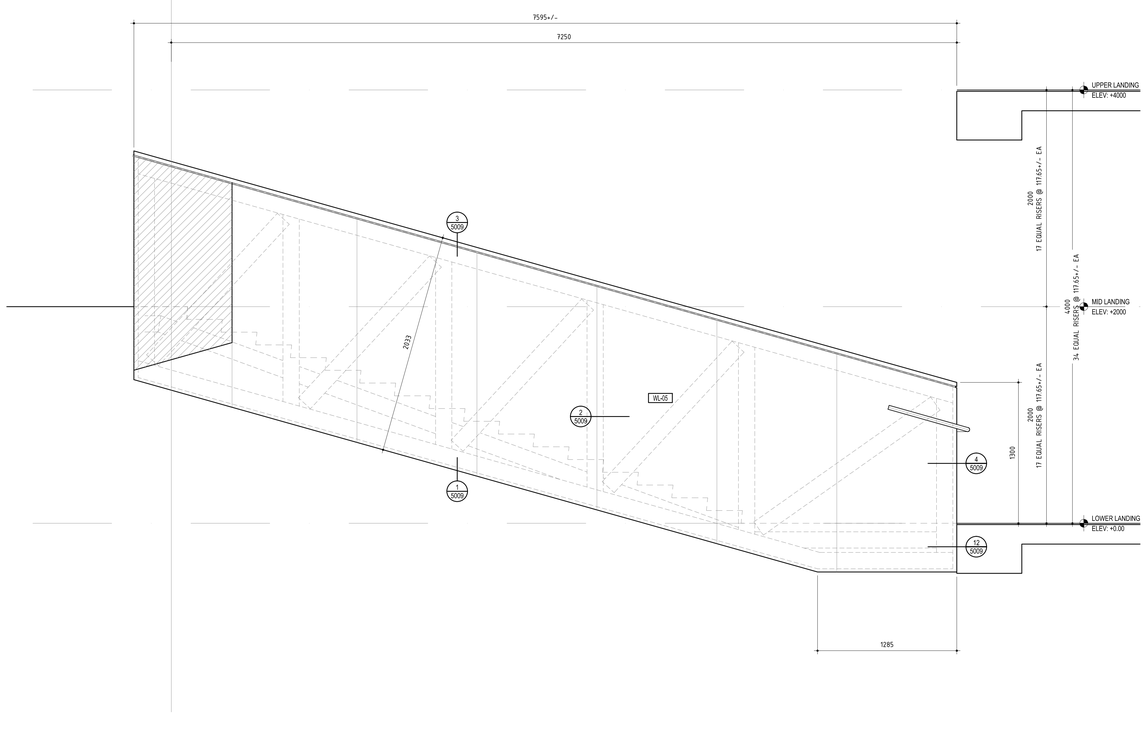

01 EAST ELEVATION OF 000H STAIR
SCALE: 1:20

THIS DRAWING IS AN UNCONTROLLED COPY UNLESS STAMPED OTHERWISE

CONTRACTORS SHALL VERIFY JOB DIMENSIONS BEFORE ANY JOB COMMENCES.
ALL SHOP DRAWINGS SHALL BE SUBMITTED TO THE SUPERINTENDENT AND MANUFACTURE
SHALL NOT COMMENCE PRIOR TO THE RETURN OF UNMARKENDED SHOP DRAWINGS SIGNED
BY THE CONSULTANT. FIGURED DIMENSIONS SHALL TAKE PRECEDENCE OVER SCALED. THIS
DRAWING SHOULD BE READ IN CONJUNCTION WITH ALL RELEVANT CONTRACT, SPECIFICATIONS
AND DRAWINGS COPYRIGHT OF THIS DRAWING IS VESTED IN WARDLE

General Notes

Rev	Issue	Revision Description	Amd	Date
A	SG	CONSTRUCTION ISSUE	-	12.24.13
06	JC	100% CD – TENDER ISSUE	-	07.09.12
05	JC	90% CD ISSUE	-	10.08.12
04	JC	75% CD ISSUE	-	13.07.12
03	JC	50% CD ISSUE	-	06.06.12
02	JC	ISSUED FOR INFORMATION	-	27.03.12
01	JC	DD ISSUE	-	20.01.12

NADAAA

NADAAA
1920 Washington
Street No.2
Boston
Massachusetts
02118 USA

Telephone
+1 617 442 6232
Facsimile
+1 888 442 1417
Email
nada@nadaaa.com

John Wardle Architects

© 2011 John Wardle Architects
Level 10, 180 Russell Street, Melbourne Victoria 3000 Australia
Tel : +613 9654 8700 www.johnwardlearchitects.com

Client
University of Melbourne
Parkville Campus

Project
Faculty of Architecture
Building and Planning

Title
000H STAIR
ENLARGED ELEVATIONS & SECTIONS

	Project No. 0913		Scale 1:20
	Drawing No. AR5006		Revision A
Date DEC 2013	Drwn -	Co-Ord -	Chck -

FILENAME - ####

FOR CONSTRUCTION