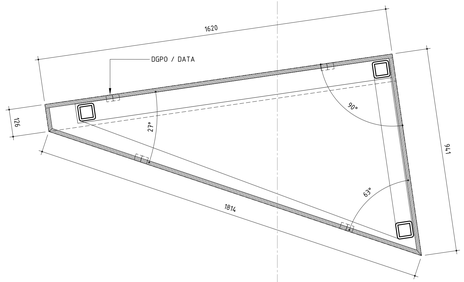

08 TABLE BASE PLAN
SCALE 1:10

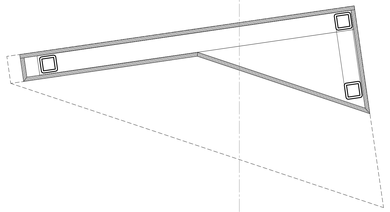

07 TABLE BASE PLAN
SCALE 1:10

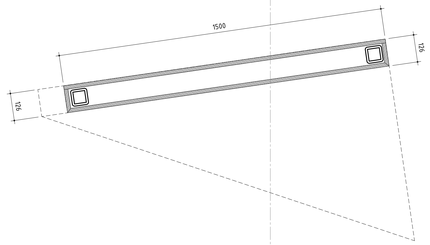

06 TABLE BASE PLAN
SCALE 1:10

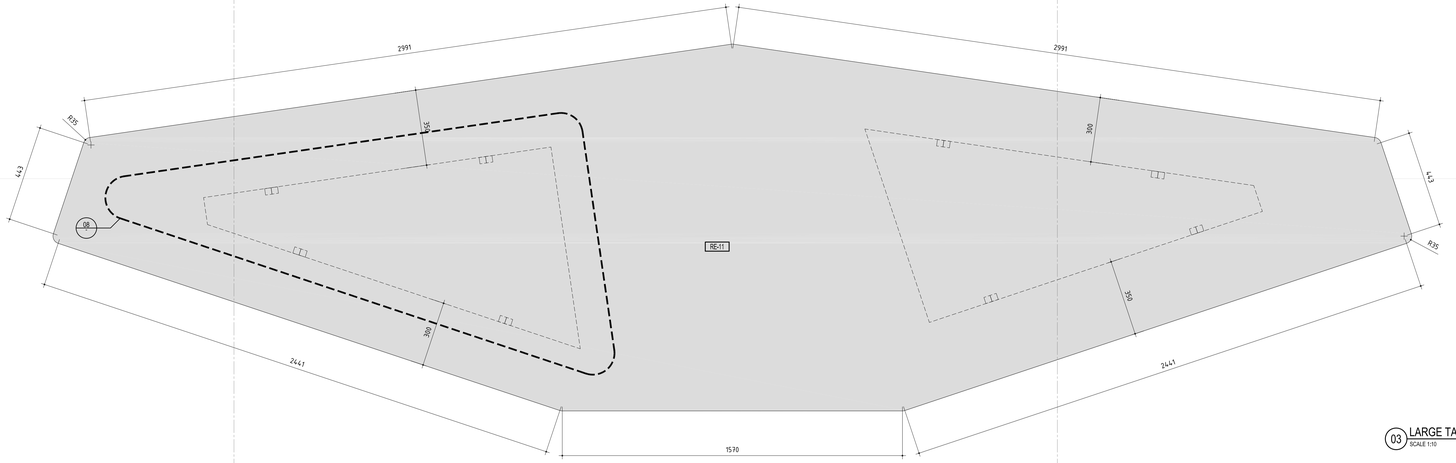

03 LARGE TABLE PLAN
SCALE 1:10

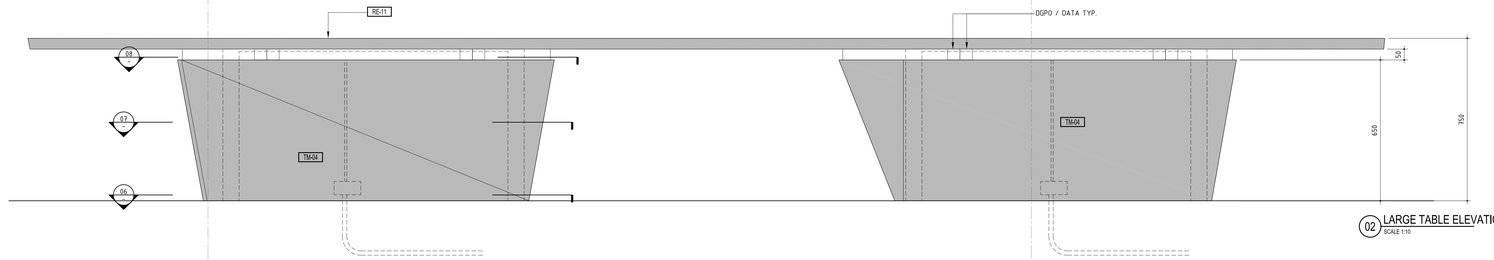

02 LARGE TABLE ELEVATION
SCALE 1:10

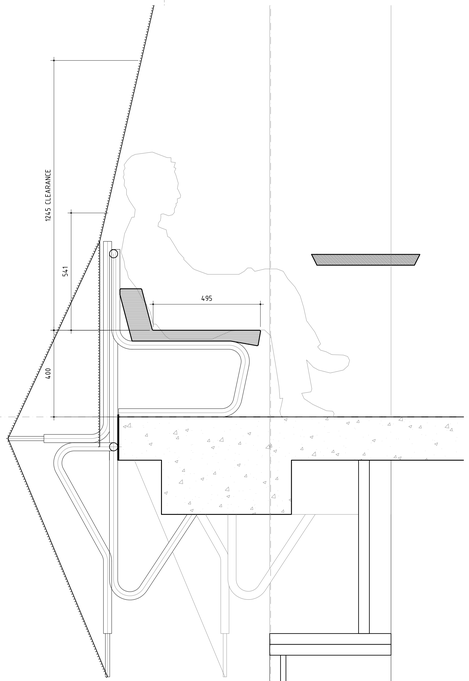

05 PIPE OUTRIGGER @ L02 - SECTION
SCALE 1:10

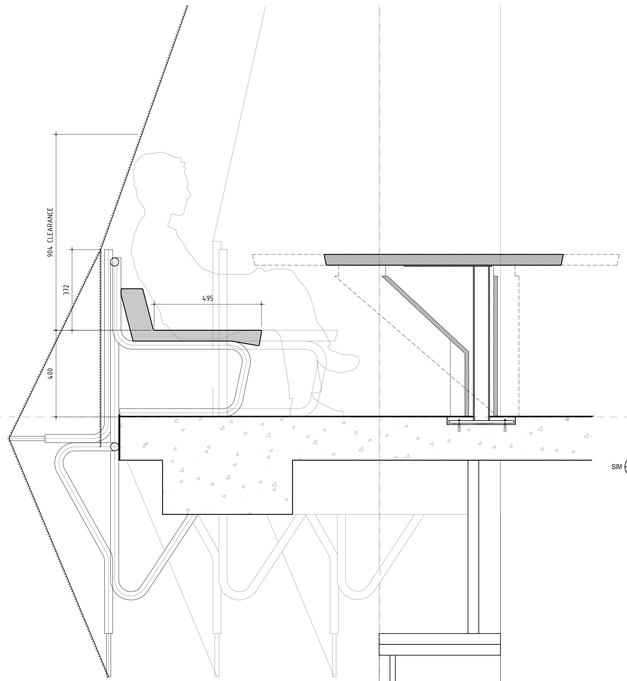

04 PIPE OUTRIGGER @ L02 - SECTION
SCALE 1:10

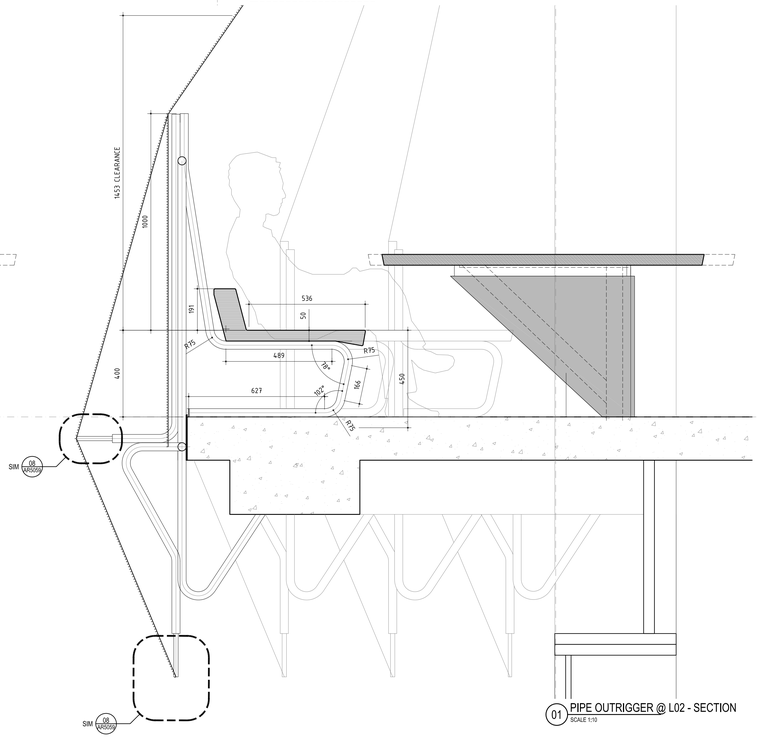

01 PIPE OUTRIGGER @ L02 - SECTION
SCALE 1:10

THIS DRAWING IS AN UNCONTROLLED COPY UNLESS STAMPED OTHERWISE

CONTRACTORS SHALL VERIFY JOB DIMENSIONS BEFORE ANY JOB COMMENCES.
ALL SHOP DRAWINGS SHALL BE SUBMITTED TO THE SUPERINTENDENT AND MANUFACTURE SHALL NOT COMMENCE PRIOR TO THE RETURN OF UNMARKNDED SHOP DRAWINGS SIGNED BY THE CONSULTANT. FIGURED DIMENSIONS SHALL TAKE PRECEDENCE OVER SCALED. THIS DRAWING SHOULD BE READ IN CONJUNCTION WITH ALL RELEVANT CONTRACT, SPECIFICATIONS AND DRAWINGS COPYRIGHT OF THIS DRAWING IS VESTED IN WARDLE

General Notes

01. SEE MESH ENGINEER DRAWINGS FOR ALL SS MESH AND CABLE CONNECTION DETAILS. INCLUDING CLAMPS, BRACKETS, TURN BUCKLES STUDS CLEATS ANCHORS AND ENDSTOPS.

02. SEE STRUCTURAL FOR ALL CONNECTIONS TO CONCRETE POCKETS

03. 8 DATA AND DGPO POINTS

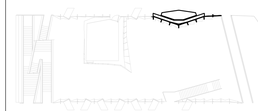

KEY PLAN - L02 _ BALUSTRADE

Rev	Issue	Revision Description	Amd	Date
A	SG	CONSTRUCTION ISSUE	-	03.01.14
05	SG	100% CD – TENDER ISSUE	-	17.09.13
04	JC	100% CD – TENDER ISSUE	-	07.09.12
03	JC	90% CD ISSUE	-	10.08.12
		THIS SHEET WAS PREVIOUSLY AR5057		
02	JC	75% CD ISSUE	-	13.07.12
01	JC	50% CD ISSUE	-	01.06.12

NADAAA

NADAAA
1920 Washington Street No.2
Boston
Massachusetts
02118 USA

Telephone
+1 617 442 6232
Facsimile
+1 888 442 1417
Email
nada@nadaaa.com

John Wardle Architects

© 2011 John Wardle Architects

Level 10, 180 Russell Street, Melbourne Victoria 3000 Australia
Tel : +613 9654 8700 www.johnwardlearchitects.com

Client
University of Melbourne
Parkville Campus

Project
Faculty of Architecture
Building and Planning

Title
MESH BALUSTRADE
LEVEL 02 JOINERY DETAIL

Project No. 0913			Scale 1:100
Drawing No. AR5053			Revision A
Date JAN 2014	Drwn -	Co-Ord -	Chck -

FILENAME - #####

FOR CONSTRUCTION