


CONTRACTORS SHALL VERIFY ALL DIMENSIONS BEFORE ANY JOB COMMENCES. ALL SHOP DRAWINGS SHALL BE SUBMITTED TO THE SUPERINTENDENT AND MANUFACTURE SHALL NOT COMMENCE WORK TO THE RETURN OF DIMANDED SHOP DRAWINGS ISSUED BY THE CONSULTANT. FIGURED DIMENSIONS SHALL TAKE PRECEDENCE OVER SCALED THIS DRAWING SHOULD BE READ IN CONJUNCTION WITH ALL RELEVANT CONTRACT SPECIFICATIONS AND DRAWING COPYRIGHT OF THIS DRAWING IS VESTED IN WARDLE


General Notes

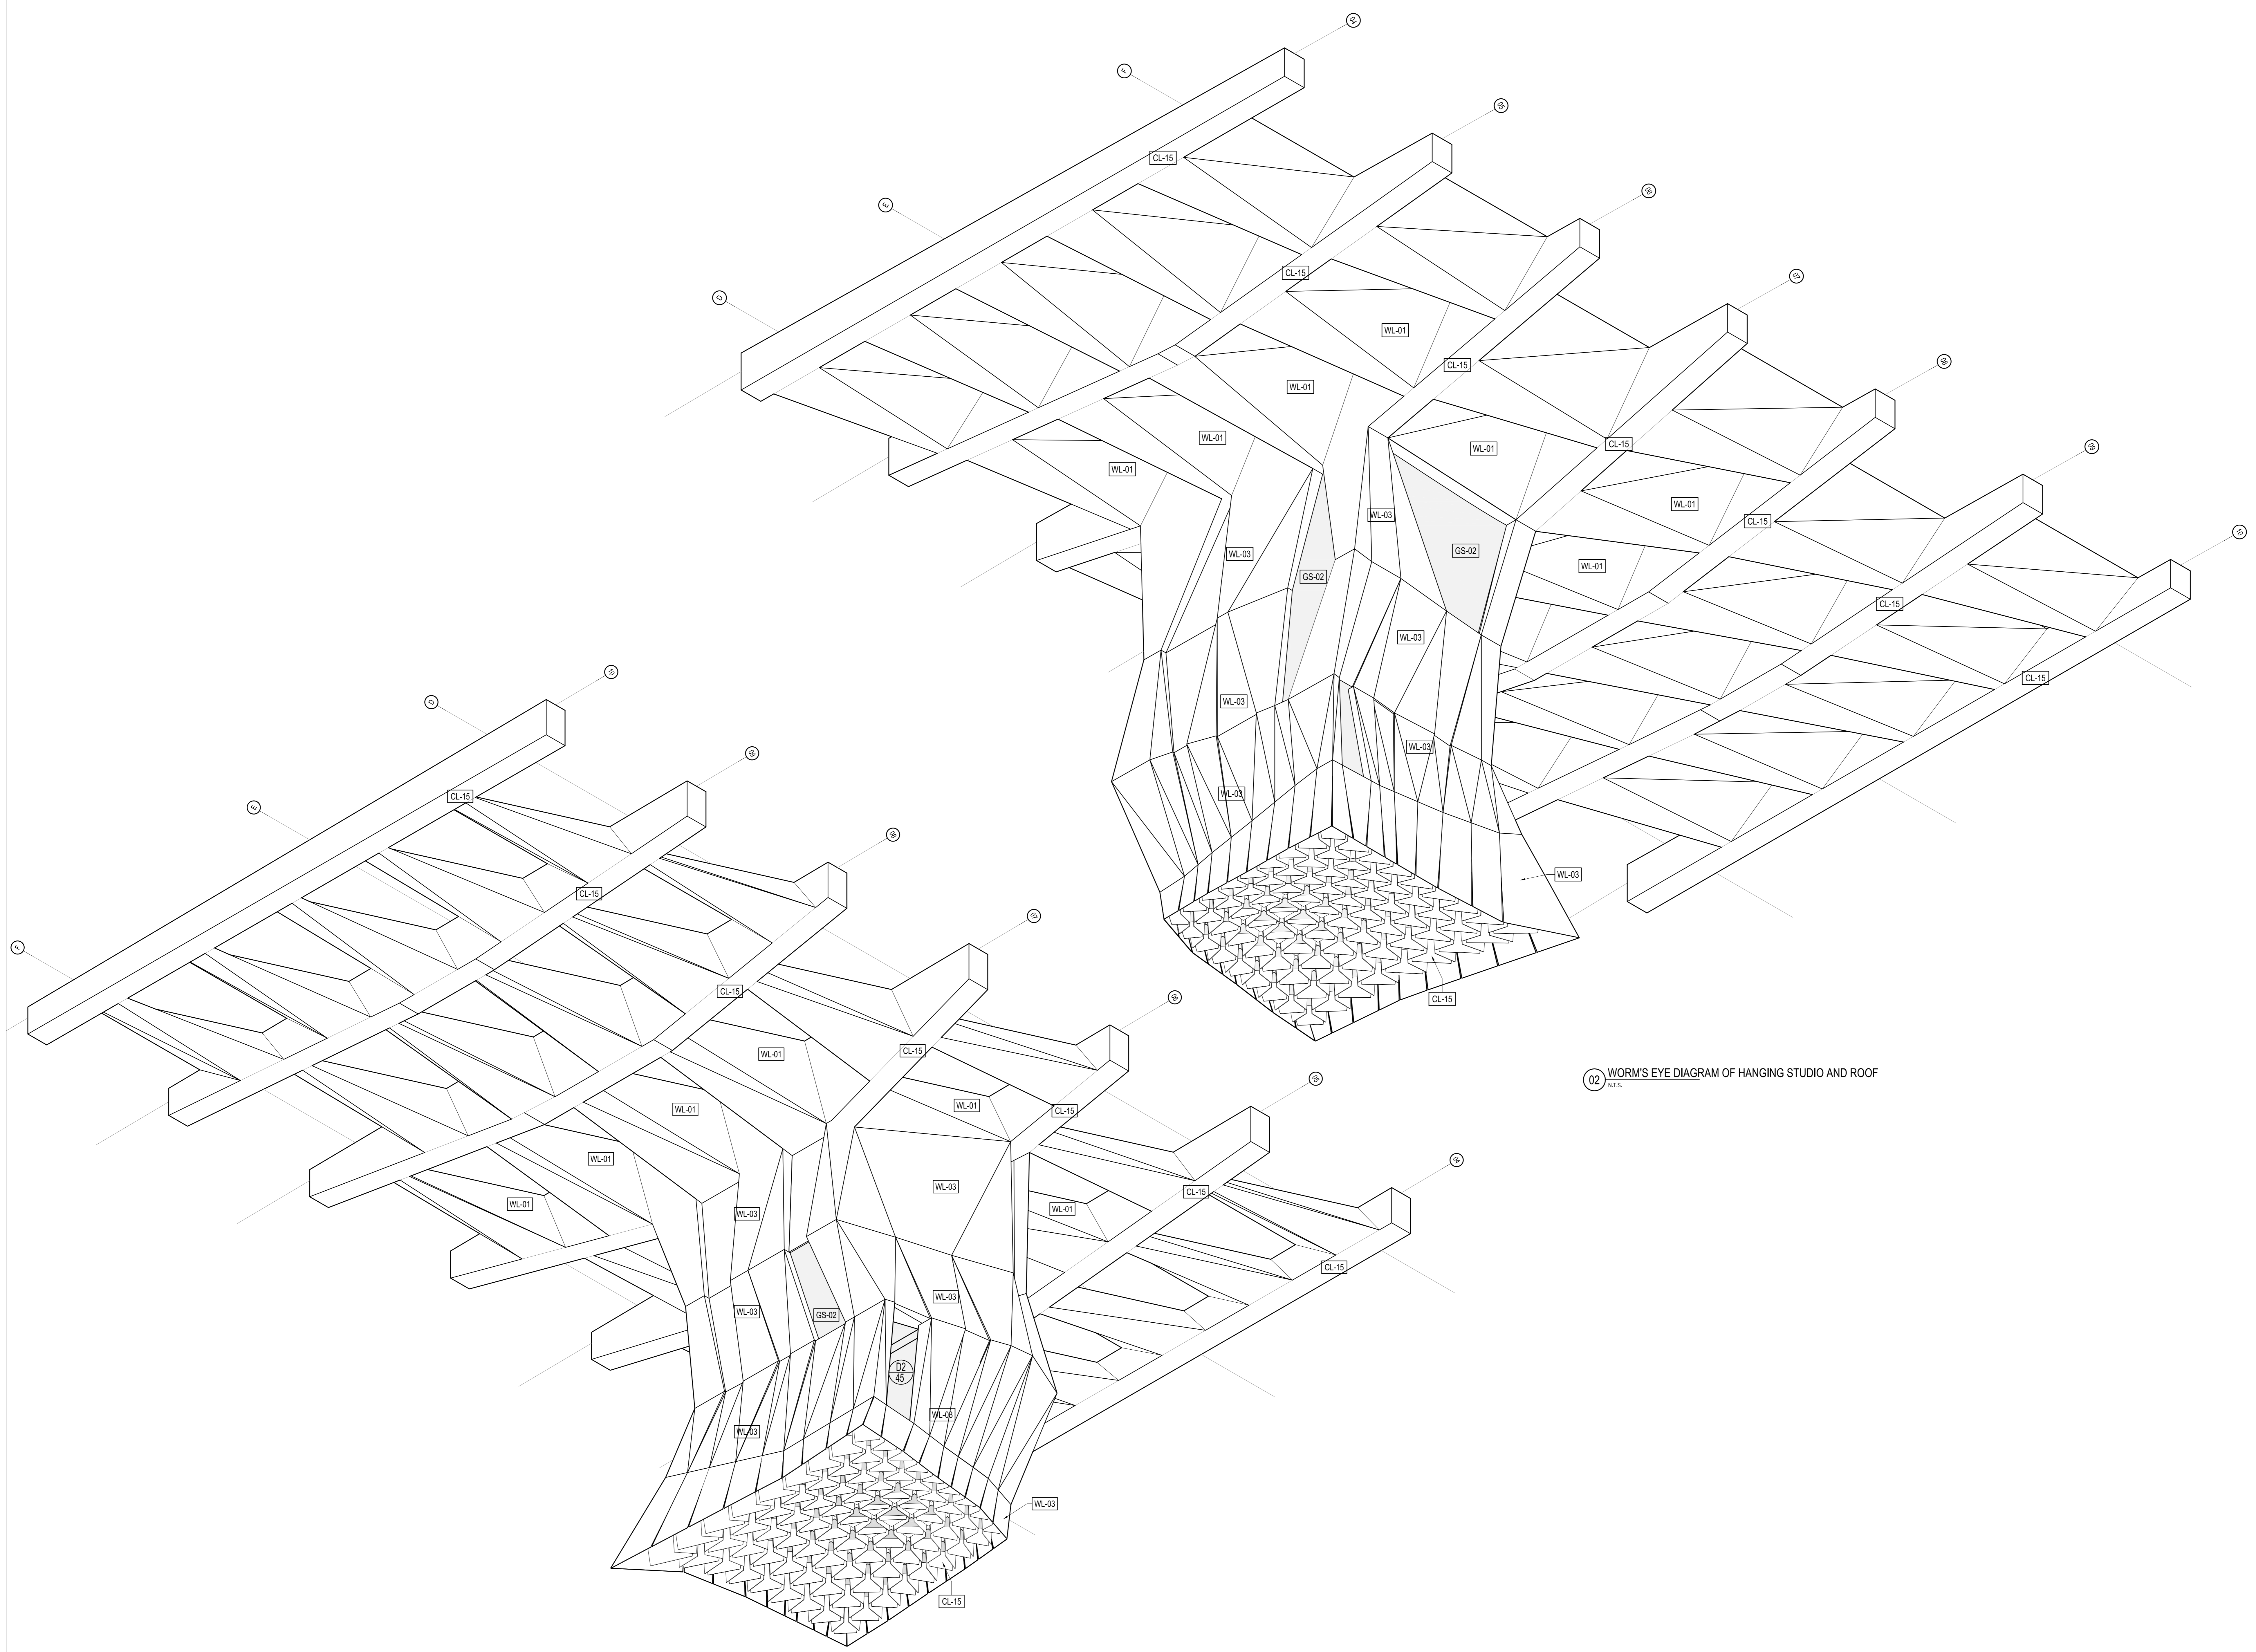

02 WORM'S EYE DIAGRAM OF HANGING STUDIO AND ROOF
N.T.S.

01 WORM'S EYE DIAGRAM OF HANGING STUDIO AND ROOF
N.T.S.

Rev	Issue	Revision Description	Amd	Date
A	SG	CONSTRUCTION ISSUE		06.02.14
07	JC	100% CD - TENDER ISSUE		07.08.12
06	JC	90% CD ISSUE		10.08.12
05	JC	75% CD ISSUE		13.07.12
04	JC	50% CD ISSUE		01.06.12
03	JC	FINAL CD ISSUE		24.02.12
02	JC	DESIGN DEVELOPMENT ISSUE		20.01.12
01	JC	DESIGN DEVELOPMENT ISSUE		22.12.11

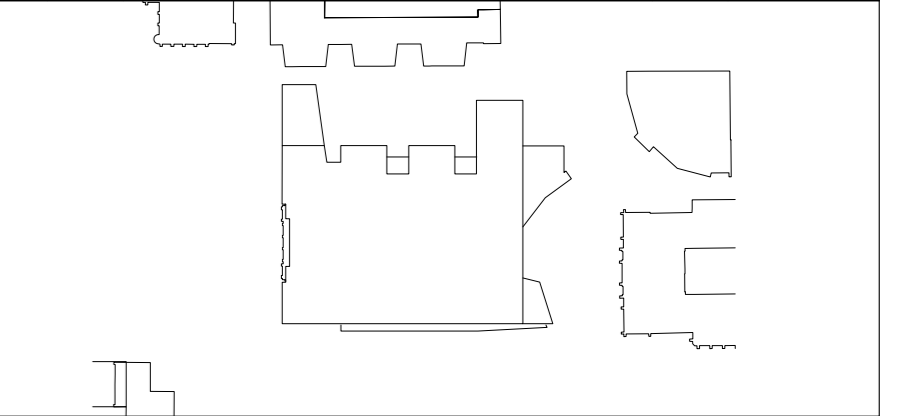

NADAAA
 NADAAA
 1320 Washington
 Street No.2
 Boston
 Massachusetts
 02118 USA
 Telephone
 +1 617 442 6232
 Facsimile
 +1 617 442 1417
 Email
 nada@nadaaa.com

John Wardle Architects
 © 2011 John Wardle Architects
 Level 10, 180 Russell Street, Melbourne Victoria 3000 Australia
 Tel : +613 9654 8700 www.johnwardlearchitects.com

Client **University of Melbourne
Parkville Campus**

Project **Faculty of Architecture
Building and Planning**

Title **3D VIEWS
HANGING STUDIO AND ROOF**

Project No.	0913	Scale	N.T.S.
Drawing No.	AR5101	Revision	A

Date JAN 2014 Dwn - Cs-Ord - Chk -

FILENAME: #####

FOR CONSTRUCTION