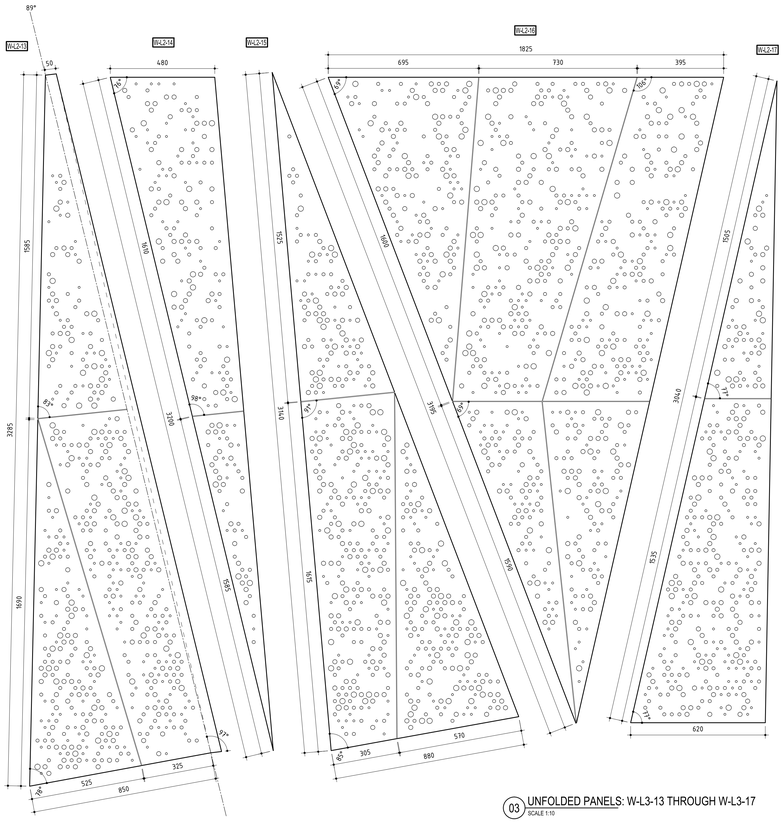

03 UNFOLDED PANELS: W-L3-13 THROUGH W-L3-17
SCALE 1:10

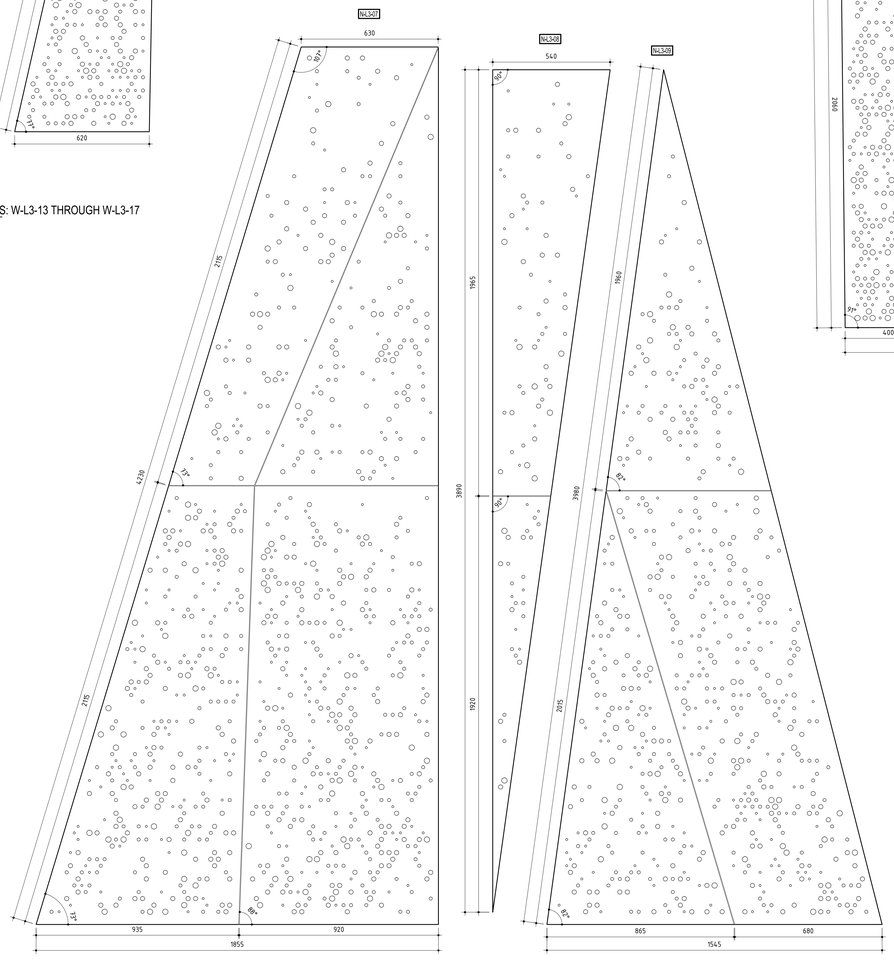

02 UNFOLDED PANELS: N-L3-07 THROUGH N-L3-09
SCALE 1:10

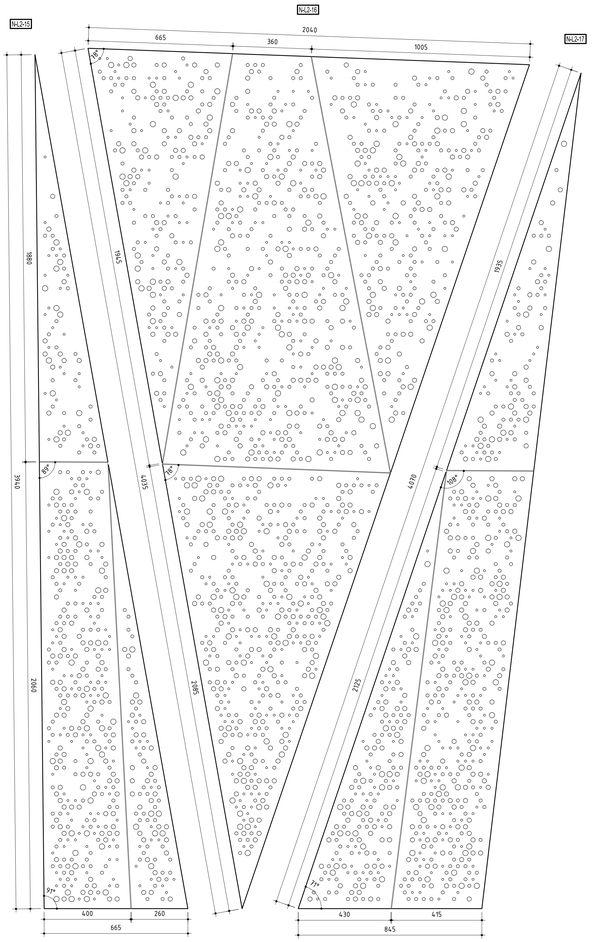

01 UNFOLDED PANELS: N-L2-15 THROUGH N-L2-17
SCALE 1:10

THIS DRAWING IS AN UNCONTROLLED COPY UNLESS STAMPED OTHERWISE

CONTRACTORS SHALL VERIFY JOB DIMENSIONS BEFORE ANY JOB COMMENCES.
ALL SHOP DRAWINGS SHALL BE SUBMITTED TO THE SUPERINTENDENT AND MANUFACTURE SHALL NOT COMMENCE PRIOR TO THE RETURN OF UNMARKED SHOP DRAWINGS SIGNED BY THE CONSULTANT. FIGURED DIMENSIONS SHALL TAKE PRECEDENCE OVER SCALED. THIS DRAWING SHOULD BE READ IN CONJUNCTION WITH ALL RELEVANT CONTRACT, SPECIFICATIONS AND DRAWINGS COPYRIGHT OF THIS DRAWING IS VESTED IN WARDLE

General Notes

1. PERFORATIONS OCCUR IN FOUR SIZES:
   - ◦ = DIAMETER OF 10mm
   - ○ = DIAMETER OF 15mm
   - ○ = DIAMETER OF 20mm
   - ○ = DIAMETER OF 25mm
2. ALL DIGITAL ARTWORK FILES WILL BE PROVIDED BY ARCHITECT.
3. CONTRACTORS TO REFER TO RELATED ARCHITECTURAL SPECIFICATION SECTIONS FOR 3D MODEL INTEGRATION REQUIREMENTS.
4. NO VENEER AT EDGE UNLESS OTHERWISE NOTED

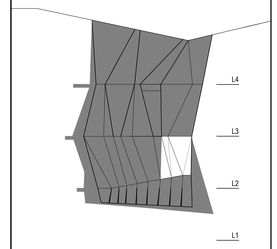

NORTH FACE: PANELS N-L2-14 THROUGH N-L2-16 AND N-L3-06 THROUGH N-L3-08

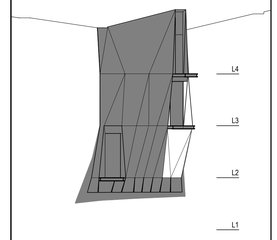

Rev	Issue	Revision Description	Amd	Date
A	SG	CONSTRUCTION ISSUE	-	06.01.14
04	JC	100% CD – TENDER ISSUE	-	07.09.12
03	JC	90% CD ISSUE	-	10.08.12
02	JC	75% CD ISSUE	-	13.07.12
01	JC	50% CD ISSUE	-	01.06.12

NADAAA

NADAAA
1920 Washington
Street No.2
Boston
Massachusetts
02118 USA

Telephone
+1 617 442 6232
Facsimile
+1 888 442 1417
Email
nada@nadaaa.com

John Wardle Architects

© 2011 John Wardle Architects

Level 10, 180 Russell Street, Melbourne Victoria 3000 Australia
Tel : +613 9654 8700 www.johnwardlearchitects.com

Client
University of Melbourne
Parkville Campus

Project
Faculty of Architecture
Building and Planning

Title
HANGING STUDIO
UNFOLDED PANELS

Project No. 0913			Scale 1:10 @ A0 1:20 @ A2
Drawing No. AR5144			Revision A
Date JAN 2014	Drwn -	Co-Ord -	Chck -

FILENAME - ####

FOR CONSTRUCTION