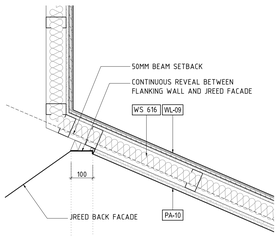

07 PLAN DETAIL
SCALE 1:10

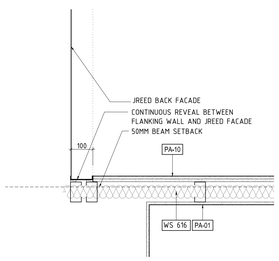

06 PLAN DETAIL
SCALE 1:10

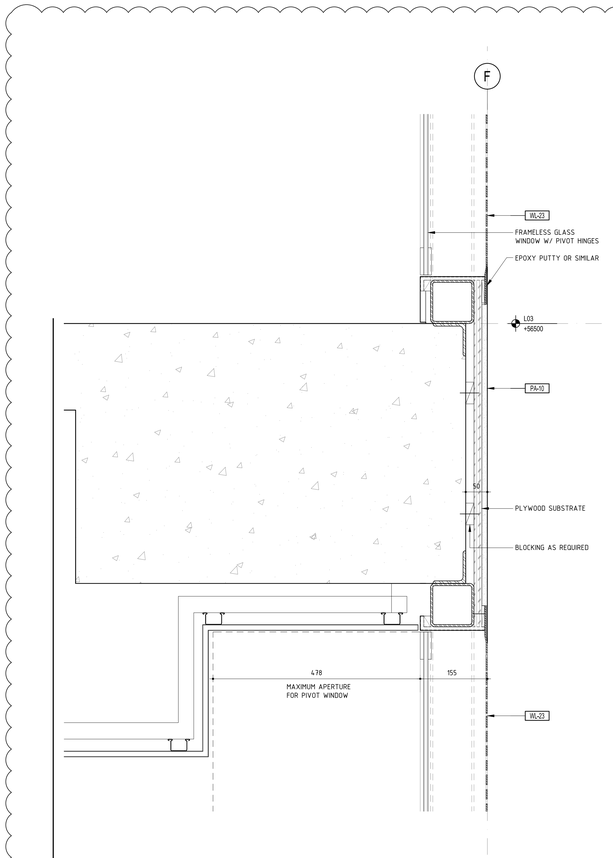

04 SECTION DETAIL
SCALE 1:5

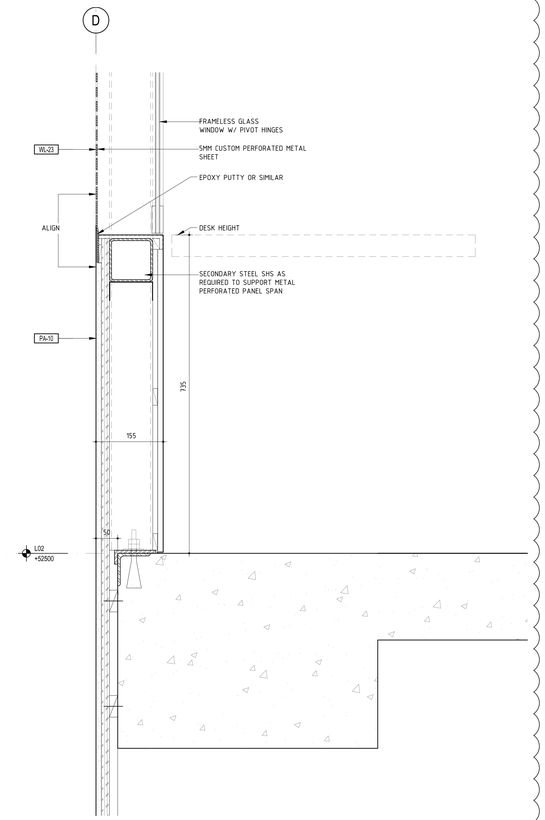

02 SECTION DETAIL
SCALE 1:5

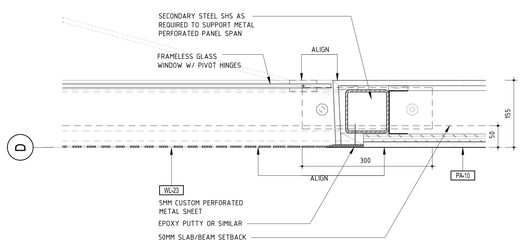

05 PLAN DETAIL
SCALE 1:5

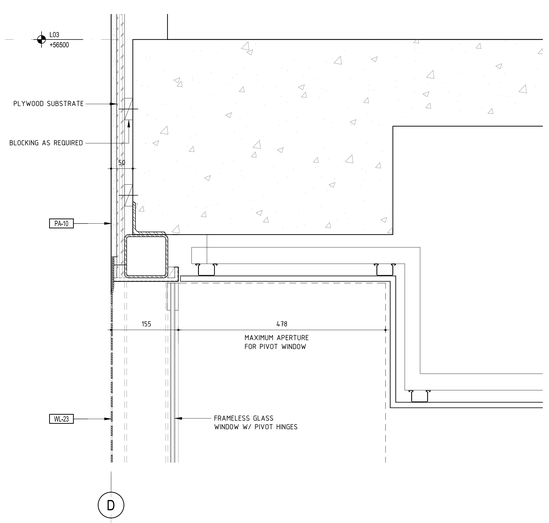

03 SECTION DETAIL
SCALE 1:5

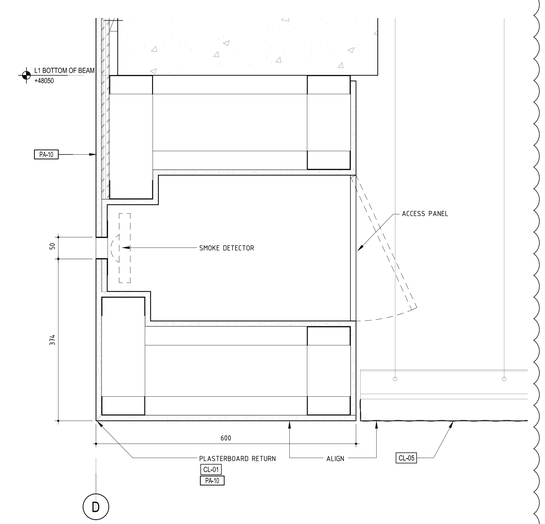

01 SECTION DETAIL
SCALE 1:5

02

THIS DRAWING IS AN UNCONTROLLED COPY UNLESS STAMPED OTHERWISE

CONTRACTORS SHALL VERIFY JOB DIMENSIONS BEFORE ANY JOB COMMENCES.
ALL SHOP DRAWINGS SHALL BE SUBMITTED TO THE SUPERINTENDENT AND MANUFACTURE SHALL NOT COMMENCE PRIOR TO THE RETURN OF UNAMENDED SHOP DRAWINGS SIGNED BY THE CONSULTANT. FIGURED DIMENSIONS SHALL TAKE PRECEDENCE OVER SCALED. THIS DRAWING SHOULD BE READ IN CONJUNCTION WITH ALL RELEVANT CONTRACT, SPECIFICATIONS AND DRAWINGS COPYRIGHT OF THIS DRAWING IS VESTED IN NADDLE

General Notes

Rev	Issue	Revision Description	Amd	Date
02	SG	VALUE MANAGEMENT ISSUE	-	28.03.13
01	JC	100% CD – TENDER ISSUE	-	07.09.12
		THIS SHEET WAS PREVIOUSLY AR5171		

NADAAA

NADAAA
1920 Washington Street No.2
Boston Massachusetts
02118 USA

Telephone +1 617 442 6232
Facsimile +1 888 442 1417
Email nada@nadaaa.com

John Wardle Architects

© 2011 John Wardle Architects

Level 10, 180 Russell Street, Melbourne Victoria 3000 Australia
Tel : +613 9654 8700 www.johnwardlearchitects.com

Client: University of Melbourne Parkville Campus

Project: Faculty of Architecture Building and Planning

Title: JOSEPH REED FLANKING WALL DETAILS

Project No. 0913 | Scale 1:10
Drawing No. AR5172 | Revision 02
Date MARCH 2013 | Drwn - | Co-Ord - | Chck -

FILENAME - ####

VM ISSUE