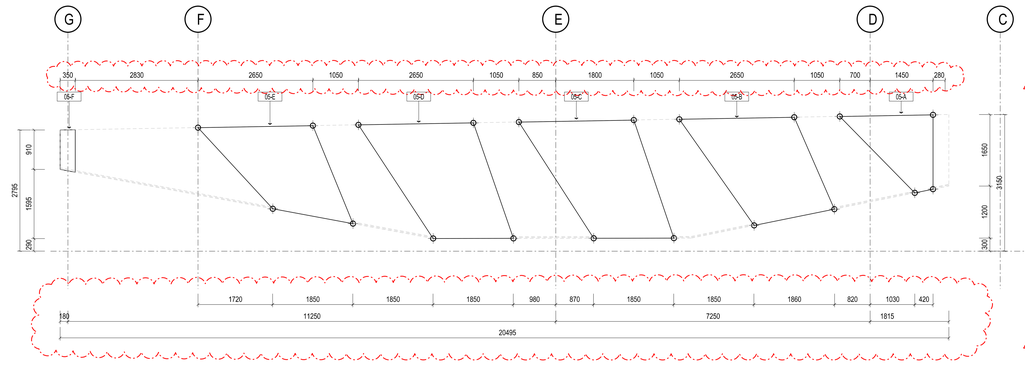

03 / 6205 ROOF BAY 05 COFFERS - WEST SETOUT
SCALE 1:50

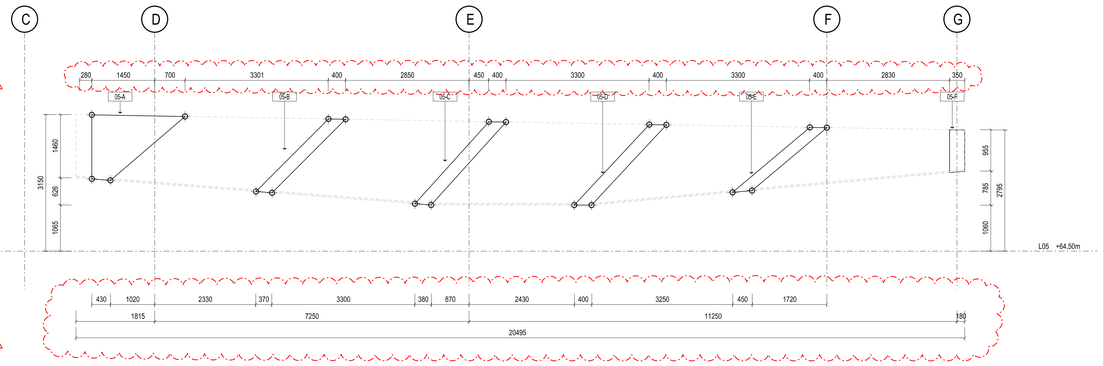

04 / 6205 ROOF BAY 05 COFFERS - EAST SETOUT
SCALE 1:50

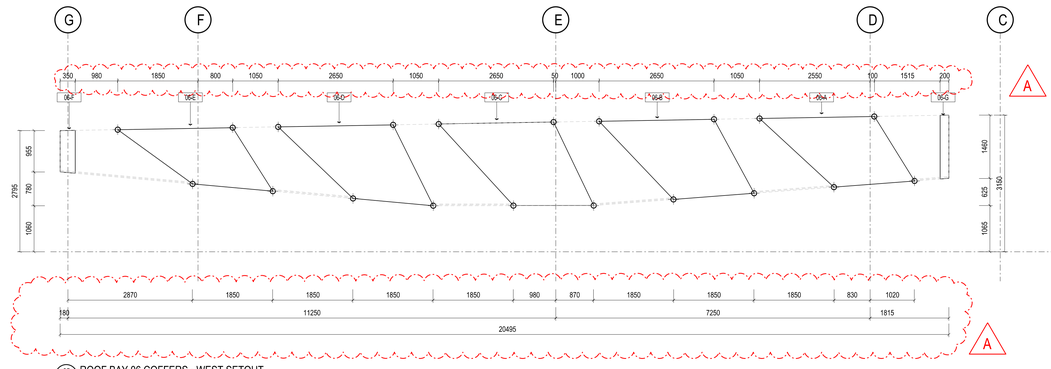

05 / 6205 ROOF BAY 06 COFFERS - WEST SETOUT
SCALE 1:50

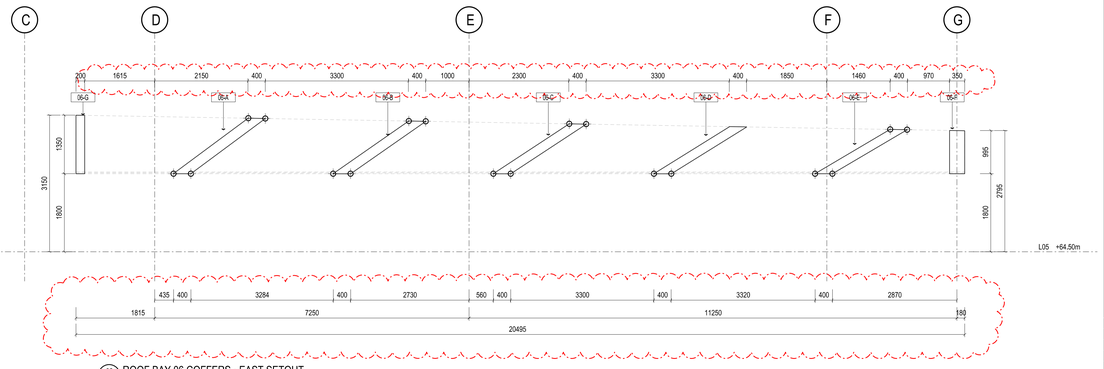

06 / 6205 ROOF BAY 06 COFFERS - EAST SETOUT
SCALE 1:50

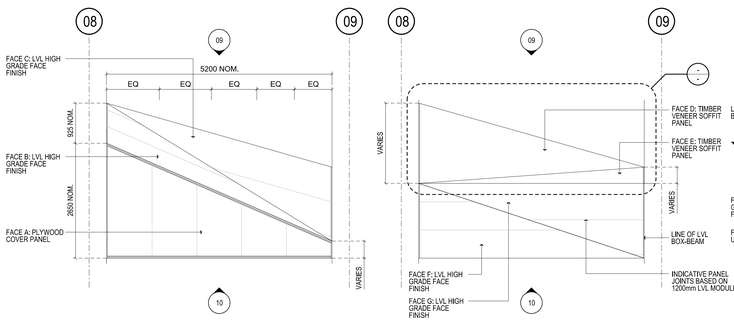

07 COFFER SETOUT - PLAN
SCALE 1:50

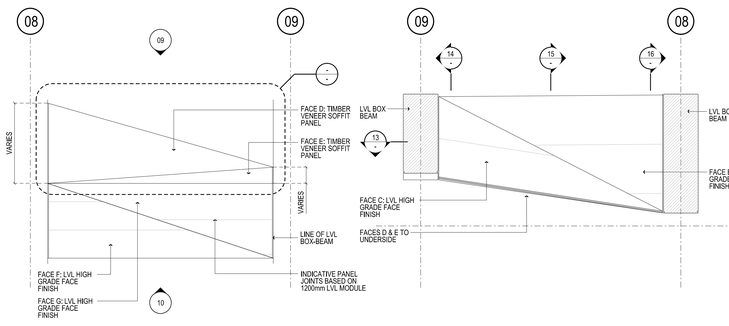

08 COFFER SETOUT - REFLECTED PLAN
SCALE 1:50

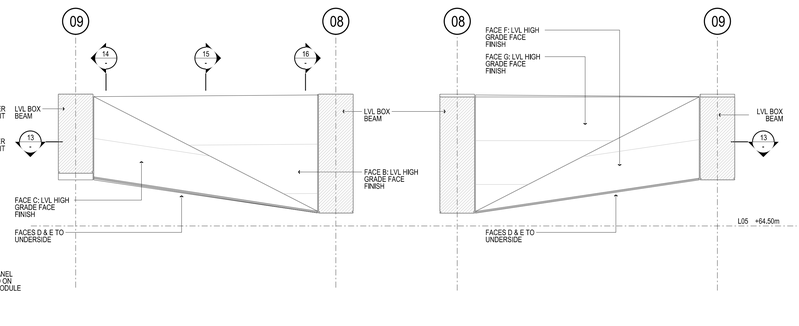

09 COFFER SETOUT - NORTH ELEVATION
SCALE 1:50

10 COFFER SETOUT - SOUTH ELEVATION
SCALE 1:50

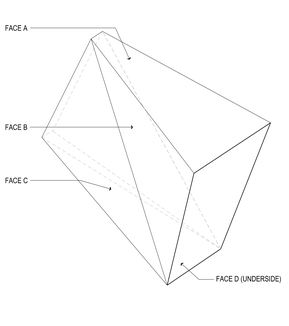

11 ISOMETRIC COFFER DIAGRAM - N.W. VIEW
SCALE 1:50

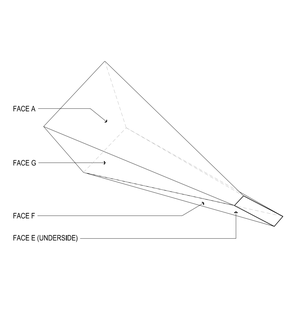

12 ISOMETRIC COFFER DIAGRAM - S.E. VIEW
SCALE 1:50

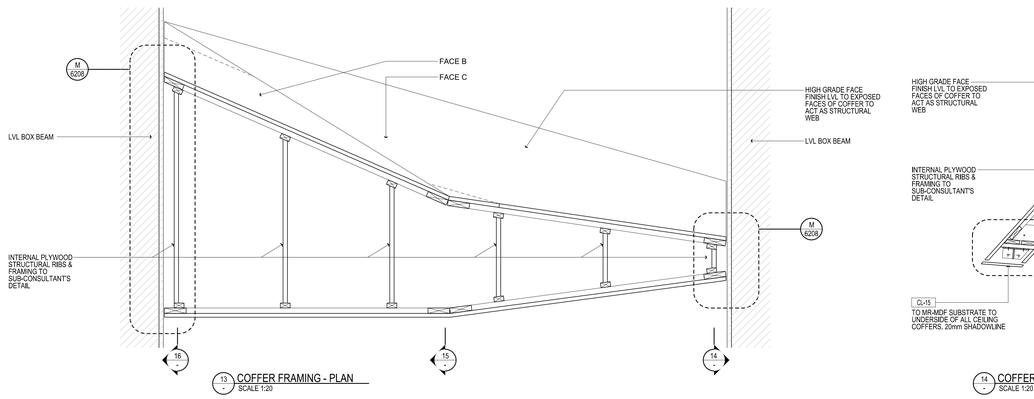

13 COFFER FRAMING - PLAN
SCALE 1:20

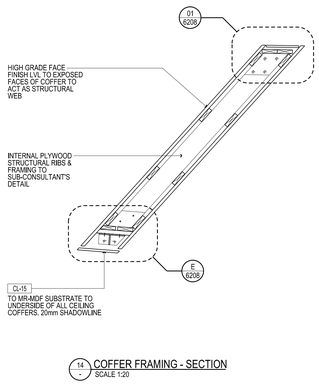

14 COFFER FRAMING - SECTION
SCALE 1:20

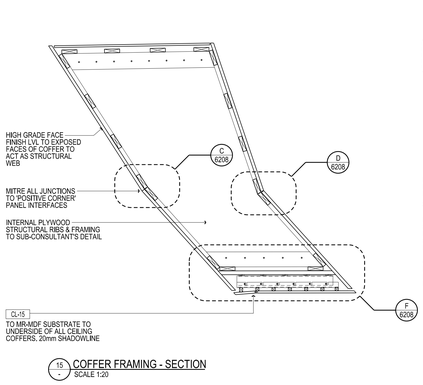

15 COFFER FRAMING - SECTION
SCALE 1:20

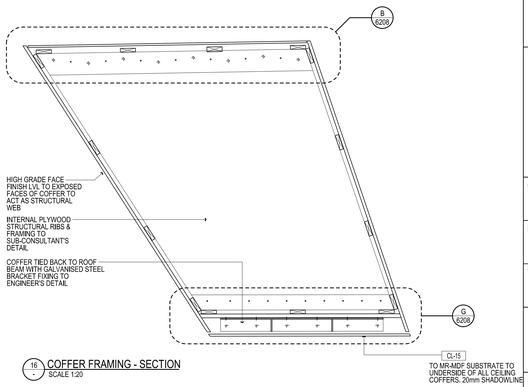

16 COFFER FRAMING - SECTION
SCALE 1:20

THIS DRAWING IS AN UNCONTROLLED COPY UNLESS STAMPED OTHERWISE

CONTRACTORS SHALL VERIFY JOB DIMENSIONS BEFORE ANY JOB COMMENCES.
ALL SHOP DRAWINGS SHALL BE SUBMITTED TO THE SUPERINTENDENT AND MANUFACTURE SHALL NOT COMMENCE PRIOR TO THE RETURN OF UNMARKINGS SHOP DRAWINGS SIGNED BY THE CONSULTANT. FIGURED DIMENSIONS SHALL TAKE PRECEDENCE OVER SCALED. THIS DRAWING SHOULD BE READ IN CONJUNCTION WITH ALL RELEVANT CONTRACT, SPECIFICATIONS AND DRAWINGS COPYRIGHT OF THIS DRAWING IS VESTED IN WARDLE

General Notes

Rev	Issue	Revision Description	Amd	Date
		DIM'S REVISED TO SUIT GRID		
A	SG	ISSUED FOR CONSTRUCTION	-	05.09.13
03	SG	100% CD - TENDER ISSUE	-	07.09.12
02	SG	90% CD ISSUE	-	10.08.12
01	SG	75% CD ISSUE	-	13.07.12

Brookfield MULTIPLEX

NADAAA
NADAAA
1920 Washington Street No.2
Boston
Massachusetts
02118 USA
Telephone
+1 617 442 6232
Facsimile
+1 888 442 1417
Email
nada@nadaaa.com

John Wardle Architects
25 Rokeby Street, Collingwood, Victoria 3066 Australia
Tel : +61 3 8662 0400
www.johnwardlearchitects.com
© 2012 John Wardle Architects
ABN 83 006 814 268

Client
University of Melbourne
Parkville Campus

Project
Faculty of Architecture
Building and Planning

Title
ROOF DETAILS
ATRIUM ROOF - COFFER SETOUT

Project No. 0913			Scale 1:50 @ A0
Drawing No. AR6207			Revision A
Date June 2012	Drwn -	Co-Ord -	Chck -

FILENAME - $FILES

FOR CONSTRUCTION