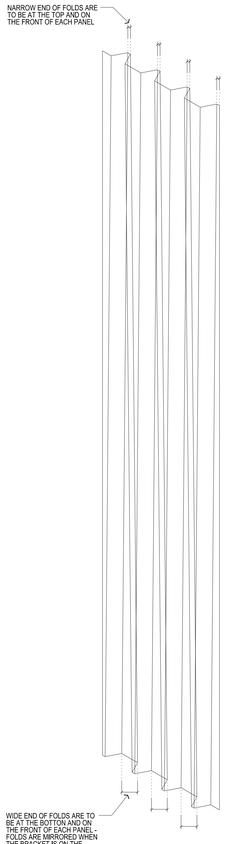

02 EXTERNAL SCREEN ISOMETRIC
SCALE NTS

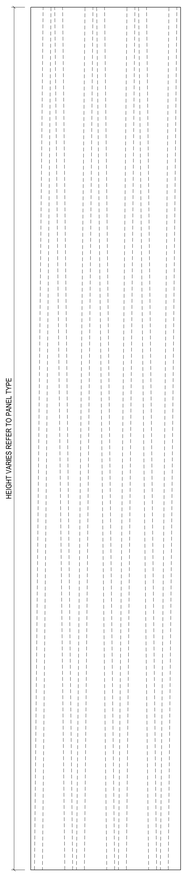

03 EXTERNAL SCREEN ELEVATION
SCALE 1:10

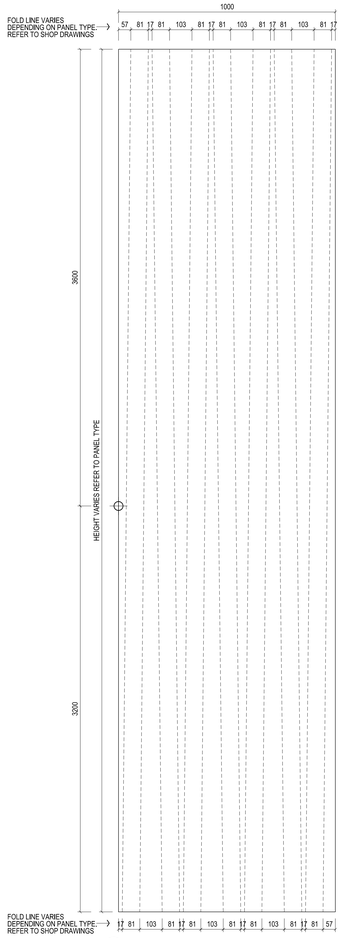

04 EXTERNAL SCREEN UNFOLDED
SCALE 1:10

01 EXTERNAL SCREEN PLAN DETAIL
SCALE 1:10

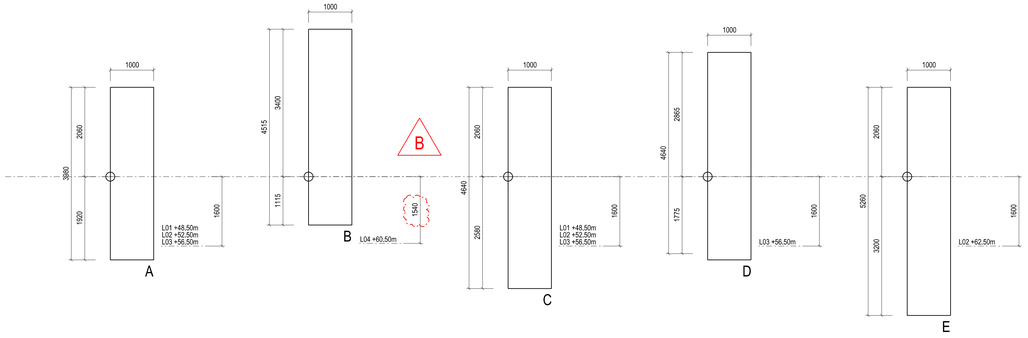

05 UNFOLDED SCREEN PANEL TYPE A
SCALE 1:50

05 UNFOLDED SCREEN PANEL TYPE B
SCALE 1:50

07 UNFOLDED SCREEN PANEL TYPE C
SCALE 1:50

08 UNFOLDED SCREEN PANEL TYPE D
SCALE 1:50

09 UNFOLDED SCREEN PANEL TYPE E
SCALE 1:50

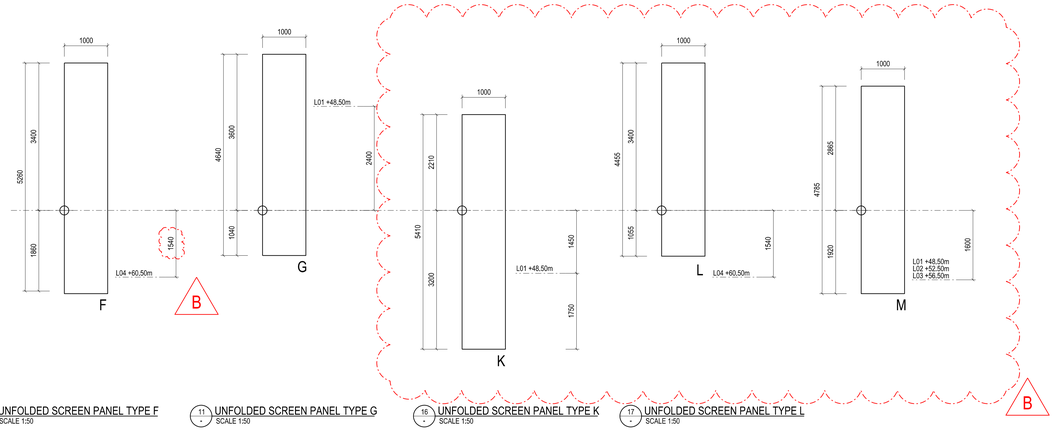

10 UNFOLDED SCREEN PANEL TYPE F
SCALE 1:50

11 UNFOLDED SCREEN PANEL TYPE G
SCALE 1:50

16 UNFOLDED SCREEN PANEL TYPE K
SCALE 1:50

17 UNFOLDED SCREEN PANEL TYPE L
SCALE 1:50

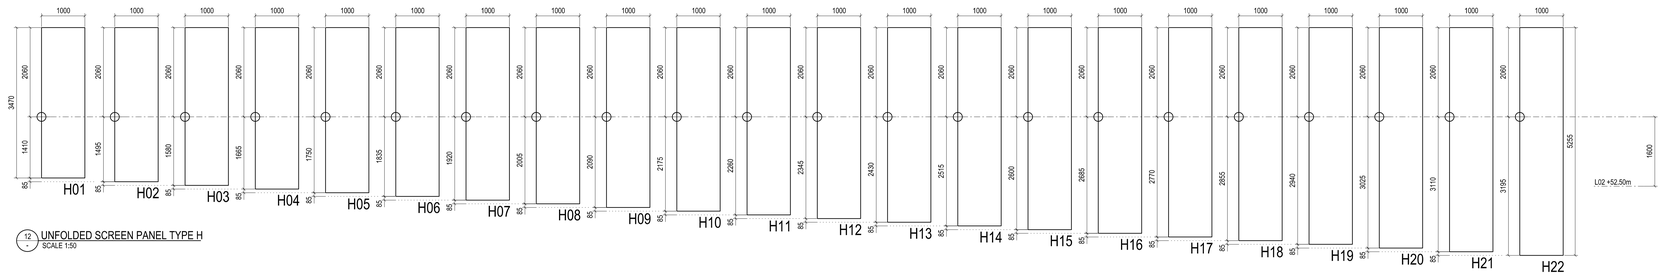

12 UNFOLDED SCREEN PANEL TYPE H
SCALE 1:50

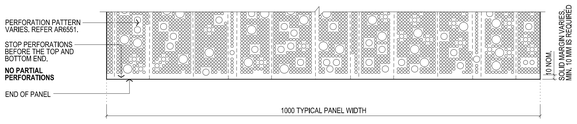

15 TYPICAL PANEL END DETAIL
SCALE 1:5

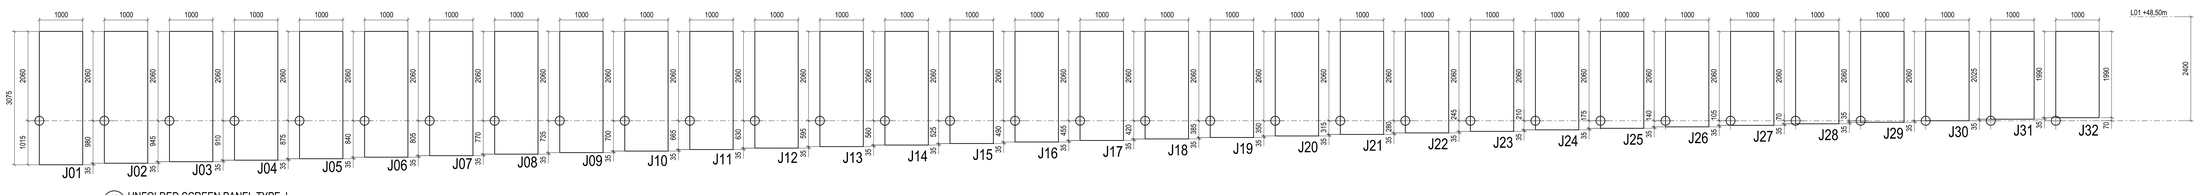

14 UNFOLDED SCREEN PANEL TYPE J
SCALE 1:50

THIS DRAWING IS AN UNCONTROLLED COPY UNLESS STAMPED OTHERWISE

CONTRACTORS SHALL VERIFY JOB DIMENSIONS BEFORE ANY JOB COMMENCES. ALL SHOP DRAWINGS SHALL BE SUBMITTED TO THE SUPERINTENDENT AND MANUFACTURE SHALL NOT COMMENCE PRIOR TO THE RETURN OF UNAMENDED SHOP DRAWINGS SIGNED BY THE CONSULTANT. FIGURED DIMENSIONS SHALL TAKE PRECEDENCE OVER SCALED. THIS DRAWING SHOULD BE READ IN CONJUNCTION WITH ALL RELEVANT CONTRACT, SPECIFICATIONS AND DRAWINGS COPYRIGHT OF THIS DRAWING IS VESTED IN WARDLE

General Notes

Rev	Issue	Revision Description	Amd	Date
B	SG	NEW SCREEN TYPES ADDED	-	13.12.13
A	SG	ISSUE FOR CONSTRUCTION	-	31.10.13
05	SG	VALUE MANAGEMENT ISSUE	-	28.03.13
04	SG	TENDER ADDENDUM 4	-	08.10.12
03	SG	100% CD - TENDER ISSUE	-	07.09.12
02	SG	90% CD ISSUE	-	10.08.12
01	SG	75% CD ISSUE	-	13.07.12

Brookfield MULTIPLEX

NADAAA

NADAAA
1920 Washington Street No.2
Boston
Massachusetts
02118 USA

Telephone
+1 617 442 6232
Facsimile
+1 888 442 1417
Email
nada@nadaaa.com

John Wardle Architects

25 Rokeby Street, Collingwood, Victoria 3066 Australia
Tel : +61 3 8662 0400 www.johnwardlearchitects.com
© 2012 John Wardle Architects ABN 83 006 814 268

Client: University of Melbourne Parkville Campus

Project: Faculty of Architecture Building and Planning

Title: METALWORK DETAILS EXTERNAL SCREENS

Project No. 0913 | Scale 1:10 @ A0, 1:20 @ A2

Drawing No. AR6550 | Revision B

Date Dec 2011 | Drwn - | Co-Ord - | Chck -

FILENAME - $FILE$

FOR CONSTRUCTION