


THIS DRAWING IS AN UNCONTROLLED COPY UNLESS STAMPED OTHERWISE

CONTRACTORS SHALL VERIFY JOB DIMENSIONS BEFORE ANY JOB COMMENCES.
ALL SHOP DRAWINGS SHALL BE SUBMITTED TO THE SUPERINTENDENT AND MANUFACTURER
SHALL NOT COMMENCE PRIOR TO THE RETURN OF DIMENSIONS SHOP DRAWINGS REVIEWED
BY THE CONSULTANT FIGURED DIMENSIONS SHALL TAKE PRECEDENCE OVER SCALED. THIS
DRAWING SHALL BE READ IN CONJUNCTION WITH ALL RELEVANT CONTRACT SPECIFICATIONS
AND DRAWINGS COPYRIGHT OF THIS DRAWING IS VESTED IN WARDLE

General Notes

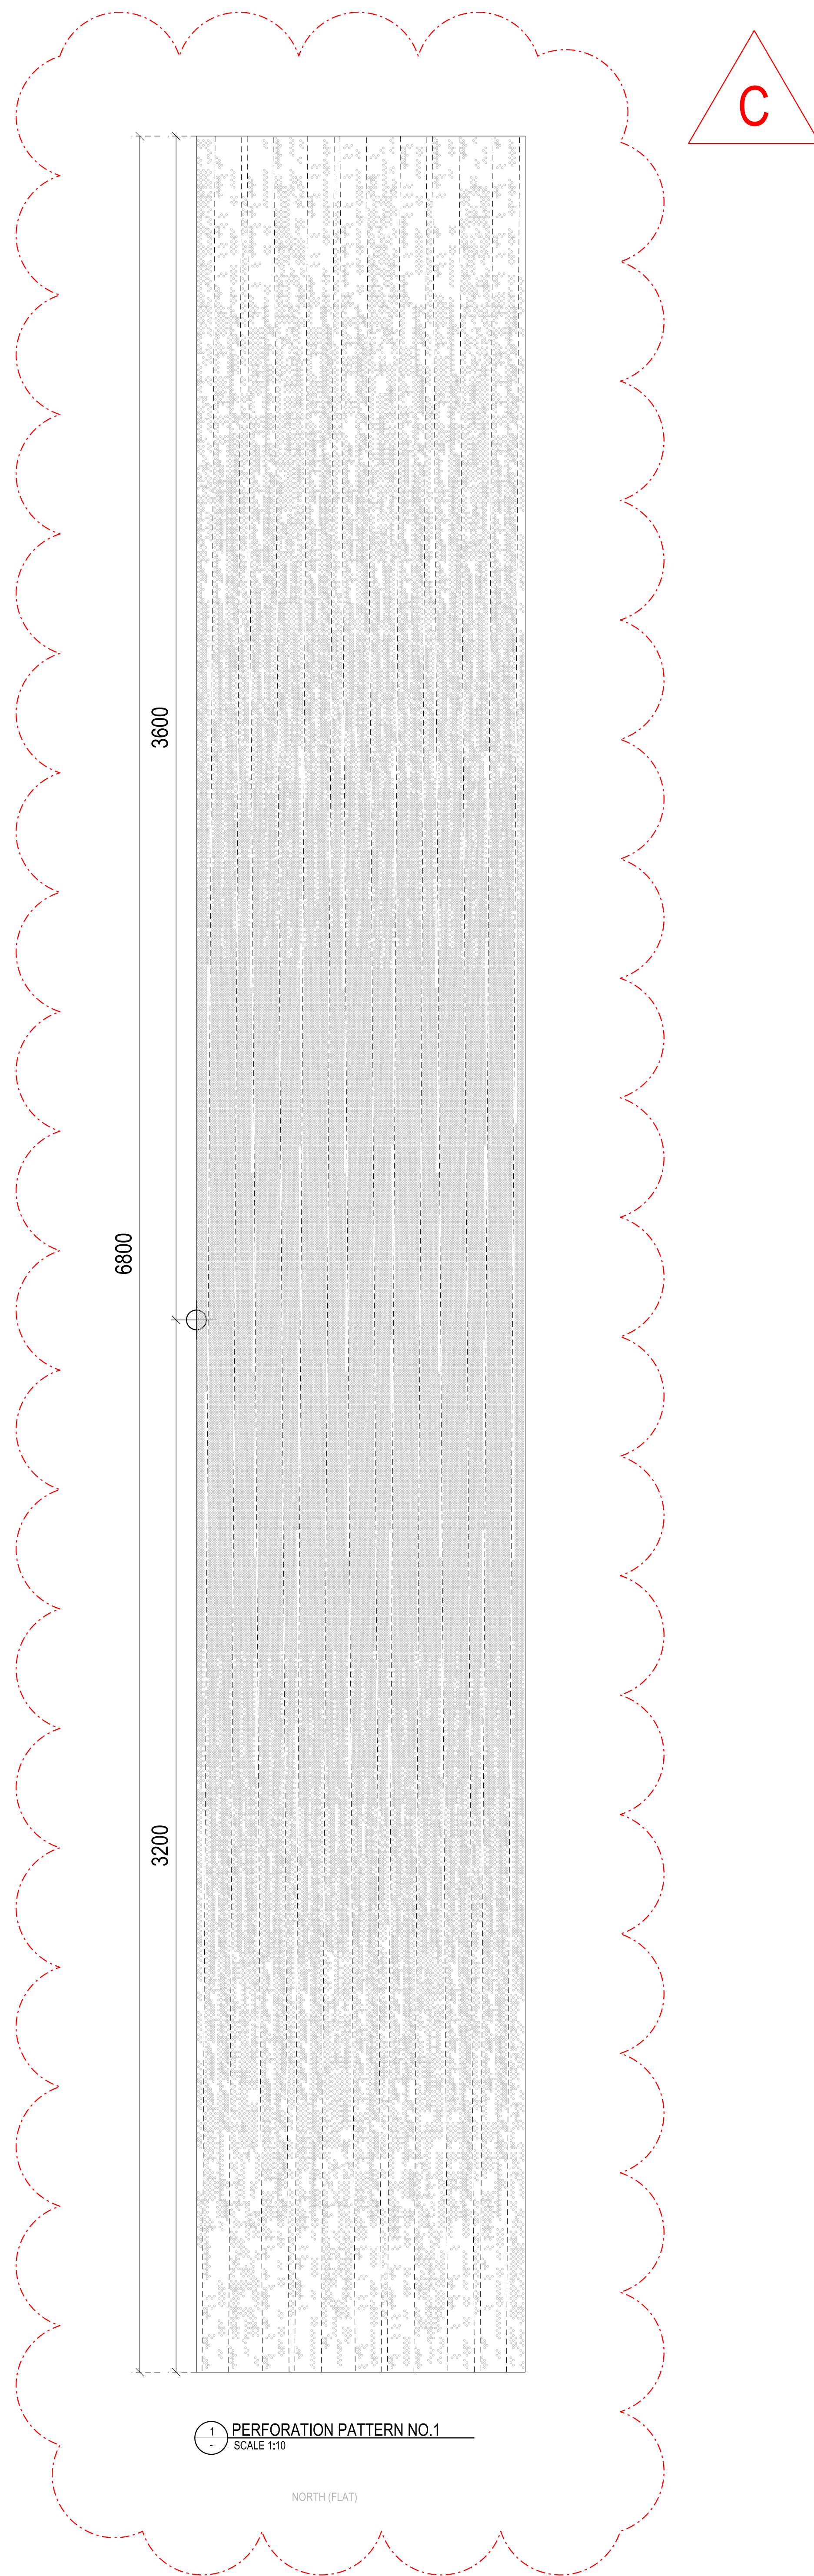

3600

6800

3200

C

PERFORATION PATTERN NO.1
SCALE 1:10

NORTH (FLAT)

Rev	Issue	Revision Description	Amd	Date
C	SG	PATTERN REVISED	-	03.12.13
B	SG	ISSUE FOR CONSTRUCTION - UPDATE	-	22.11.13
A	SG	ISSUE FOR CONSTRUCTION	-	18.11.13

Rev	Issue	Revision Description	Amd	Date
C	SG	PATTERN REVISED	-	03.12.13
B	SG	ISSUE FOR CONSTRUCTION - UPDATE	-	22.11.13
A	SG	ISSUE FOR CONSTRUCTION	-	18.11.13



NADAAA

NADAAA
1520 Washington
Street No.2
Boston
Massachusetts
02118 USA
Telephone
+1 817 442 8232
Facsimile
+1 888 442 1417
Email
nadaaa@nadaaa.com



25 Rokeby Street, Collingwood, Victoria 3066 Australia
Tel : +61 3 8662 0400
www.johnwardlearchitects.com
© 2012 John Wardle Architects ABN 83 006 814 268

Client
**University of Melbourne
Parkville Campus**

Project
**Faculty of Architecture
Building and Planning**

Title
**METALWORK DETAILS
PERFORATION PATTERN NO. 1**

Project No.	0913	Scale	1:10 @ A0 1:20 @ A2
Drawing No.	AR6560	Revision	C

Date	Dec 2011	Dwn	-	Co-Ord	-	Chk	-
------	----------	-----	---	--------	---	-----	---

FILENAME - \$FILES

FOR CONSTRUCTION