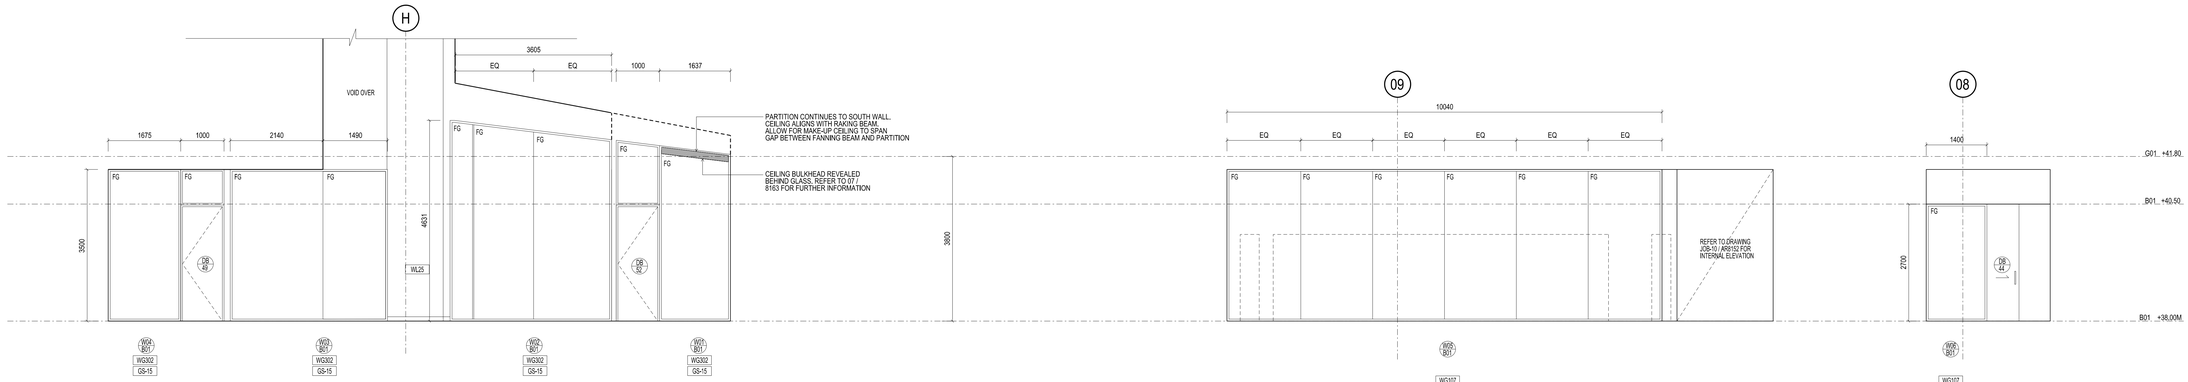

01 B134, B135, AND B136 OFFICE PROJECT ROOMS - EAST ELEVATION
SCALE 1:50

02 B131 LIBRARY OPEN COMPACTUS - NORTH ELEVATION
SCALE 1:50

03 B132 LINRARY PRINT / COPY - NORTH ELEVATION
SCALE 1:50

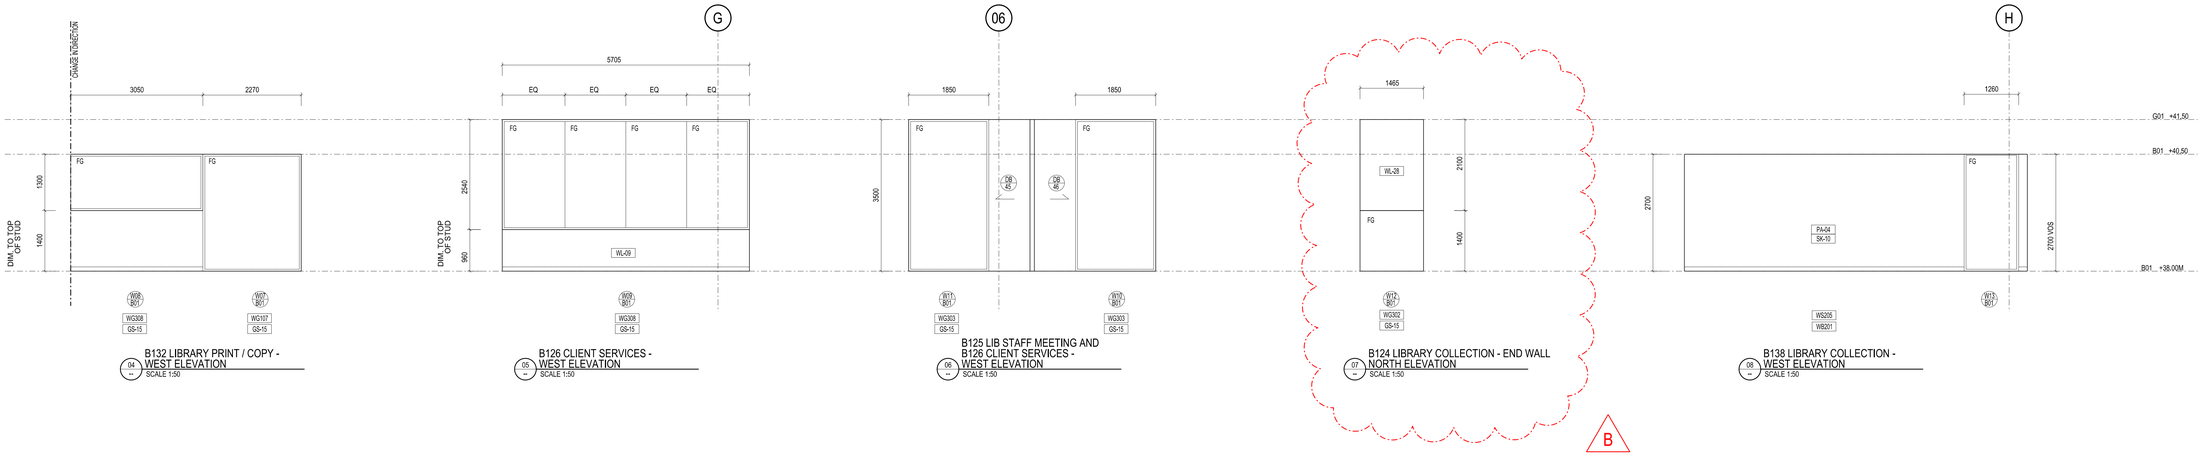

04 B132 LIBRARY PRINT / COPY - WEST ELEVATION
SCALE 1:50

05 B126 CLIENT SERVICES - WEST ELEVATION
SCALE 1:50

06 B125 LIB STAFF MEETING AND B126 CLIENT SERVICES - WEST ELEVATION
SCALE 1:50

07 B124 LIBRARY COLLECTION - END WALL NORTH ELEVATION
SCALE 1:50

08 B138 LIBRARY COLLECTION - WEST ELEVATION
SCALE 1:50

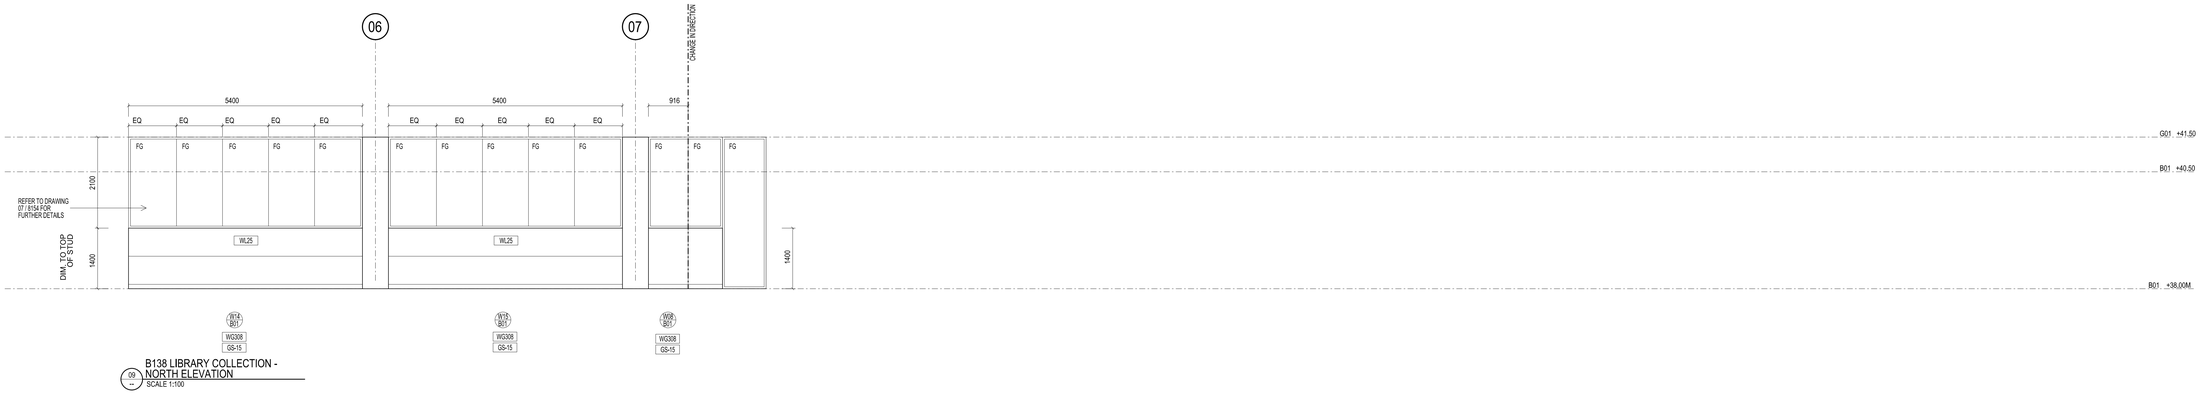

09 B138 LIBRARY COLLECTION - NORTH ELEVATION
SCALE 1:100

B

THIS DRAWING IS AN UNCONTROLLED COPY UNLESS STAMPED OTHERWISE

CONTRACTORS SHALL VERIFY JOB DIMENSIONS BEFORE ANY JOB COMMENCES.
ALL SHOP DRAWINGS SHALL BE SUBMITTED TO THE SUPERINTENDENT AND MANUFACTURE SHALL NOT COMMENCE PRIOR TO THE RETURN OF UNMARKNDED SHOP DRAWINGS SIGNED BY THE CONSULTANT. FIGURED DIMENSIONS SHALL TAKE PRECEDENCE OVER SCALED. THIS DRAWING SHOULD BE READ IN CONJUNCTION WITH ALL RELEVANT CONTRACT, SPECIFICATIONS AND DRAWINGS COPYRIGHT OF THIS DRAWING IS VESTED IN WARDLE

General Notes

REFER TO WINDOW SCHEDULE FOR FURTHER DETAILS

Rev	Issue	Revision Description	Amd	Date
B	SG	AMENDMENTS AS CLOUDED	--	20.11.13
A	SG	ISSUE FOR CONSTRUCTION	--	13.11.13

Brookfield MULTIPLEX

NADAAA

NADAAA
1920 Washington Street No.2
Boston
Massachusetts
02118 USA

Telephone
+1 617 442 6232
Facsimile
+1 888 442 1417
Email
nada@nadaaa.com

John Wardle Architects

25 Rokeby Street, Collingwood, Victoria 3066 Australia
Tel : +61 3 8662 0400 www.johnwardlearchitects.com

© 2012 John Wardle Architects ABN 83 006 814 268

Client
University of Melbourne
Parkville Campus

Project
Faculty of Architecture
Building and Planning

Title
INTERNAL ELEVATIONS
B01 LIBRARY

Project No. 0913			Scale 1:50 @ A0 1:100 @ A1
Drawing No. AR 7108			Revision B
Date NOV 2013	Drwn -	Co-Ord -	Chck -

FILENAME - $FILES

FOR CONSTRUCTION