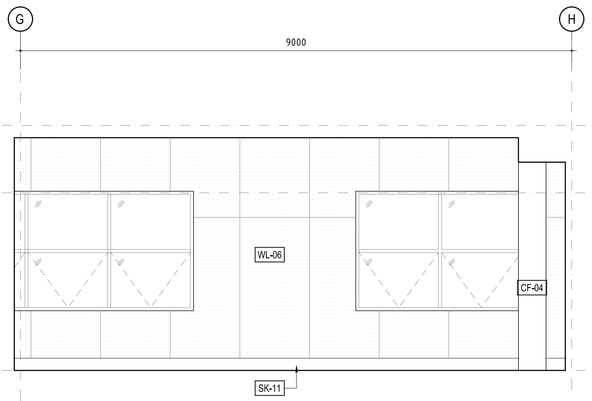

12 STUDIO (236) - EAST ELEVATION
SCALE 1:50

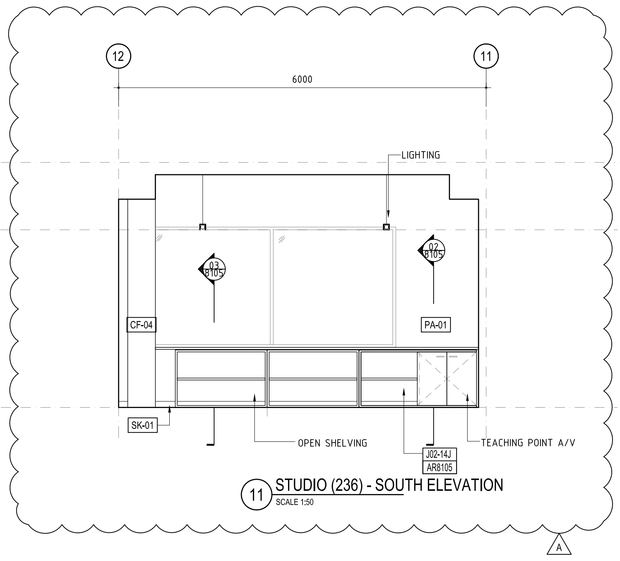

11 STUDIO (236) - SOUTH ELEVATION
SCALE 1:50

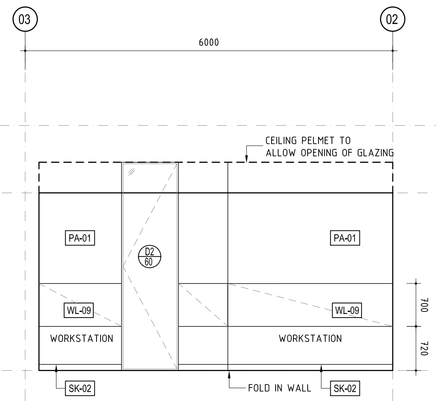

10 WORKSPACE (205) - SOUTH ELEVATION
SCALE 1:50

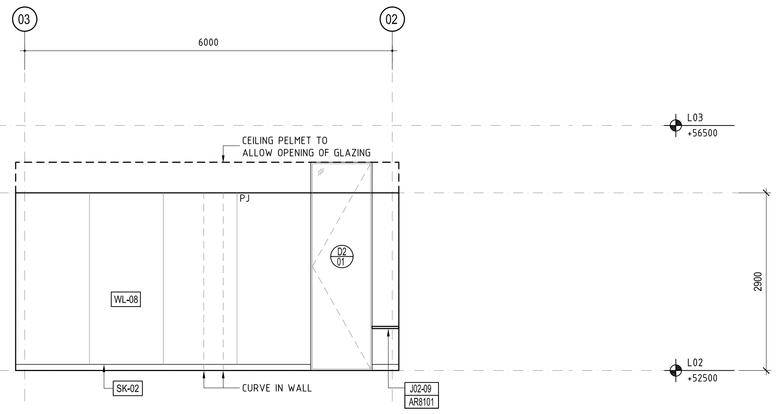

09 MEETING SPACE (201) - SOUTH ELEVATION
SCALE 1:50

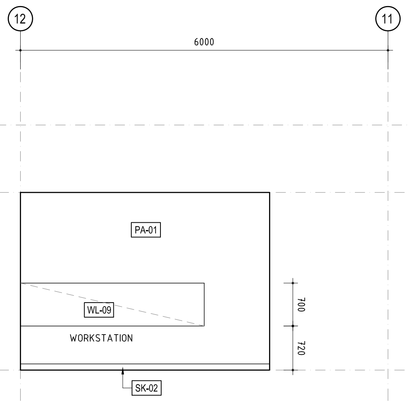

08 WORKSPACE (224) - SOUTH ELEVATION
SCALE 1:50

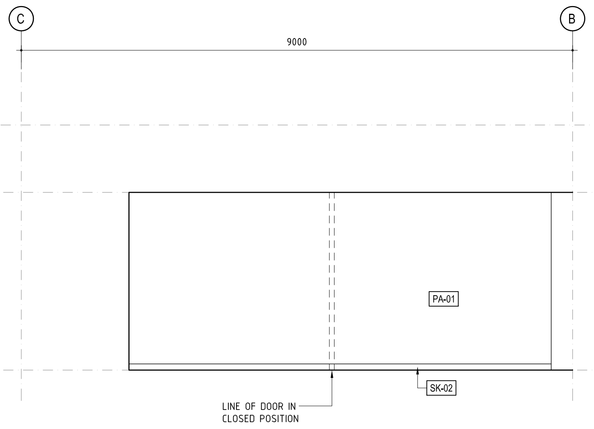

07 WORKSPACES (220/225) - WEST ELEVATION
SCALE 1:50

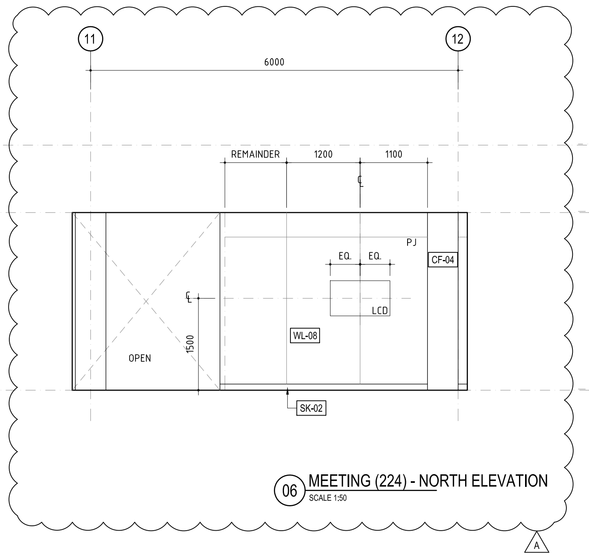

06 MEETING (224) - NORTH ELEVATION
SCALE 1:50

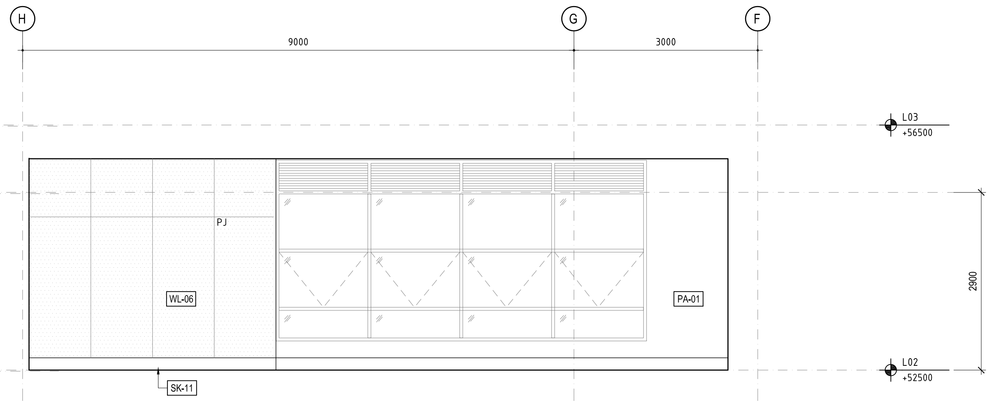

05 CAD LAB (246) - WEST ELEVATION
SCALE 1:50

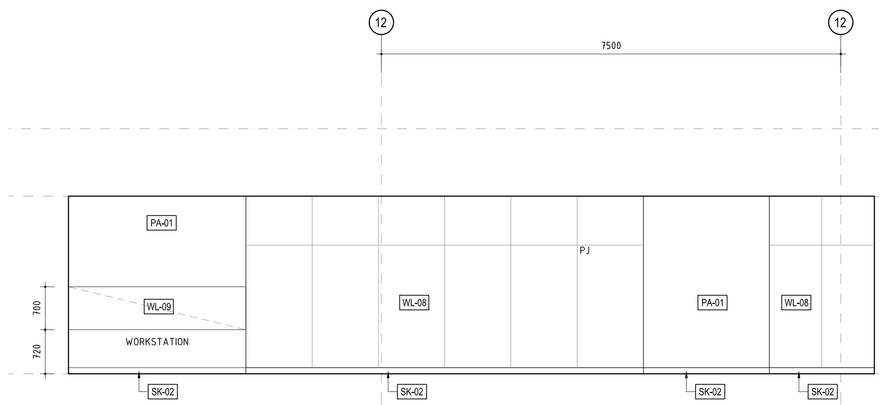

04 WORKSPACE (218) - EAST ELEVATION
SCALE 1:50

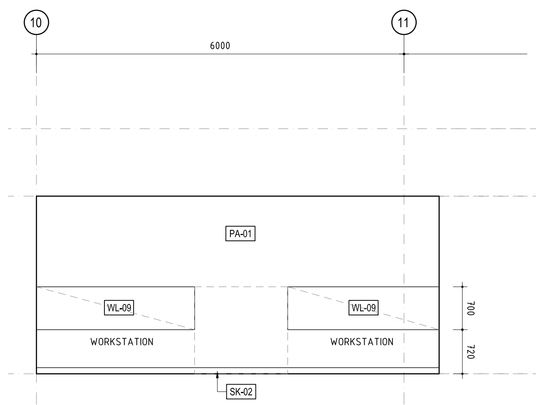

03 WORKSPACE (218) - NORTH ELEVATION
SCALE 1:50

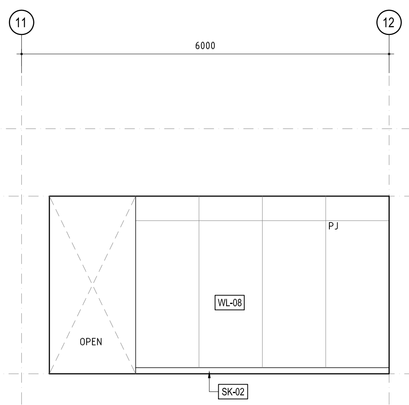

02 WORKSPACE (220) - NORTH ELEVATION
SCALE 1:50

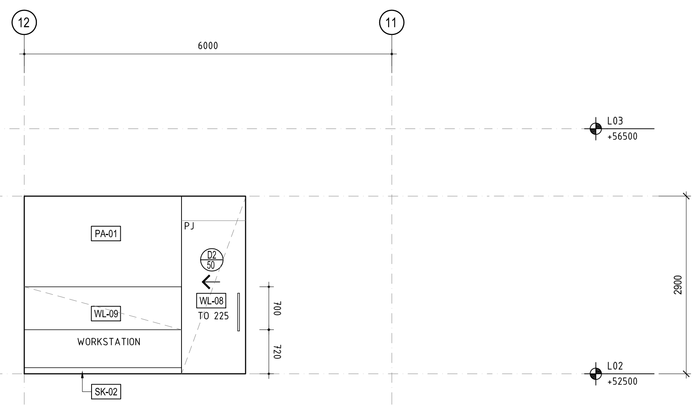

01 WORKSPACE (220) - SOUTH ELEVATION
SCALE 1:50

THIS DRAWING IS AN UNCONTROLLED COPY UNLESS STAMPED OTHERWISE

CONTRACTORS SHALL VERIFY JOB DIMENSIONS BEFORE ANY JOB COMMENCES.
ALL SHOP DRAWINGS SHALL BE SUBMITTED TO THE SUPERINTENDENT AND MANUFACTURE SHALL NOT COMMENCE PRIOR TO THE RETURN OF UNMARKNDED SHOP DRAWINGS SIGNED BY THE CONSULTANT. FIGURED DIMENSIONS SHALL TAKE PRECEDENCE OVER SCALED, THIS DRAWING SHOULD BE READ IN CONJUNCTION WITH ALL RELEVANT CONTRACT, SPECIFICATIONS AND DRAWINGS COPYRIGHT OF THIS DRAWING IS VESTED IN WARDLE

General Notes

Rev	Issue	Revision Description	Amd	Date
A	SG	CONSTRUCTION ISSUE	-	19.12.13
04	SG	VALUE MANAGEMENT ISSUE	-	28.03.13
03	JC	100% CD - TENDER ISSUE	-	07.06.12
02	JC	90% CD ISSUE	-	10.08.12
01	JC	75% CD ISSUE	-	13.07.12
		THIS SHEET WAS PREVIOUSLY AR7133		

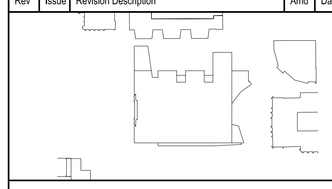

NADAAA

NADAAA
1920 Washington
Street No.2
Boston
Massachusetts
02118 USA

Telephone
+1 617 442 8232
Facsimile
+1 888 442 1417
Email
nada@nadaaa.com

John Wardle Architects

© 2011 John Wardle Architects

Level 10, 180 Russell Street, Melbourne Victoria 3000 Australia
Tel : +613 9654 8700 www.johnwardlearchitects.com

Client
University of Melbourne
Parkville Campus

Project
Faculty of Architecture
Building and Planning

Title
L02
INTERIOR & JOINERY ELEVATIONS

Project No. 0913			Scale 1:50
Drawing No. AR7163			Revision A
Date DEC 2013	Drwn -	Co-Ord -	Chck -

FILENAME - ####

FOR CONSTRUCTION