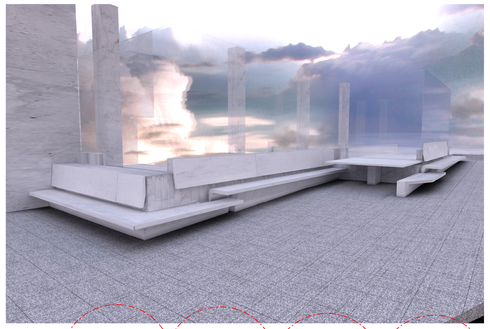

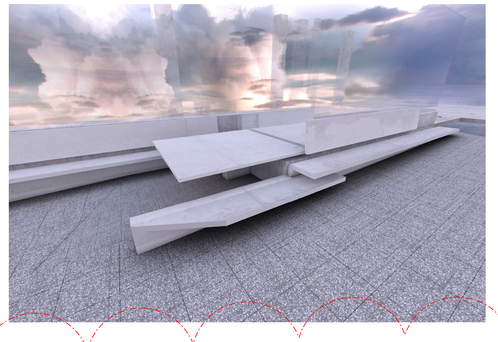

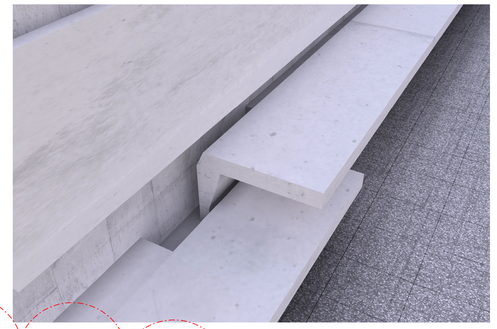

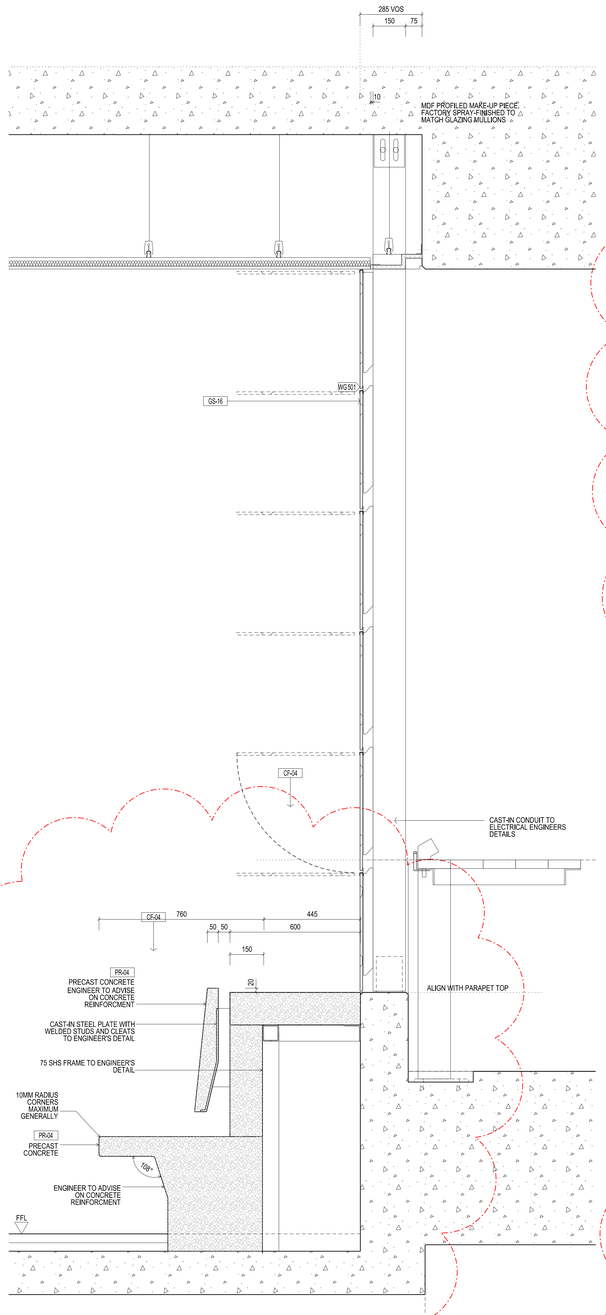

01 7774 DETAIL SECTION
PRECAST CONCRETE BENCH SEAT
SCALE 1:10

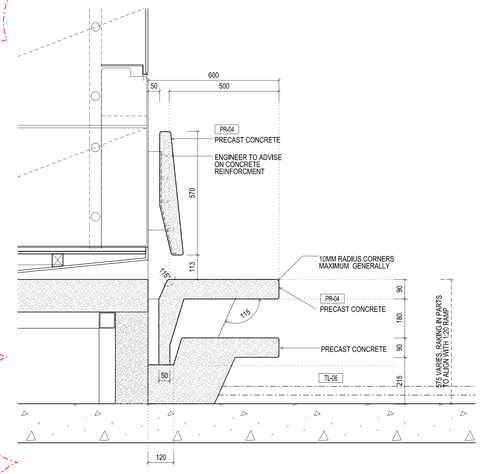

04 7774 DETAIL SECTION
PRECAST CONCRETE BENCH SEAT
SCALE 1:10

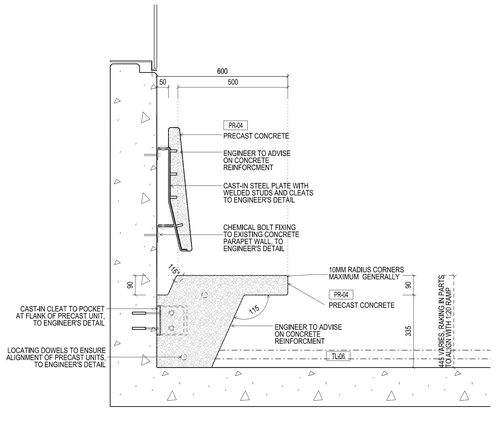

05 7774 DETAIL SECTION
PRECAST CONCRETE BENCH SEAT
SCALE 1:10

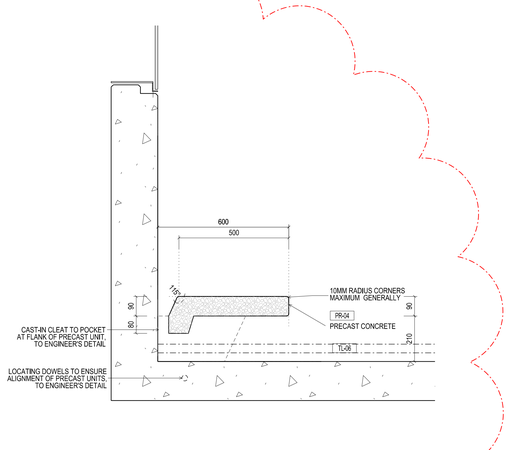

06 7774 DETAIL SECTION
PRECAST CONCRETE BENCH SEAT
SCALE 1:10

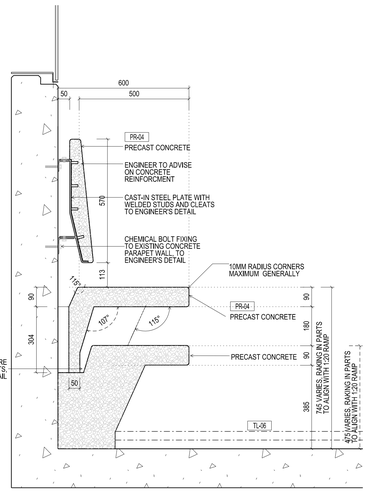

02 7774 DETAIL SECTION
PRECAST CONCRETE BENCH SEAT
SCALE 1:10

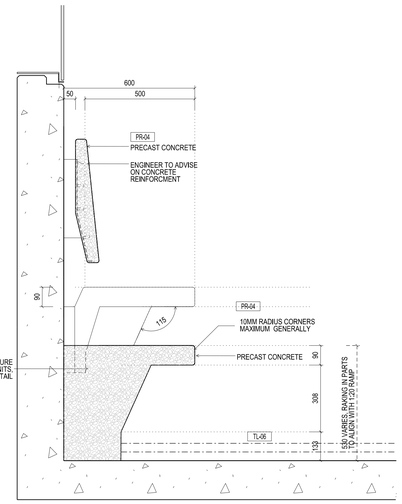

03 7774 DETAIL SECTION
PRECAST CONCRETE BENCH SEAT
SCALE 1:10

A

A

THIS DRAWING IS AN UNCONTROLLED COPY UNLESS STAMPED OTHERWISE

CONTRACTORS SHALL VERIFY JOB DIMENSIONS BEFORE ANY JOB COMMENCES. ALL SHOP DRAWINGS SHALL BE SUBMITTED TO THE SUPERINTENDENT AND MANUFACTURE SHALL NOT COMMENCE PRIOR TO THE RETURN OF UNAMENDED SHOP DRAWINGS SIGNED BY THE CONSULTANT. FIGURED DIMENSIONS SHALL TAKE PRECEDENCE OVER SCALED. THIS DRAWING SHOULD BE READ IN CONJUNCTION WITH ALL RELEVANT CONTRACT, SPECIFICATIONS AND DRAWINGS COPYRIGHT OF THIS DRAWING IS VESTED IN WARDLE

General Notes

Rev	Issue	Revision Description	Amd	Date
A	SG	FOR CONSTRUCTION		
	JA	ADJ GLAZING LINE, ADJ CONC PROFILES	JL	06.12.13
02	SG	100% CD - TENDER ISSUE	-	07.09.12
01	SG	90% CD ISSUE	-	10.08.12

Brookfield MULTIPLEX

NADAAA

NADAAA
1920 Washington Street No.2 Boston Massachusetts 02118 USA

Telephone +1 617 442 6232
Facsimile +1 888 442 1417
Email nada@nadaaa.com

John Wardle Architects

25 Rokeby Street, Collingwood, Victoria 3066 Australia
Tel : +61 3 8662 0400 www.johnwardlearchitects.com

© 2012 John Wardle Architects ABN 83 006 814 268

Client: University of Melbourne Parkville Campus

Project: Faculty of Architecture Building and Planning

Title: INTERNAL WALL SECTION DETAILS Ground Floor - SHEET 1

Project No. 0913 | Scale 1:10 @ A0, 1:20 @ A2

Drawing No. AR 7770 | Revision A

Date Jul 2012 | Drwn - | Co-Ord - | Chck -

FILENAME - $FILES

FOR CONSTRUCTION