THIS DRAWING IS AN UNCONTROLLED COPY UNLESS STAMPED OTHERWISE

CONTRACTORS SHALL VERIFY JOB DIMENSIONS BEFORE ANY JOB COMMENCES.
ALL SHOP DRAWINGS SHALL BE SUBMITTED TO THE SUPERINTENDENT AND MANUFACTURE SHALL NOT COMMENCE PRIOR TO THE RETURN OF UNMARKNDED SHOP DRAWINGS SIGNED BY THE CONSULTANT. FIGURED DIMENSIONS SHALL TAKE PRECEDENCE OVER SCALED. THIS DRAWING SHOULD BE READ IN CONJUNCTION WITH ALL RELEVANT CONTRACT, SPECIFICATIONS AND DRAWINGS COPYRIGHT OF THIS DRAWING IS VESTED IN WARDLE

General Notes

SEE SERVICE ENGINEERING DRAWINGS FOR ALL FIXTURE SPECIFICATIONS

07 REMOVED
SCALE: 1:20

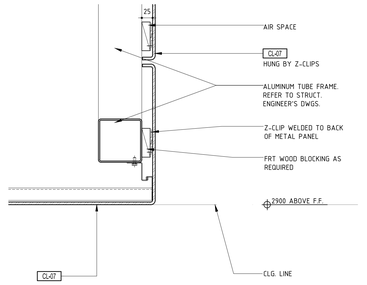

10 REMOVED
SCALE: 1:5

06 SECT DET - CL-04 MEETS CL-07, TYPICAL, L04
SCALE: 1:5

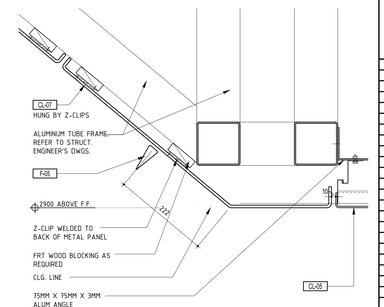

03 SECT DET - CL-04 MEETS CL-07, TYPICAL, L04
SCALE: 1:5

09 REMOVED
SCALE: 1:5

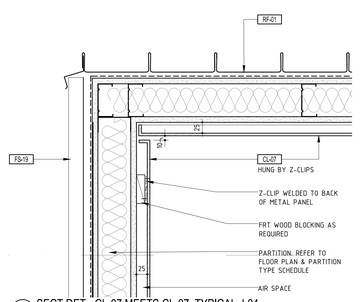

05 SECT DET - CL-07 MEETS CL-07, TYPICAL, L04
SCALE: 1:5

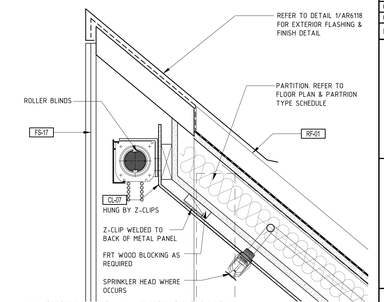

02 SECT DET - CL-07 AT TOP OF SKYLIGHT
SCALE: 1:5

08 REMOVED
SCALE: 1:5

04 REMOVED
SCALE: 1:5

01 REMOVED
SCALE: 1:5

Rev	Issue	Revision Description	Amd	Date
B	SG	CONSTRUCTION ISSUE	-	24.01.13
A	SG	CONSTRUCTION ISSUE	-	19.12.13
03	SG	VALUE MANAGEMENT	-	28.03.13
02	JC	100% CD – TENDER ISSUE	-	07.09.12
01	JC	90% CD ISSUE	-	10.08.12

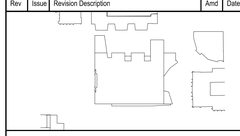

NADAAA

NADAAA
1920 Washington Street No.2
Boston
Massachusetts
02118 USA

Telephone
+1 617 442 6232
Facsimile
+1 888 442 1417
Email
nada@nadaaa.com

John Wardle Architects

Level 10, 180 Russell Street, Melbourne Victoria 3000 Australia
Tel : +613 9654 8700 www.johnwardlearchitects.com

© 2011 John Wardle Architects

Client
University of Melbourne
Parkville Campus

Project
Faculty of Architecture
Building and Planning

Title
TYPICAL CEILING FINISH DETAILS

Project No. 0913
Scale 1:5
Drawing No. AR7802
Revision B
Date JAN 2014
Drwn -
Co-Ord -
Chck -

FILENAME - ####

FOR CONSTRUCTION