


R/133.6607

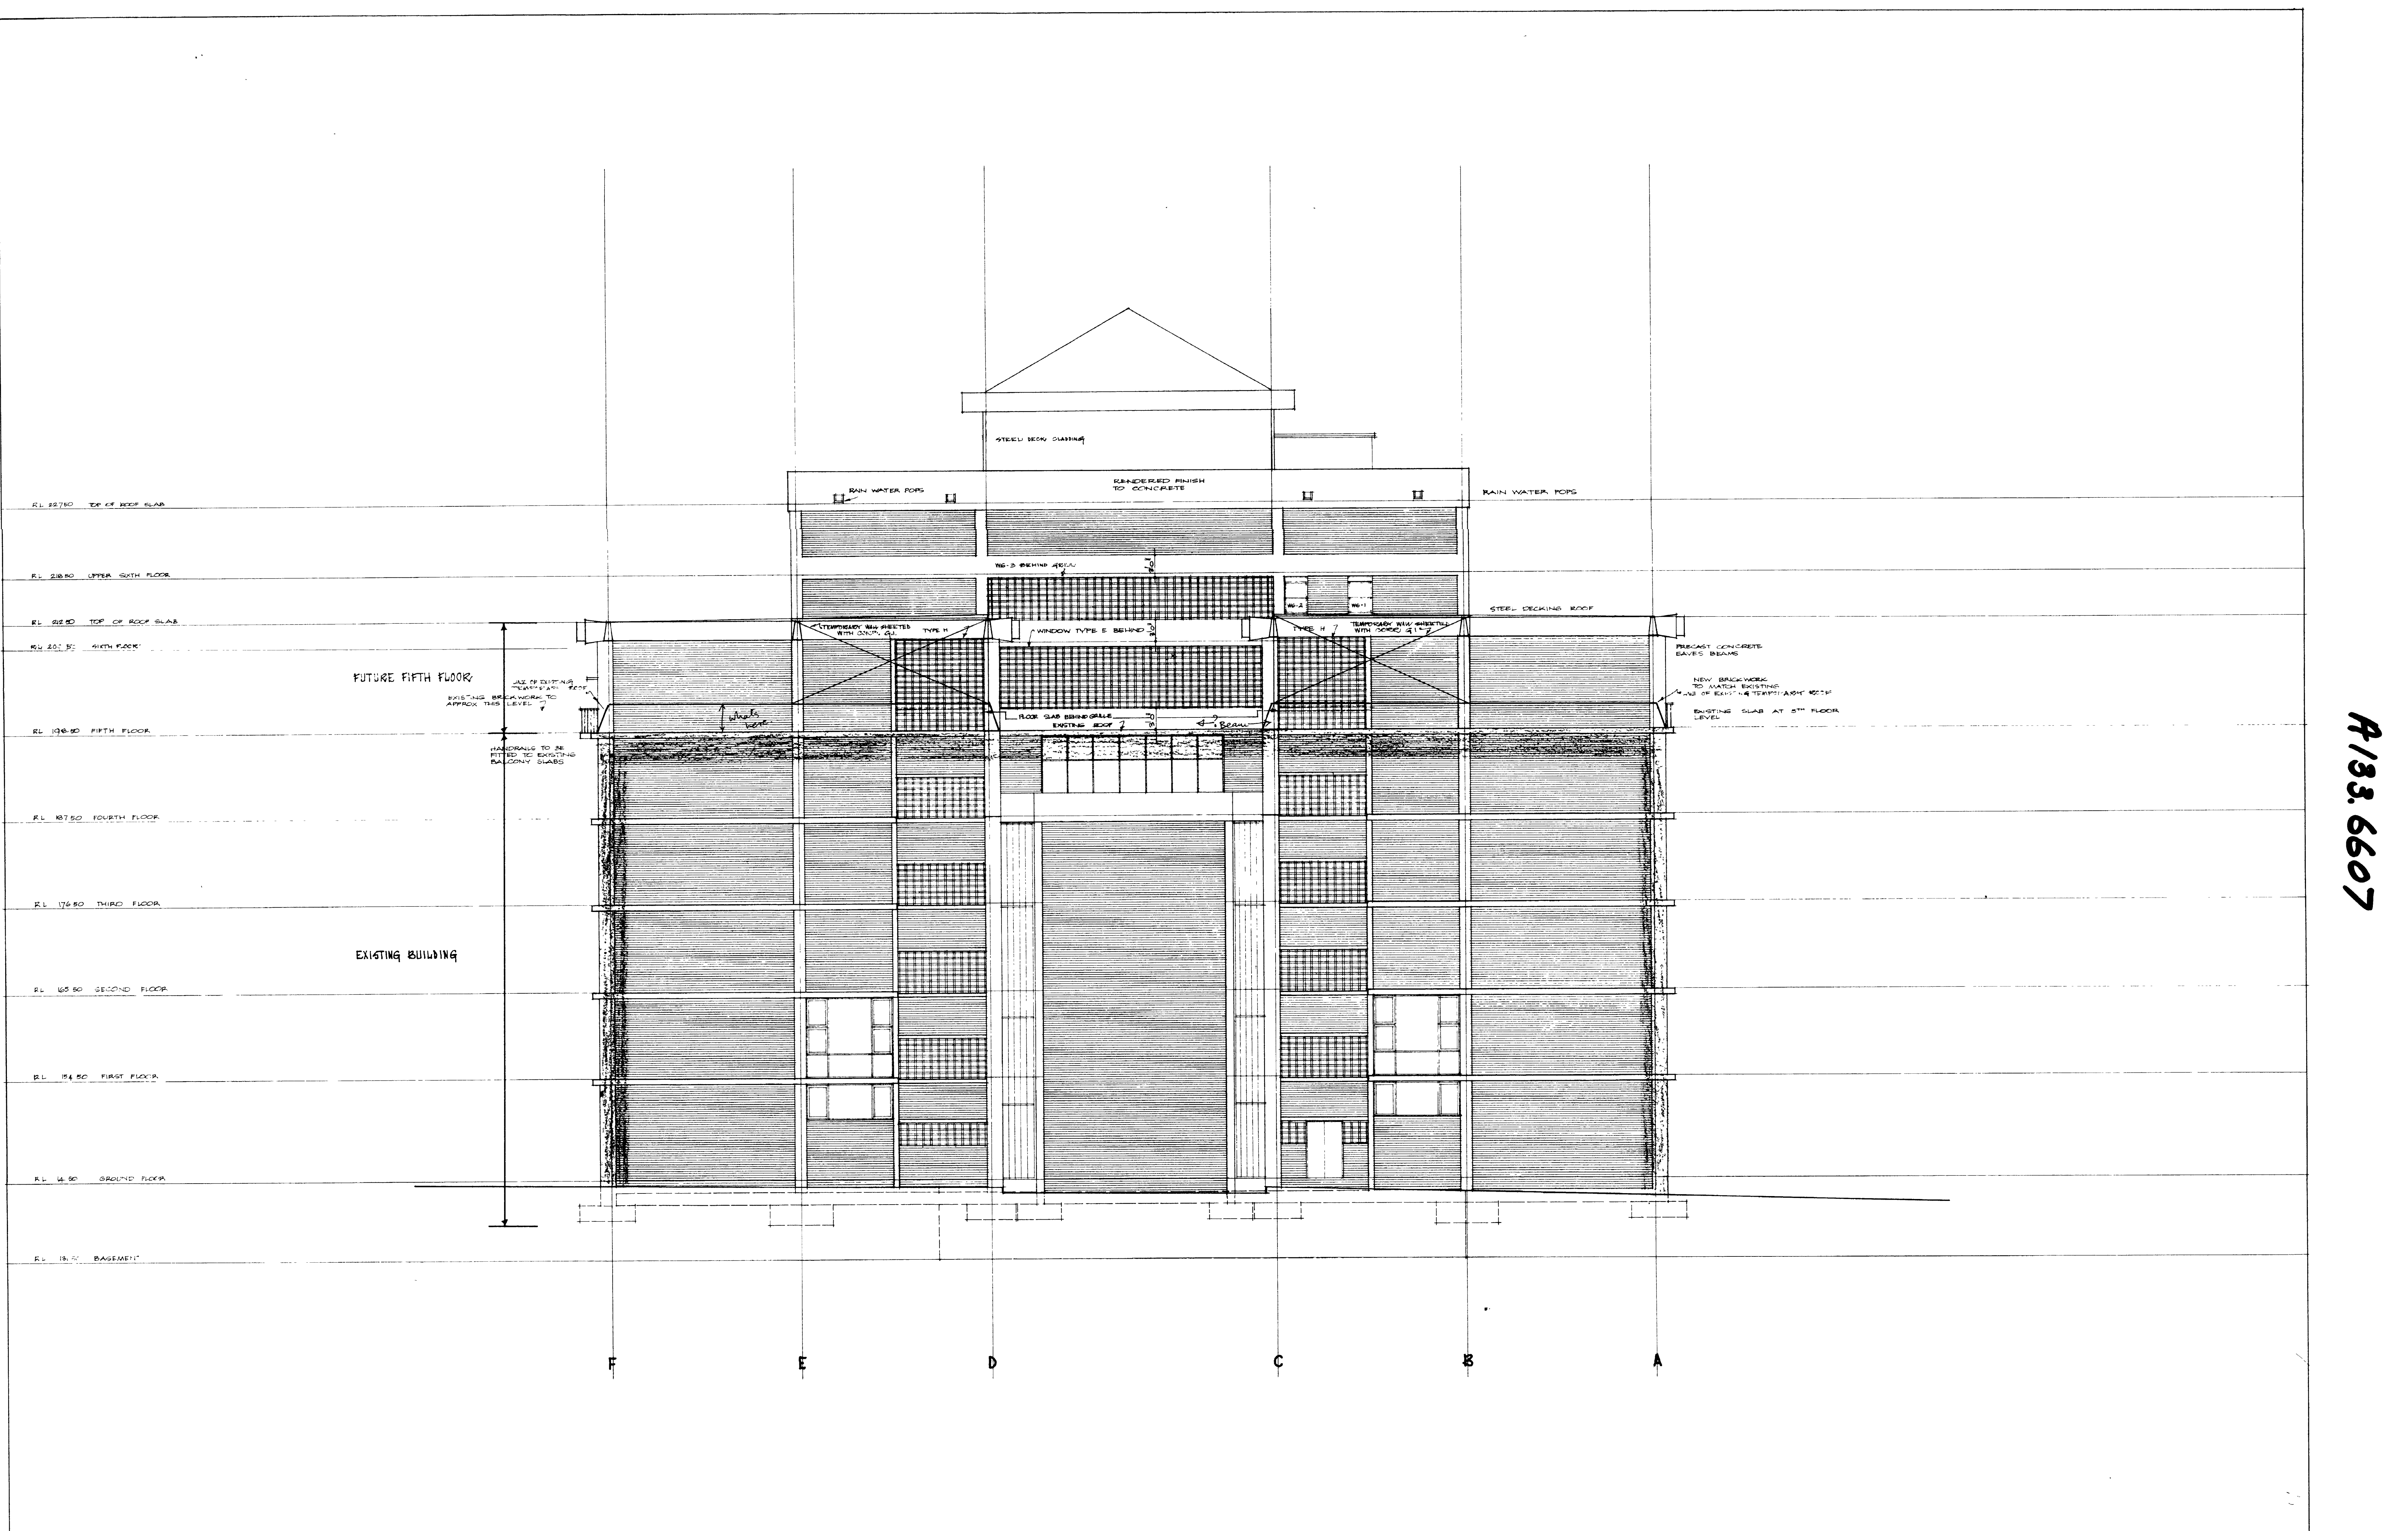

FIGURED DIMENSIONS TO BE TAKEN IN PREFERENCE TO SCALE.  
 CONTRACTOR MUST VERIFY ALL DIMENSIONS ON THE JOB.  
 CONTRACTOR TO OBTAIN ARCHITECTS' WRITTEN APPROVAL BEFORE PROCEEDING WITH EXTRAS OR VARIATIONS.

AMENDMENTS	DATE	ISSUED	DATE

DESIGNING ARCHITECT PROFESSOR BRIAN B. LEWIS  
 SUPERVISING ARCHITECT EGGLESTON, MACDONALD & SECOMB  
 215 GRATTAN STREET CARLTON 34 1624

UNIVERSITY OF MELBOURNE  
**EAST BUILDING**  
 WEST ELEVATION

JOB No 1754  
 SCALE 1/8"=1'-0"  
 DRAWN KW  
 DATE APRIL 1960