


ABP.
JAPANESE ROOM
TILE MURAL
FIRE ESCAPE STAIRS.

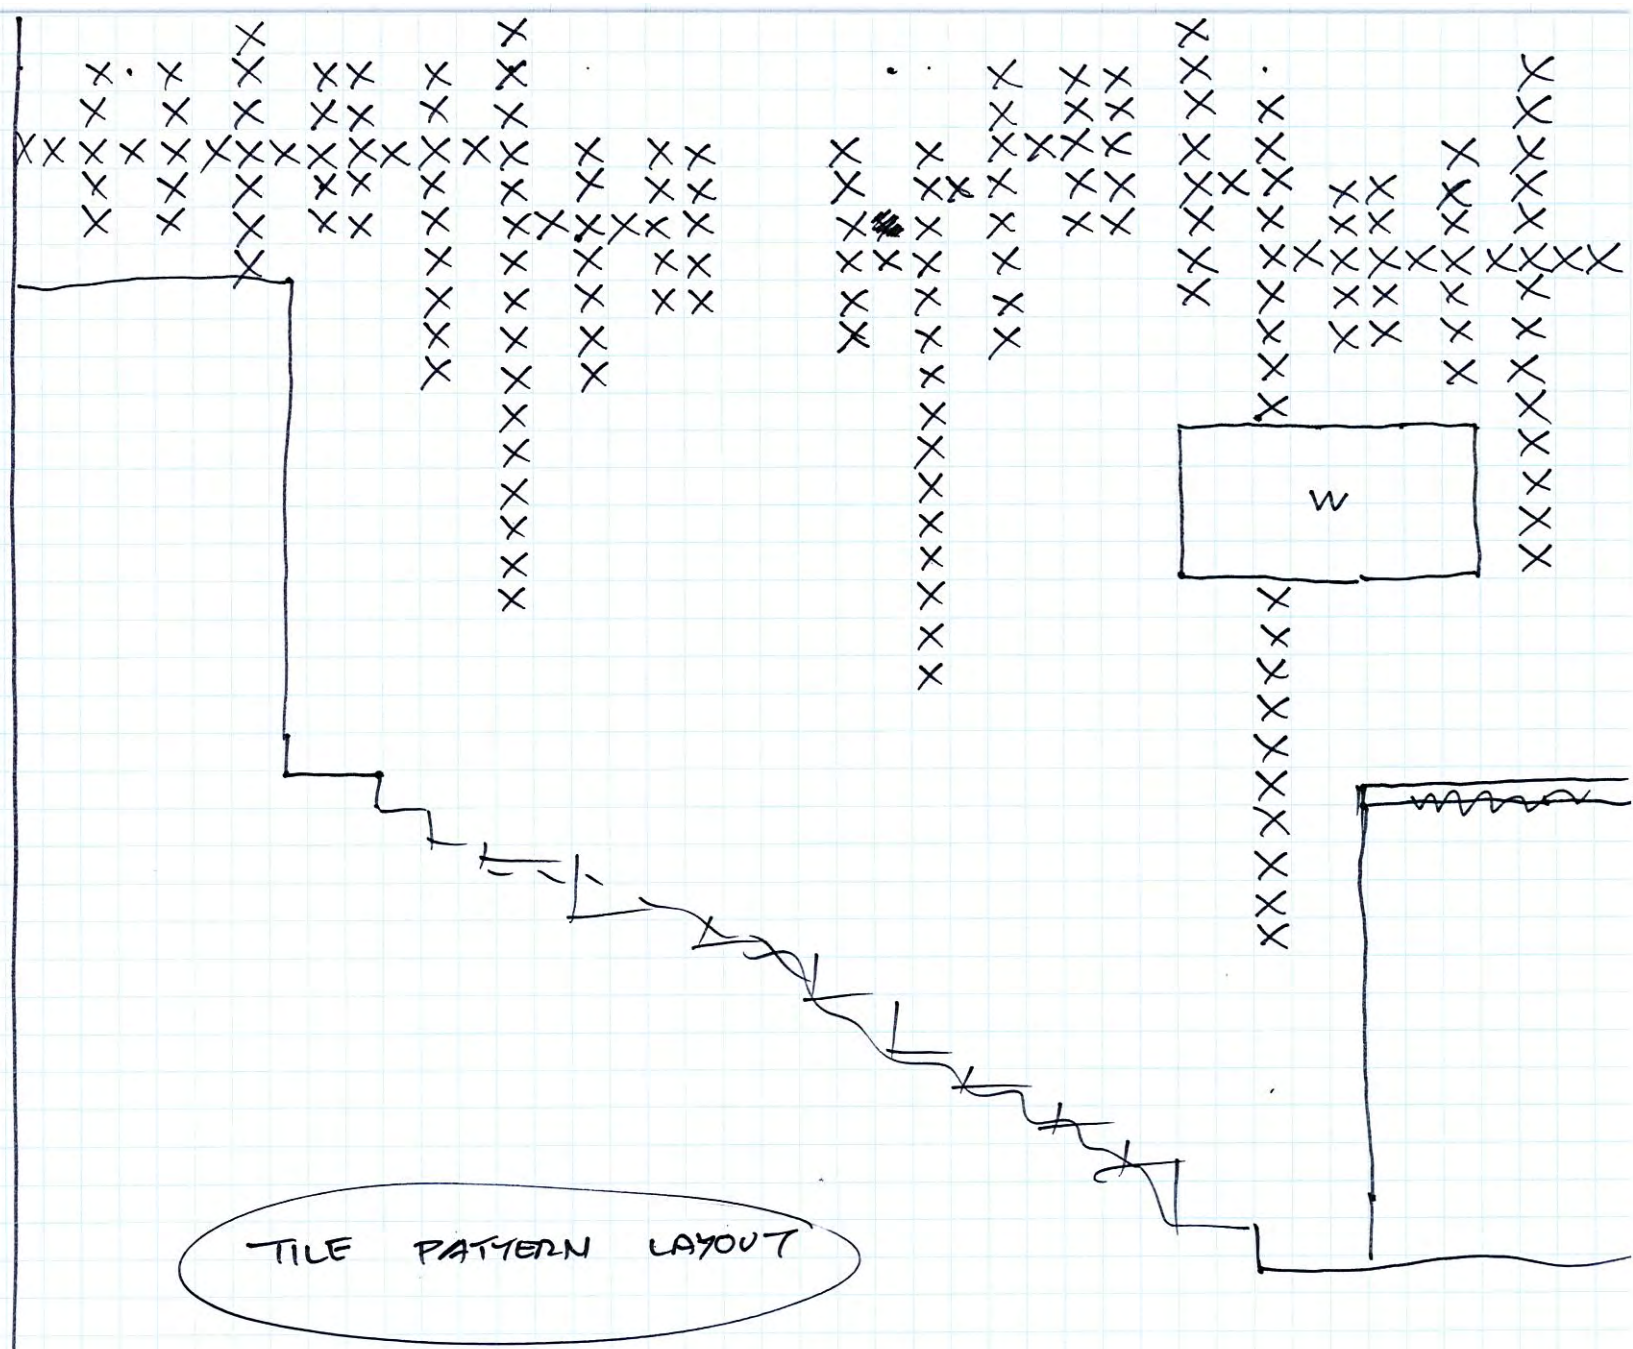


TILE PATTERN LAYOUT

PETER ASHFORD.


22/11/12.
SHEET 1/3.

ABP - JAPANESE ROOM
 TILE MURAL
 FIRE ESCAPE STAIR

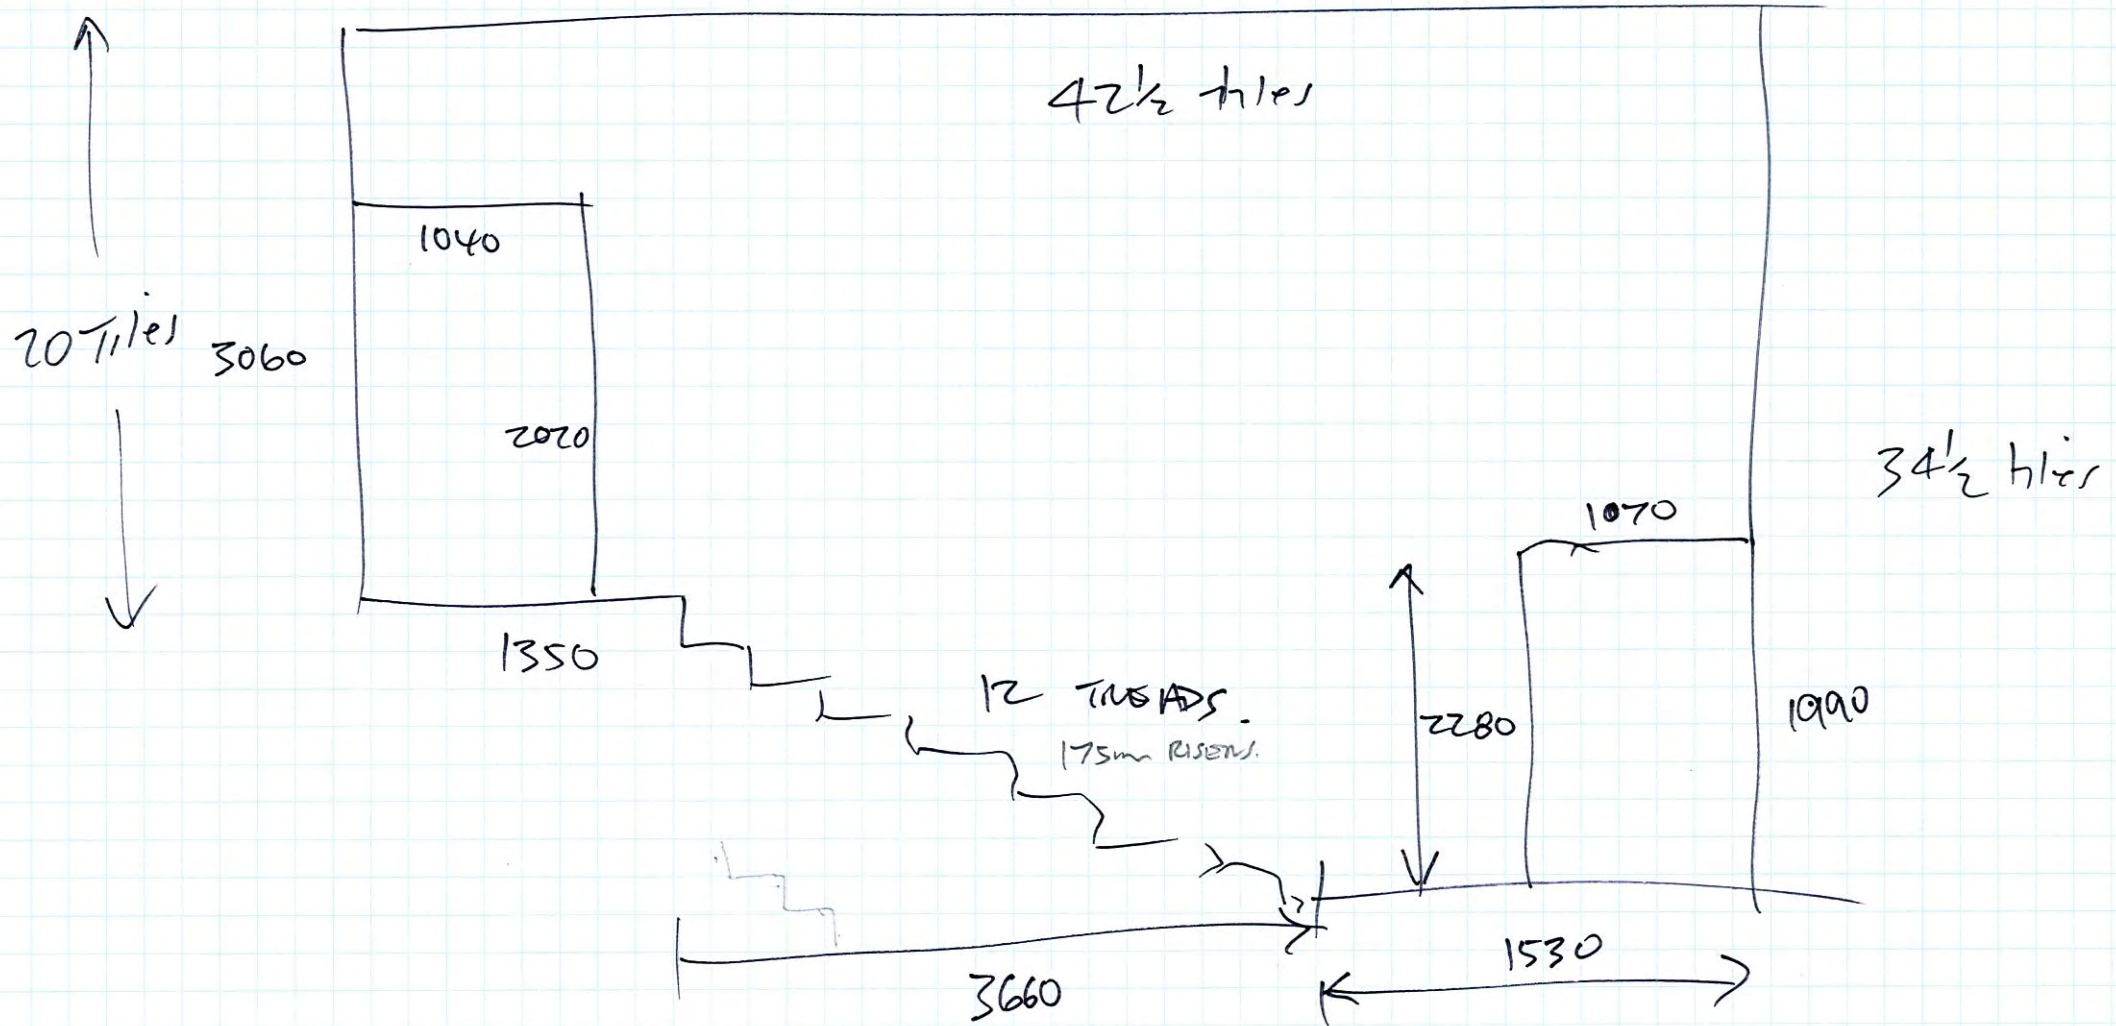

153 mm / tile incl. gaps.

* TILE GRID NUMBERS ≠ DIMENSIONS

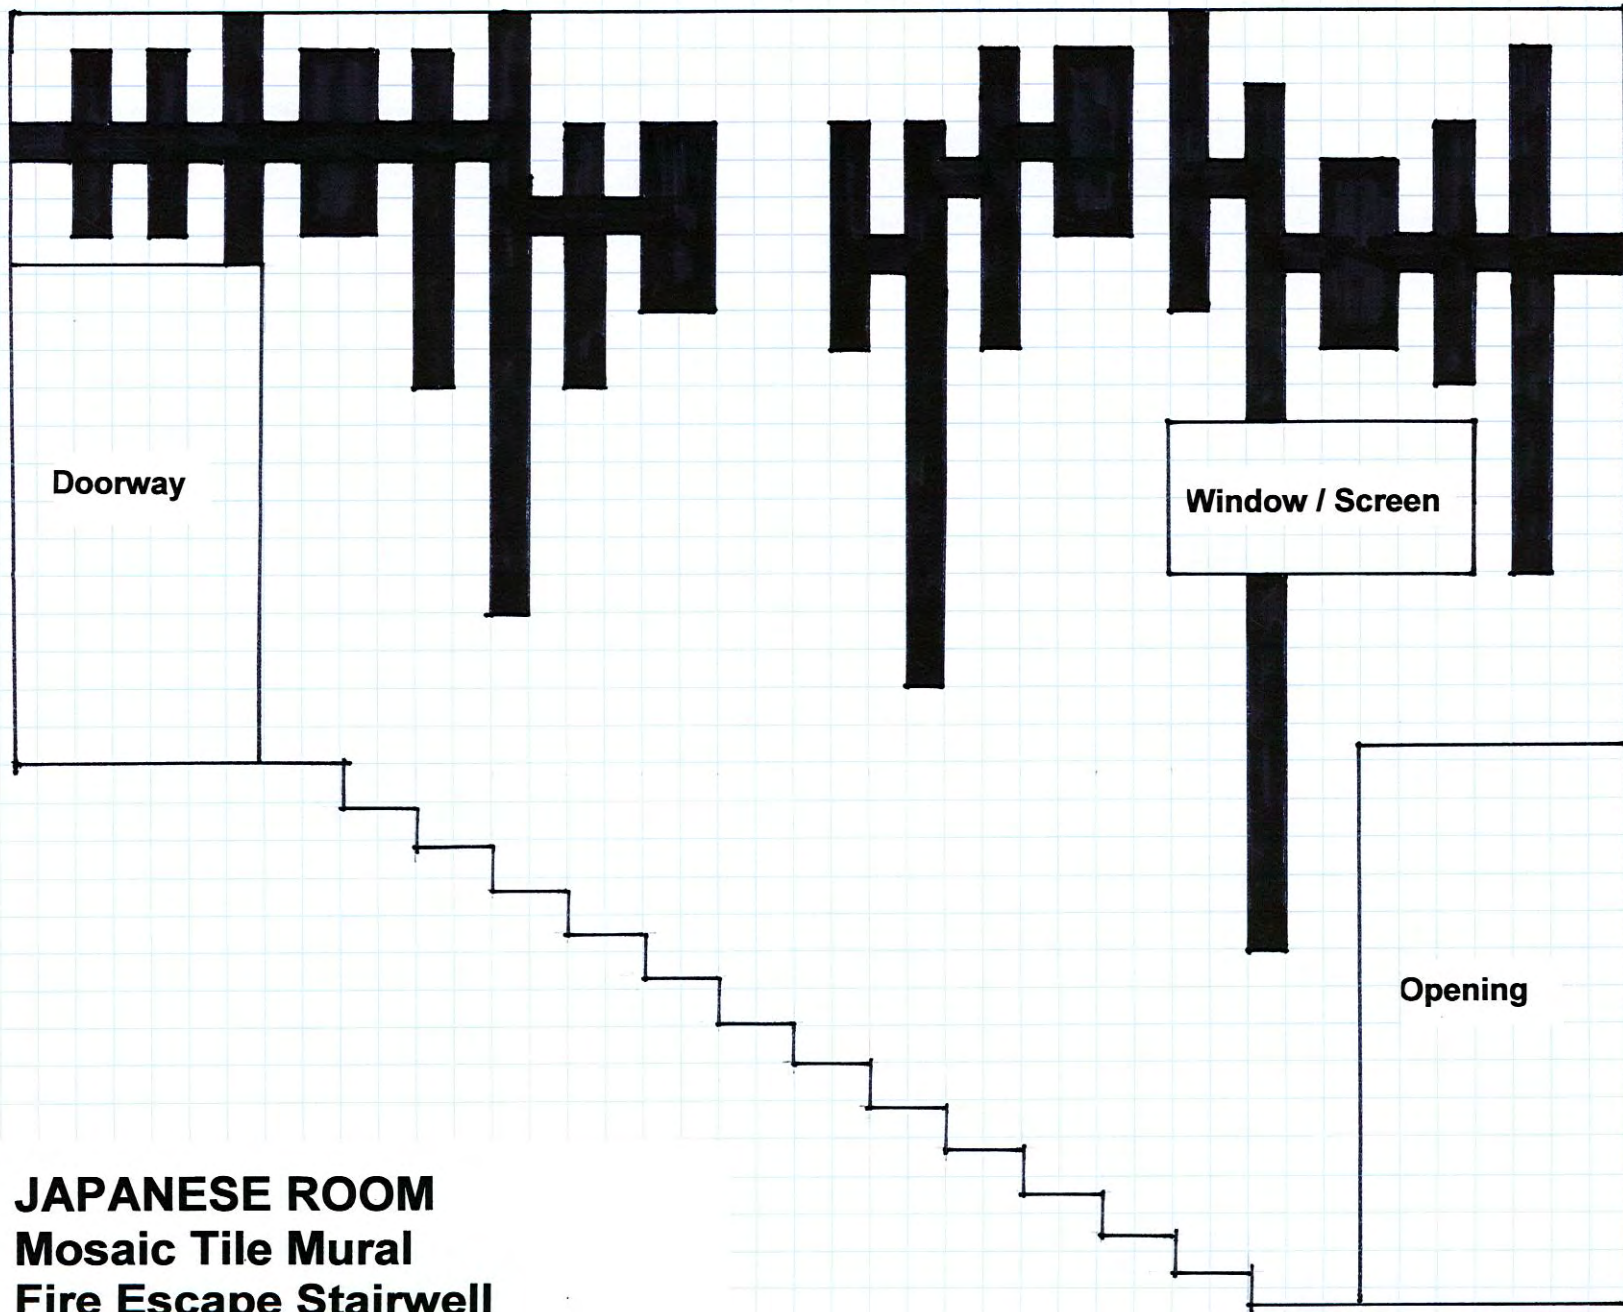

JAPANESE ROOM
Mosaic Tile Mural
Fire Escape Stairwell